

APPENDIX A

CALCULATIONS

Calculation of Joint Rotation & Eccentricity

Notes

1 Calculations based on TII Document CA/HA/BT/C11/54026/02/O pg 4/3

2 Input by user is in blue text

Ovalisation d	0.8	mm	
Allowable deflection between 2 dall sides of tunnel	0.4	mm	
Centroidal Radius r	5595	mm	
Angle subtended by a segment, β	56.8	degrees	
Calculations			
a = r + dall	5595.4		
b = r - dall	5594.6		
Chord length L	5326		
p	-0.0003		
q	11190.8		
r	-34243454.2		
χ	3060.2	mm	
Original angle between segment θ and horizontal	61.58	degrees	
New angle of the segment to the α horizontal	61.57	degrees	
Birdsmouthing between two segments $2(\theta-\alpha)$	0.009	degrees	
Joint Rotation of Each Segment $(\theta-\alpha)$	0.005	degrees	
t width at rotation = 0.581 degrees			
Max possible Contact Width	170	mm	
Packing thicknes	2.00	mm	
max strain (elastic)	0.67	mm	
Thickness of compressed packer	0.66	mm	
	0.69	mm	Opening caused by joint rotation ref 4/6A
Contact width x	8270	mm	High Contact Width relates to very low rotation of joint angle (i.e. low birdsmouthing between two segments)
Min Contact width x	170	mm	
Length of lining above packing	90	mm	
Lining thickness	350	mm	
Radial Joint Eccentricity e	28.3	mm	=Min eccentricity due to linear distribution of load over length of packing


Assessment of Joint Opening due to Longitudinal Curvature of Tunnels

IMPOSED RADIUS OF CURVATURE (R') DUE TO DEVELOPMENT

L	10 m	Distance between points of inflect
δ	0.03 mm	Maximum displacement between points of inflection
$R' = (L/2)^2 / 2\delta$		
R'	416.67 km	R' = Imposed radius of curvature
		Imposed radius of curvature due to longitudinal tunnel deflection



CHECK FOR OPENING OF TUNNEL JOINTS

R'	416666667 mm
L1	1700.0 mm
$\theta' = L1/R'$	4.08E-06 radians
Tunnel diameter	1.15E+04 mm
L2	$1700.047 = (R' + L1) \theta$
Joint Opening	0.05 mm

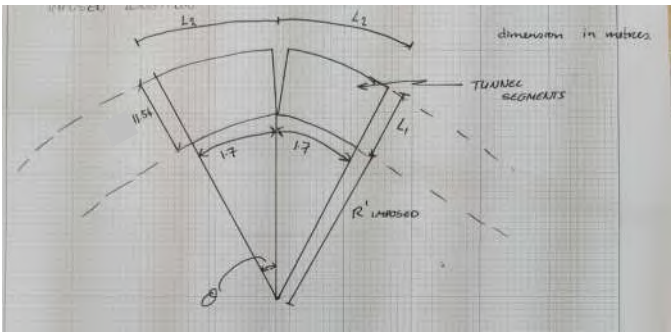

APPENDIX B



AS-BUILT DRAWINGS OF DUBLIN PORT TUNNELS

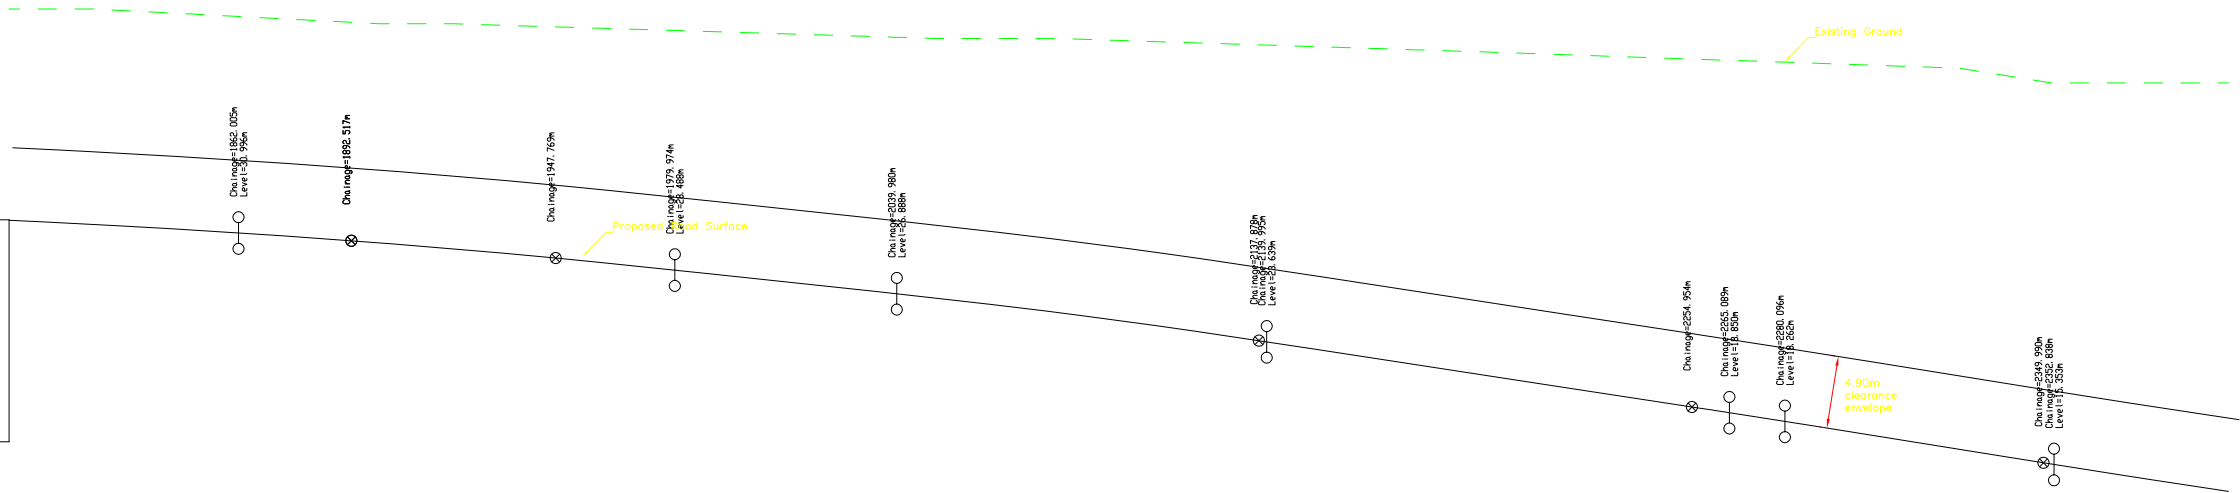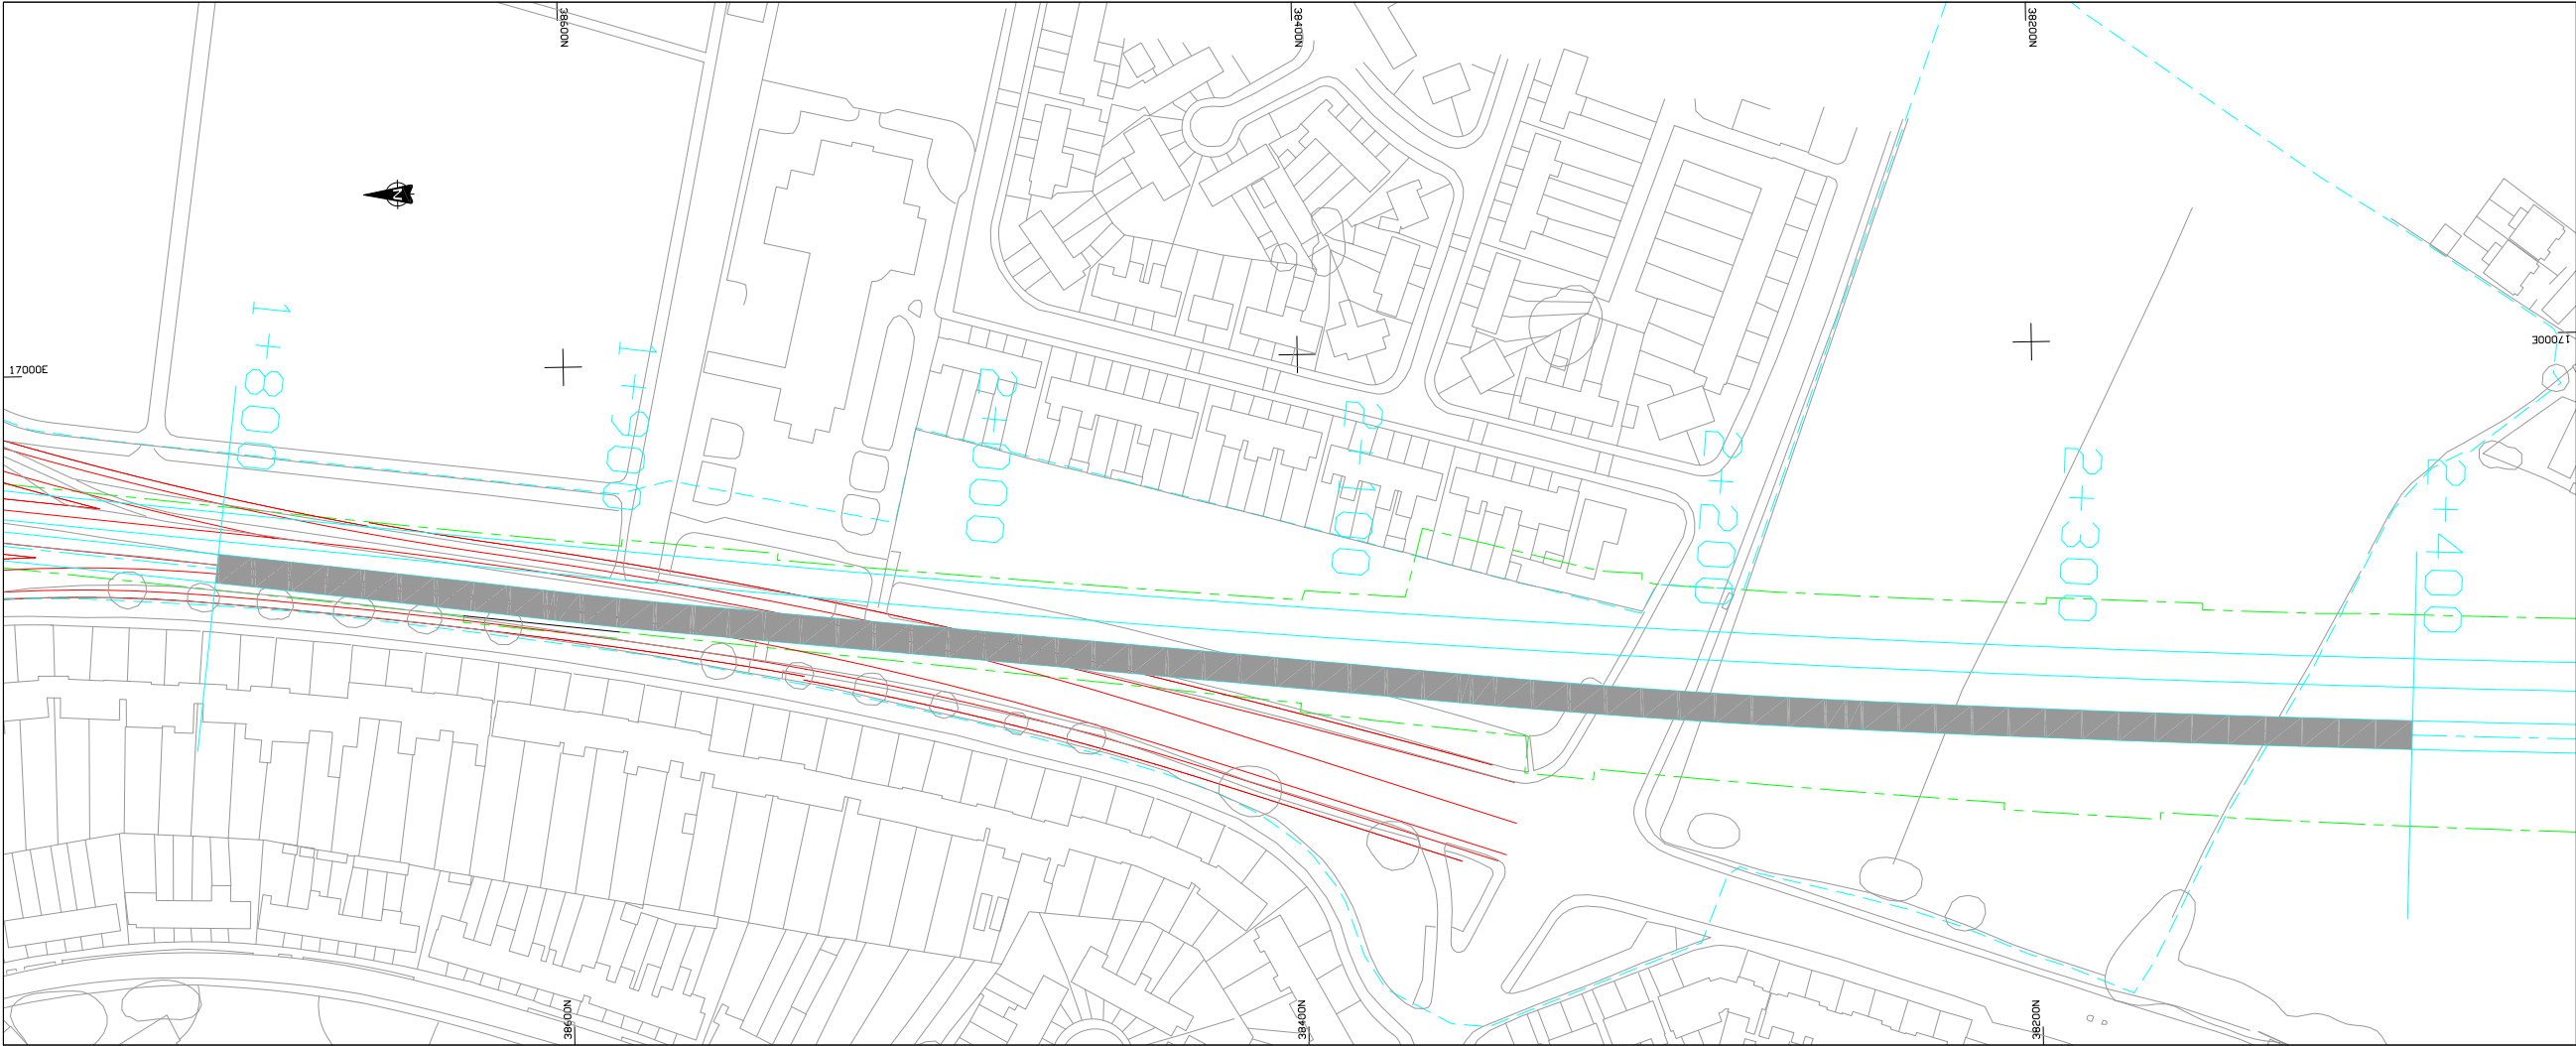

DESIGN SPEED 80 kph
SCALES :
HORIZONTAL 1:1000
VERTICAL 1:250


Level Datum =8.000

PROPOSED LEVEL	31.893	31.736	31.607	31.471	31.330	31.182	31.028	30.867	30.696	30.517	30.328	30.130	29.923	29.706	29.481	29.246	28.999	28.750	28.488	28.221	27.954	27.687	27.421	27.154	26.887	26.613	26.331	26.052	25.727	25.408	25.078	24.736	24.382	24.016	23.639	23.256	22.873	22.491	22.108	21.725	21.342	20.959	20.576	20.193	19.810	19.427	19.044	18.660	18.266	17.866	17.466	17.066	16.666	16.266	15.866	15.466	15.068	14.675	14.289	13.909	13.526																																																																																																																																																																																																																																																																																																																																																																																																																																																																																																																																																																																																																																																																																																																																																																																																																																																																																																																																																																																																								
EXISTING LEVEL	46.000	46.000	46.000	45.904	45.775	45.646	45.517	45.388	45.259	45.129	45.000	45.000	45.000	44.924	44.848	26.076	25.999	25.923	25.847	1.071	1.000	0.924	0.848	0.772	0.696	0.620	0.544	0.468	0.392	0.316	0.240	0.164	0.088	0.012	-0.064	-0.138	-0.212	-28.924	-29.000	-29.074	-29.148	-29.222	-29.296	-29.370	-29.444	-29.518	-29.592	-29.666	-29.740	-29.814	-29.888	-29.962	-30.036	-30.110	-30.184	-30.258	-30.332	-30.406	-30.480	-30.554	-30.628	-30.702	-30.776	-30.850	-30.924	-31.000	-31.074	-31.148	-31.222	-31.296	-

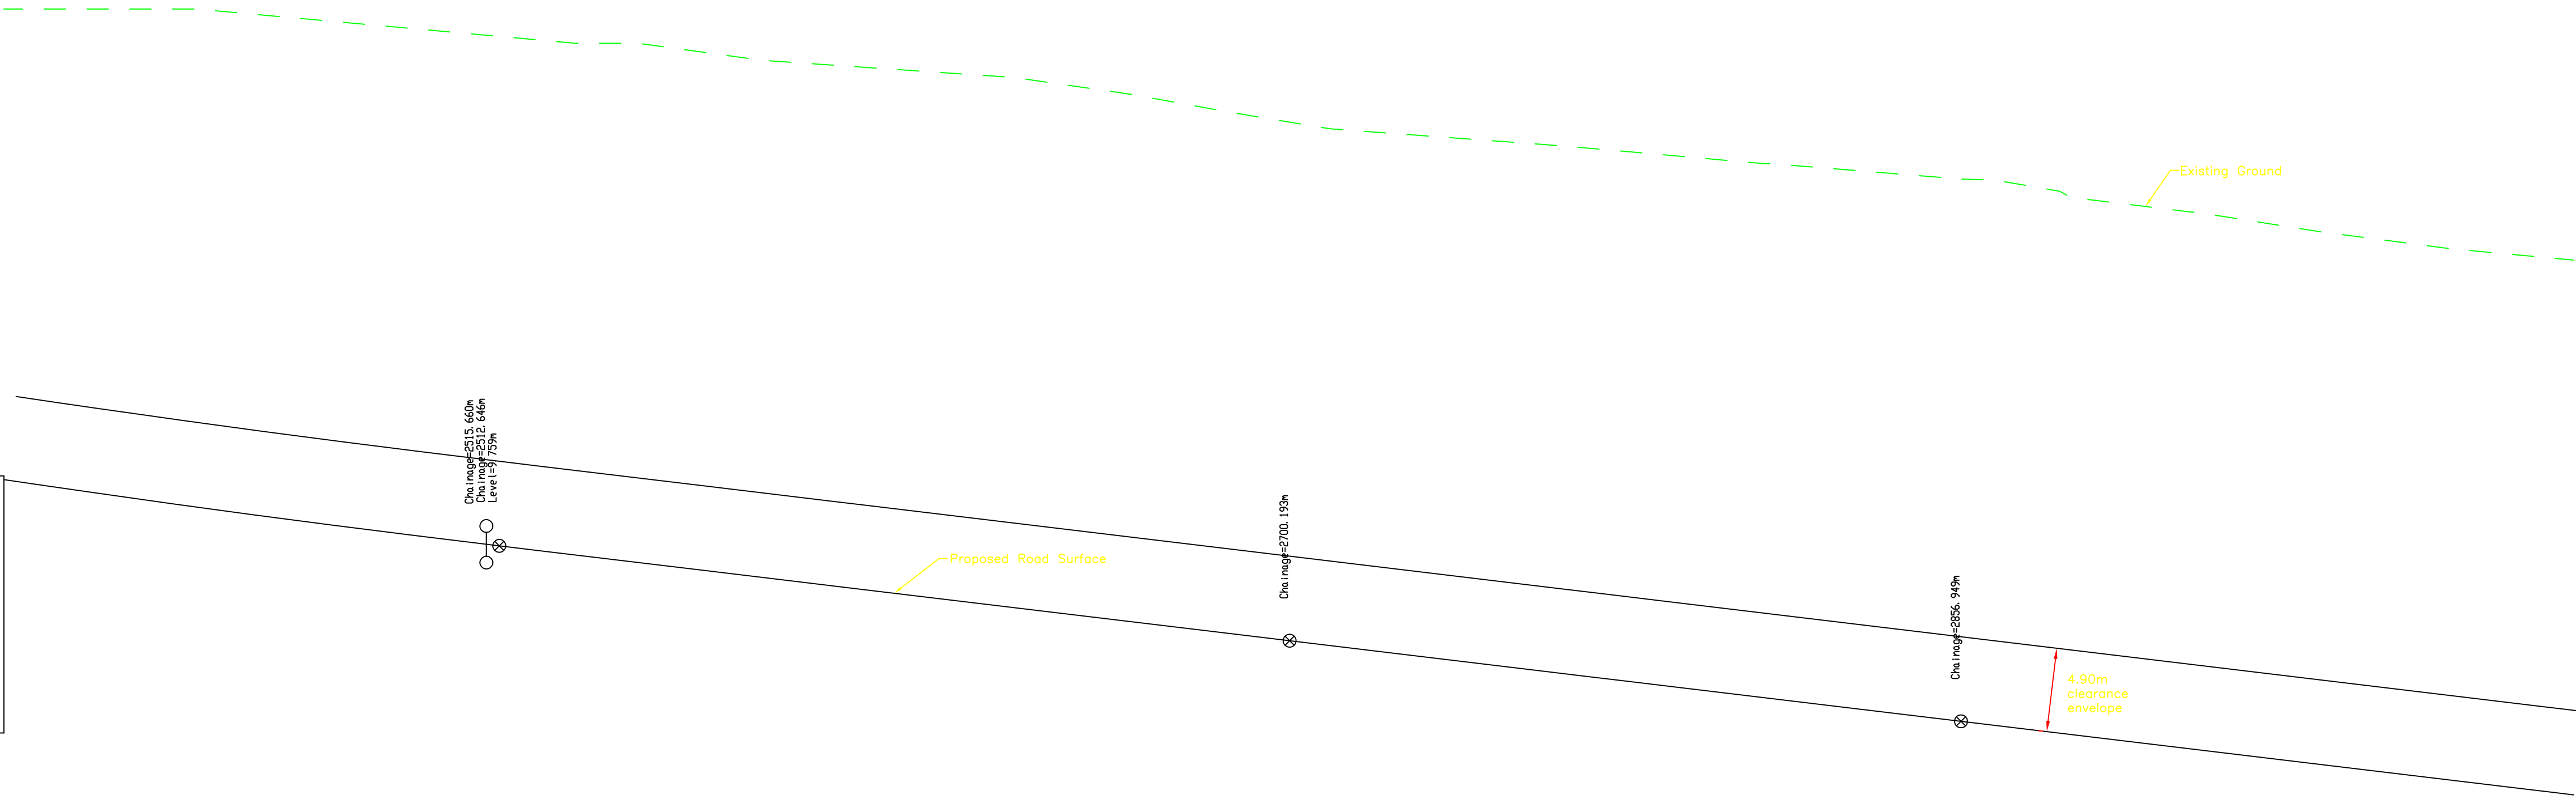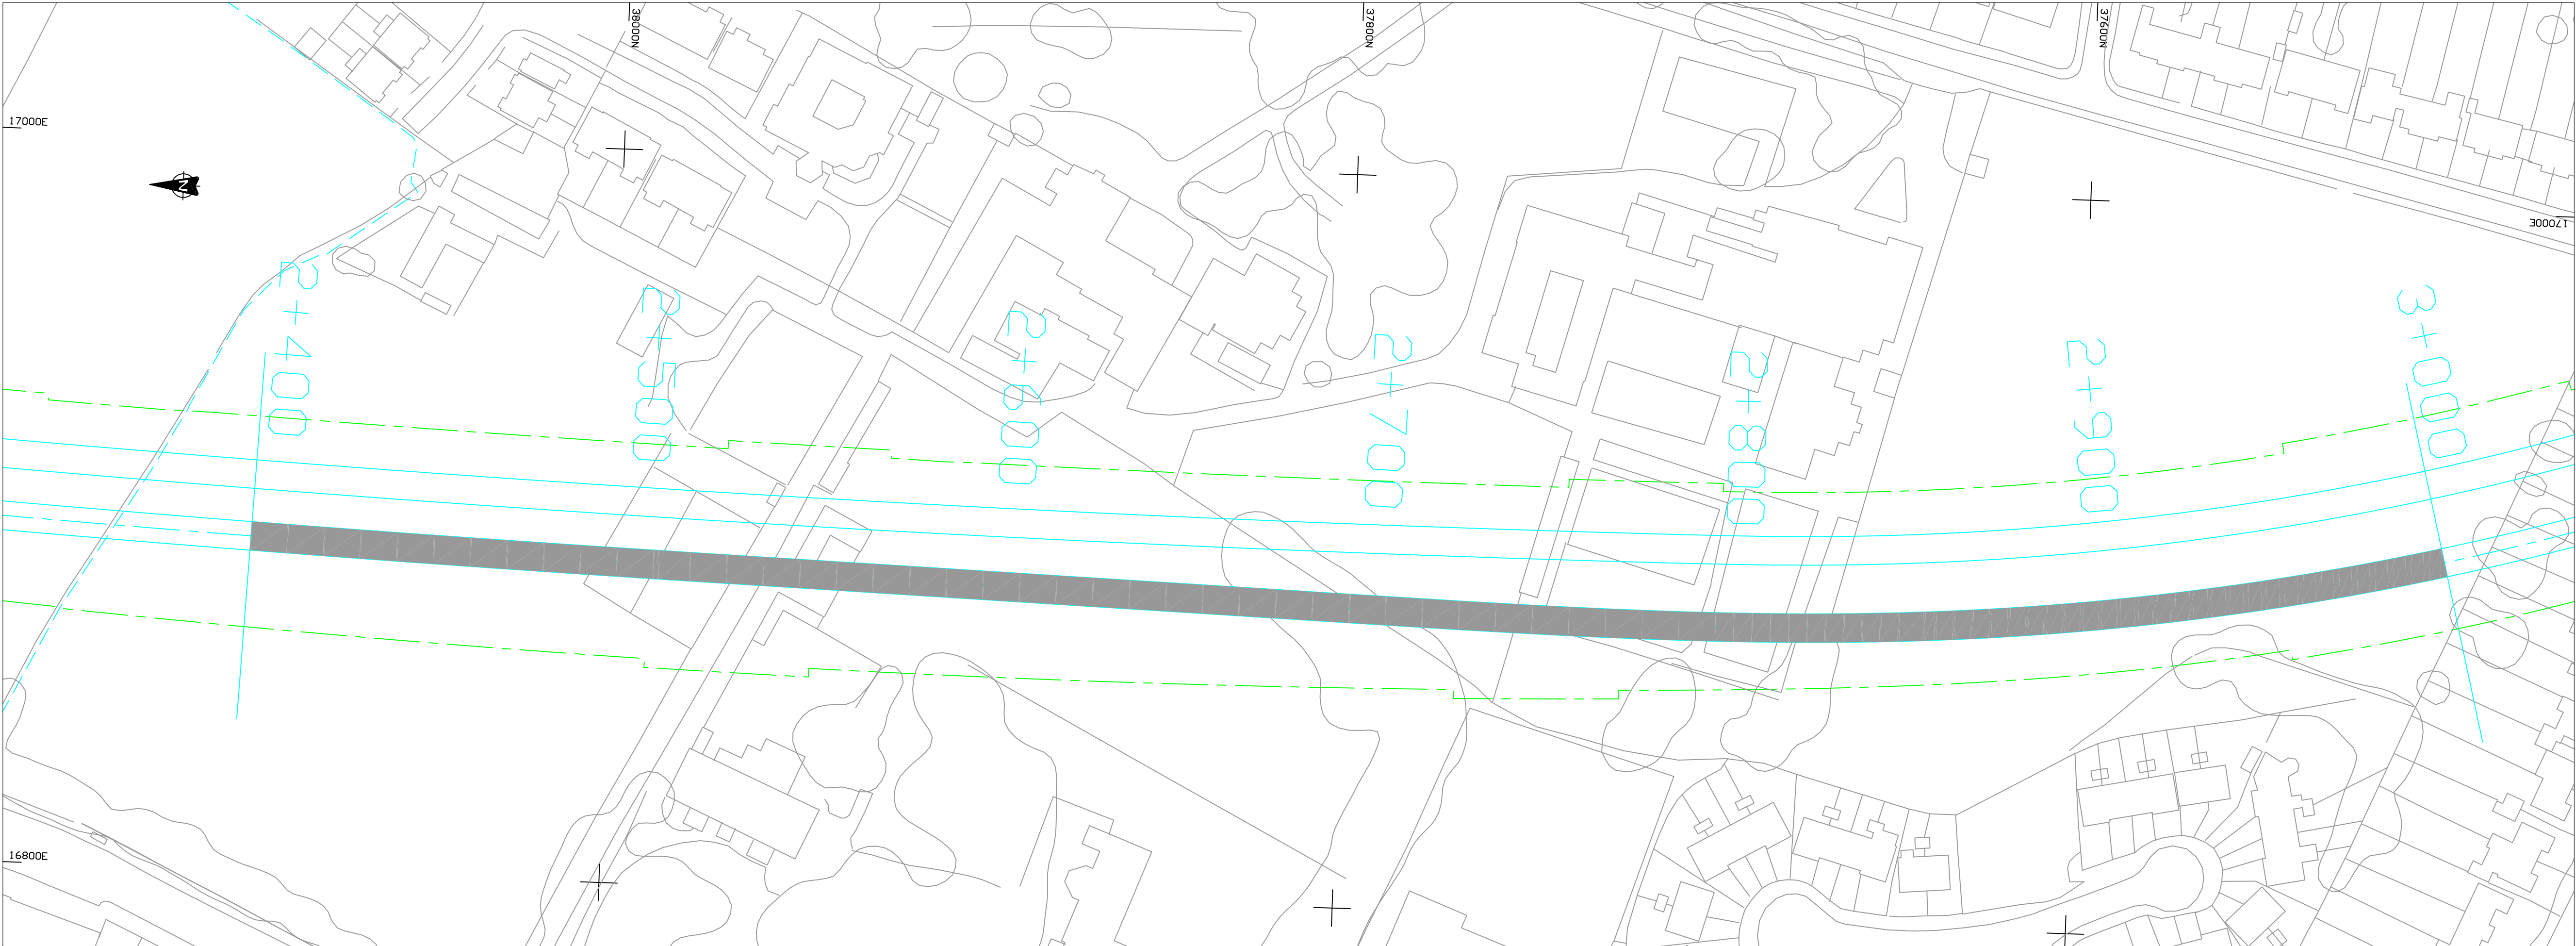

DESIGN SPEED 80 kph
SCALES :
HORIZONTAL 1:1000
VERTICAL 1:250


Level Datum =-10.000	
PROPOSED LEVEL	13.136 13.168 12.807 12.452 12.104 11.761 11.425 11.095 10.772 10.454 10.143 9.838 9.538 9.238 8.938 8.638 8.338 8.038 7.738 7.438 7.137 6.837 6.537 6.237 5.937 5.637 5.337 5.037 4.737 4.437 4.137 3.837 3.537 3.237 2.936 2.636 2.336 2.036 1.736 1.436 1.136 0.836 0.536 0.236 -0.064 -0.364 -0.664 -0.964 -1.264 -1.565 -1.865 -2.165 -2.465 -2.765 -3.065 -3.365 -3.655 -3.955 -4.255 -4.555 -4.855
EXISTING LEVEL	41.000 41.000 41.000 41.000 40.999 40.881 40.656 40.430 40.205 39.979 39.754 39.528 39.303 39.077 38.852 38.628 38.403 38.178 0.153 -0.078 -0.303 -0.528 -236.328 -236.55

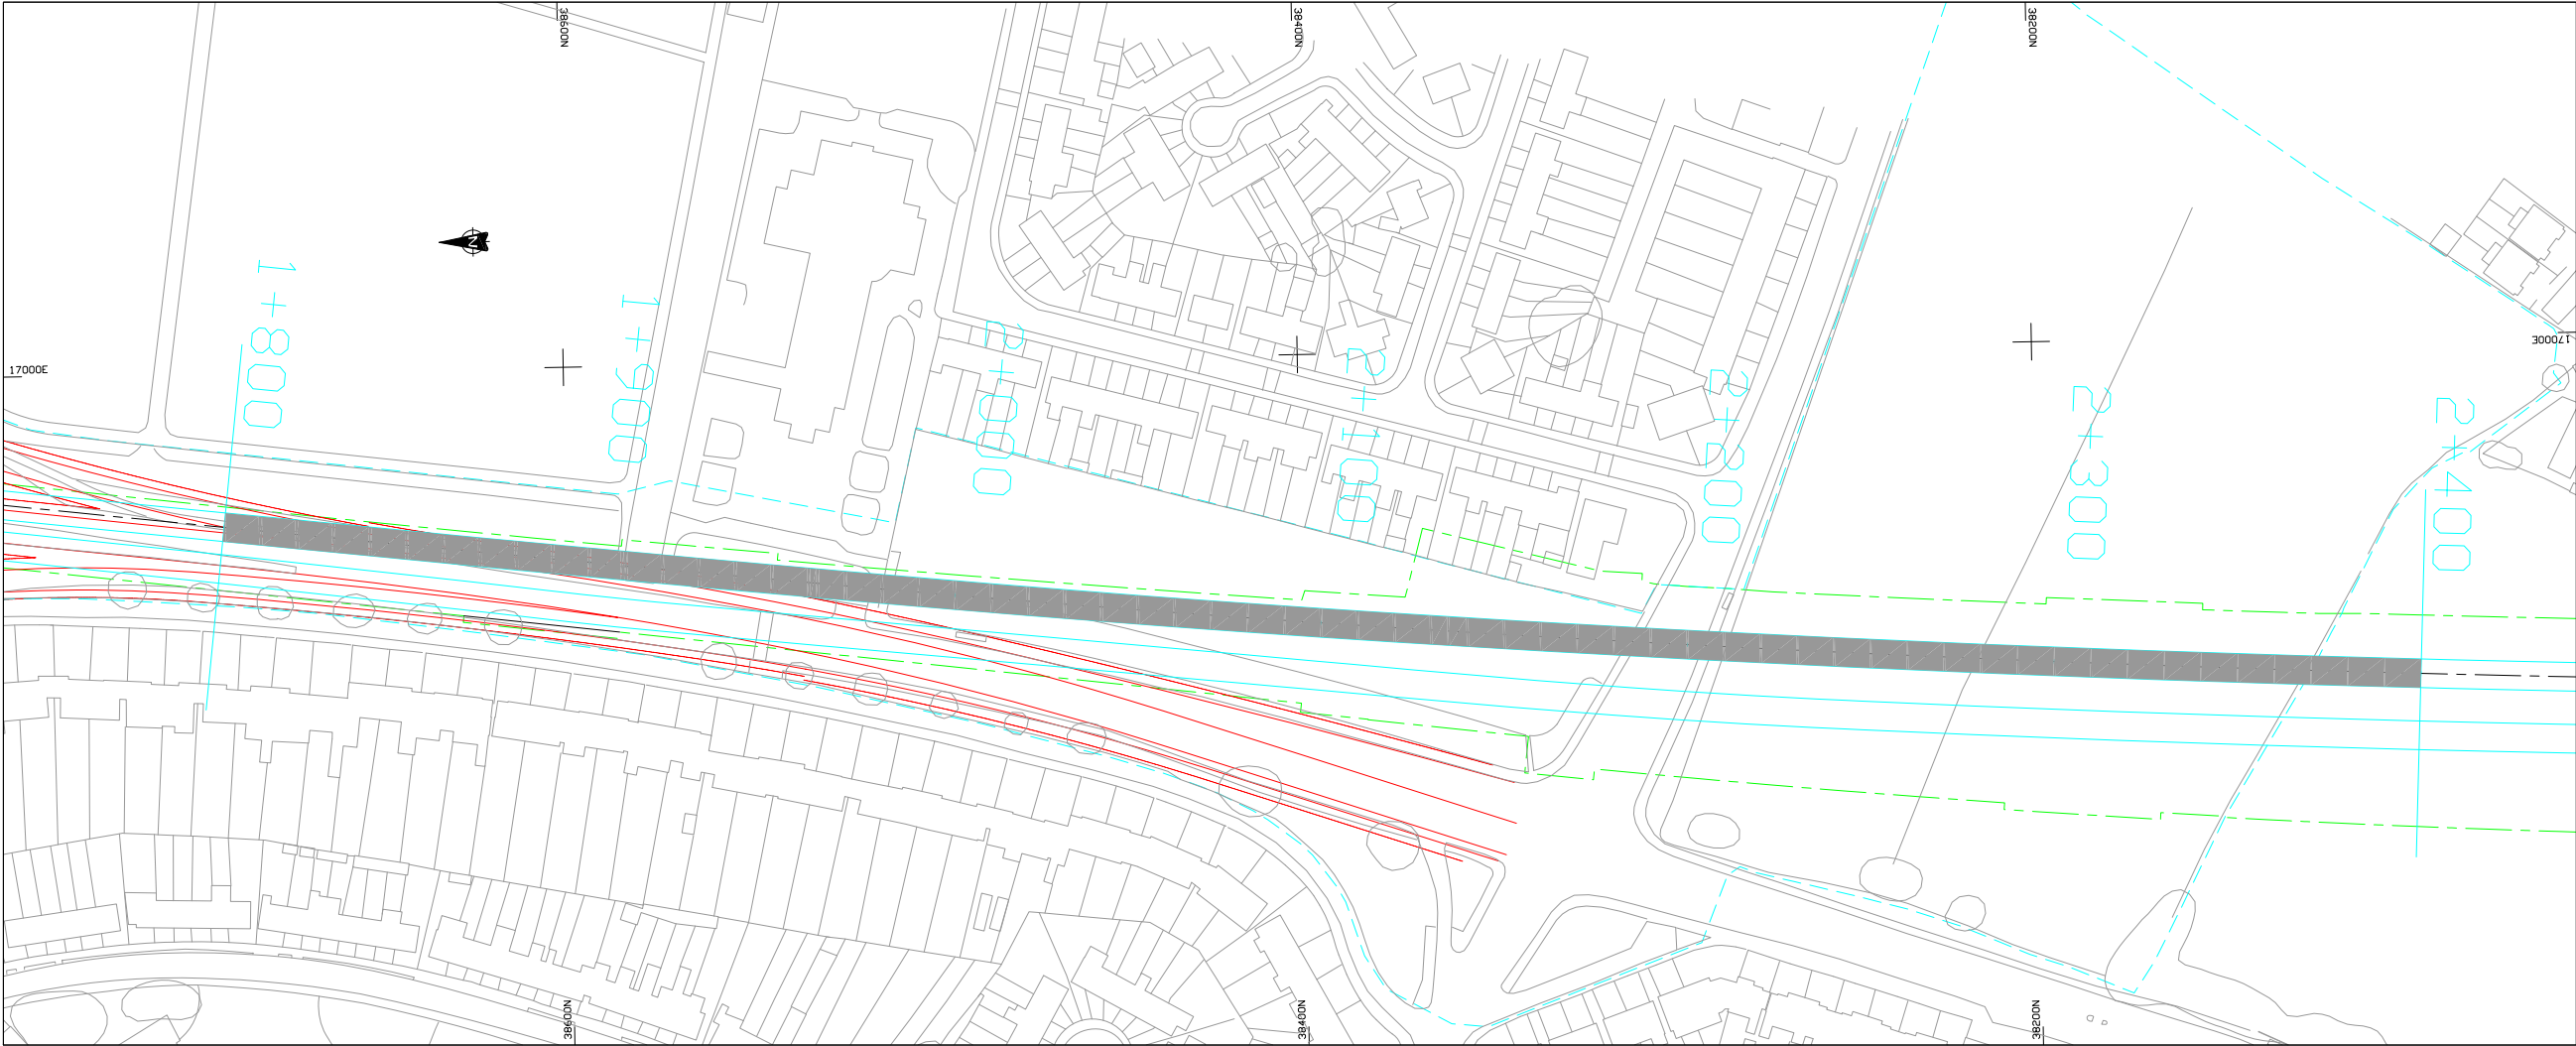


DESIGN SPEED 80 kph
SCALES :
HORIZONTAL 1:1000
VERTICAL 1:250

Level Datum =9.000


PROPOSED LEVEL	31.831	31.706	31.575	31.438	31.294	31.144	30.988	30.826	30.657	30.482	30.301	30.113	29.918	29.717	29.508	29.292	29.070	28.840	28.604	28.360	28.109	27.852	27.588	27.315	27.038	26.753	26.460	26.161	25.855	25.542	25.221	24.894	24.560	24.219	23.871	23.515	23.154	22.785	22.409	22.028	21.644	21.254	20.862	20.500	20.118	19.726	19.324	18.912	18.500	18.208	17.805	17.444	17.062	16.680	16.298	15.916	15.534	15.152	14.770	14.388	14.006																																																																																																																																																																																																																																																																																																																																																																																																																																																																																																																																																																																																																																																																																																																																																																																																																																																																																																																																																																																																																																													
EXISTING LEVEL	46.100	45.983	45.820	45.717	45.614	45.512	45.409	45.306	45.203	45.100	44.998	44.895	44.876	44.771	44.666	44.562	44.457	44.352	44.248	44.143	44.038	43.936	43.827	43.882	43.883	43.784	43.706	43.647	43.588	43.529	43.470	43.412	43.353	43.294	43.235	43.176	43.118	43.059	43.000	42.936	42.868	42.800	42.734	42.666	42.598	1.050	1.082	1.014	0.946	0.878	0.810	0.742	0.674	0.606	0.538	0.470	0.402	0.334	0.266	0.198	0.130	0.062	-0.006	-0.074	-0.142	-19.930	-20.000	-20.070	-26.930

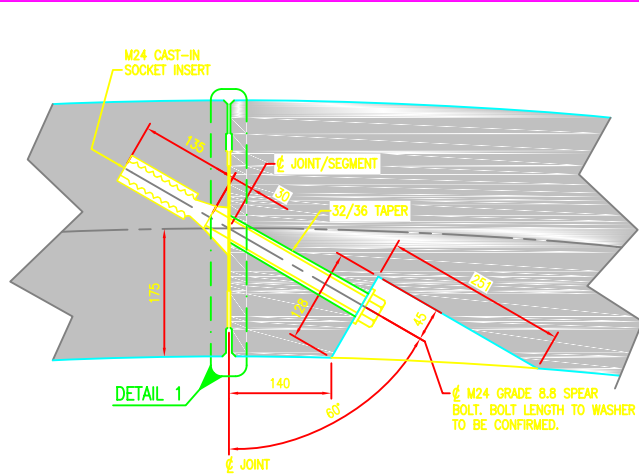


CROSS JOINT CONNECTION
SCALE 1:5

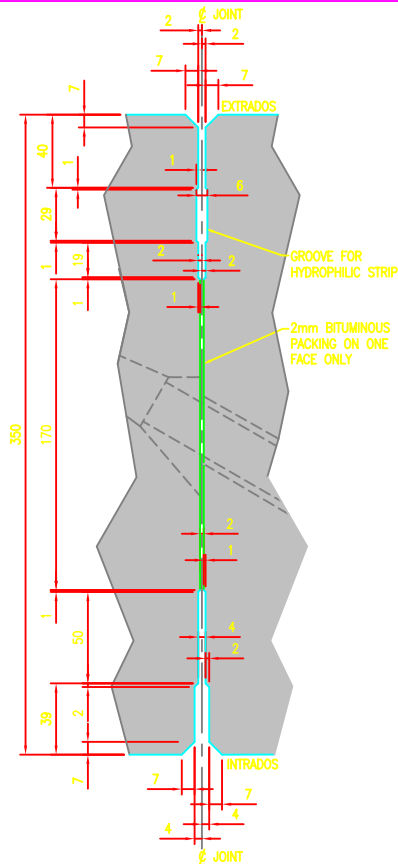


DETAIL 1
CROSS JOINT CONNECTION
SCALE 1:2

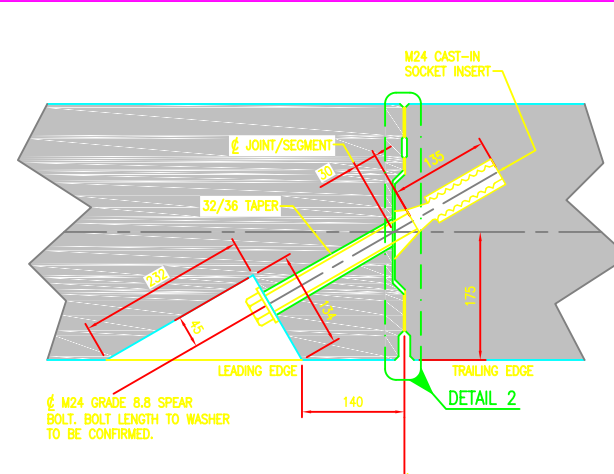


CIRCLE JOINT CONNECTION
SCALE 1:5

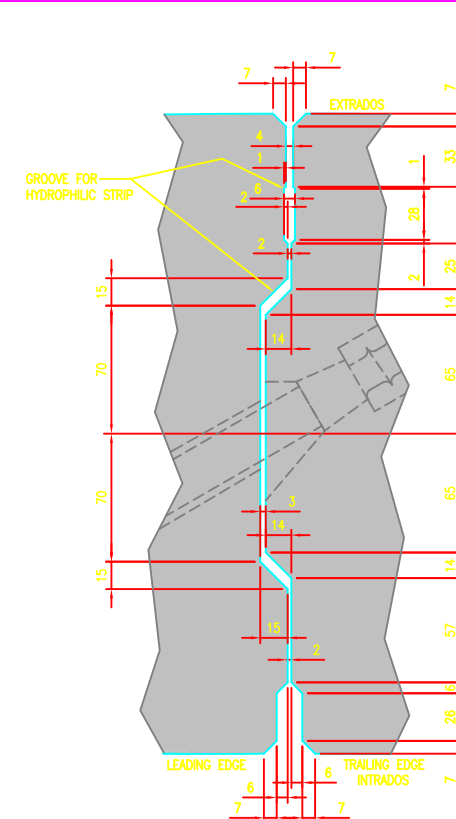


DETAIL 2
CIRCLE JOINT CONNECTION
SCALE 1:2

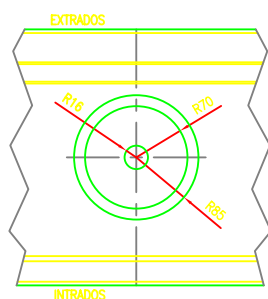


LEADING EDGE
SCALE 1:5

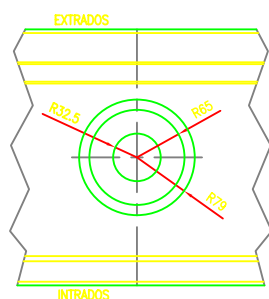


TRAILING EDGE
SCALE 1:5

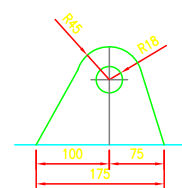


OUTER CIRCLE JOINT
BOLT POCKET DETAIL
SCALE 1:5

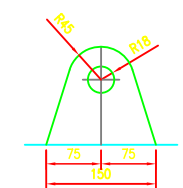


INNER CIRCLE JOINT
BOLT POCKET DETAIL
SCALE 1:5

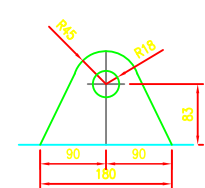


CROSS JOINT
BOLT POCKET DETAIL
SCALE 1:5

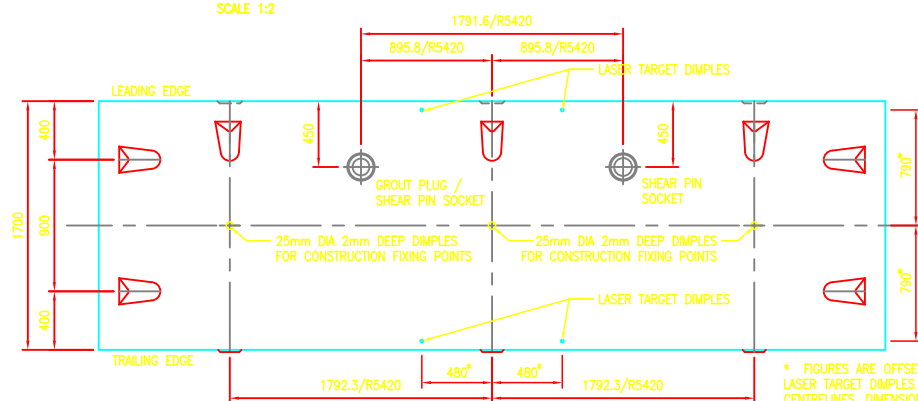


TYPICAL SEGMENT DETAIL - STANDARD RING DEVELOPED VIEW
SCALE 1:25

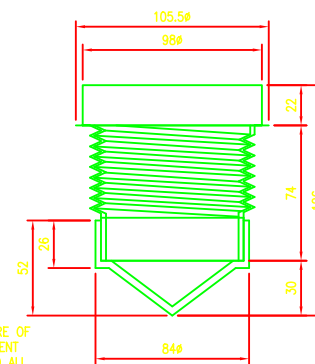


DETAIL 3 - GROUT PLUG
SCALE 1:2

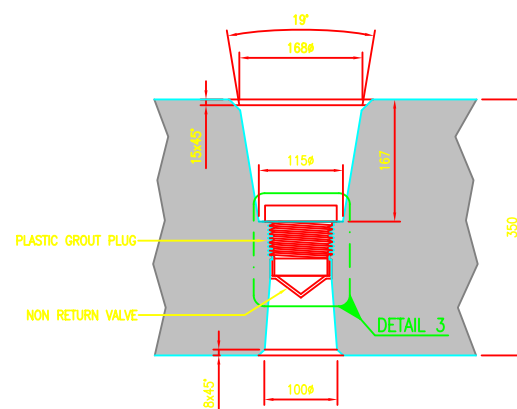

GROUT PLUG/SHEAR PIN SOCKET DETAIL
SCALE 1:5

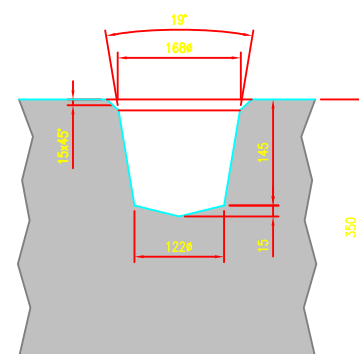


SHEAR PIN SOCKET DETAIL
SCALE 1:5

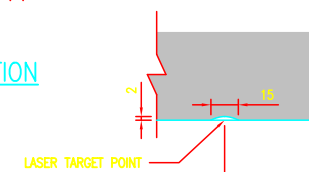

DETAIL OF LASER TARGET
DIMPLE
SCALE 1:2

DESIGN ASSUMPTIONS RELATING TO TEMPORARY LOADING CONDITIONS

1. MAXIMUM NUMBER OF SEGMENTS TO BE STACKED/LIFTED IS THREE UNLESS DETAILED ASSESSMENT OF SUPPORT BEARERS IS UNDERTAKEN.

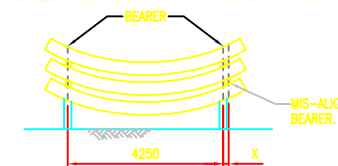

2. No. BEARERS MIN PER SEGMENT AT 4250mm SPACING. BEARERS TO BE MIN 1800mm LONG. 'X' MAXIMUM HORIZONTAL OFFSET IS 150mm. LIFTING POINTS TO MATCH BEARER POSITIONS ON LOWER SEGMENT. ALTERNATIVE ARRANGEMENTS TO BE AGREED BY THE CONTRACTOR'S DESIGNER.

3. SEGMENTS NOT TO BE STACKED 3 HIGH UNTIL CHARACTERISTIC STRENGTH OF 25N/mm² IS ATTAINED.




4. ALL CIRCLE BOLTS TO SEGMENTS ABOVE AXIS LEVEL TO BE INSERTED AND RAM PRESSURE TO BE MAINTAINED ON SEGMENTS PRIOR TO REMOVAL OF ERECTOR PADS. RAM PRESSURE TO BE REMOVED ONLY AFTER COMPLETE RING HAS BEEN BOLTED. ALTERNATIVE SEQUENCE TO BE AGREED BY THE CONTRACTOR'S DESIGNER.

5. PLANE MIS-ALIGNMENT ON CIRCLE JOINT GREATER THAN PACKER THICKNESS MAY RESULT IN DAMAGE TO SEGMENT DURING RAM SHOVE.
6. SHOVE RAM THRUST OF 2655kN OVER 900mm SHOE LENGTH NOT TO BE EXCEEDED. LOADS IN EXCESS OF THIS VALUE MAY RESULT IN DAMAGE TO SEGMENTS.

AS-BUILT

Changes have been made to the 'For Construction' drawing. This drawing should be read in conjunction with Field Change Request numbers:

FCR/NC/NTS/T04/38315/01/C Change in segment lifting arrangements

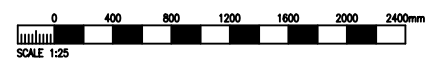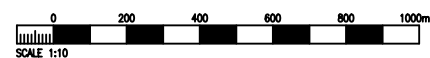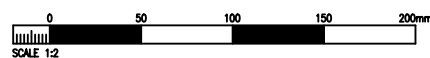

NOTES

1. ALL DIMENSIONS IN MILLIMETRES UNLESS NOTED OTHERWISE.
2. CHARACTERISTIC STRENGTH OF CONCRETE TO BE CLASS 60.
3. MINIMUM PULL-OUT LOAD FOR BOLT/SOCKET TO BE 8 TONNES.
4. ALL MATERIALS USED HAVE BEEN APPROVED IN ACCORDANCE WITH THE SITE BASE QUALITY ASSURANCE PROCEDURES.
5. COVER TO BE 40mm NOMINAL, 35mm MINIMUM.
6. THIS DRAWING TO BE READ IN CONJUNCTION WITH DWG Nos. 41002, 41003, 41004, 41012 & 41013.
7. GRUMMET OR COMPRESSIBLE WASHER TO BE INSERTED WITH BOLTS. GRUMMET/WASHER TYPE TO BE CONFIRMED.
8. BOLT DIMENSIONS TO BE CONFIRMED DEPENDING ON SOCKET DETAILS.
9. GROUT SOCKET AS SHOWN OR SIMILAR APPROVED.
10. MAXIMUM GROUT PRESSURE TO BE 4.6 BAR.
11. OVER 80% OF THE BOLTS REMAINED IN PLACE ONCE RINGS BUILT AND GRANTED.
12. DIMPLES FOR CONSTRUCTION FIXING POINTS APPLICABLE TO ALL SEGMENTS FOR ALL RING TYPES EXCEPT KEY SEGMENTS
13. GROUT TO ACHIEVE CHARACTERISTIC STRENGTH PRIOR TO GANTRY WHEEL TRAVELLING OVER SEGMENT NIB

09	9.11.06	CD	AS-BUILT ISSUE
08	-	MA	AS-BUILT CHANGES ADDED
07	9.02.02	SML	DRAWING ISSUED FOR CONSTRUCTION
06	2.2.02	GRD	NOTE ADDED
05	22.8.01	GRD	LABOR AMENDMENTS AT NOC REQUEST
04	5.7.01	PRD	NMI COMMENTS INCORPORATED
03	27.8.01	NDA	DEFINITIVE DESIGN
02	31.5.01	NDA	NMI COMMENTS INCORPORATED
Rev. No. Date By Rev.			

The content in this drawing is the property of Dublin Corporation and the drawing may not be reproduced or used in any form without the prior written permission of Dublin Corporation. As a third contractual party, without the written permission of Dublin Corporation.

Project **DUBLIN PORT TUNNEL**

NISHIMATSU
MOWLEM
IRISHENCO

Haswell
Consulting Engineers

Carl Bro
Intelligent Solutions

HBI
HAERTER AG

NRA NATIONAL ROADS AUTHORITY
An tArdánas um Bóthraí Náisiúnta

Client **Dublin Corporation**
Bárdas Átha Cliath



Title **10840 I.D. TUNNEL**
PRECAST CONCRETE LINING
DETAILS


Scales **1/25, 1/10, 1/5, 1/2**

Rev. **NDA** Date **14/5/01** Chk. **Passed**

Project No. **4958** Design Package **HWD 4.3**

Drawing No. **DR/HA/BT/C11/41001/09/X**

Original Drawing Size : 594 x 841 - A1

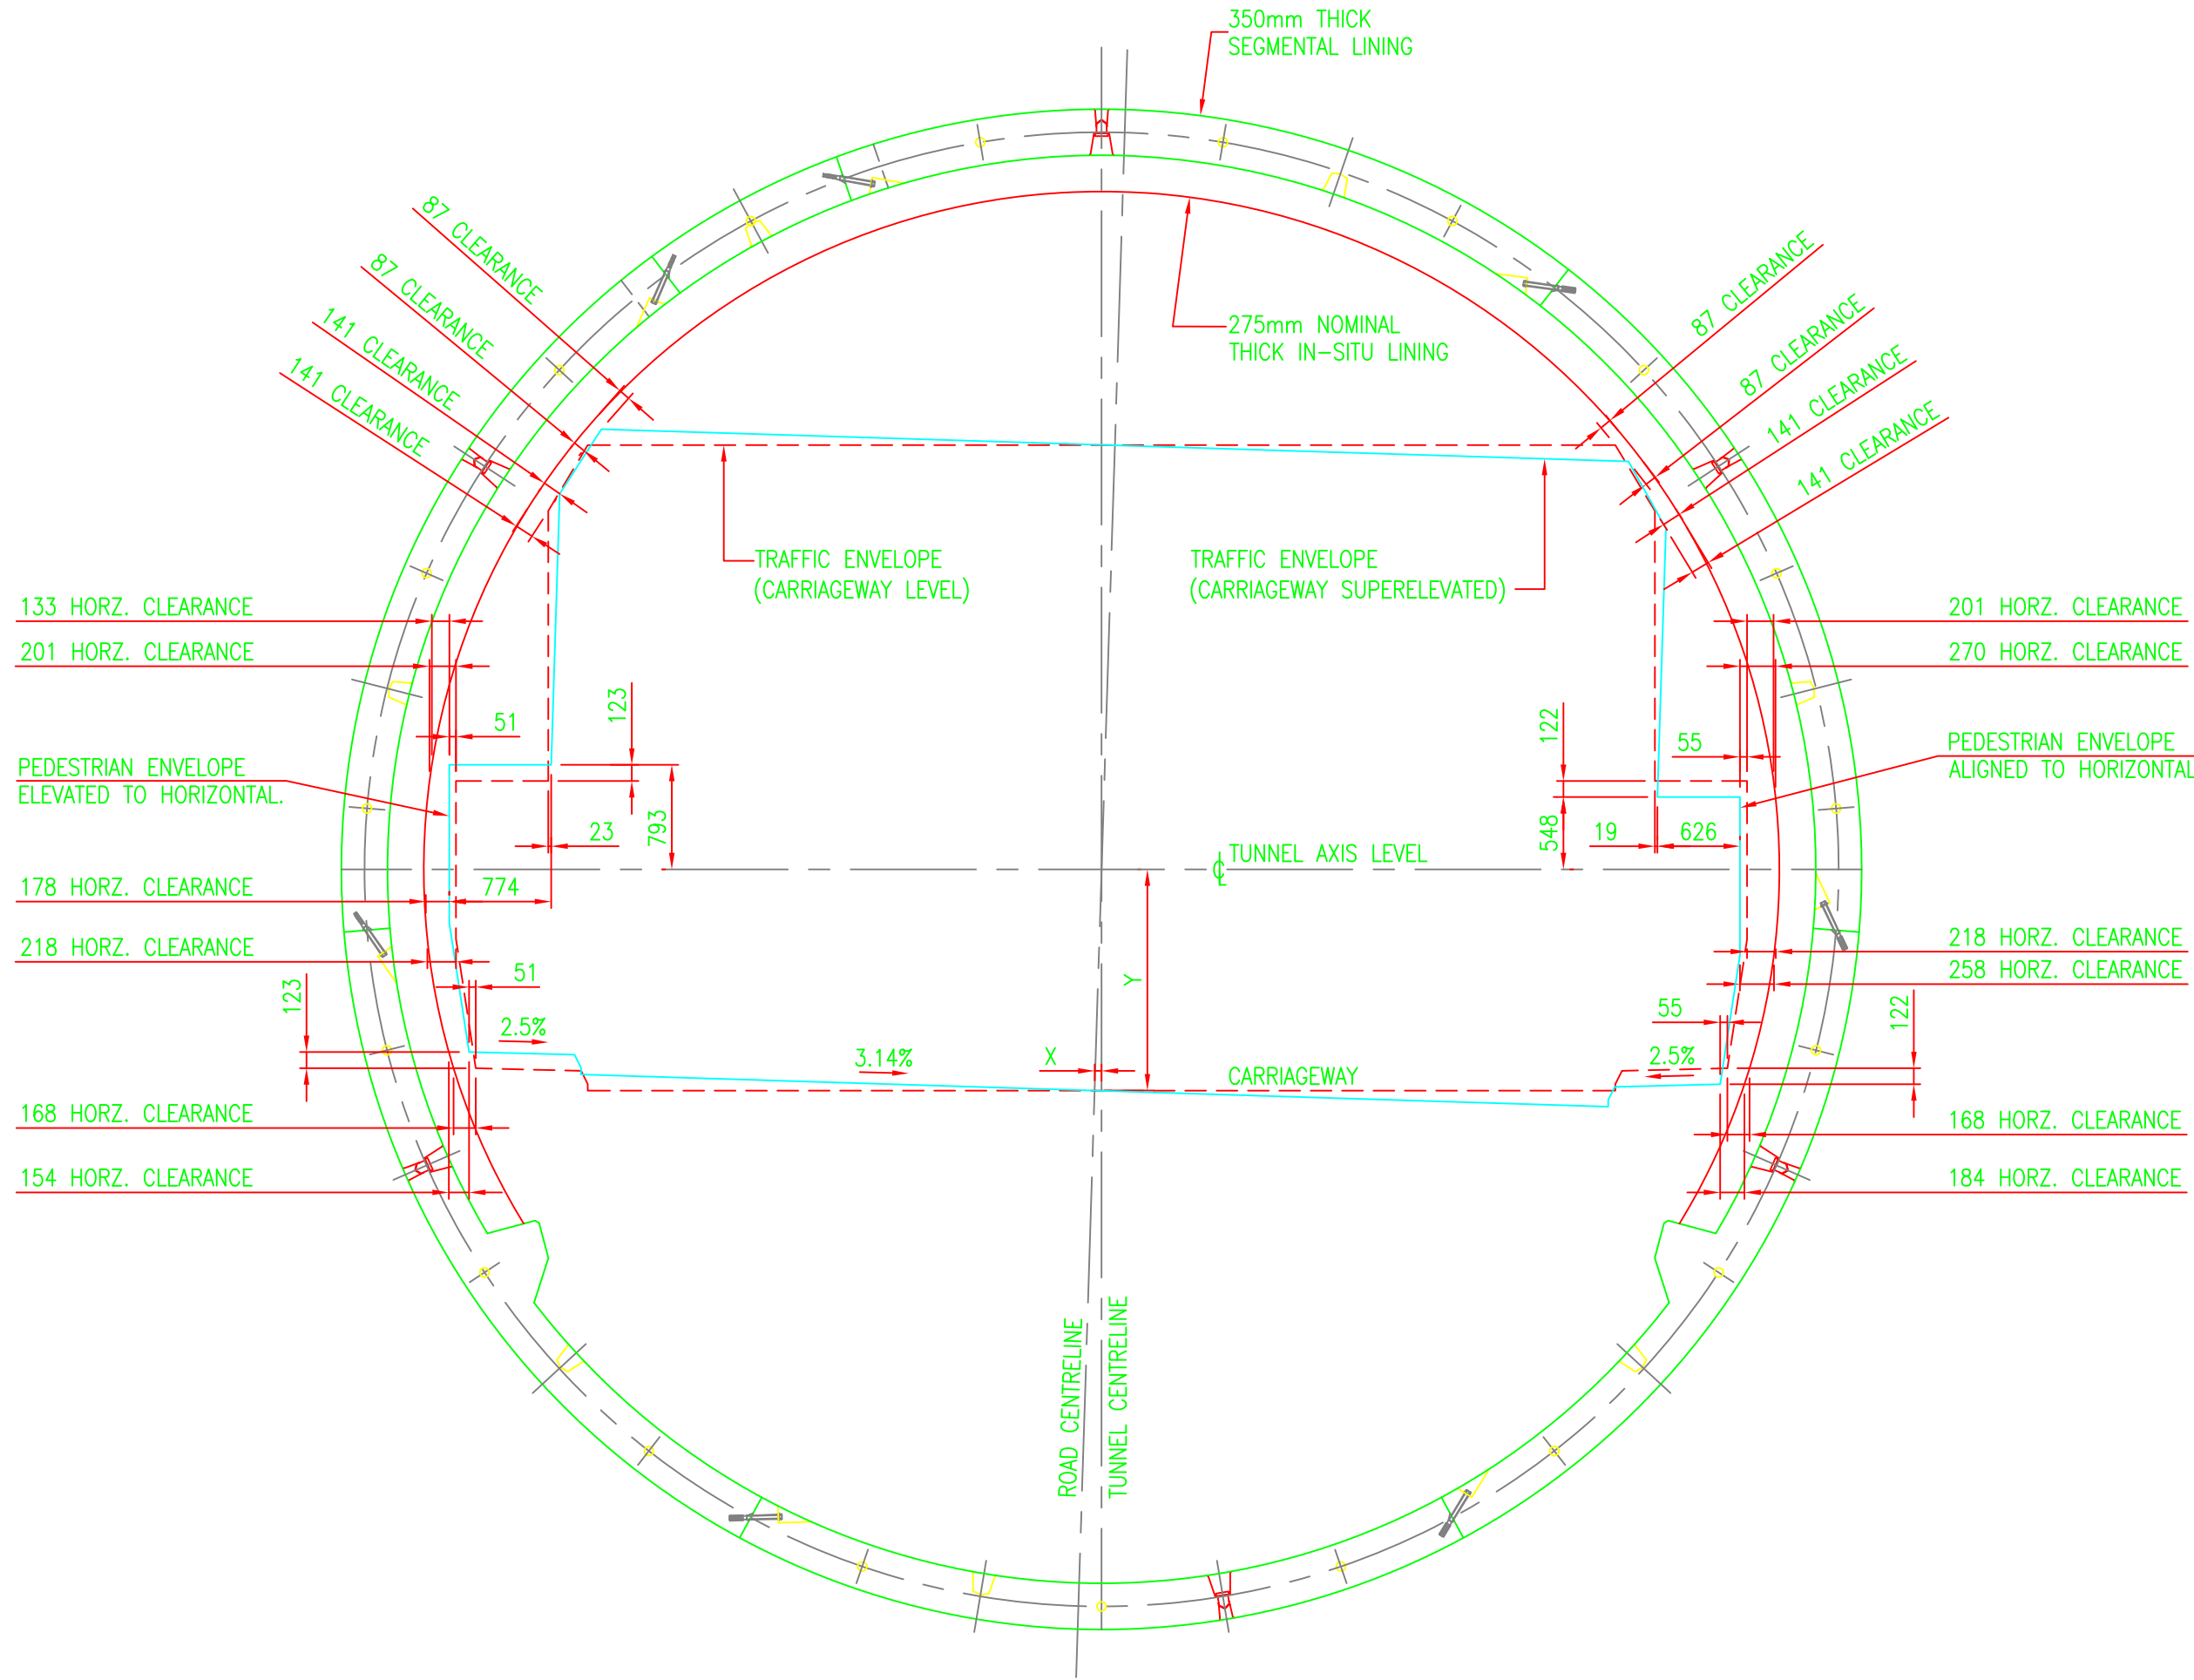

DISPLACEMENT BETWEEN ROAD AND TUNNEL
ALIGNMENT TO SUIT ROAD SUPERELEVATION
(MAX. SHOWN)


SCALE 1:50

NOTE:

CLEARANCES MAY VARY FROM
THEORETICAL DUE TO DRIVING
TOLERANCES AND DESIGN
REALIGNMENTS. REFER TO WRIGGLE
SURVEY IN AS-BUILT RECORDS.


SUPER ELEVATION	HORIZONTAL SHIFT FROM ROAD ALIGNMENT TO TUNNEL AXIS X	VERTICAL SHIFT FROM ROAD ALIGNMENT TO TUNNEL AXIS Y
0.50%	8.40mm	1679.98mm
1.00%	16.80mm	1679.92mm
1.50%	25.20mm	1679.81mm
2.00%	33.60mm	1679.66mm
2.50%	42.00mm	1679.47mm
2.80%	47.04mm	1679.34mm
3.14%	52.75mm	1679.17mm

SCHEDULE OF SHIFT BETWEEN TUNNEL
CENTREPOINT AND CARRIAGEWAY CENTRELINE WITH
VARYING SUPER ELEVATION

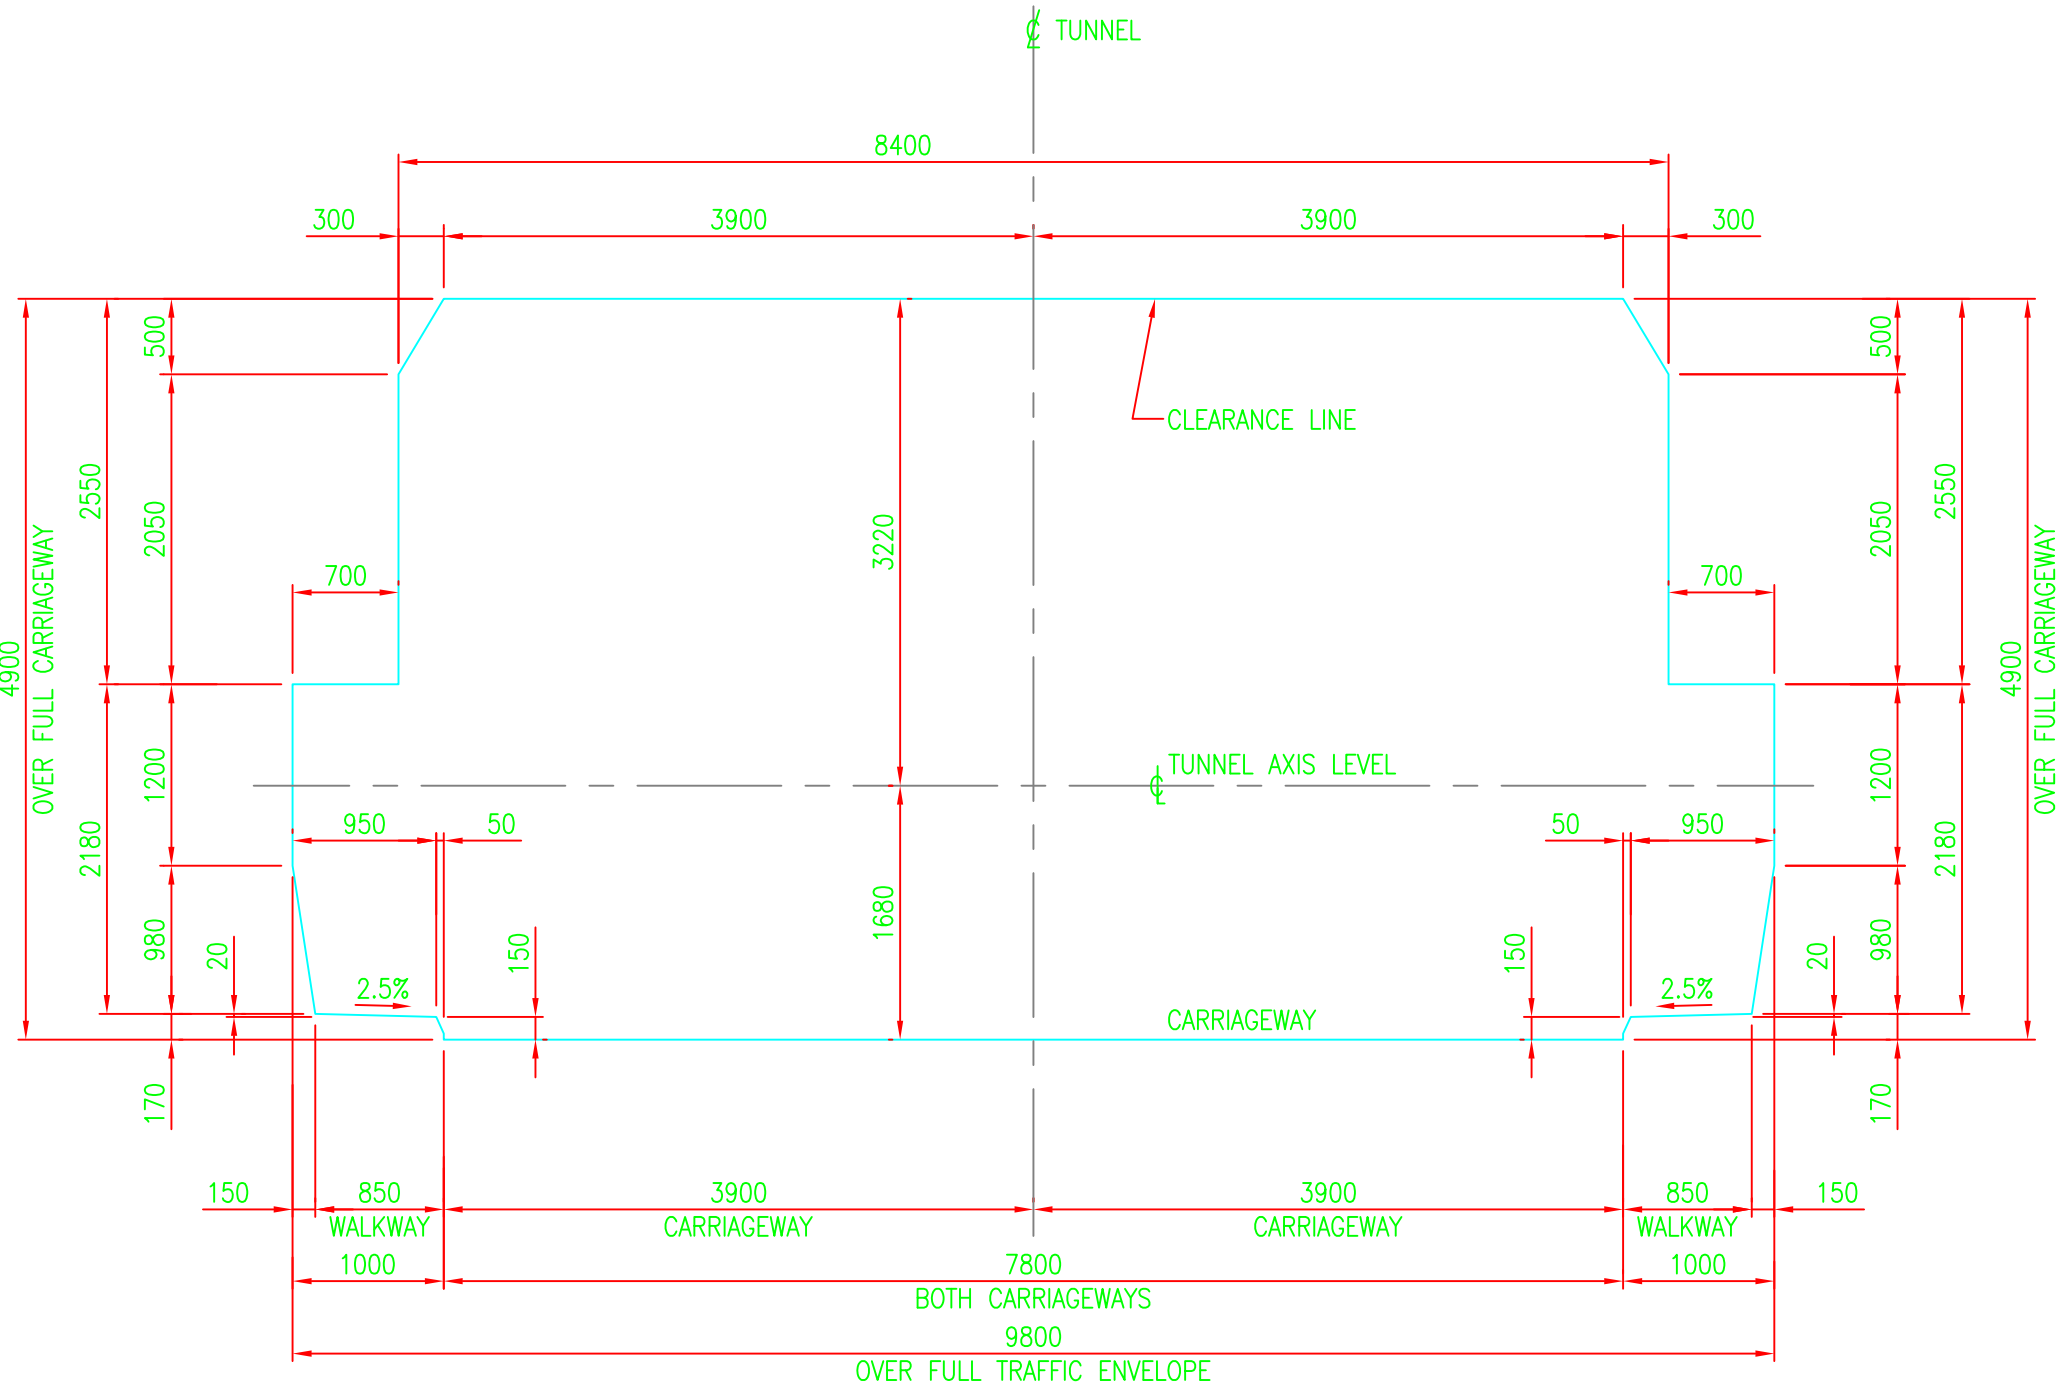

TRAFFIC ENVELOPE (BASED ON REFERENCE DESIGN CONTRACT DRAWING 26-03-TN-401)

SCALE 1:50

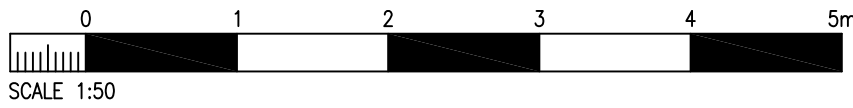

NOTES

1. NO ALLOWANCE FOR ROAD LAYING TOLERANCE IN SPECIFIED CLEARANCE. HOWEVER TOLERANCE ON ROAD SURFACE LEVEL TO BE ± 6 mm FROM DESIGN POSITION IN ACCORDANCE WITH TABLE 7/1 OF VOLUME 1 OF THE NRA SPECIFICATION FOR ROAD WORKS.
2. NO ALLOWANCE FOR ROAD RESURFACING
3. WALKWAYS FALL 2.5% TO HORIZONTAL, TOWARDS THE CARRIAGEWAY, IRRELEVANT OF ROAD SUPER ELEVATION. WALKWAY ENVELOPE ORIENTATED TO HORIZONTAL.
4. THIS DRAWING TO BE READ IN CONJUNCTION WITH DRAWING No DR/HA/BT/C11/41101.
5. TOLERANCE OF POSITION OF INNER LINING TO BE ± 50 mm IN ACCORDANCE WITH BTS MODEL SPECIFICATION FOR TUNNELLING (1997) CLAUSE 360.1.
6. MINIMUM STRENGTH OF CONCRETE TO BE 10N/mm^2 PRIOR TO STRIKING SECONDARY LINING SHUTTER.
7. FINISH TO CONCRETE TO BE F3 AS EMPLOYERS REQUIREMENTS VOLUME 3, PART 3, CLAUSE 3.16.6.15, AND COATED AS CLAUSE 3.16.6.16.
8. LINING TO BE COATED WITH CERAMICOAT REFER TO DRAWING No's :-
DR/HA/BT/C11/41054,41056,41061,41063.

07	9.11.06	CD	AS-BUILT ISSUE
06	-	MA	AS-BUILT CHANGES ADDED.
05	07.11.02	SJS	FOR CONSTRUCTION
04	15.07.02	GEG	NMI COMMENTS INCORPORATED
03	08.05.02	RJY	TRAFFIC ENVELOPE REALIGNED.
02	13.11.01	SRC	NMI COMMENTS INCORPORATED
01	18.09.01	BM	FIRST ISSUE

Work
Crd By

Date

By

Rev.

THE COPYRIGHT IN THIS DRAWING IS THE PROPERTY OF DUBLIN CORPORATION AND THE DRAWING MAY NOT BE REPRODUCED IN WHOLE OR IN PART, IN ANY FORM, WITHOUT THE WRITTEN PERMISSION OF DUBLIN CORPORATION.



BORED TUNNEL
TUNNEL ALIGNMENT SETTING
OUT RELATIVE TO
CARRIAGEWAY ALIGNMENT

Project No.	4958	Design Package	HWD 4.4.1
Drawing No.	DR/HA/BT/C11/41018/07/X		

Original Drawing Size : 594 x 841 – A1

BAR SCHEDULE

Haswell ■ Consulting Engineers

Bar Schedule Ref RS/HA/BT/C11/41513/06/C

0 7

Project No. 4958 – DUBLIN PORT TUNNEL

Drawing Ref DR/HA/BT/C11/41013

Package 10840 ID TUNNEL



Date Prepared 22/6/01

Date Revised 19/02/02

Structure PRECAST CONCRETE LINING

Prepared By NDA

Checked by LLJ

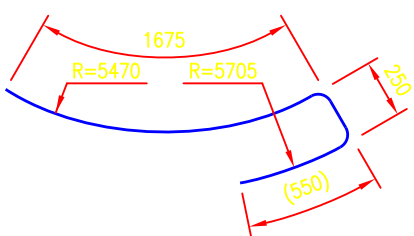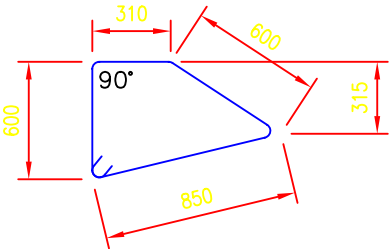Member	Bar mark	Type and size	No. of mbrs.	No. of bars in each	Total no.	Length of each bar ** mm	Shape code	A* mm	B* mm	C* mm	D* mm	E/R* mm
	26	T12		6	6	2425	99					
	35	T8		16	16	925	77	270	230			
	36	T12		4	4	1625	20					
	38	T16		1+1	2	1200	65	1200				5585
	39	T16		1+1	2	975	65	975				5585
NIB TO	28	T12	2	12	24	2500	99					
SEGMENTS												
3 and 5												
	29	T12		2	4	2250	38	1000	300	(1000)		
	30	T8		2	4	2300	38	930	470	(930)		
	31	T8		2	4	2450	38	930	625	(930)		
	32	T8		2x6x2	48	1050	38	460	175	(460)		
	33	T8		1+1	4	1625	20					

* Specified in multiples of 5mm. ** Specified in multiples of 25mm. (This schedule is based on BS 4466).



ORIENTATION OF 'TOP HAT' REINFORCEMENT



SEGMENT 3 – SIM. OPP. HAND



AS BUILT



SECTION F-F



SECTION F-F



PLAN ON TYPICAL SEGMENT DETAIL
STANDARD RING – TOP SEGMENT No. 6

- | CONFIRMED | | DATE | | TITLE / COMMENT | |
|-----------|----------|------|---|-----------------|--|
| 06 | - | SM | AS BUILT CHANGES ADDED | | |
| 07 | 19.02.02 | SM | DRAWING ISSUED FOR CONSTRUCTION | | |
| 06 | 02.02.02 | GRD | BARS MARKED 02.03.02, 40.41 AMENDED ON PLAN | | |
| 05 | 14.12.01 | SM | MINOR COMMENTS INCORPORATED. | | |
| 04 | 21.8.01 | FRD | MINOR AMENDMENTS AT NOC REQUEST. | | |
| 03 | 18.7.01 | FRD | NMC COMMENTS INCORPORATED. | | |
| 02 | 6.7.01 | FRD | NMC COMMENTS INCORPORATED. | | |
| Rev. | By | Date | By | Rev. | |

Project DUBLIN PORT TUNNEL

NISHIMATSU
MOWLEM
IRISHENCO

Haswell
Consulting Engineers

Carl Bro
Intelligent Solutions


HBI
 HAERTER AG

NRA NATIONAL ROADS AUTHORITY
An tOidear um Bóithre Náisiúnta

Client **Dublin Corporation**
Bárdas Átha Cliath



10840 I.D. TUNNEL PRECAST CONCRETE LINING STANDARD RING RC DETAILS

Scales: 1/25, 1:10			
Drawn: NDA	Issue: 22/05/01	Check:	Passed
Project No: 4958		Design Package: HWD 4.3	
Drawing No: DR/HA/BT/C11/41013/08/X			
Original Drawing Size: 594 x 841 - A1			



AS BUILT



1. ALL DIMENSIONS IN MILLIMETRES UNLESS NOTED OTHERWISE.
2. REFER TO NOTES ON DWG No. 41001.
3. THIS DRAWING TO BE READ IN CONJUNCTION WITH DWG Nos. 41001, 41002, 41003, 41004 & 41013.
4. THIS DRAWING SHOWS STANDARD POSITIONS FOR UP/DOWN CONFIGURATIONS. RING TO BE ROLLED TO 19 POSITIONS AS REQUIRED TO FOLLOW ALIGNMENT.

7	--	BM	AS BUILT CHANGES ADDED
06	9.02.02	SML	DRAWING ISSUED FOR CONSTRUCTION
05	22.8.01	GRD	MINOR AMENDMENTS AT NCC REQUEST.
04	17.7.01	NDA	FURTHER NMI COMMENTS INCORPORATED
03	5.7.01	PRD	NMI COMMENTS INCORPORATED
02	27.6.01	NDA	DEFINITIVE DESIGN
01	31.5.01	NDA	FIRST ISSUE
Work	Date	By	Rev

THE CONTENTS OF THIS JOURNAL IS THE PROPERTY OF BUREAU OF COMMERCE AND THE READING MAY NOT BE REPRODUCED IN WHOLE OR IN PART, IN ANY FORM, WITHOUT THE PERMISSION OF THE BUREAU OF COMMERCE AS A TRADE INFORMATION, WHICH MEANS THE BUREAU OF COMMERCE OF BUREAU OF COMMERCE.



Project **DUBLIN
PORT
TUNNEL**

NISHIMATSU
MOWLEM
IRISHENCO



Haswell
Consulting Engineers

Carl Bro 
Intelligent Solutions

HBI
HAERTER AG


NRA NATIONAL ROADS AUTHORITY
An tÚdarás um Bóithre Náisiúnta

Client: **Dublin Corporation**
Bárdas Átha Cliath




10840 I.D. TUNNEL PRECAST CONCRETE LINING TAPER RING CONFIGURATION FOR VERTICAL CURVES

Scales				1/50	
Tm.		Date		Dist.	
NDA		22/05/01		Passed	
Project No.			Design Package		
4958			HWD 4.3		
Drawing No.					
DR/HA/BT/C11/41012/07/X					
Original Drawing Size : 594 x 841 — A1					

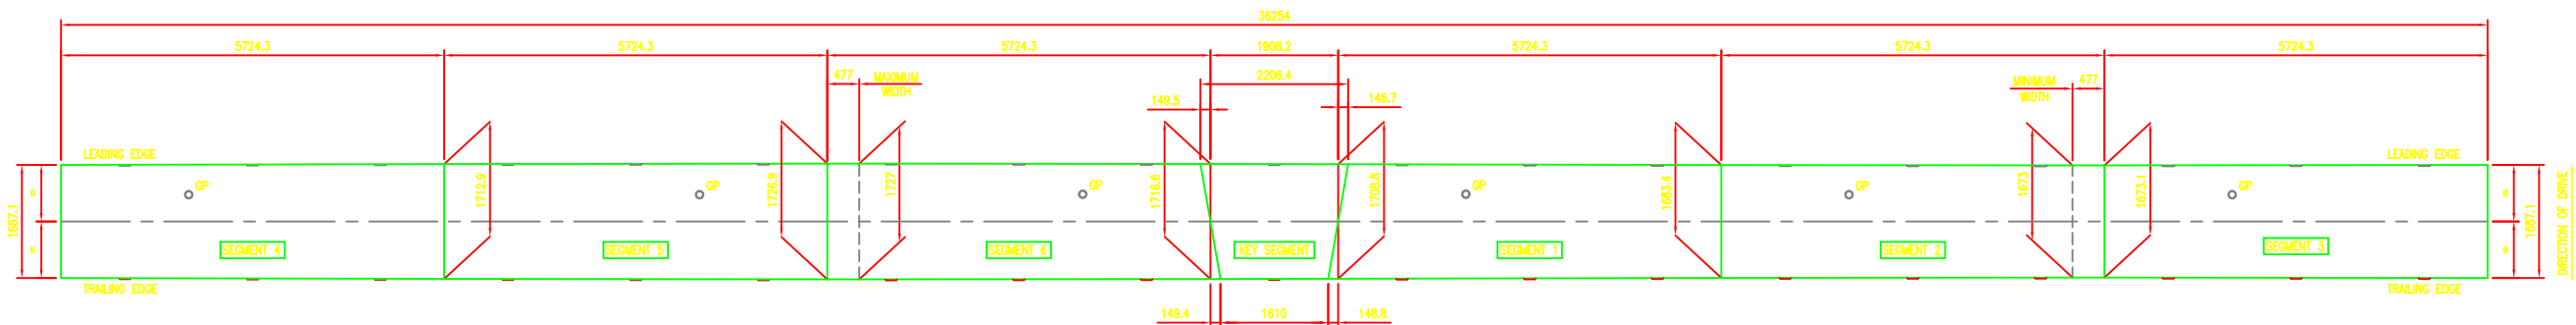


RIGHT-HAND TAPER RING - DEVELOPED VIEW ON EXTRADOS

SCALE 1:50

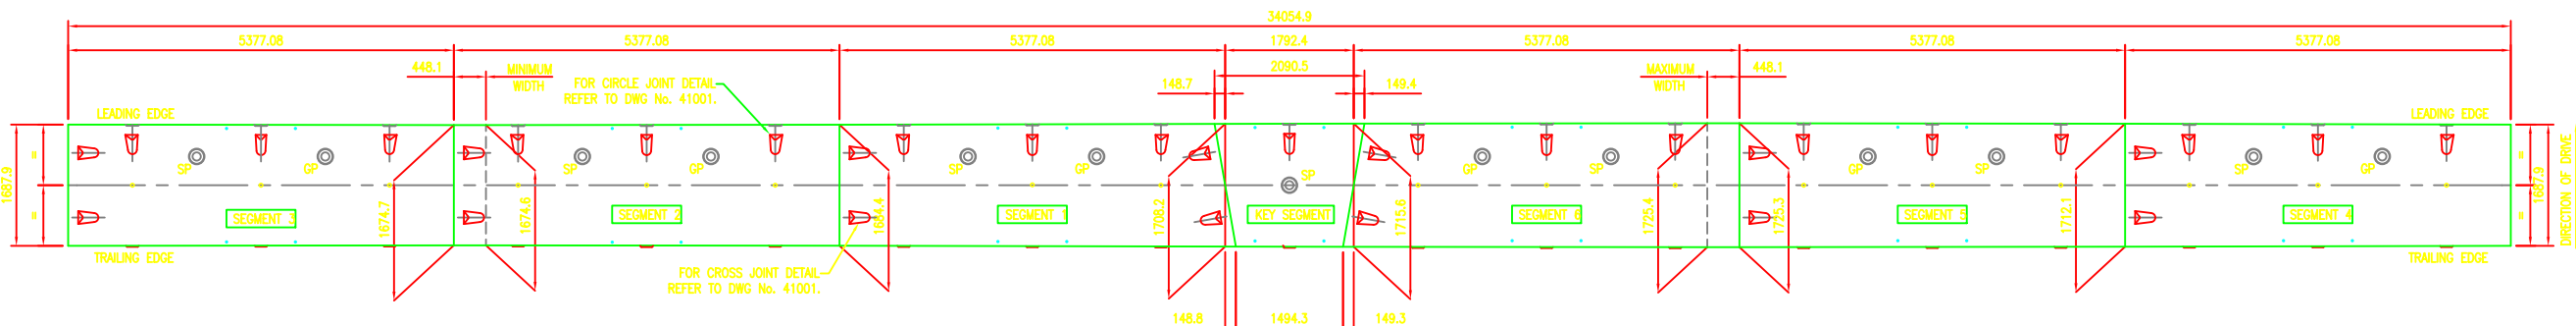


RIGHT-HAND TAPER RING - DEVELOPED VIEW ON INTRADOS

SCALE 1:50

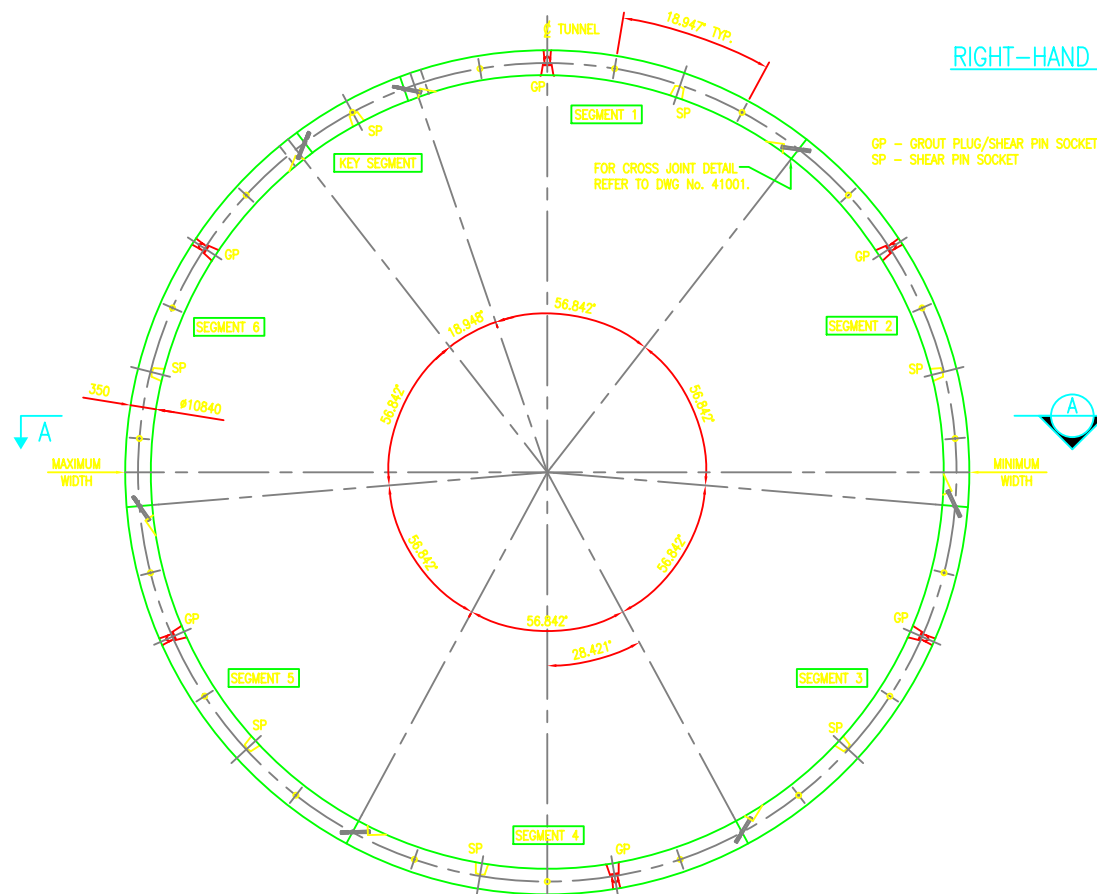


CROSS-SECTION
RIGHT-HAND TAPER RING - STANDARD KEY POSITION
(VIEW IN DIRECTION OF DRIVE)

SCALE 1:50

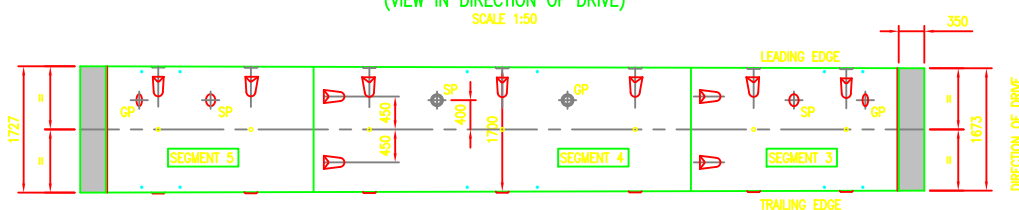


PLAN ON SECTION A-A - RIGHT-HAND TAPER RING

SCALE 1:50

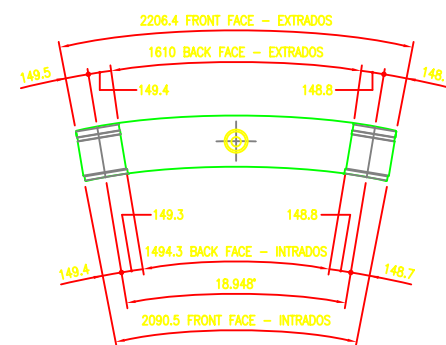


ELEVATION B-B

SCALE 1:25

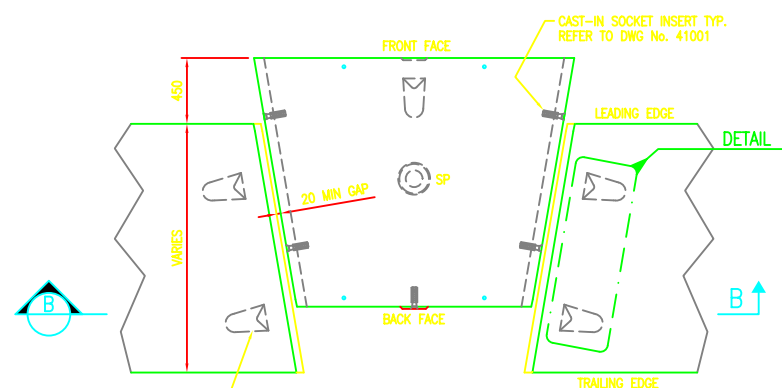


KEY SEGMENT VIEWED FROM ABOVE

SCALE 1:25

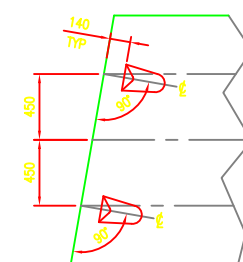

DETAIL 1
SETTING OUT OF BOLT POCKETS
ON TOP SEGMENTS

SCALE 1:25

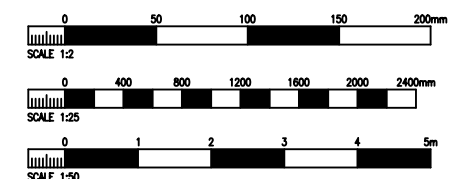

- NOTES
1. ALL DIMENSIONS IN MILLIMETRES UNLESS NOTED OTHERWISE.
 2. REFER TO NOTES ON DWG No. 41001.
 3. THIS DRAWING TO BE READ IN CONJUNCTION WITH DWG Nos. 41001, 41002, 41003, 41012 & 41013.

06	-	BM	AS BUILT CHANGES ADDED
07	9.02.02	SML	DRAWING ISSUED FOR CONSTRUCTION
06	2.2.02	GRD	AMPLE POSITIONS ON SEGMENT 3 (REVISED)
05	22.8.01	GRD	LABOR AMENDMENTS AT NOC REQUEST
04	5.7.01	PRD	NMI COMMENTS INCORPORATED
03	27.8.01	RJY	DEFINITIVE DESIGN
02	31.5.01	NDA	NMI COMMENTS INCORPORATED
01	14.05.01	NDA	NMI COMMENTS INCORPORATED
00	14.05.01	NDA	NMI COMMENTS INCORPORATED

Project
DUBLIN PORT TUNNEL

NISHIMATSU
MOWLEM
IRISHENCO

Haswell
Consulting Engineers

Carl Bro
Intelligent Solutions

HBI
HAERTER AG

NRA NATIONAL ROADS AUTHORITY
An tArdánas um Bóthar Náisiúnta

Client
Dublin Corporation
Bárdas Átha Cliath

Title
10840 I.D. TUNNEL
PRECAST CONCRETE LINING
RIGHT-HAND TAPER RING
GENERAL ARRANGEMENT

Scales
1/50, 1/25, 1/2








Rev
NDA 14/05/01

Project No
4958

Design Package
HWD 4.3

Drawing No
DR/HA/BT/C11/41004/08/X

Original Drawing Size : 594 x 841 - A1

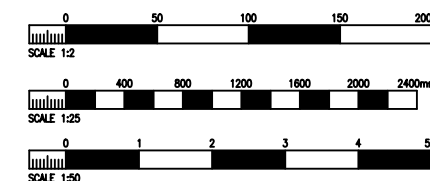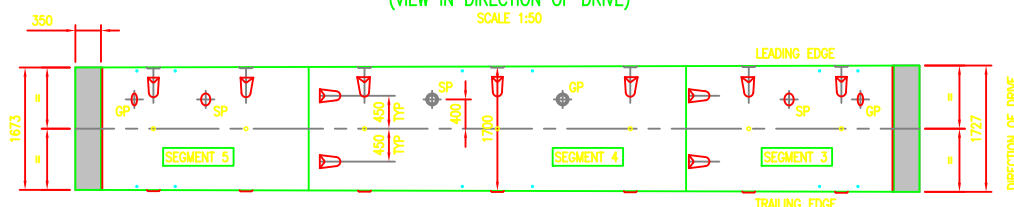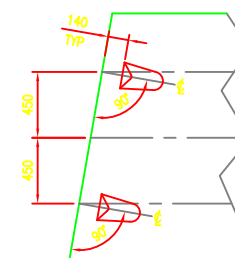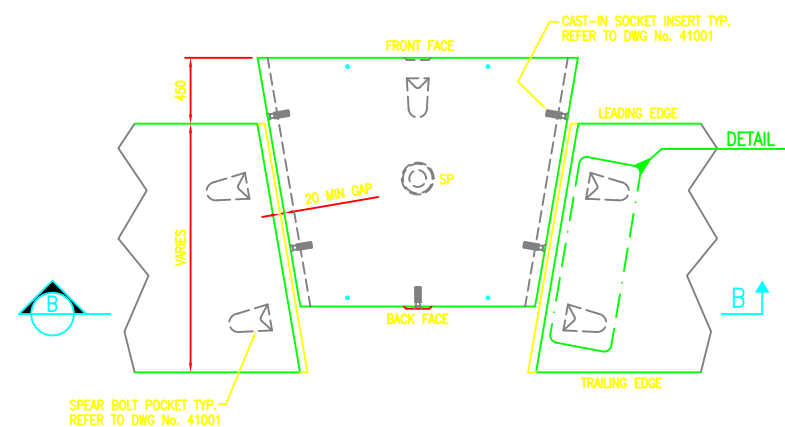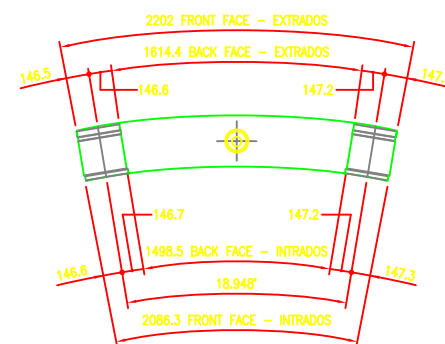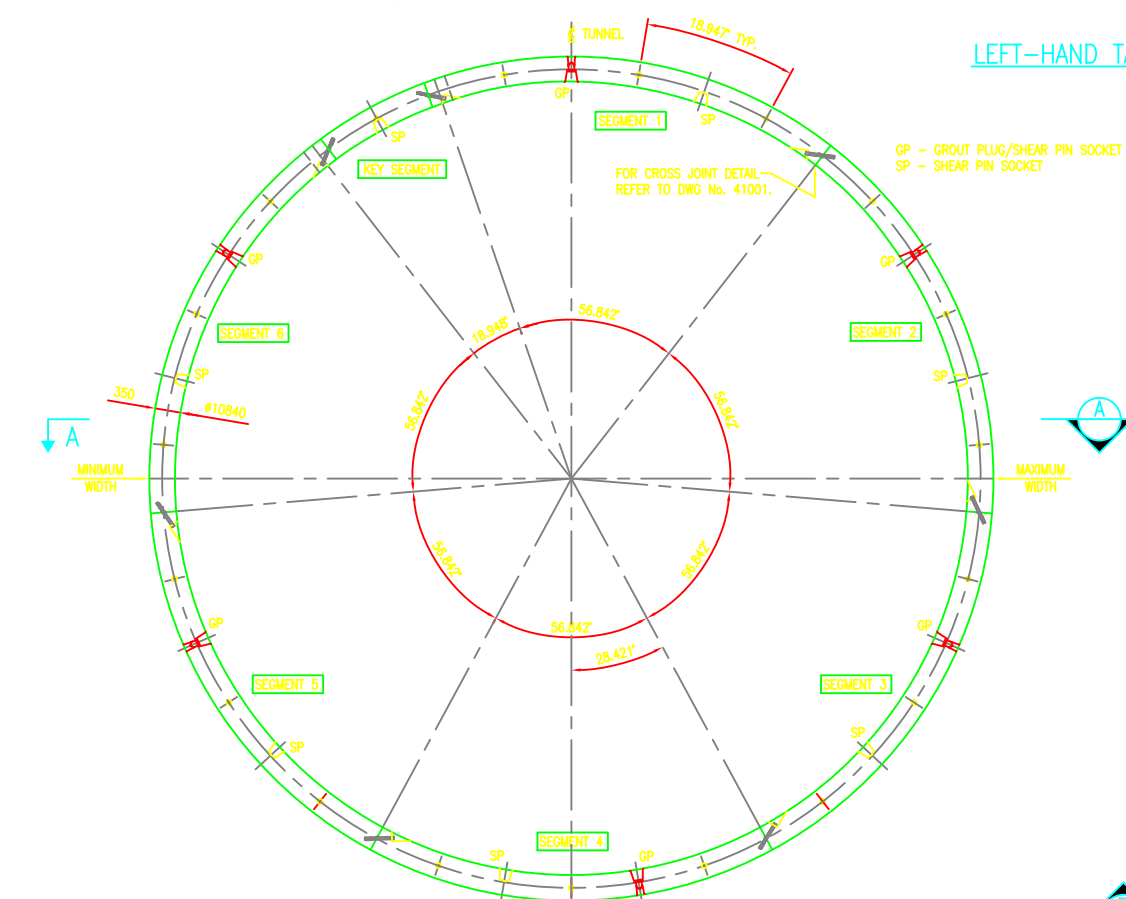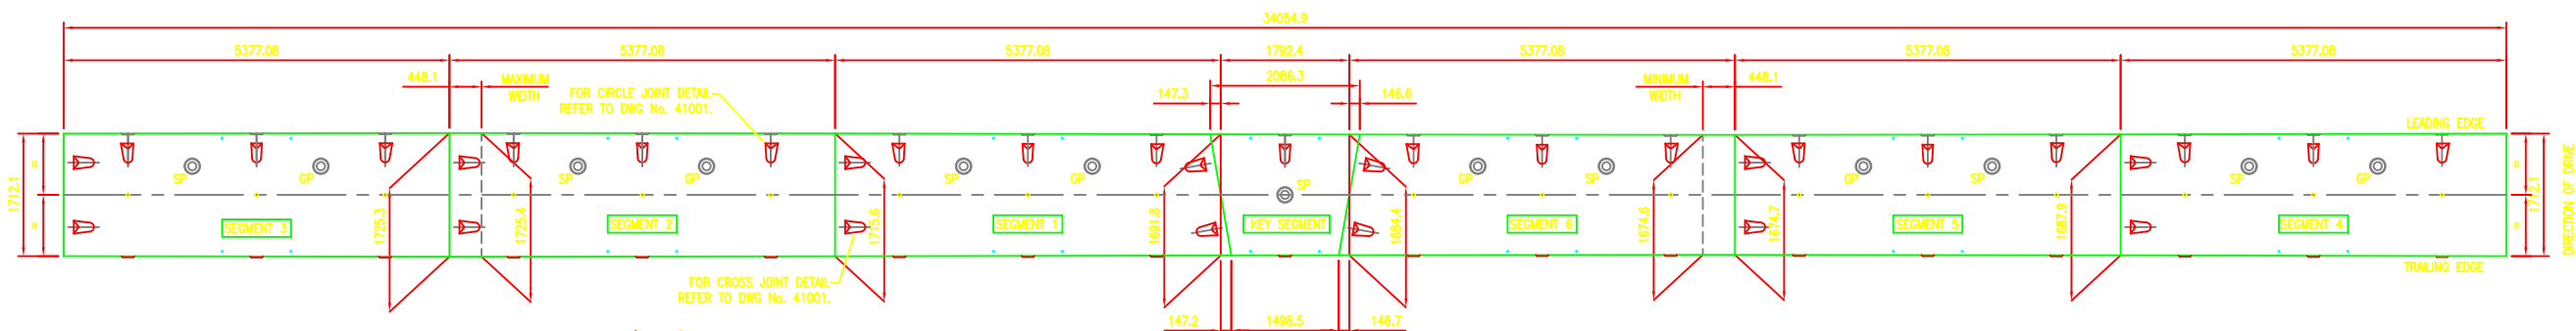

1. ALL DIMENSIONS IN MILLIMETRES UNLESS NOTED OTHERWISE.
2. REFER TO NOTES ON DWG No. 41001.
3. THIS DRAWING TO BE READ IN CONJUNCTION WITH DWG Nos. 41001, 41002, 41004, 41012 & 41013.

07	--	BM	AS BUILT CHANGES ADDED
06	9.02.02	SML	DRAWING ISSUED FOR CONSTRUCTION
05	22.8.01	GRD	MINOR AMENDMENTS AT MCC REQUEST
04	5.7.01	PRD	NMI COMMENTS INCORPORATED
03	27.6.01	RLY	DEFINITIVE DESIGN
02	31.5.01	NDA	NMI COMMENTS INCORPORATED
01	15.5.01	NDA	FIRST ISSUE
Rev	Date	By	Desc

THE COPYRIGHT IN THIS DRAWING IS THE PROPERTY OF INDIAN CONFERENCE AND THE DRAWING MAY NOT BE REPRODUCED IN WHOLE OR IN PART, IN ANY FORM, WHETHER BY PHOTOGRAPHY, PHOTOCOPYING OR REPRODUCTION AS A TRADE INSTRUMENTATION, WITHOUT THE WRITTEN PERMISSION OF INDIAN CONFERENCE.



Project **DUBLIN
PORT
TUNNEL**

NISHIMATSU
MOWLEM
IRISHENCO



Haswell
Consulting Engineers

Carl Bro
Intelligent Solutions

HBI
 HAERTER AG

NRA NATIONAL ROADS AUTHORITY
An tOideas um Bóithre Náisiúnta

Client
Dublin Corporation
Bárdas Átha Cliath



Title

10840 I.D. TUNNEL
PRECAST CONCRETE LINING
LEFT-HAND TAPER RING
GENERAL ARRANGEMENT

Scales			
1/50, 1/25, 1/2			
Item	Date	Onk	Passed
NDA	14/05/01		
Project No.		Design Package	
4958		HWD 4.3	

Drawing No. DR/HA/BT/C11/41003/07/X

Original Drawing Size : 594 x 841 – A1

NORTH BOUND.

EMERGENCY CALL NICHE.		
REFERENCE	ROAD CHAINAGE	
ECN/206	2114.196	
ECN/207	FOR DETAILS SEE WA2 SECTION	
ECN/208	2525.799	
ECN/209	2774.258	
ECN/210	FOR DETAILS SEE CLOISTERS LAYBY	
ECN/211	3187.849	
ECN/212	3438.029	
ECN/213	3689.960	
ECN/214	3929.979	
ECN/215	FOR DETAILS SEE MARINO LAYBY	
ECN/216	4391.297	

FIRE FIGHTING NICHE.		
REFERENCE	ROAD CHAINAGE	
FFN/18	2008.695	
FFN/19	2097.134	
FFN/20	FOR DETAILS SEE WA2 SECTION	
FFN/21	2360.804	
FFN/22	2508.819	
FFN/23	2610.925	
FFN/24	2757.262	
FFN/25	2859.359	
FFN/26	FOR DETAILS SEE CLOISTERS LAYBY	
FFN/27	3068.694	
FFN/28	3172.479	
FFN/29	3293.281	
FFN/30	3417.577	
FFN/31	3538.392	
FFN/32	3671.246	
FFN/33	3790.364	
FFN/34	3909.554	
FFN/35	4026.998	
FFN/35b	4134.231	
FFN/36	FOR DETAILS SEE MARINO LAYBY	
FFN/37	4265.317	
FFN/38	4372.564	
FFN/39	4486.613	

FFN/35b TO BE FINALISED

PEDESTRIAN CROSS PASSAGES.		
REFERENCE	ROAD CHAINAGE	
PCP/06A	2107.360	
PCP/07A	2517.779	
PCP/08A	2765.731	
PCP/09A	3179.928	
PCP/10A	3429.639	
PCP/11A	3677.900	
PCP/12A	3919.783	
PCP/13A	4379.454	

HOSE REEL NICHE.		
REFERENCE	ROAD CHAINAGE	
HRN/17a	1951.708	
HRN/18a	2050.385	
HRN/19a	2150.715	
HRN/19b	2200.065	
HRN/20a	2302.090	
HRN/21a	2407.594	
HRN/21b	2451.818	
HRN/22a	2552.219	
HRN/23a	2659.42	
HRN/23b	2710.464	
HRN/24a	2802.347	
HRN/25a	2901.005	
HRN/25b	2943.521	
HRN/26a	FOR DETAILS SEE CLOISTERS LAYBY	
HRN/27a	3129.041	
HRN/28a	3227.75	
HRN/29a	3333.277	
HRN/29b	3375.847	
HRN/30a	3479.699	
HRN/31a	3592.118	
HRN/31b	3641.473	
HRN/32a	3731.665	
HRN/33a	3837.218	
HRN/33b	3881.478	
HRN/34a	3964.868	
HRN/35a	4084.035	
HRN/36a	FOR DETAILS SEE MARINO LAYBY	
HRN/37a	4301.949	
HRN/37b	4337.692	
HRN/38a	4432.995	
HRN/39a	FOR DETAILS SEE CUT & COVER SECTION	

SOUTH BOUND.

EMERGENCY CALL NICHE.		
REFERENCE	ROAD CHAINAGE	
ECN/104	1912.178	
ECN/105	2097.667	
ECN/106	FOR DETAILS SEE WA2 SECTION	
ECN/107	2504.138	
ECN/108	2752.532	
ECN/109	FOR DETAILS SEE CLOISTERS LAYBY	
ECN/110	3157.529	
ECN/111	3397.464	
ECN/112	3644.235	
ECN/113	3896.221	
ECN/114	FOR DETAILS SEE MARINO LAYBY	
ECN/115	4378.050	

FIRE FIGHTING NICHE.		
REFERENCE	ROAD CHAINAGE	
FFN/18	2000.648	
FFN/19	2114.664	
FFN/20	FOR DETAILS SEE WA2 SECTION	
FFN/21	2403.718	
FFN/22	2526.267	
FFN/23	2650.520	
FFN/24	2771.264	
FFN/25	2886.940	
FFN/26	FOR DETAILS SEE CLOISTERS LAYBY	
FFN/27	3084.333	
FFN/28	3176.254	
FFN/29	3296.988	
FFN/30	3417.828	
FFN/31	3542.130	
FFN/32	3664.723	
FFN/33	3788.978	
FFN/34	3914.949	
FFN/35	4035.831	
FFN/35b	4143.057	
FFN/36	FOR DETAILS SEE MARINO LAYBY	
FFN/37	4267.374	
FFN/38	4391.672	
FFN/39	4486.960	

PEDESTRIAN CROSS PASSAGES.		
REFERENCE	ROAD CHAINAGE	
PCP/06	2107.355	
PCP/07	2515.495	
PCP/08	2763.305	
PCP/09	3166.134	
PCP/10	3409.894	
PCP/11	3655.831	
PCP/12	3907.717	
PCP/13	4384.813	

HOSE REEL NICHE.		
REFERENCE	ROAD CHAINAGE	
HRN/17a	1945.411	
HRN/18a	2054.286	
HRN/19a	2154.700	
HRN/19b	2198.942	
HRN/20a	2316.176	
HRN/20b	2360.421	
HRN/21a	2467.554	
HRN/22a	2588.339	
HRN/23a	2710.893	
HRN/24a	2828.245	
HRN/25a	2940.637	
HRN/26a	3042.643	
HRN/27a	3129.437	
HRN/28a	3236.609	
HRN/29a	3357.436	
HRN/30a	3479.972	
HRN/31a	3604.233	
HRN/32a	3730.236	
HRN/33a	3830.667	
HRN/33b	3871.542	
HRN/34a	3975.416	
HRN/35a	4089.457	
HRN/36a	4223.943	
HRN/37a	4312.496	
HRN/37b	4349.920	
HRN/38a	4433.335	

VEHICLE CROSS PASSAGES AND ELECTRICAL NICHEs
NOT INCLUDED IN SCHEDULE

AS BUILT

NOTES

1. NICHE AND CROSS PASSAGE LOCATIONS BASED ON DRAWINGS DR/CB/PRO/C01/74039/03/0, THRU. 74042 INCLUSIVE.

2. DETAILS OF CUT AND COVER WORKS WITHIN SHAFT WA2 INDICATIVE ONLY.

3. DRAWINGS TO BE READ IN CONJUNCTION WITH DRAWINGS DR/HA/BT/C11/41050 AND 41051 DR/HA/BT/C11/41121 – 41130

4. ACTUAL LOCATION OF CROSS PASSAGE AND NICHEs TO SUIT AS BUILT SEGMENT LAYOUT AND POSITION OF PEDESTRIAN CROSS PASSAGES ±0.85m

5. FIRE FIGHTING AND EMERGENCY CALL NICHEs TO OFFSET FROM CROSS PASSAGES BY APPROXIMATELY 5 TO 7m FROM THE CENTRE LINE OF CROSS PASSAGES TO SUIT DESIGN AND CONSTRUCTION CONSIDERATIONS.

6. FFN NOT ADJACENT TO CROSS PASSAGE SHOULD BE LOCATED BETWEEN THOSE WHICH ARE ADJACENT TO MAINTAIN THE REQUIRED OF NO MORE THAN 150 METRES.

7. THE SPACING OF PCP IS A MAXIMUM OF 250 METRES.

8. ECN, FFN, HRN, AND PCP LOCATIONS ARE BASED ON ROAD ALIGNMENT

9. THE LEVELS & TUNNEL GRADES (SOUTHBOUND) USED IN THIS DRAWING FOR REVISION 12 HAVE BEEN BASED ON 137W ALIGNMENT.

13

–

BM

AS BUILT CHANGES ADDED

12

16.04.04

SRC

ECN, HRN AND FFN TABLES AMENDED FOR SOUTHBOUND

11

24.10.03

SRC

ISSUED FOR NMI REVIEW
PCP TABLES AMENDED TO FCR 38379,
ECN, FFN, HRN TABLES REVISED
FFN/35b ADDED, LAYBYs RELOCATED

10

14.05.03

GEG

NICHEs ADDED & REMOVED – PCP's ALTERED

09

20.11.02

GEG

ISSUED FOR CONSTRUCTION

08

2.10.02

GEG

NICHE POSITIONS UPDATED

07

1.7.02

PRD

ISSUED FOR B&R APPROVAL. NMI COMMENTS INCORPORATED. MINOR AMENDMENTS.

06

31.5.02

GEG

ISSUED FOR NMI REVIEW

05

27.5.02

GEG

PCP/08 SOUTH BOUND CHAINAGE REVISED AND TUNNEL CHAINAGES ADDED

Mark
Ctd By

Date

By

Rev.

Project

DUBLIN
PORT
TUNNEL

mm

Consortium

NISHIMATSU
MOWLEM
IRISHENCO

Haswell

Consulting Engineers

Carl Bro

Intelligent Solutions

CG

HAERTER AG

HBI

NRA

NATIONAL ROADS AUTHORITY

An údarás um Beithre Náisiúnta

Dublin City Council

Comhairle Cathrach Bhaile Átha Cliath

Title

BORED TUNNEL
THEORETICAL CHAINAGE
SCHEDULE OF NICHE AND
CROSS PASSAGE LOCATIONS

Scales

–

Dm.

RdY

Date

27/9/01

Chd.

Passed

Project No.

4958


Design Package

HWD 4.5

Drawing No.


DR/HA/BT/C11/41052/13/X

Original Drawing Size : 594 x 841 – A1

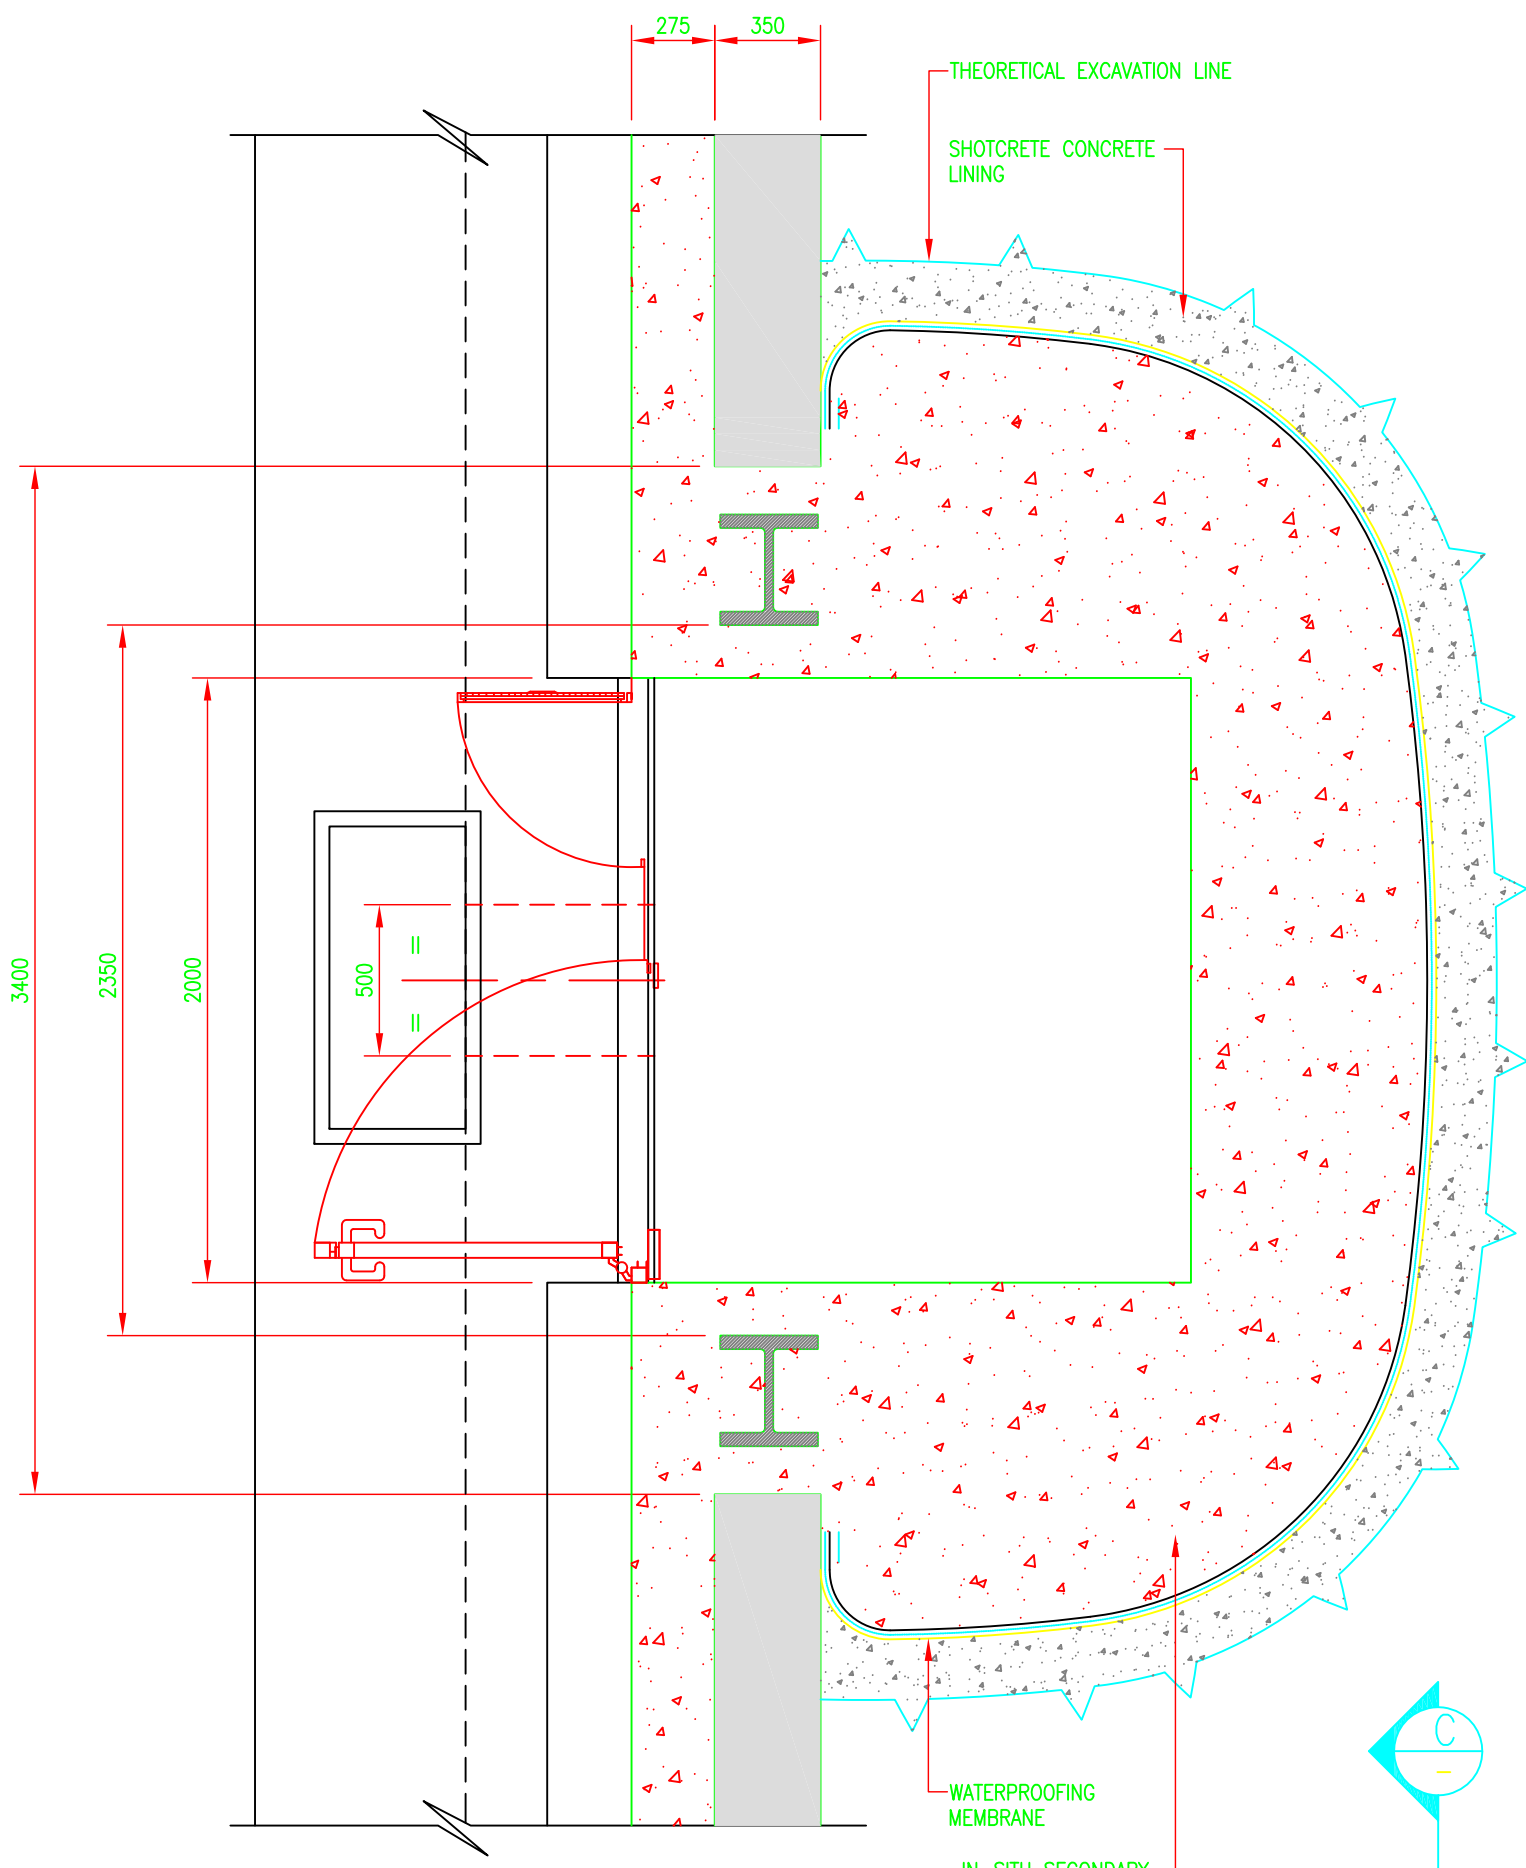


SECTION A-A
Scale 1: 25

FOR DOOR DETAILS
REFER TO DRG:
DR/CB/PRD/CO1/76885

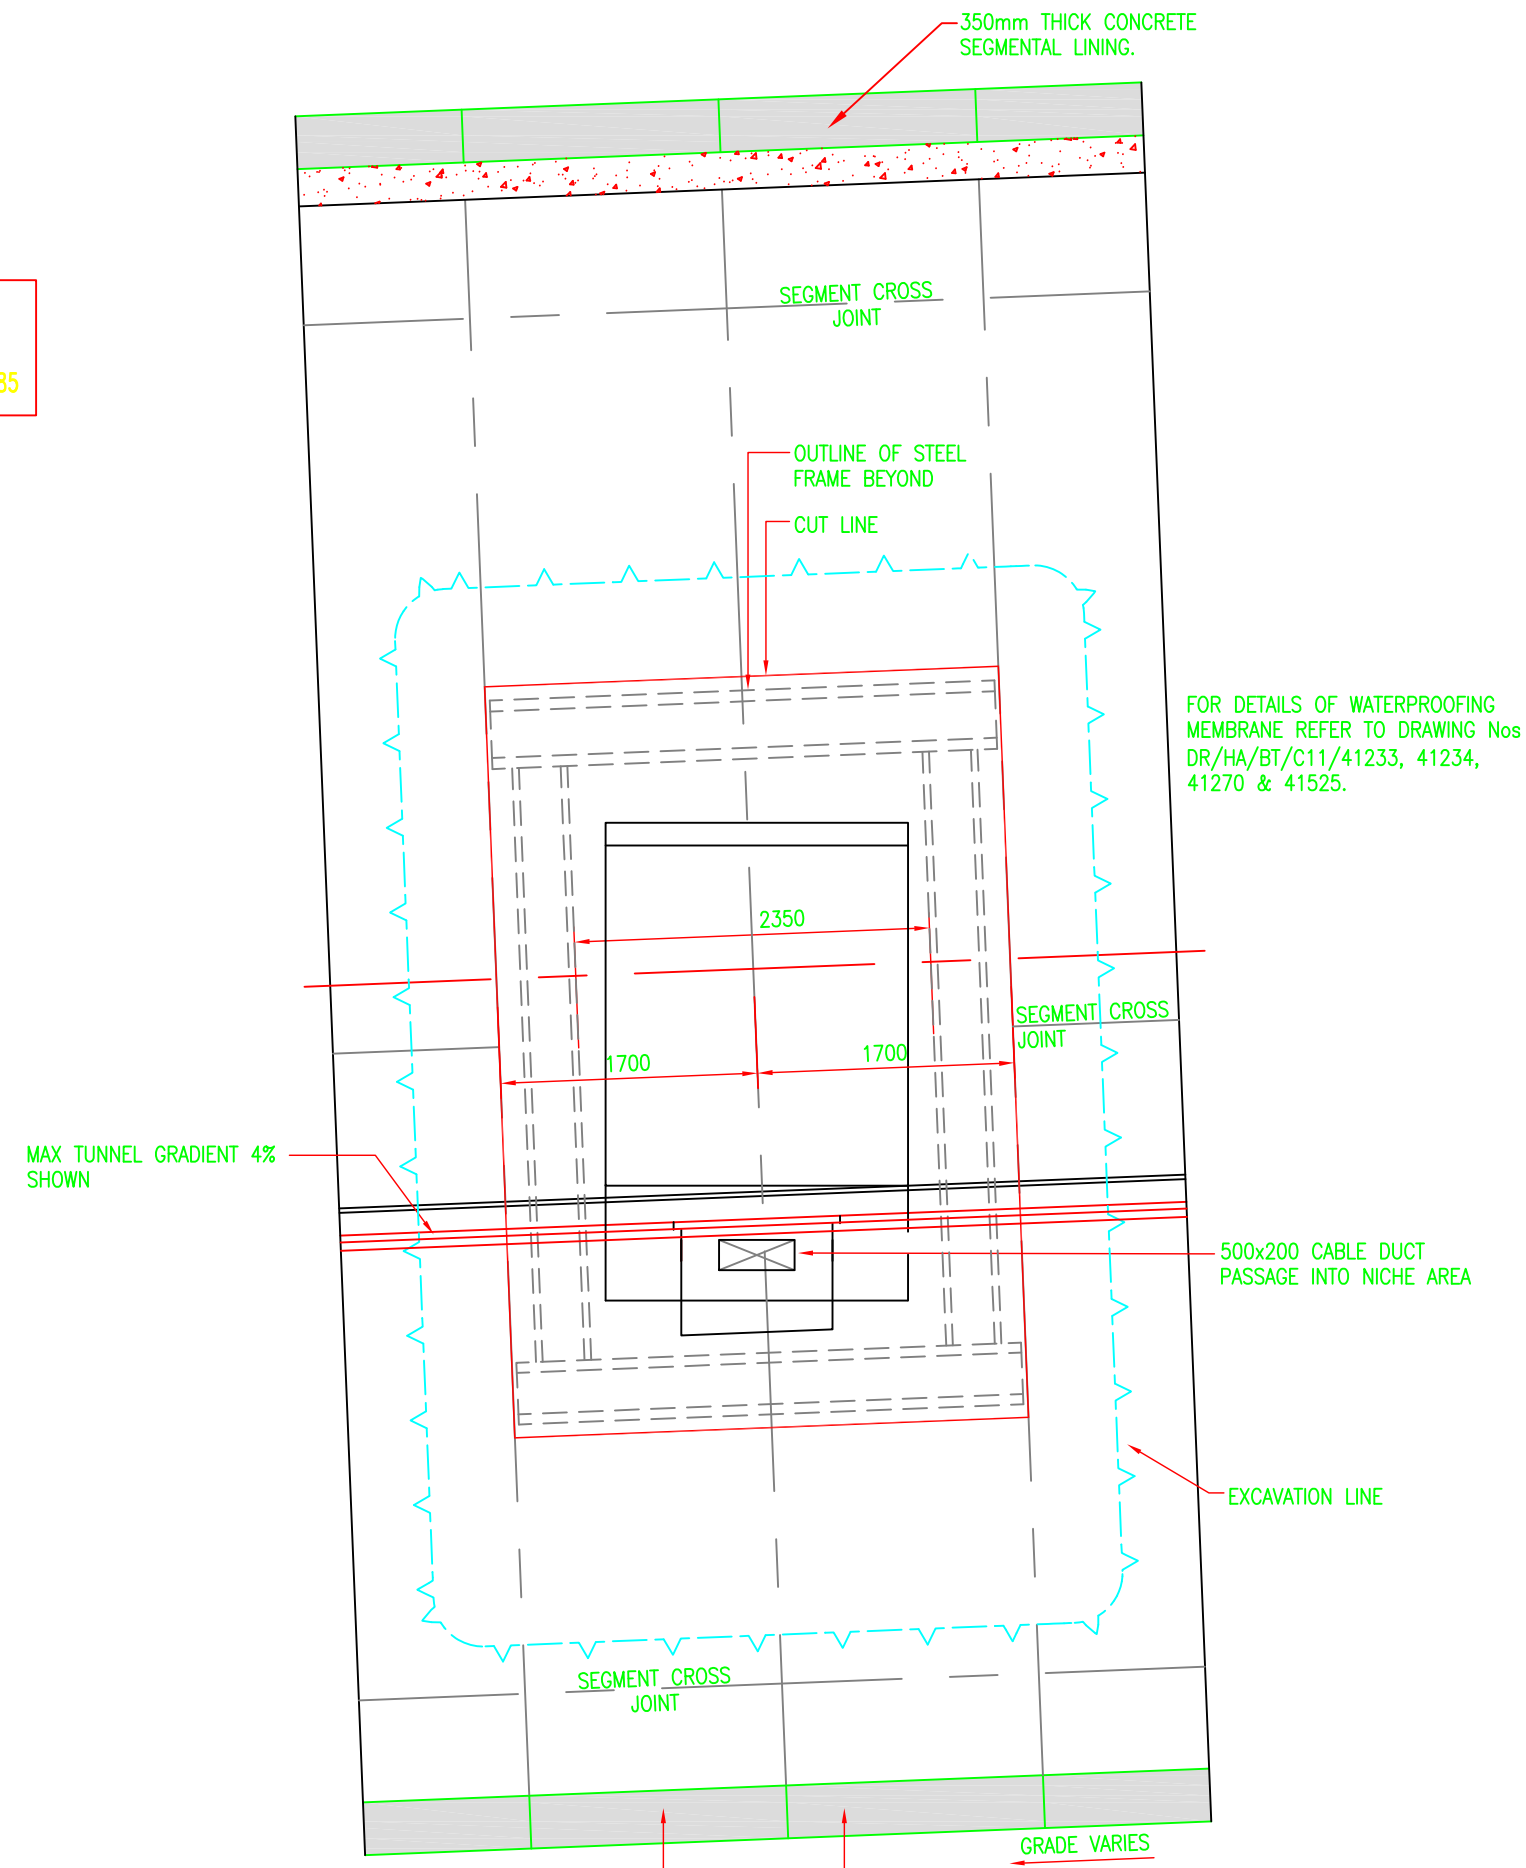


SECTION C-C
Scale 1: 50

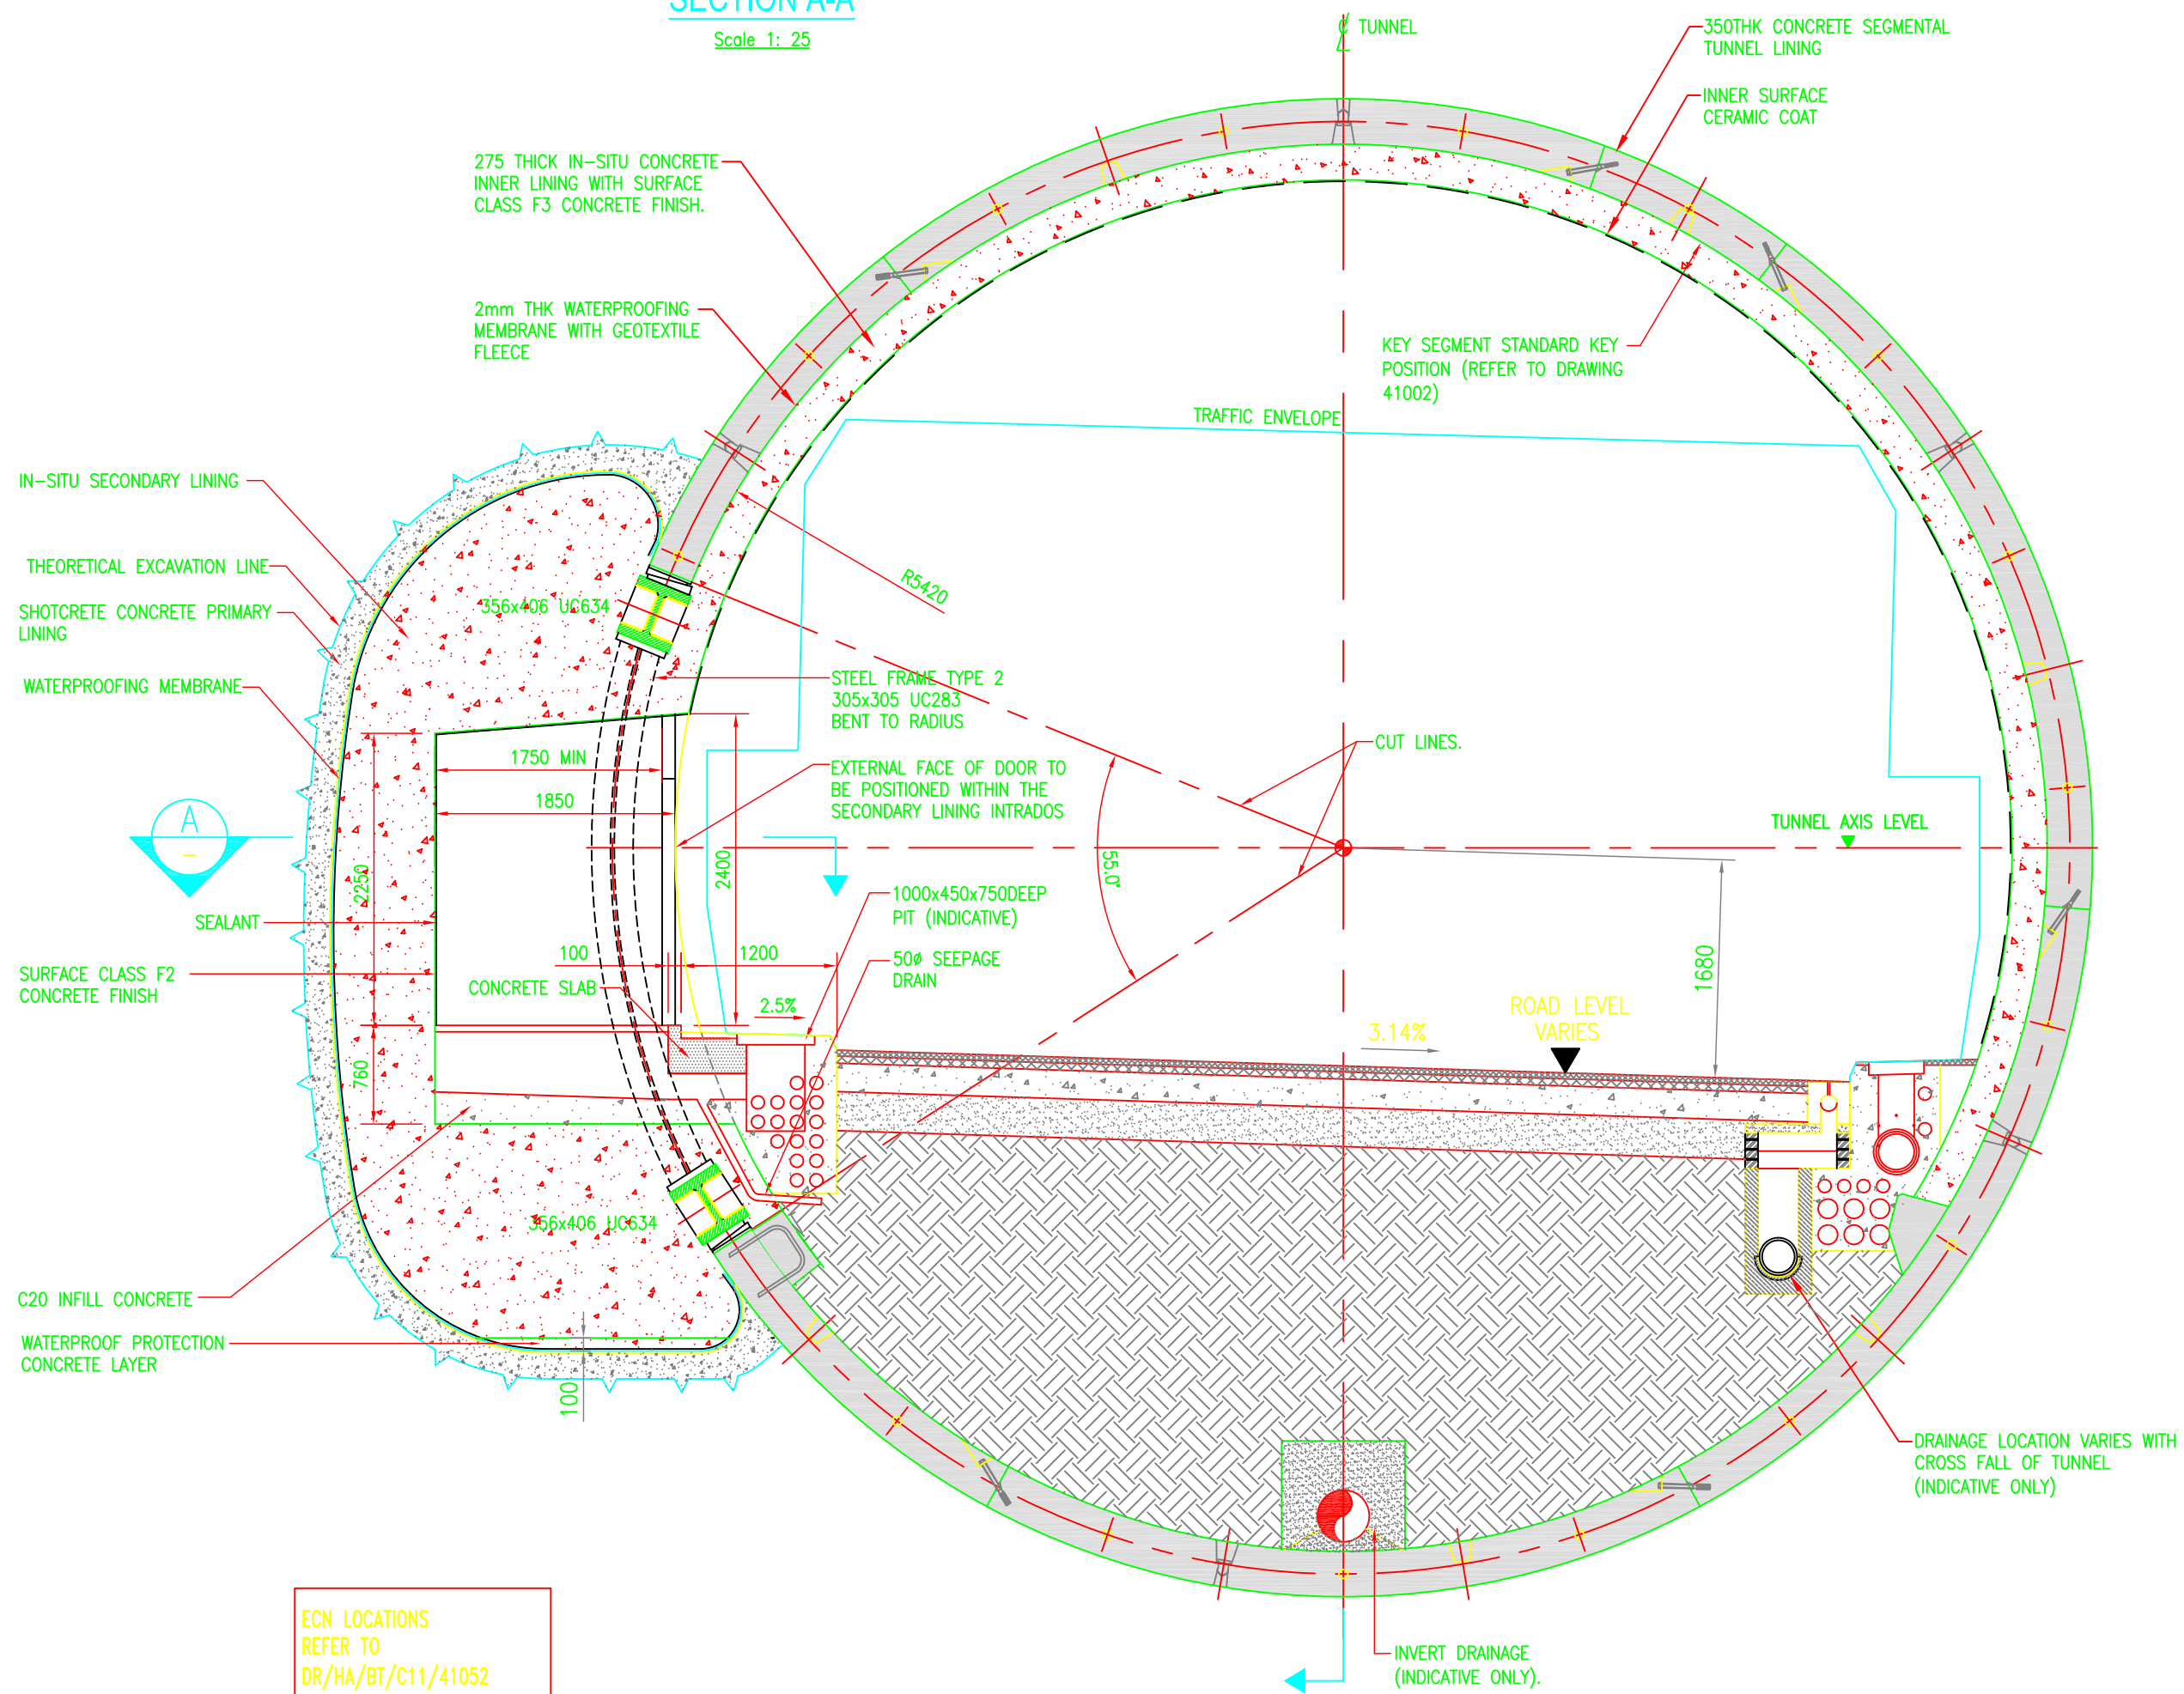


NORTHBOUND TUNNEL
CROSS SECTION IN DIRECTION OF TRAFFIC
Scale 1: 50

ECN LOCATIONS
REFER TO
DR/HA/BT/C11/41052

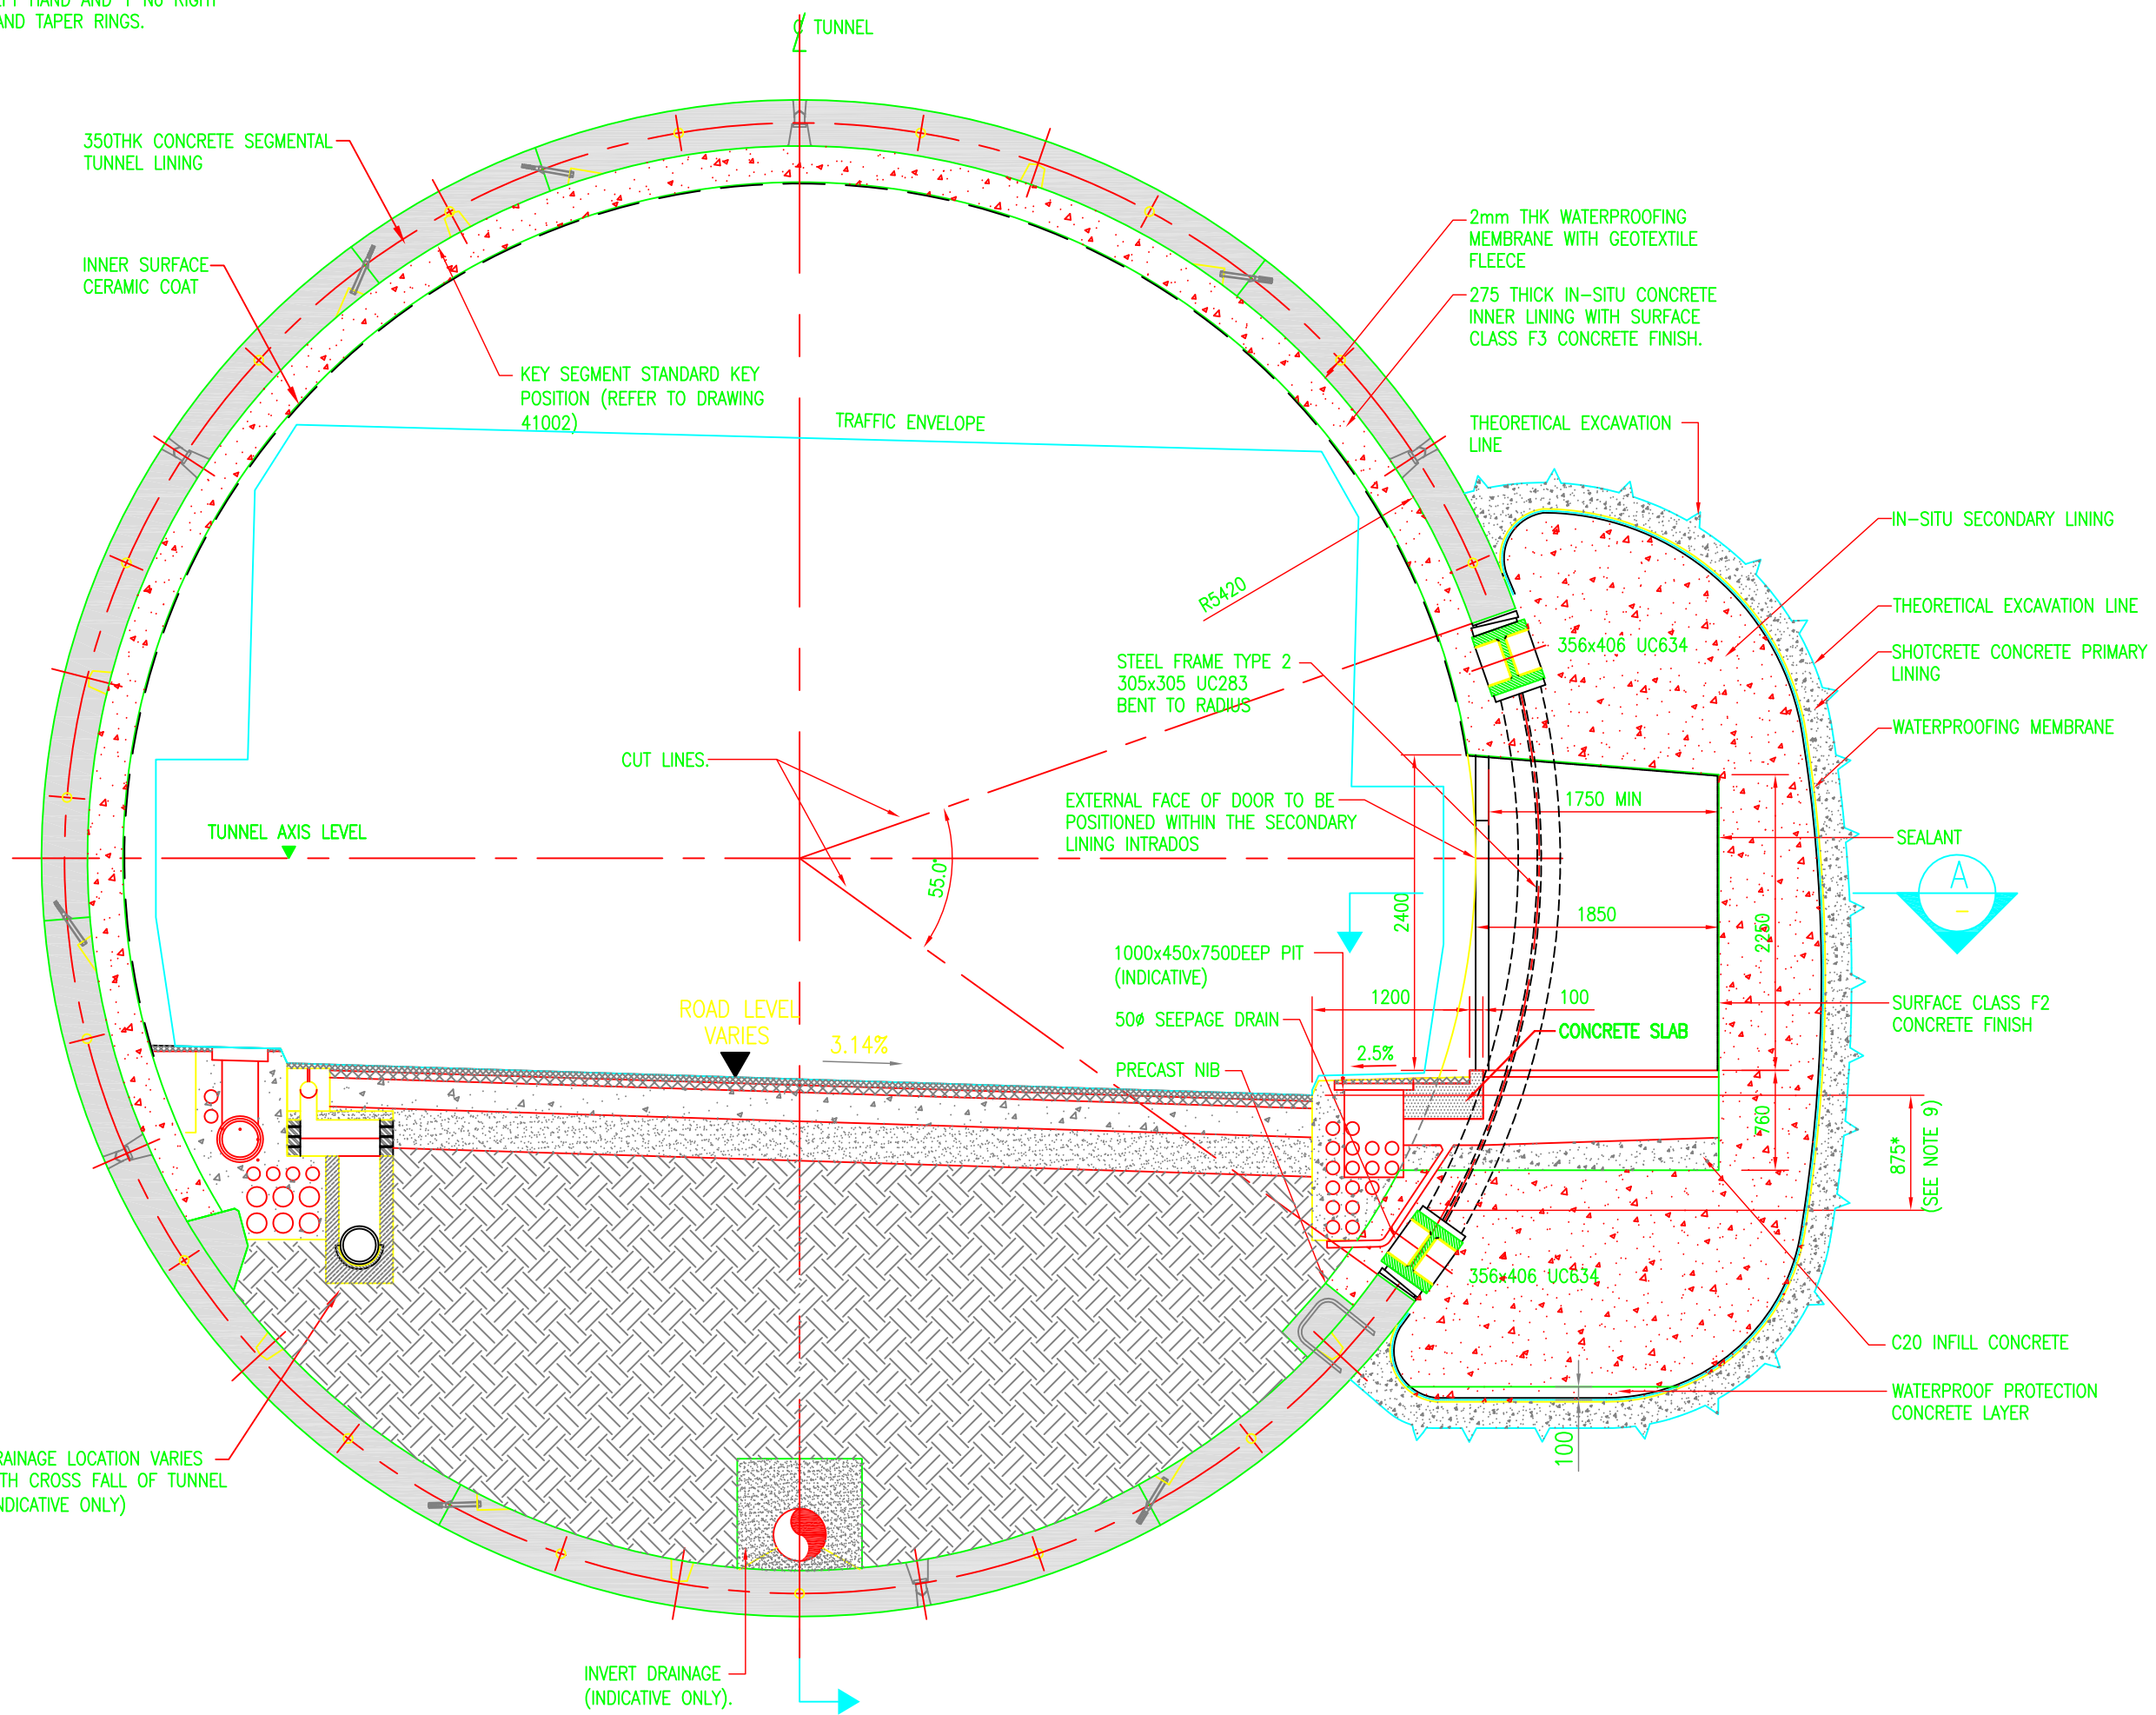

SOUTHBOUND TUNNEL
CROSS SECTION AGAINST DIRECTION OF TRAFFIC
Scale 1: 50

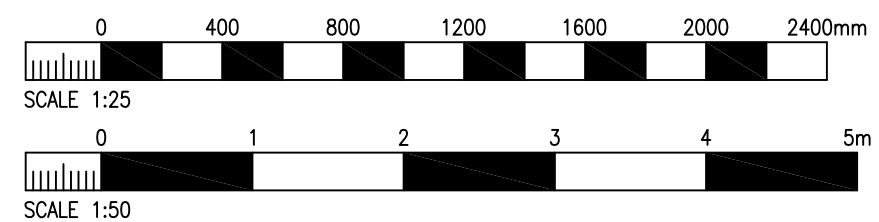


AS-BUILT

NOTES:

1. THIS DRAWING TO BE READ IN CONJUNCTION WITH
DR/HA/BT/C11/41121 - 41130 (INCLUSIVE)
DR/HA/BT/C11/41525
DR/HA/BT/C11/41052
DR/HA/BT/C11/41060
DR/HA/BT/C11/41228 & 41234
2. ALL DIMENSIONS SHOWN ON THIS DRAWING ARE IN MILLIMETRES.
3. ALL STRUCTURAL STEEL TO BE GRADE S355.
4. IN-SITU SECONDARY CONCRETE COMPRESSIVE STRENGTH
40N/mm².
5. FOR DETAILS OF STEELWORK FRAME REFER TO DRAWING
No DR/HA/BT/C11/41060.
6. CARRIAGEWAY SERVICES ARE SHOWN AS INDICATIVE ONLY.
7. THE POSITION OF KEY SEGMENTS ARE OPPOSITE TO OPENING
POSITIONS. UNLESS AS STATED IN NCR 39403.
8. FOR DETAILS OF REINFORCEMENT TO SECONDARY LINING
REFER TO DRAWING DR/HA/BT/C11/41201.

12	16.11.06	CD	AS-BUILT ISSUE
11	09.05.05	MB	AS BUILT
10	24.10.03	SJS	ISSUED FOR NMI REVIEW NOTES ADDED
09	14.5.03	SRC	PROTECTION CONCRETE TO INVERT ADDED
08	20.11.02	GEG	ISSUED FOR CONSTRUCTION
07	1.7.02	PRD	ISSUED FOR BROWN & ROOT APPROVAL. NMI COMMENTS INCORPORATED.
06	31.05.02	SML	ISSUED FOR NMI REVIEW
05	27.05.02	SML	MAJOR AMENDMENTS
Work Crd By	Date	By	Rev.
THE COPYRIGHT IN THIS DRAWING IS THE PROPERTY OF DUBLIN CORPORATION AND THE DRAWING MAY NOT BE REPRODUCED IN WHOLE OR IN PART, IN ANY FORM, WITHOUT THE WRITTEN PERMISSION OF DUBLIN CORPORATION. BY A THIRD PARTY WITHOUT THE WRITTEN PERMISSION OF DUBLIN CORPORATION.			

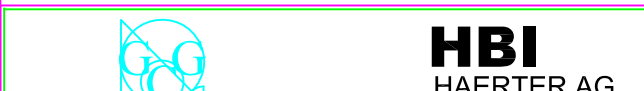

Title

BORED TUNNEL
TYPICAL
EMERGENCY CALL NICHE
GENERAL ARRANGEMENT

Scales	1:25 1:50		
Dm.	Date	Chd.	Passed
SRC	22/10/01		
Project No.	Design Package		
4958	HWD 4.5		
Drawing No.	DR/HA/BT/C11/41054/12/X		
Original Drawing Size : 594 x 841 - A1			

AS BUILT



- NOTES:
1. THIS DRAWING TO BE READ IN CONJUNCTION WITH
DR/HA/BT/C11/41121 - 41130 (INCLUSIVE)
DR/HA/BT/C11/41525
DR/HA/BT/C11/41052
DR/HA/BT/C11/41060
DR/HA/BT/C11/41230 & 41234
 2. ALL DIMENSIONS SHOWN ON THIS DRAWING ARE IN MILLIMETRES.
 3. ALL STRUCTURAL STEEL TO BE GRADE S355.
 4. IN-SITU SECONDARY CONCRETE COMPRESSIVE STRENGTH 40N/mm².
 5. FOR DETAILS OF STEELWORK FRAME REFER TO DRAWING No DR/HA/BT/C11/41060.
 6. CARRAGEWAY SERVICES SHOWN AS INDICATIVE ONLY.
 7. THE POSITION OF KEY SEGMENTS ARE OPPOSITE TO OPENING POSITIONS. UNLESS AS STATED IN NCR 39403.
 8. FOR DETAILS OF REINFORCEMENT TO SECONDARY LINING REFER TO DRAWING DR/HA/BT/C11/41202 & 41205.

12	16.11.06	CD	AS-BUILT ISSUE
11	06.05.05	MB	AS BUILT
10	24.10.03	SJS	ISSUED FOR NMI REVIEW NOTES ADDED, DOOR DELETED
09	14.5.03	SRC	PROTECTION CONCRETE TO INVERT ADDED
08	20.11.02	GEG	ISSUED FOR CONSTRUCTION
07	1.7.02	PRD	ISSUED FOR BROWN & ROOT APPROVAL. NMI COMMENTS INCORPORATED.
06	31.05.02	SML	ISSUED FOR NMI REVIEW
05	27.05.02	SML	MAJOR AMENDMENTS
04	28.03.02	SML	MAJOR REVISIONS TO FRAME & NICHE
Work Ctd By	Date	By	Rev.







BORED TUNNEL
TYPICAL
FIRE FIGHTING NICHE
GENERAL ARRANGEMENT

Scales		1:50	
Dm	Date	Chd.	Passed
SRC 01/10/01			
Project No.	4958	Design Package	HWD 4.5
Drawing No.			
DR/HA/BT/C11/41056/12/X			
Original Drawing Size : 594 x 841 - A1			

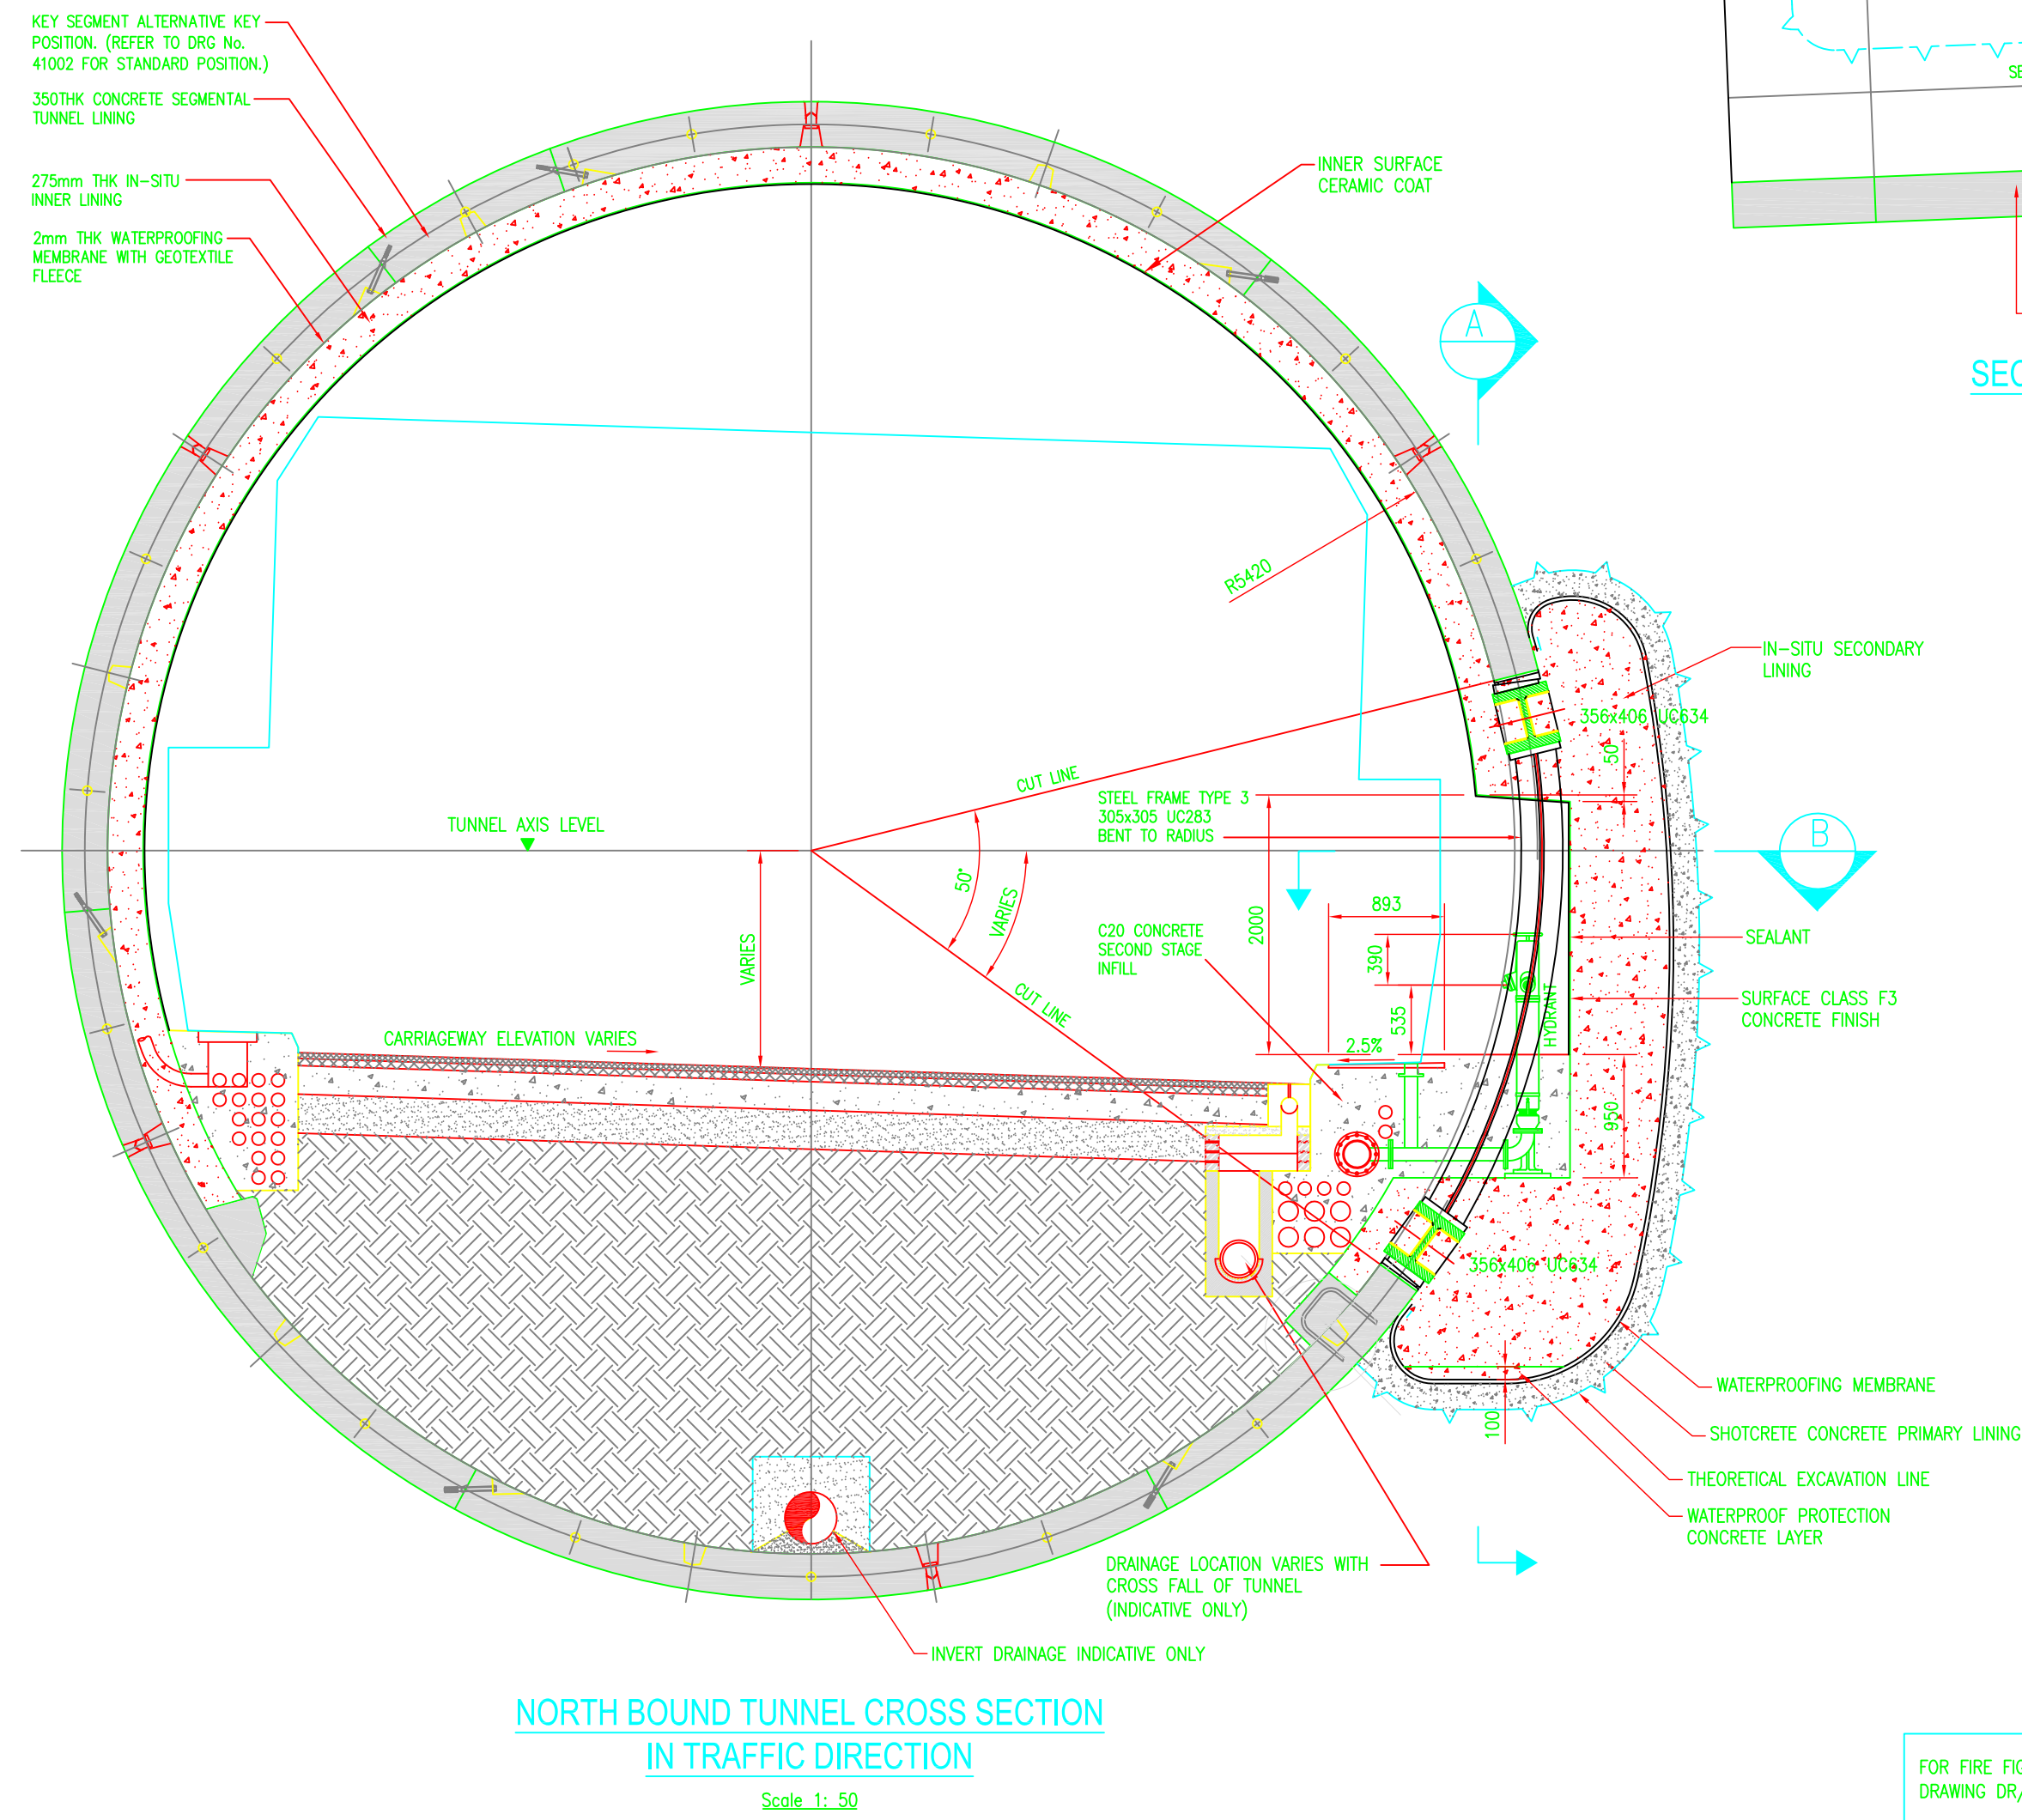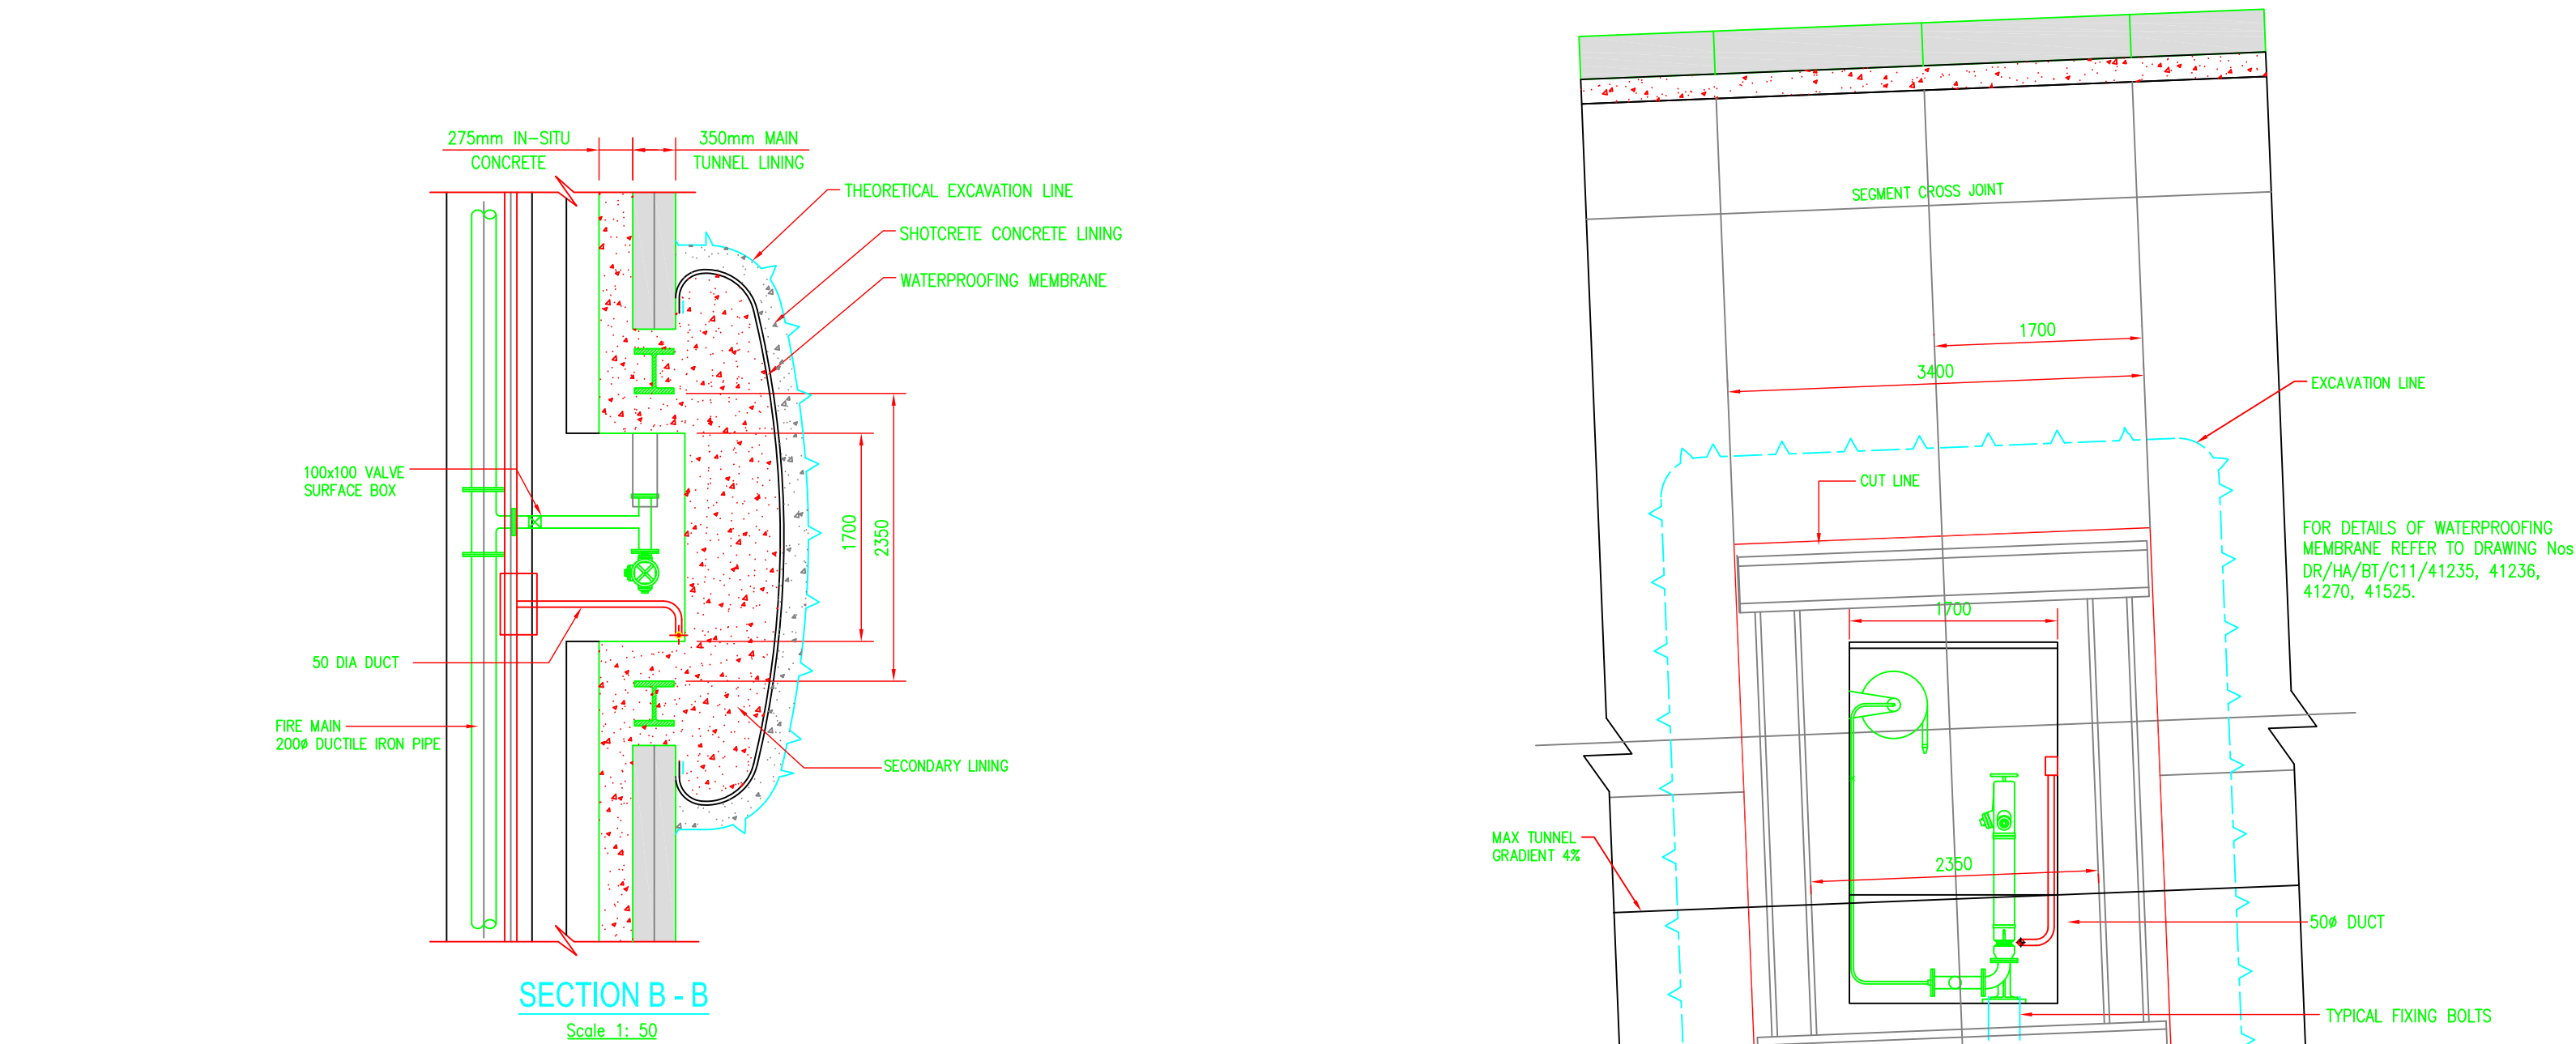

FOR FIRE FIGHTING NICHE LOCATIONS SEE
DRAWING DR/HA/BT/C11/41052

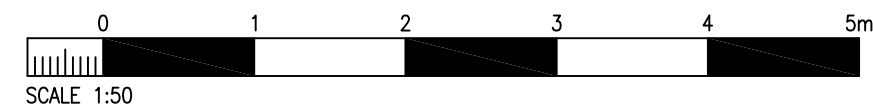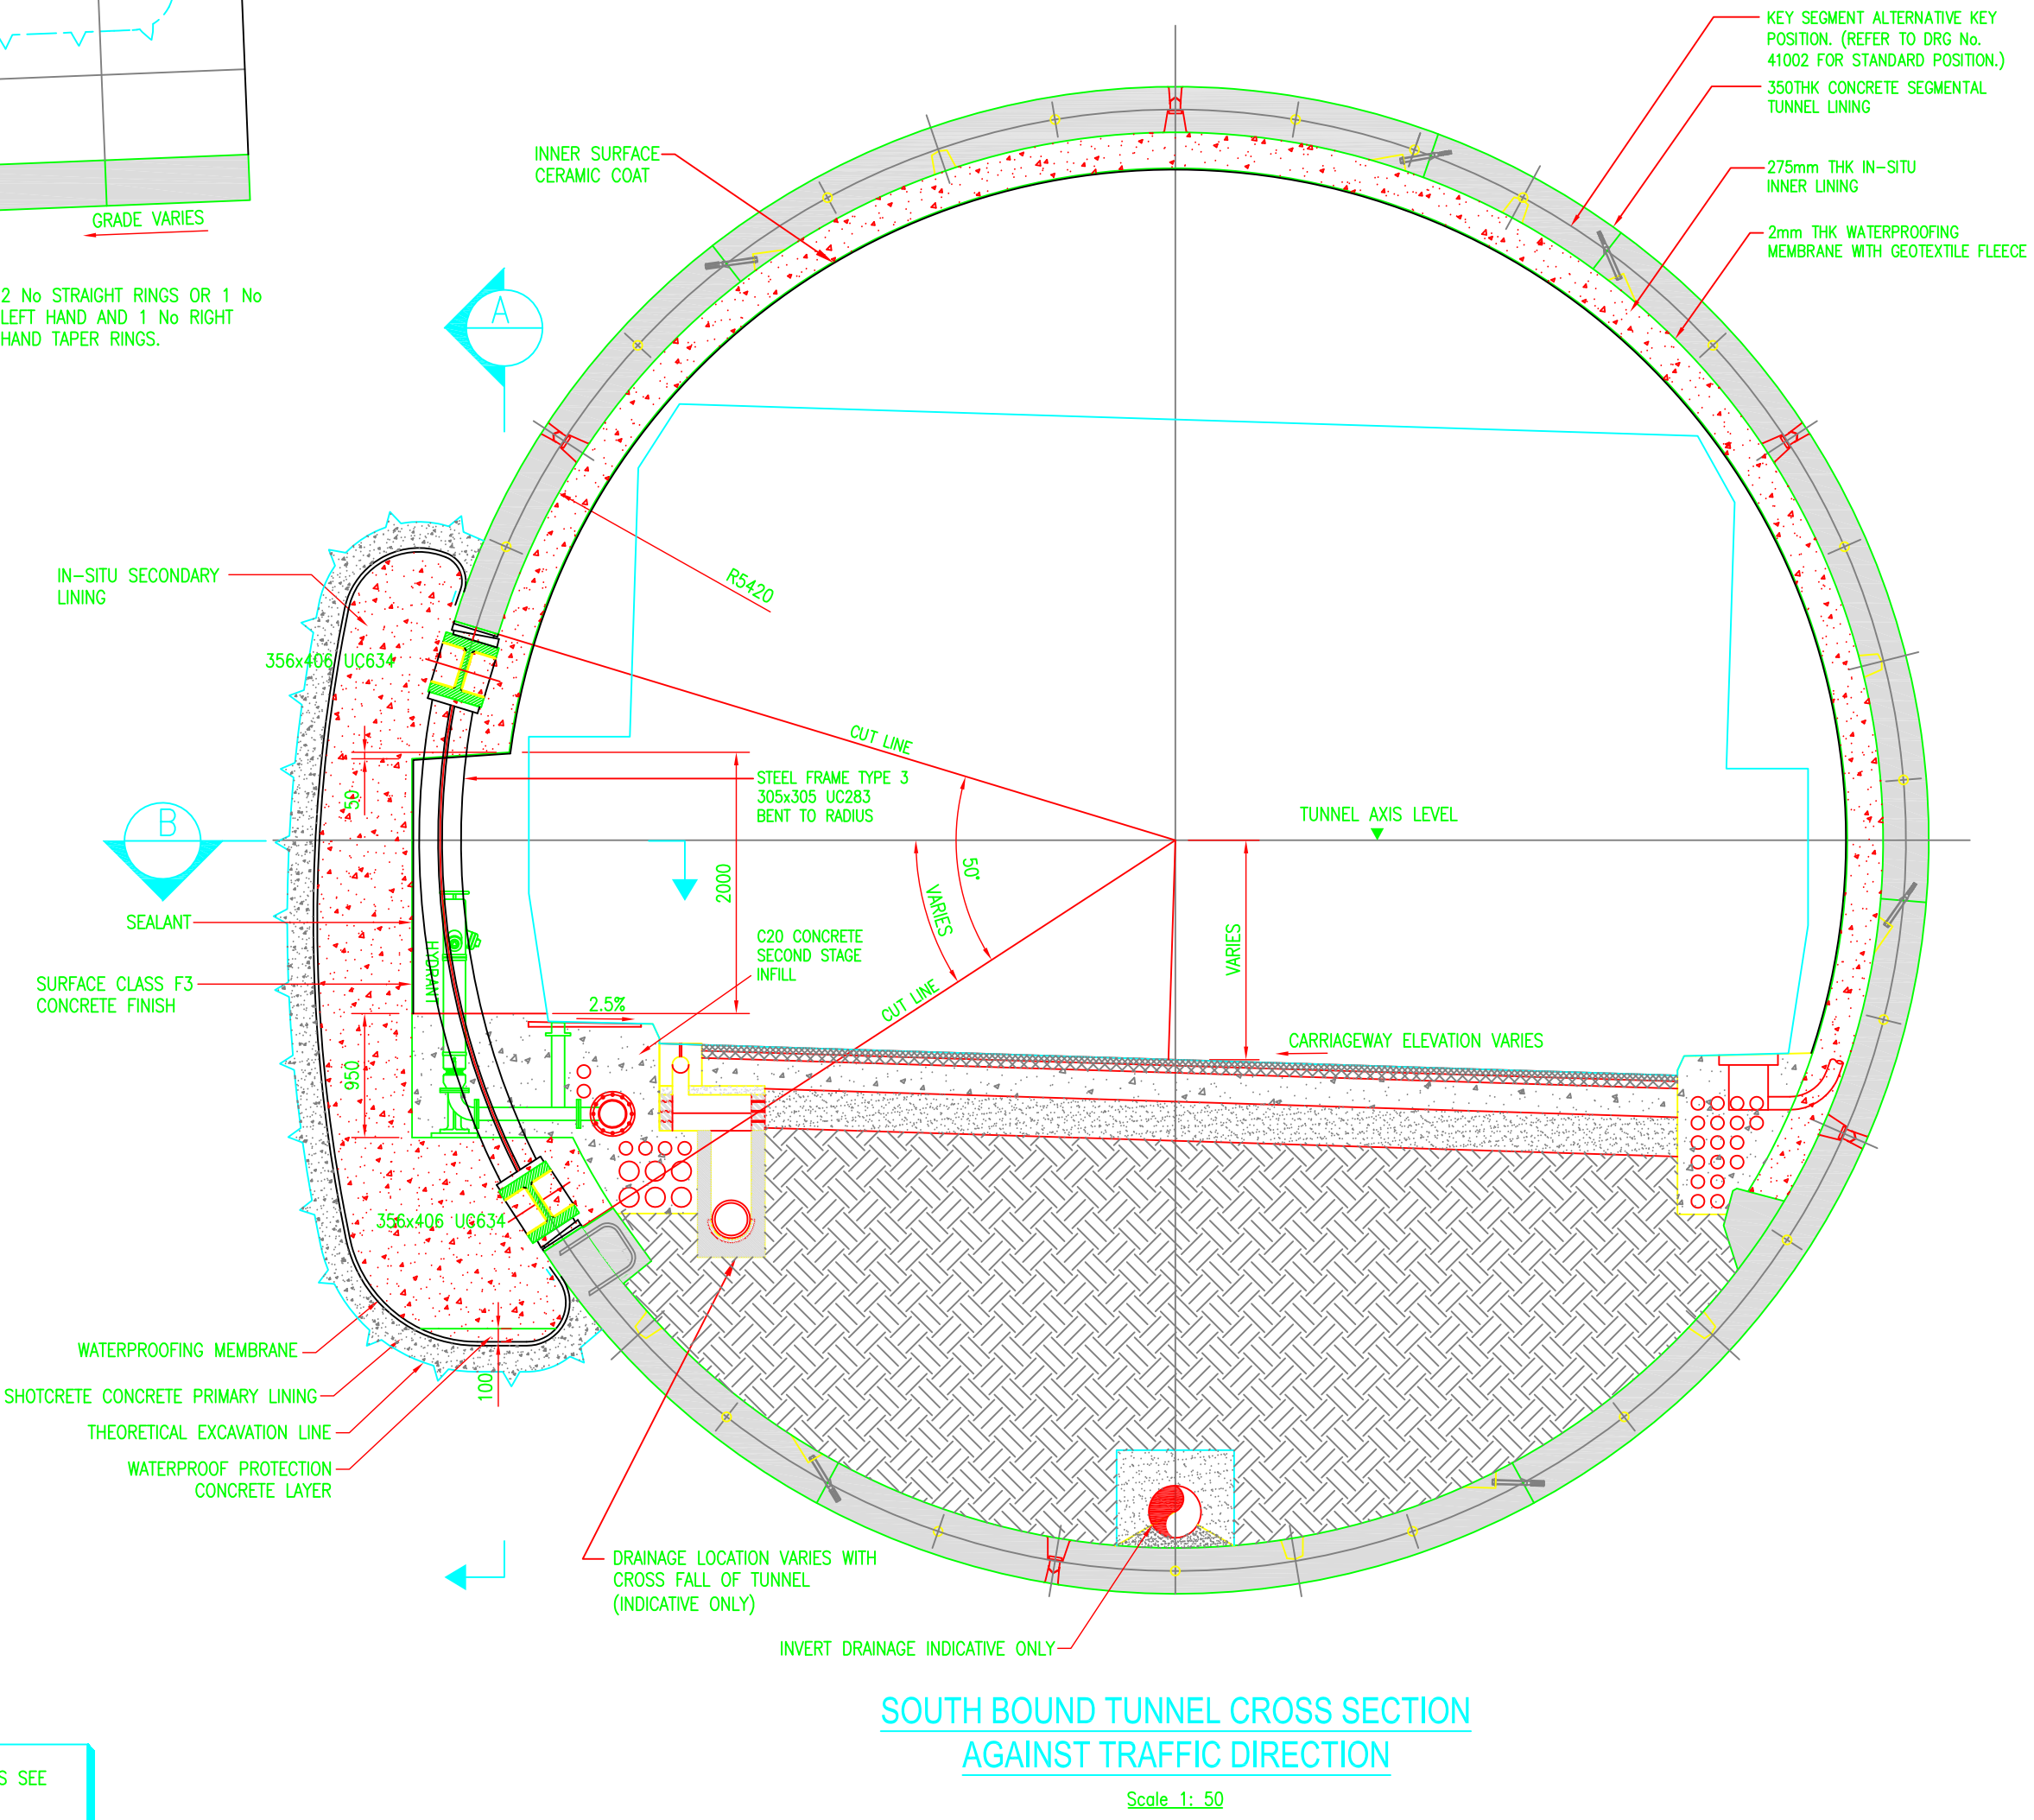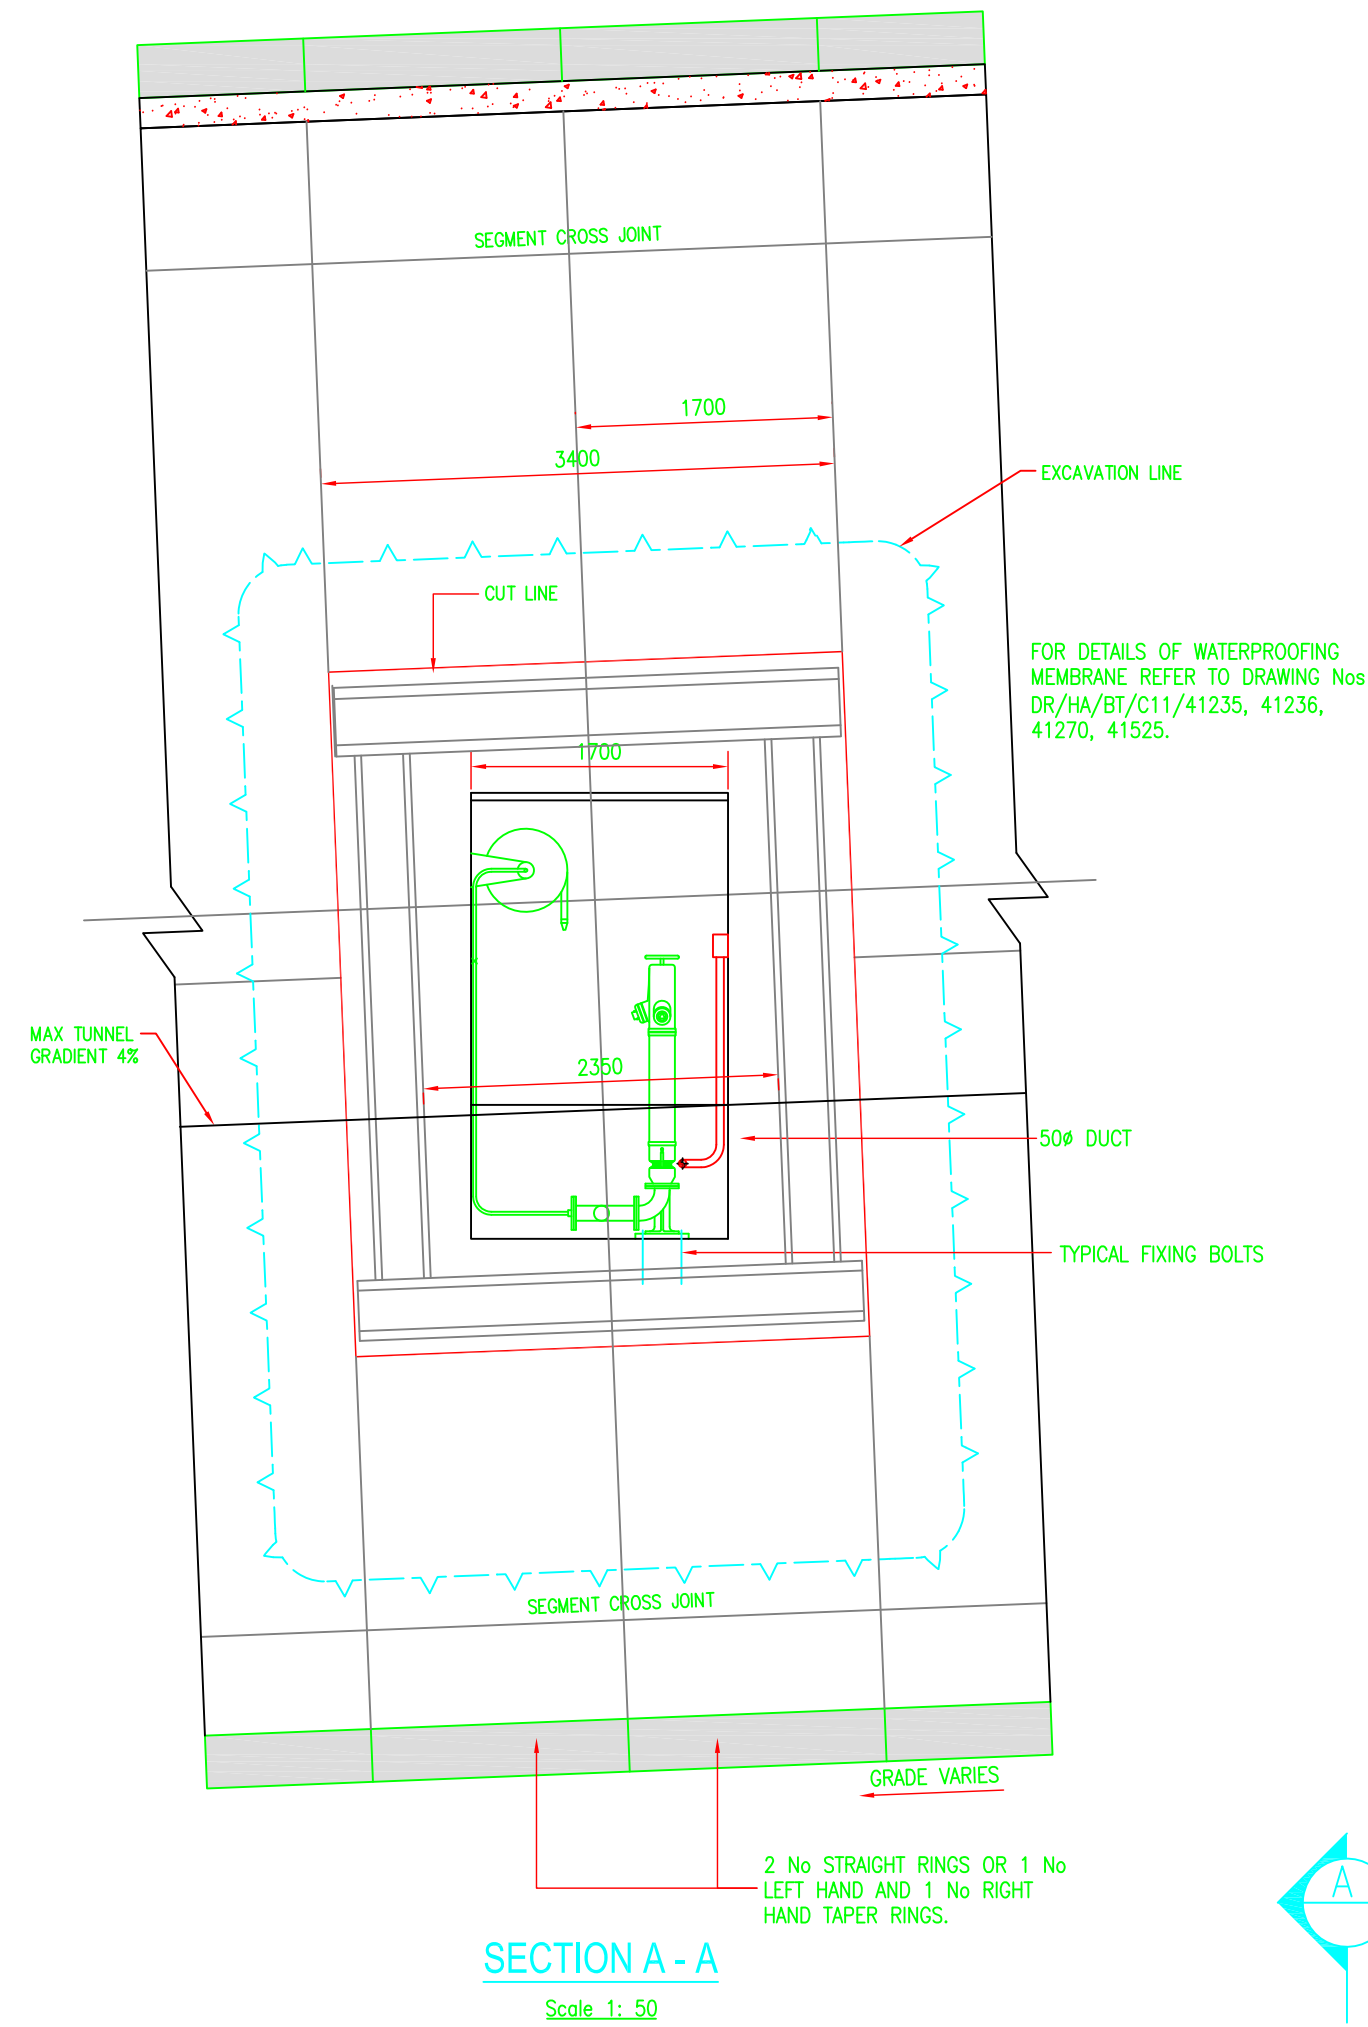

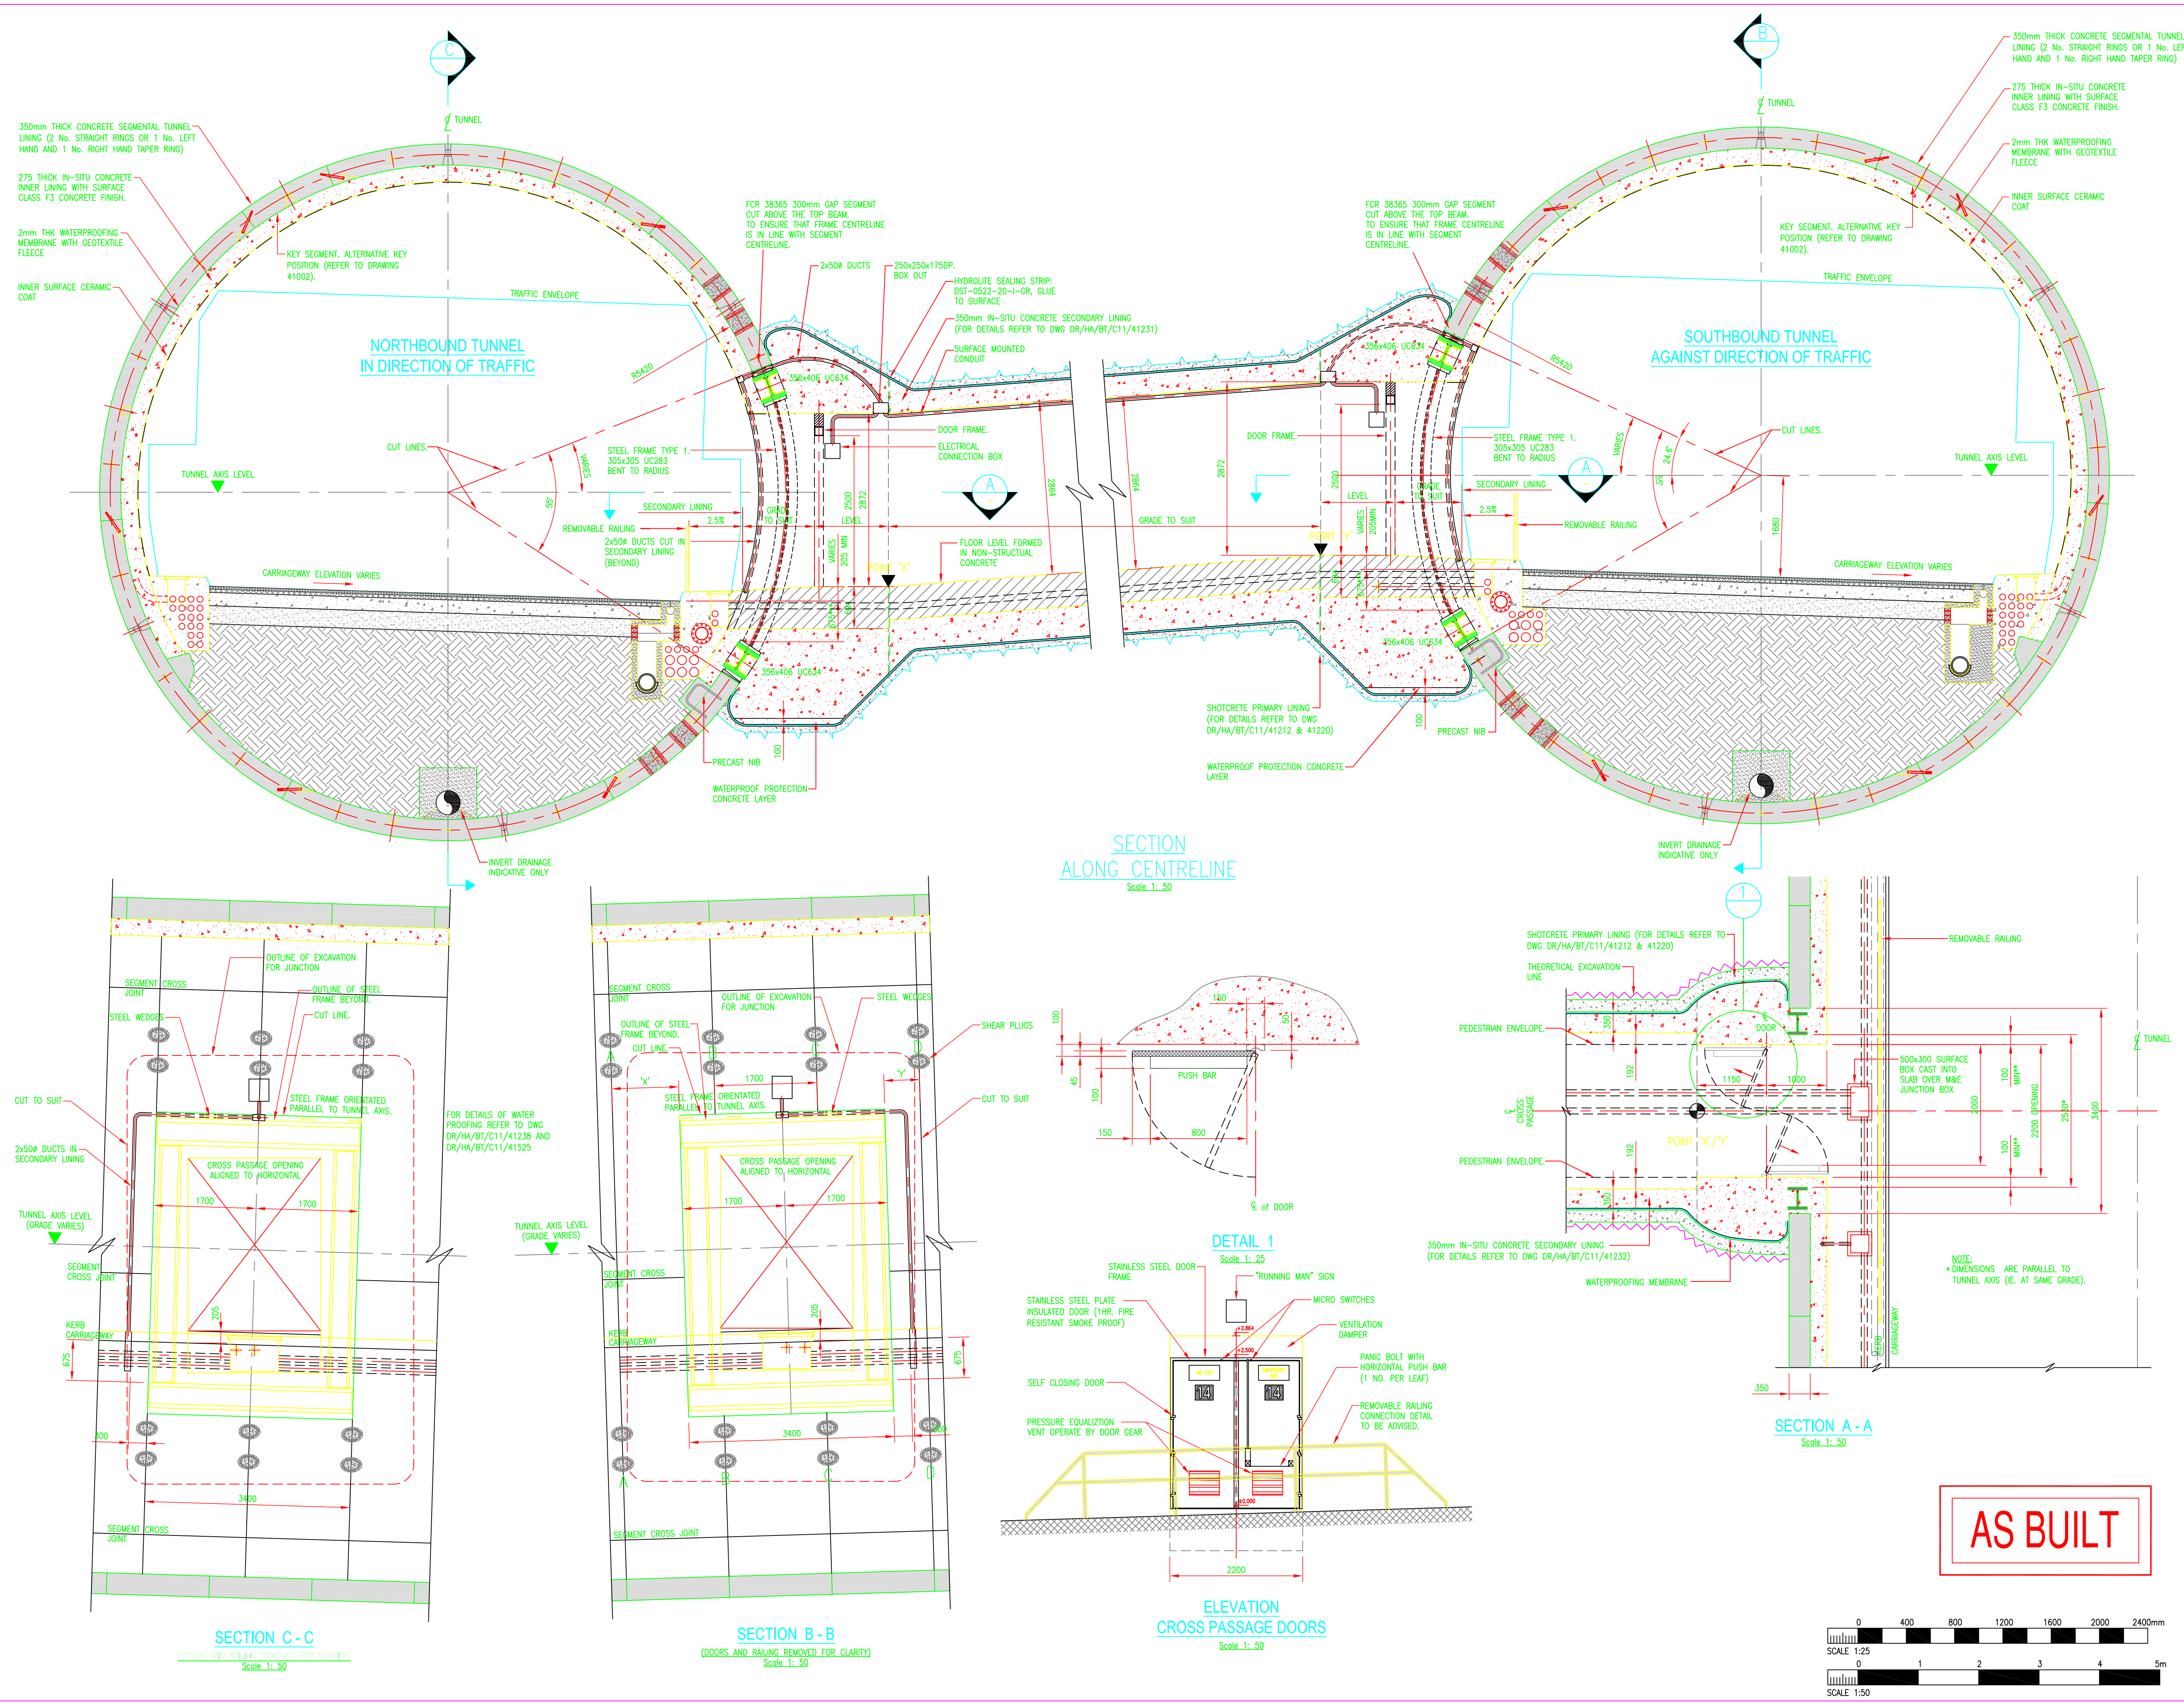

NOTES:

1. THIS DRAWING TO BE READ IN CONJUNCTION WITH
DR/HA/BT/C11/41121 - 41130 (INCLUSIVE)
DR/HA/BT/C11/41052, 41060, 41131, & 41525
DR/HA/BT/C11/41232 & 41238.
2. ALL DIMENSIONS SHOWN ON THIS DRAWING ARE IN MILLIMETRES.
3. ALL STRUCTURAL STEEL TO BE GRADE S355.
4. IN-SITU SECONDARY CONCRETE COMPRESSIVE STRENGTH
40N/mm².
5. FOR DETAILS OF STEELWORK FRAME REFER TO DRAWING
No DR/HA/BT/C11/41060.
6. CARRIAGEWAY SERVICES SHOWN AS INDICATIVE ONLY.
7. THE POSITION OF KEY SEGMENTS ARE OPPOSITE TO OPENING
POSITIONS, UNLESS STATED IN NCR 39403.
8. FOR DETAILS OF REINFORCEMENT TO SECONDARY LINING
REFER TO DRAWING DR/HA/BT/C11/41200 & 41207.

Work Ord By	Date	By	Rev.
08	16.11.06	CD	AS-BUILT ISSUE
07	24.10.03	SRP	ISSUE FOR NMI REVIEW. POP SETTING OUT ALTERED TO FOR 38365, 38367 & 38379 AROUND POINT X & Y ADDITIONAL DUCTING ADDED, SHEAR PLUGS ADDED
06	14.05.03	SRP	DOOR SIGNS ADJUSTED TO CORRECT SID- JUNCTIONS ADDED, POINTS 'B' & 'D' REVISED TO 'Y' & 'X'
05	20.11.02	GEG	ISSUED FOR CONSTRUCTION
04	1.7.02	PRD	ISSUED FOR BROWN & ROOT APPROVAL. NMI COMMENTS INCORPORATED.
03	31.05.02	GEG	ISSUE FOR NMI REVIEW
02	27.05.02	GEG	MAJOR AMENDMENTS
01	28.03.02	GEG	FIRST ISSUE

Project
**DUBLIN
PORT
TUNNEL**

mm
Consortium
**NISHIMATSU
MOWLEM
IRISHENCO**

Haswell
Consulting Engineers

Carl Bro
Intelligent Solutions

HBI
HAERTER AG

NRA
NATIONAL ROADS AUTHORITY
An tArdánas um Bheithre Náisiúnta

Dublin City Council
Comhairle Cathrach Bhaile Átha Cliath

Title
**BORED TUNNEL
TYPICAL PEDESTRIAN CROSS
PASSAGE GENERAL
ARRANGEMENT**

Scales
1:50, 1:25

Dm
GEG

Date
MAR. 2002

Chd.
Passed


Project No.
4958

Design Package
HWD4.5

Drawing No.
DR/HA/BT/C11/41061/08/X

Original Drawing Size
: 594 x 841 - A1

AS BUILT

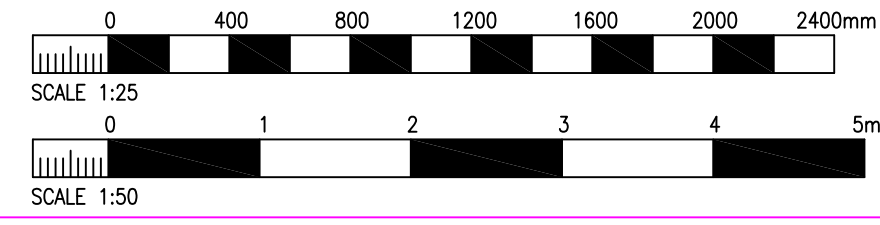

APPENDIX C

PLAXIS 3D RESULTS

PLAXIS 3D FINITE ELEMENT MODEL RESULTS

TABLE OF FIGURES

Figure C-1: Change in Total Stress on Tunnel Crown (Northbound) HSS - increase is + ive	2
Figure C-2: Change in Total Stress on Tunnel Invert (Northbound) HSS - increase is + ive.....	2
Figure C-3: Change in Total Stress on Tunnel Crown (Southbound) HSS - increase is + ive	3
Figure C-4: Change in Total Stress on Tunnel Invert (Southbound) HSS - increase is + ive.....	3
Figure C-5: Vertical Displacements on Tunnel Crown (Northbound) HSS	4
Figure C-6: Vertical Displacements on Tunnel Crown (Southbound) HSS	4
Figure C-7: Horizontal Displacements on Tunnel Crown (Northbound) HSS	5
Figure C-8: Horizontal Displacements on Tunnel Crown (Southbound) HSS	5
Figure C-9: Horizontal Displacements on Tunnel Eastern Edge (Northbound) HSS	6
Figure C-10: Horizontal Displacements on Tunnel Western Edge (Northbound)) HSS	6
Figure C-11: Horizontal Displacements on Tunnel Eastern Edge (Southbound) HSS	7
Figure C-12: Horizontal Displacements on Tunnel Western Edge (Southbound) HSS	7
Figure C-13: Axial Force along DPTs (N1 i.e. Longitudinal Force) NB HSS	8
Figure C-14: Axial Force along DPTs (N2 i.e. Hoop Force) NB HSS	8
Figure C-15: Bending Moment along DPTs (M11 i.e. Longitudinally along tunnel) NB HSS.....	9
Figure C-16: Bending Moment along DPTs (M22 i.e. transversely across tunnel) SB HSS.....	9
Figure C-17: Shear Force along DPTs (Q23 i.e. Transversely across tunnel) SB HSS.....	10
Figure C-18: Shear Force along DPTs (Q13 i.e. Longitudinally along tunnel) SB HSS.....	10

Abbreviations

- **SB** = Southbound Tunnel
- **NB** = Northbound Tunnel

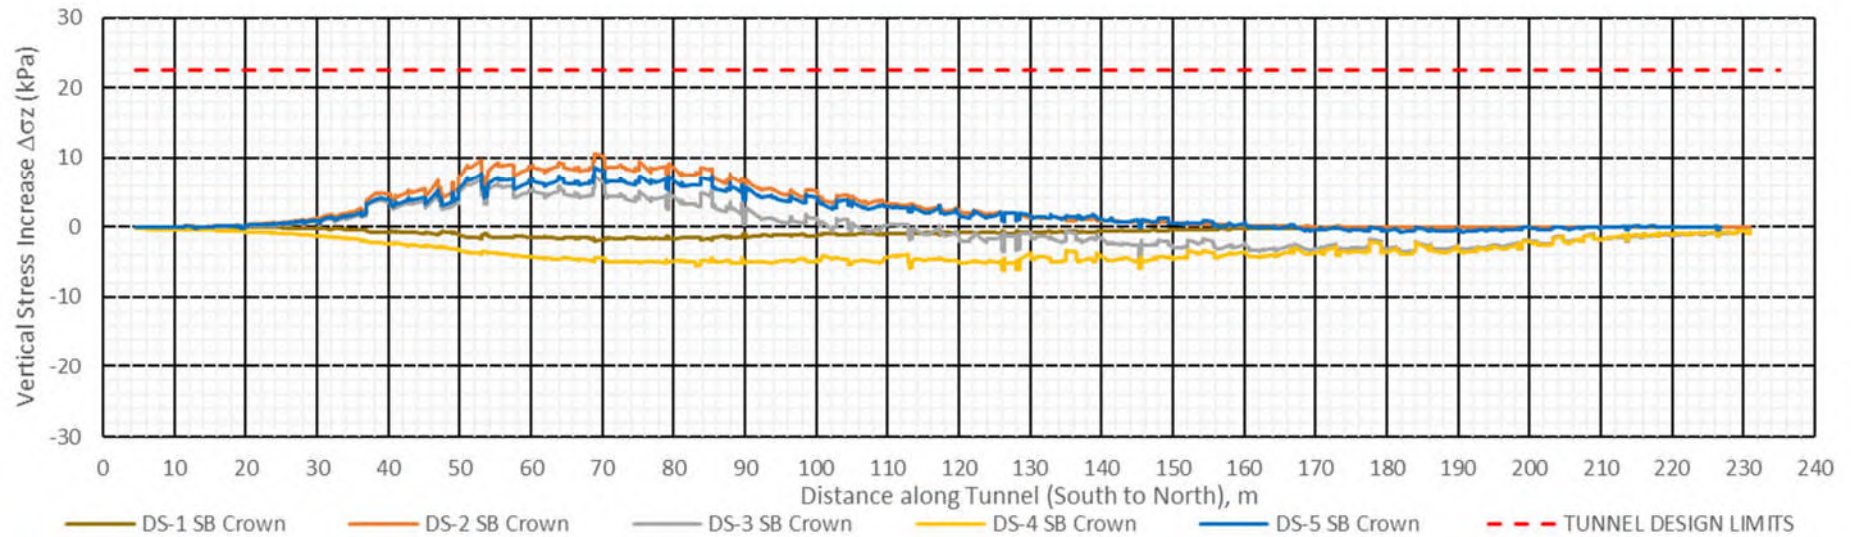


Figure C-1: Change in Total Stress on Tunnel Crown (Northbound) HSS - increase is + ive

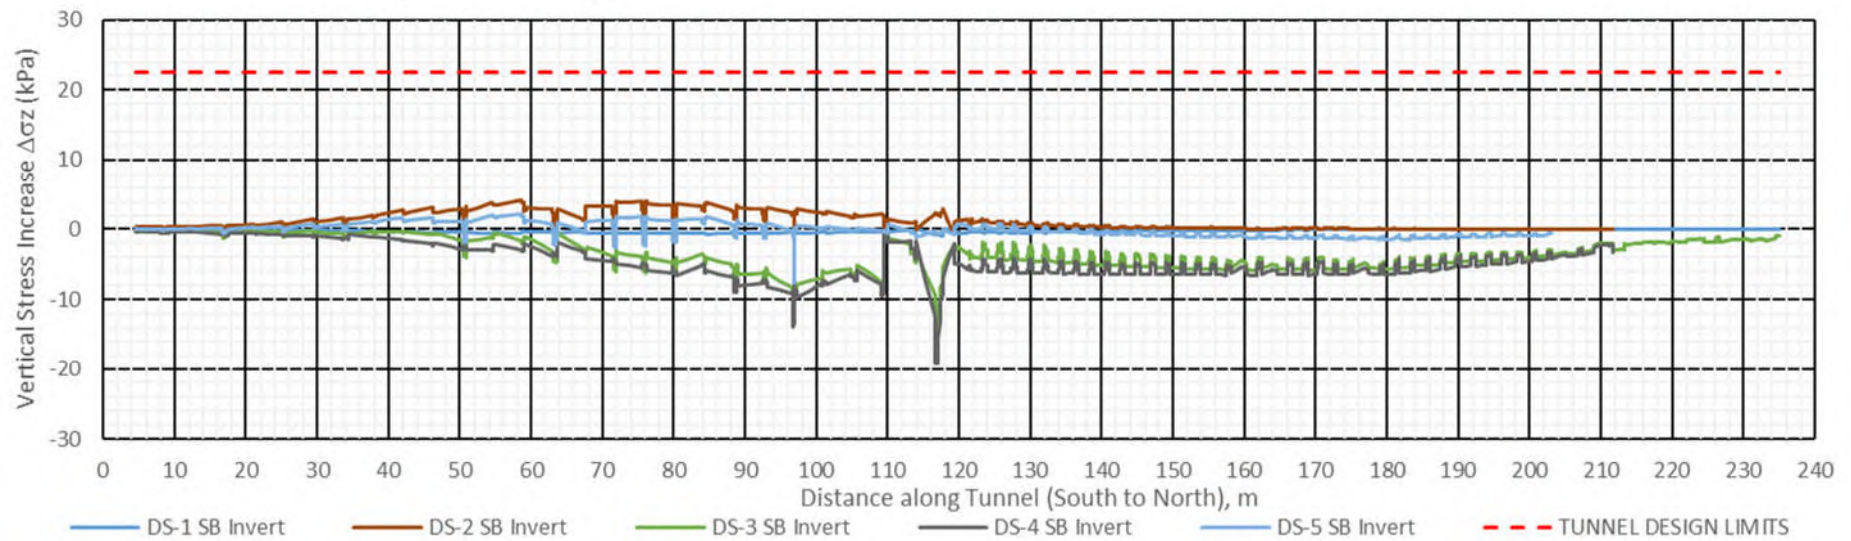


Figure C-2: Change in Total Stress on Tunnel Invert (Northbound) HSS - increase is + ive

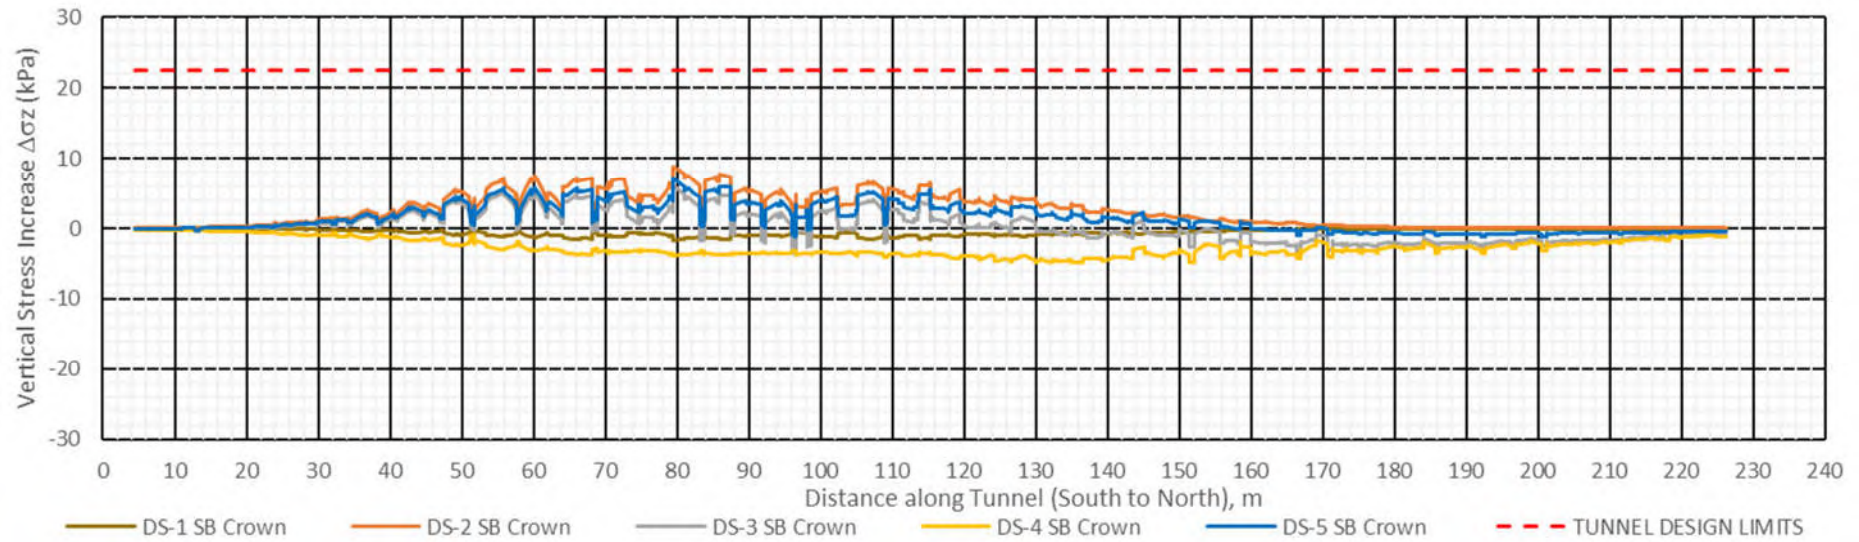


Figure C-3: Change in Total Stress on Tunnel Crown (Southbound) HSS - increase is + ive

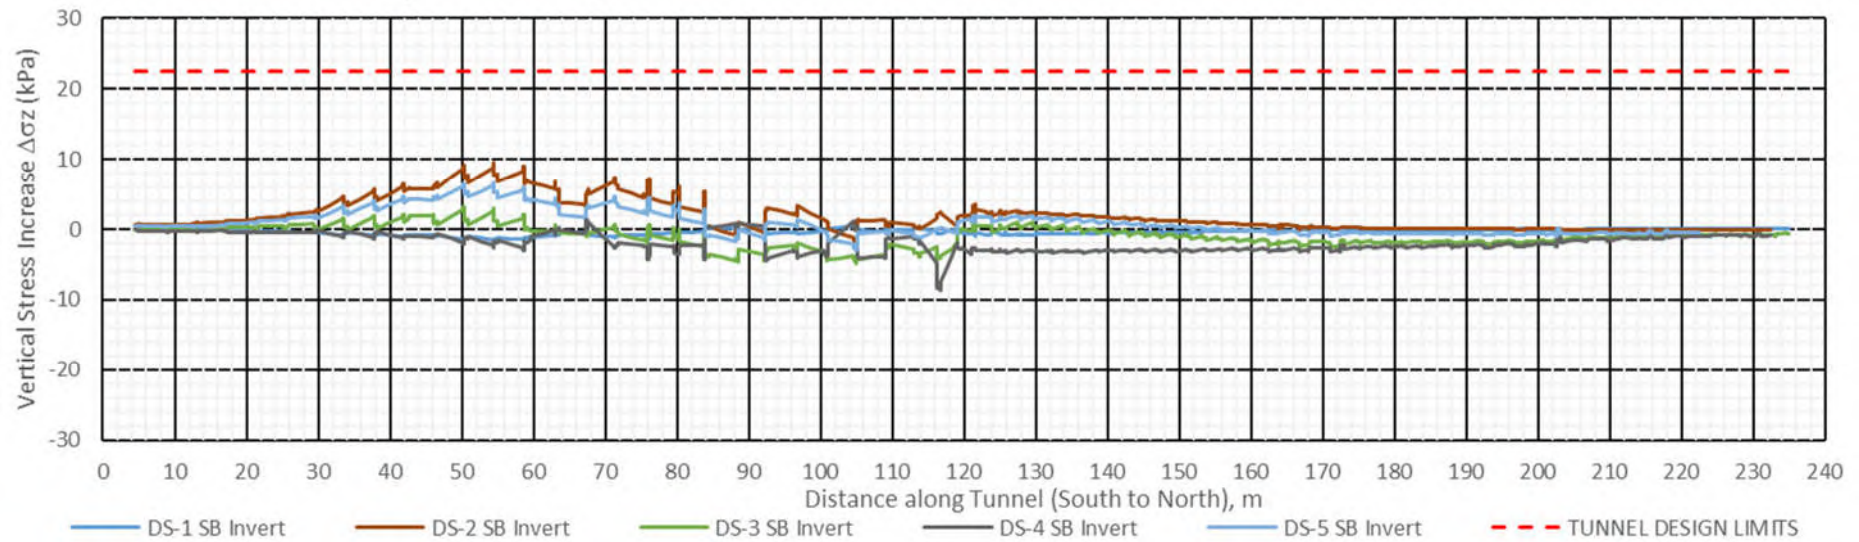


Figure C-4: Change in Total Stress on Tunnel Invert (Southbound) HSS - increase is + ive

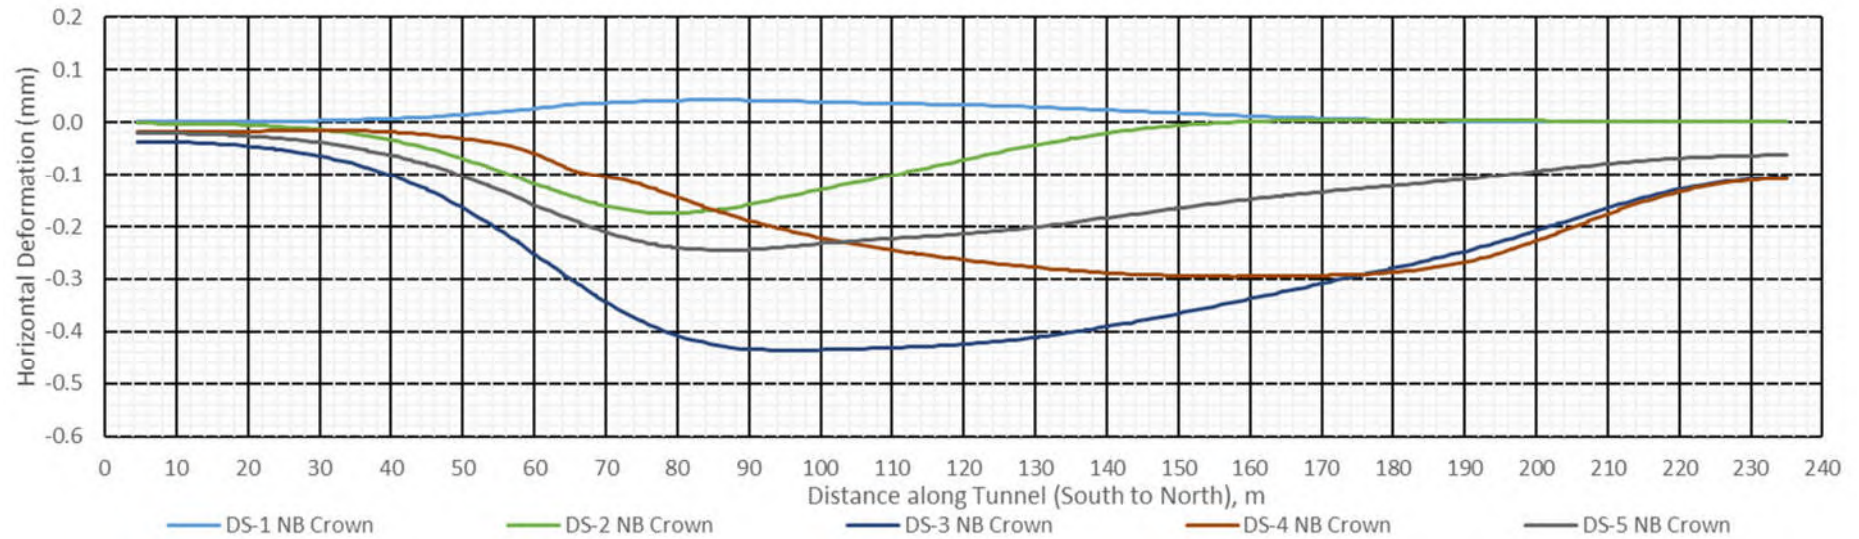


Figure C-5: Vertical Displacements on Tunnel Crown (Northbound) HSS

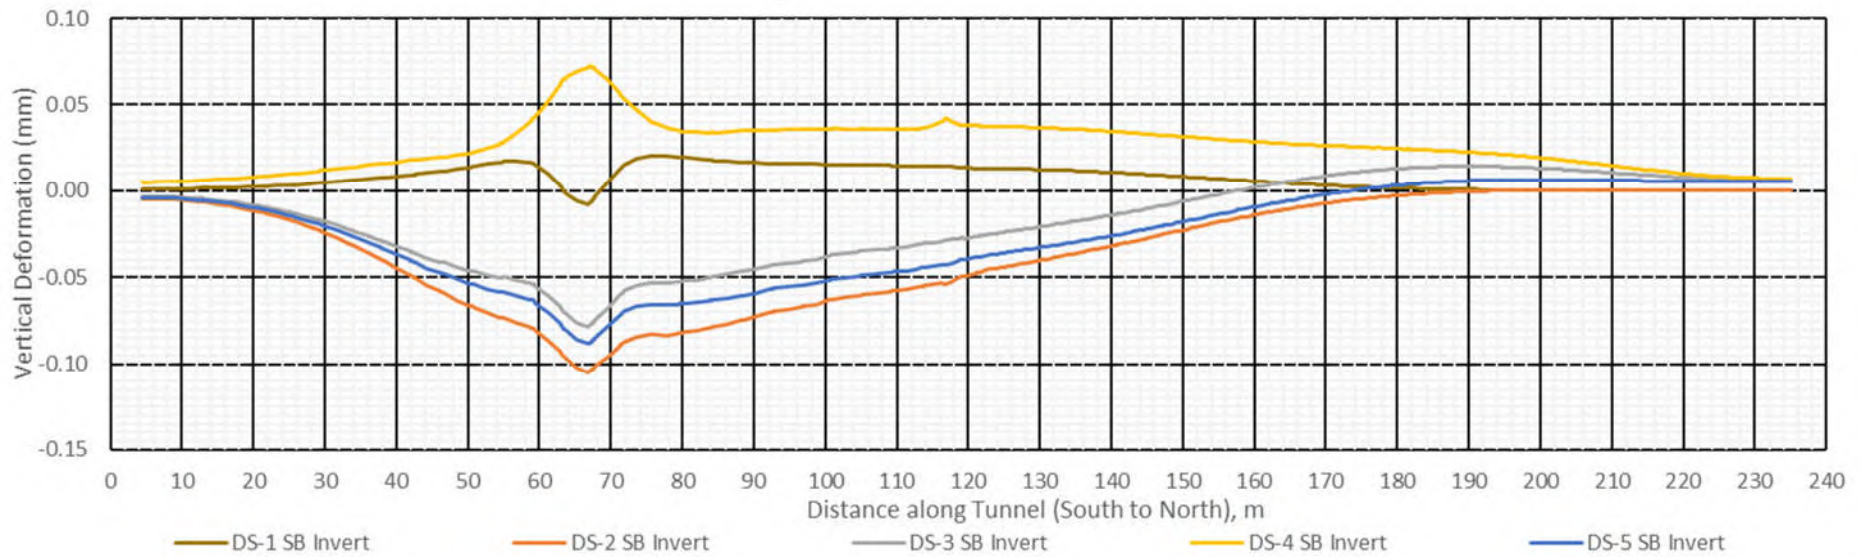


Figure C-6: Vertical Displacements on Tunnel Crown (Southbound) HSS

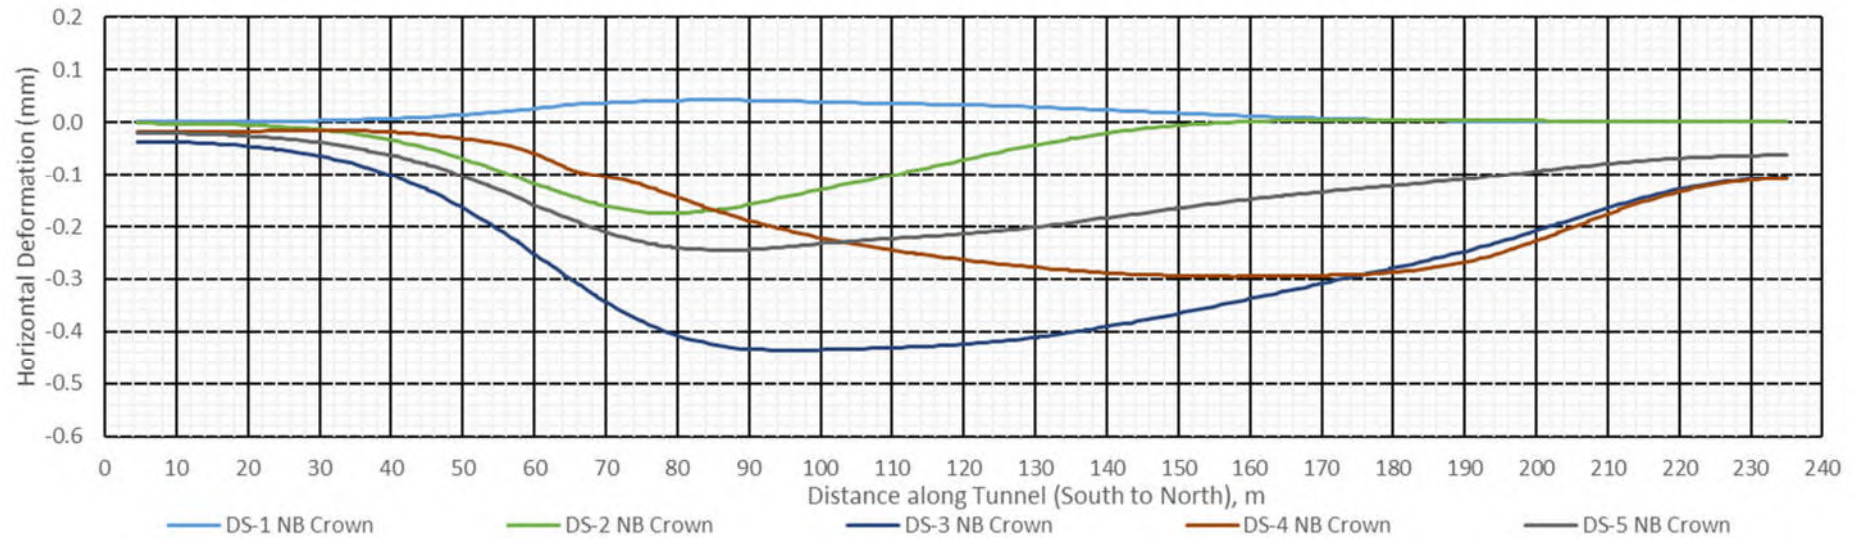


Figure C-7: Horizontal Displacements on Tunnel Crown (Northbound) HSS

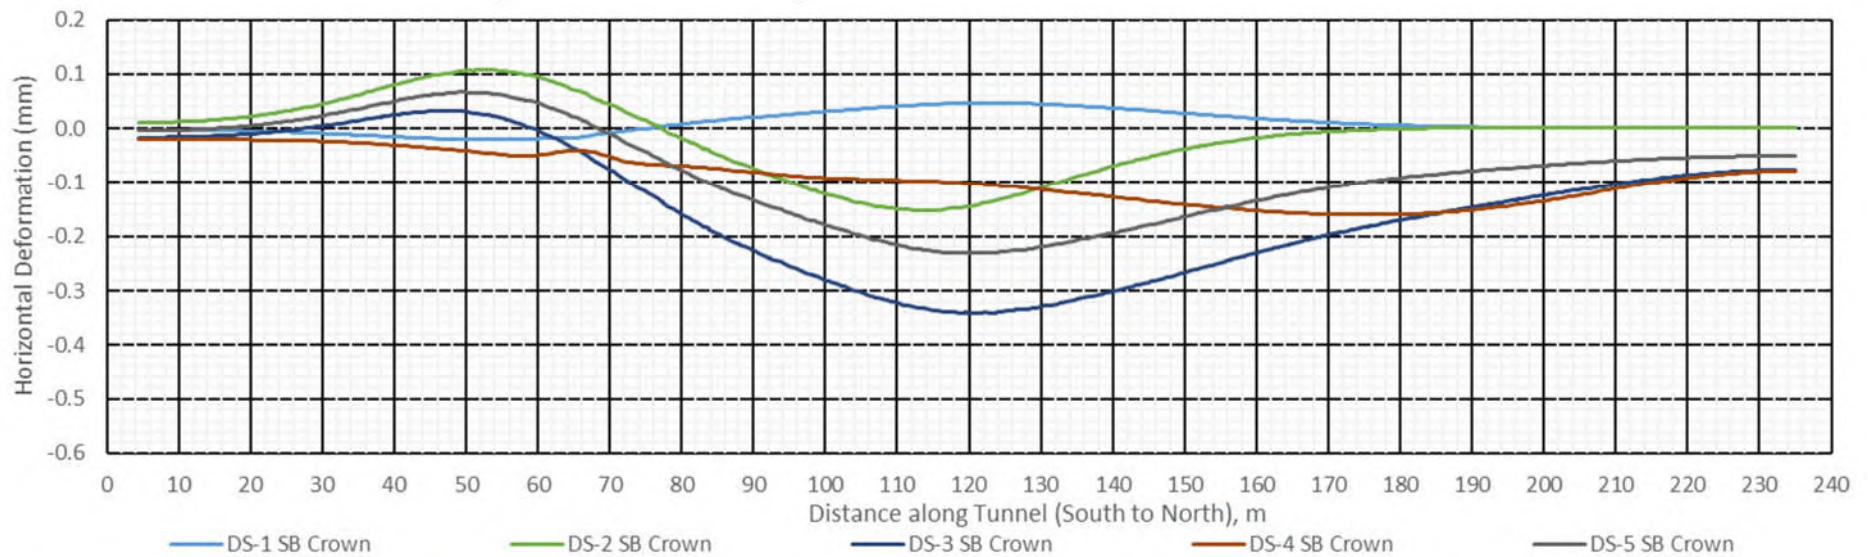


Figure C-8: Horizontal Displacements on Tunnel Crown (Southbound) HSS

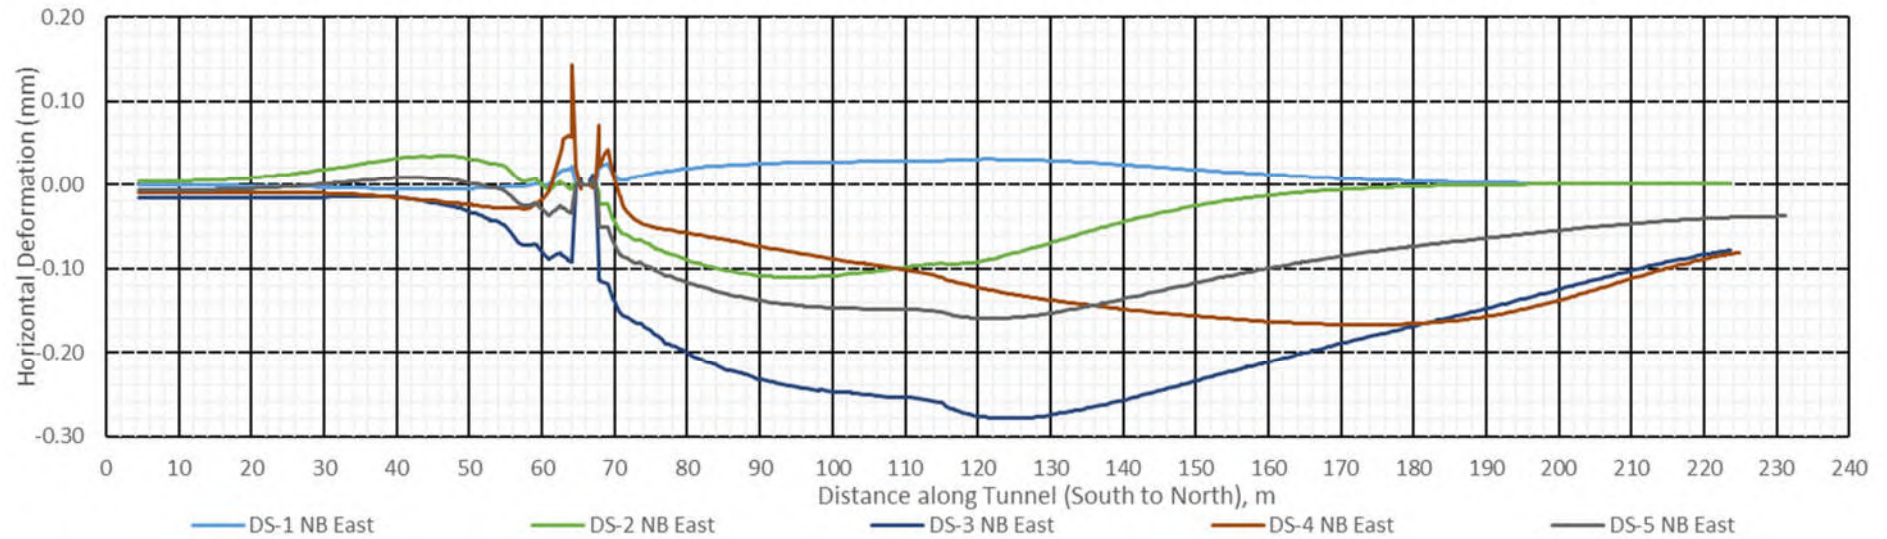


Figure C-9: Horizontal Displacements on Tunnel Eastern Edge (Northbound) HSS

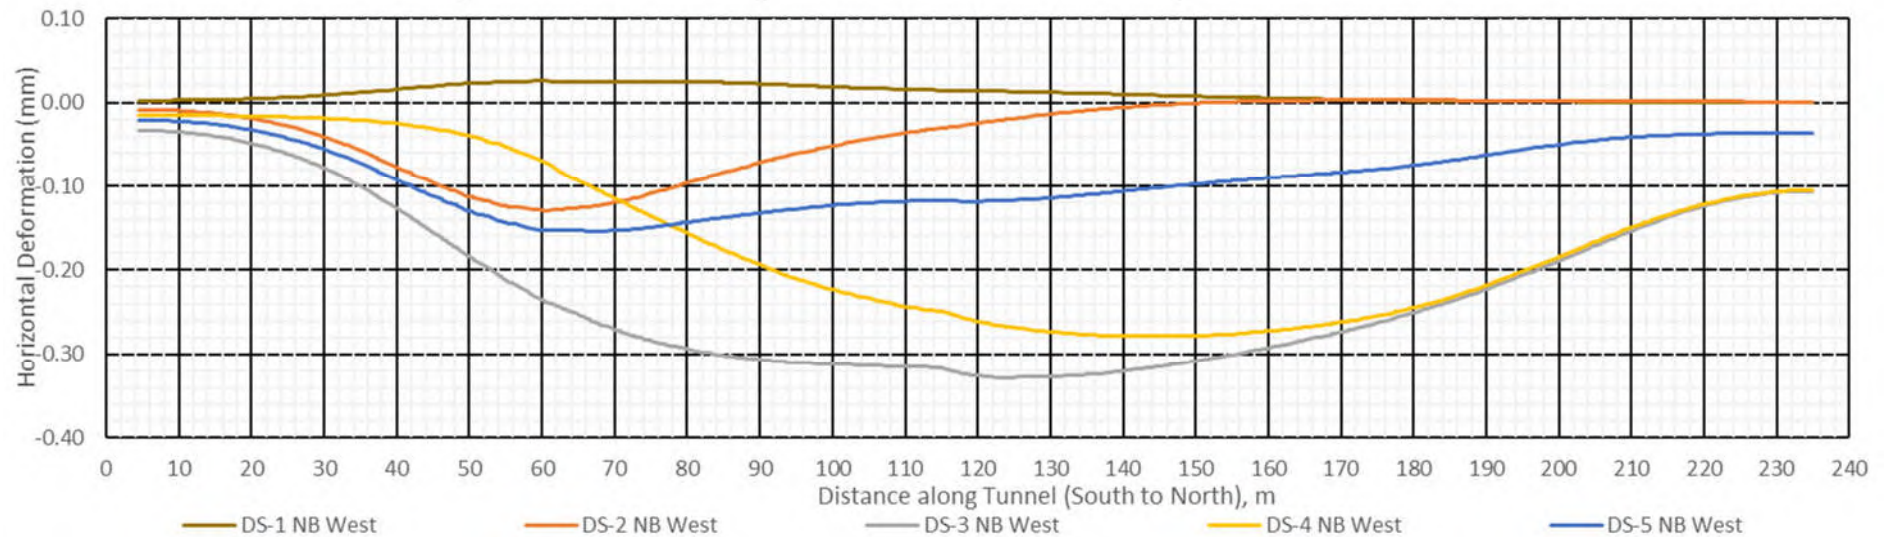


Figure C-10: Horizontal Displacements on Tunnel Western Edge (Northbound) HSS

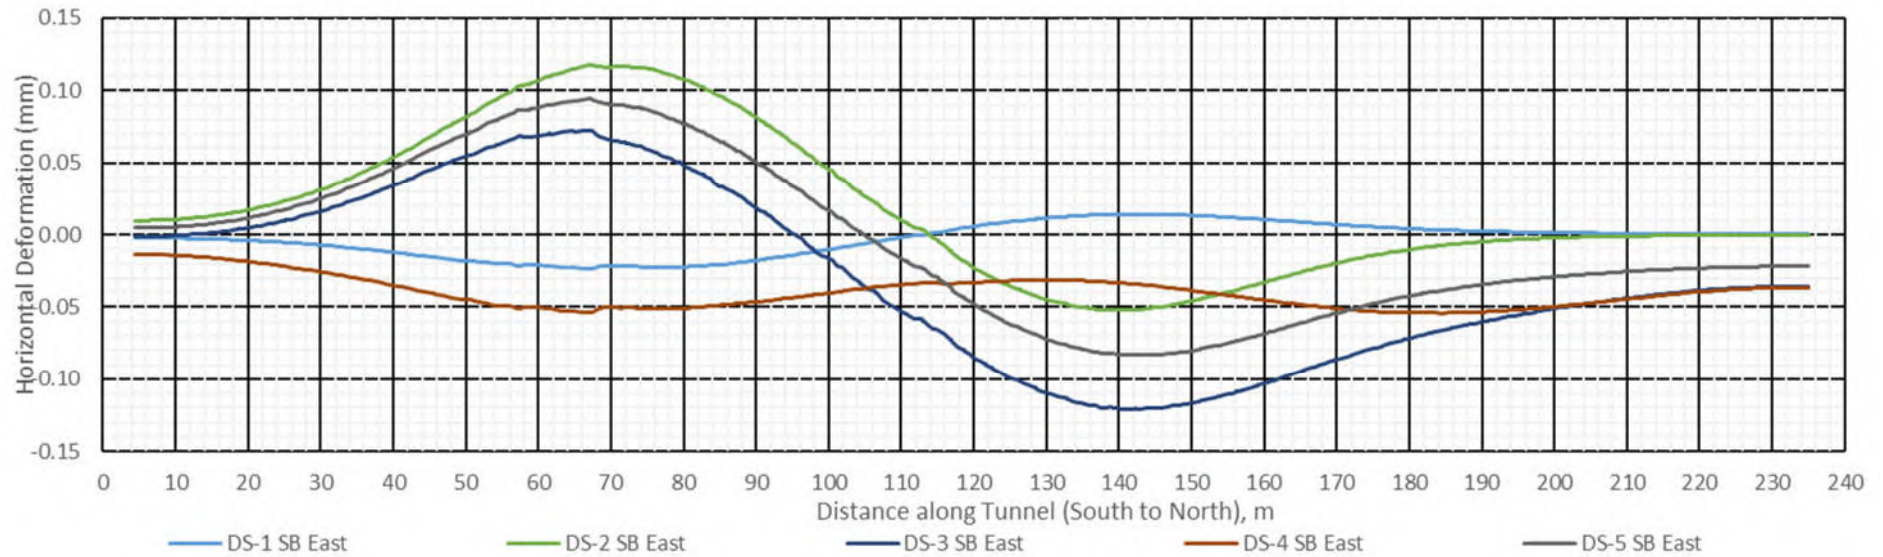


Figure C-11: Horizontal Displacements on Tunnel Eastern Edge (Southbound) HSS

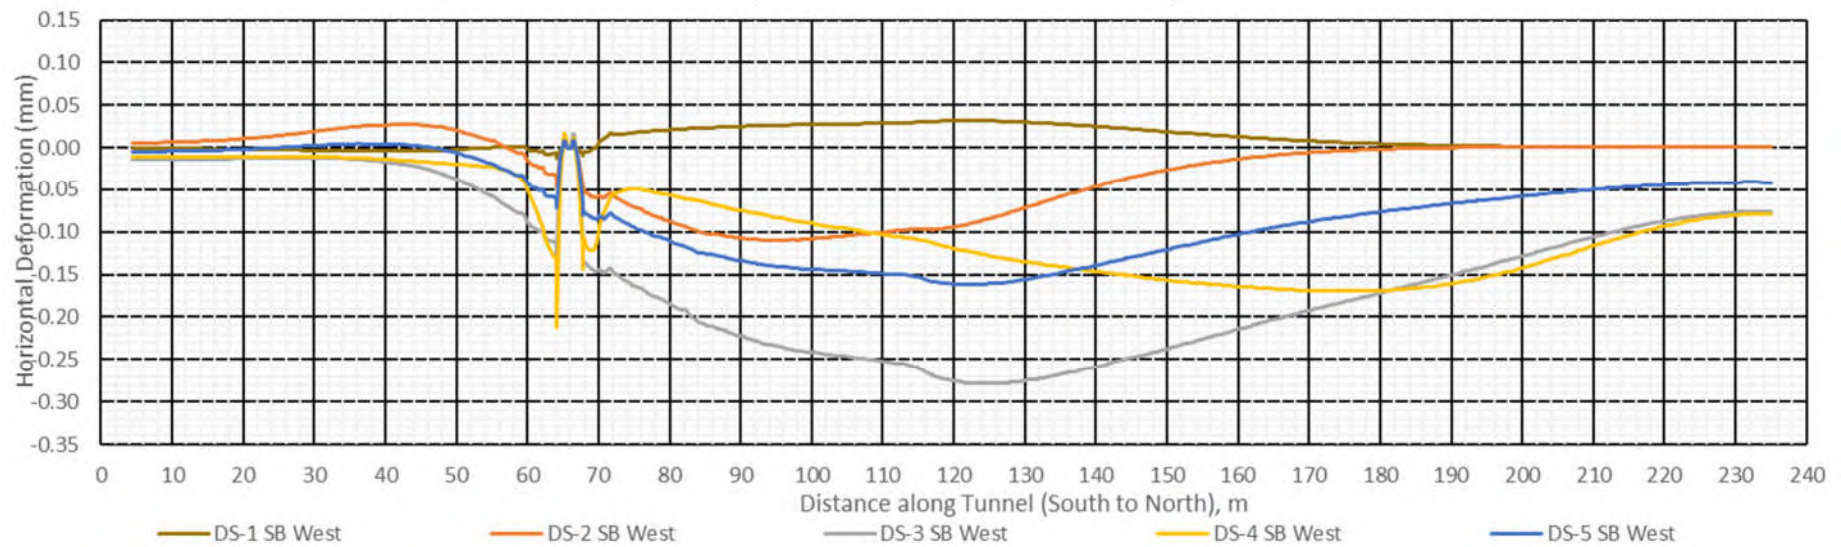


Figure C-12: Horizontal Displacements on Tunnel Western Edge (Southbound) HSS

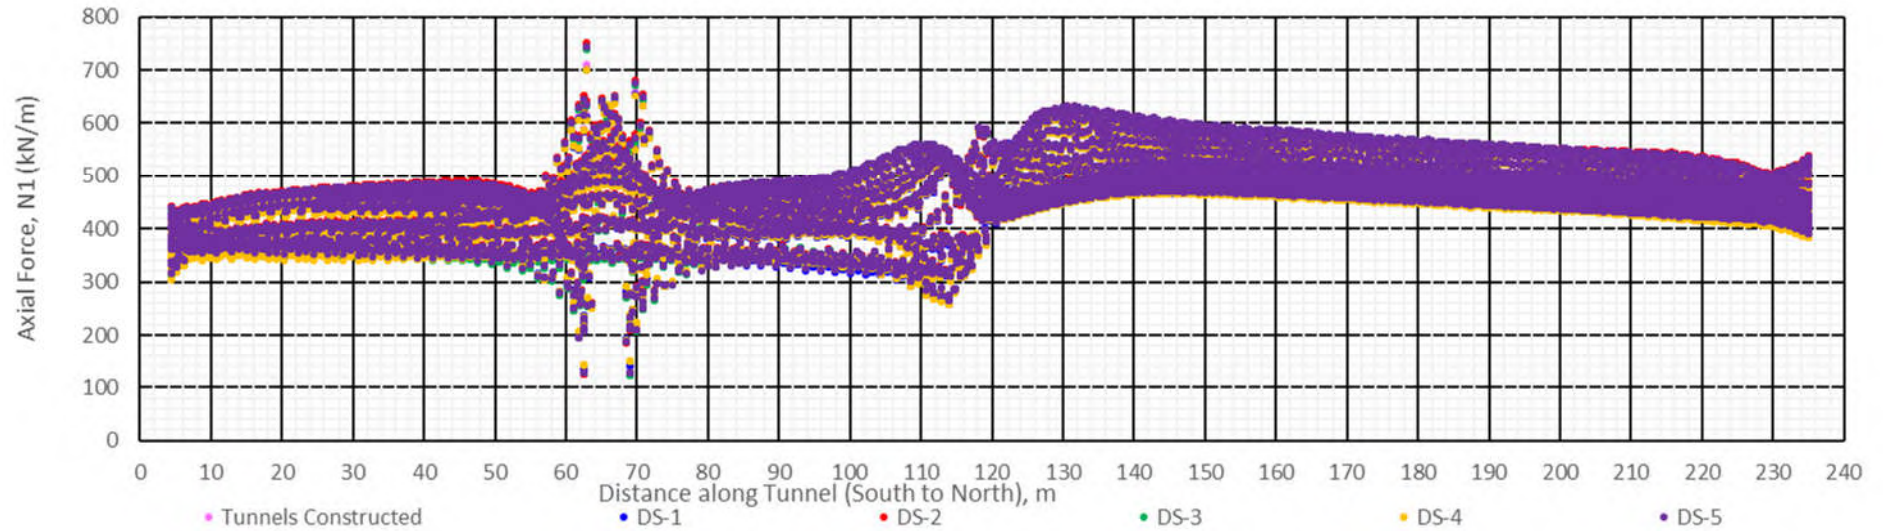


Figure C-13: Axial Force along DPTs (N1 i.e. Longitudinal Force) NB HSS

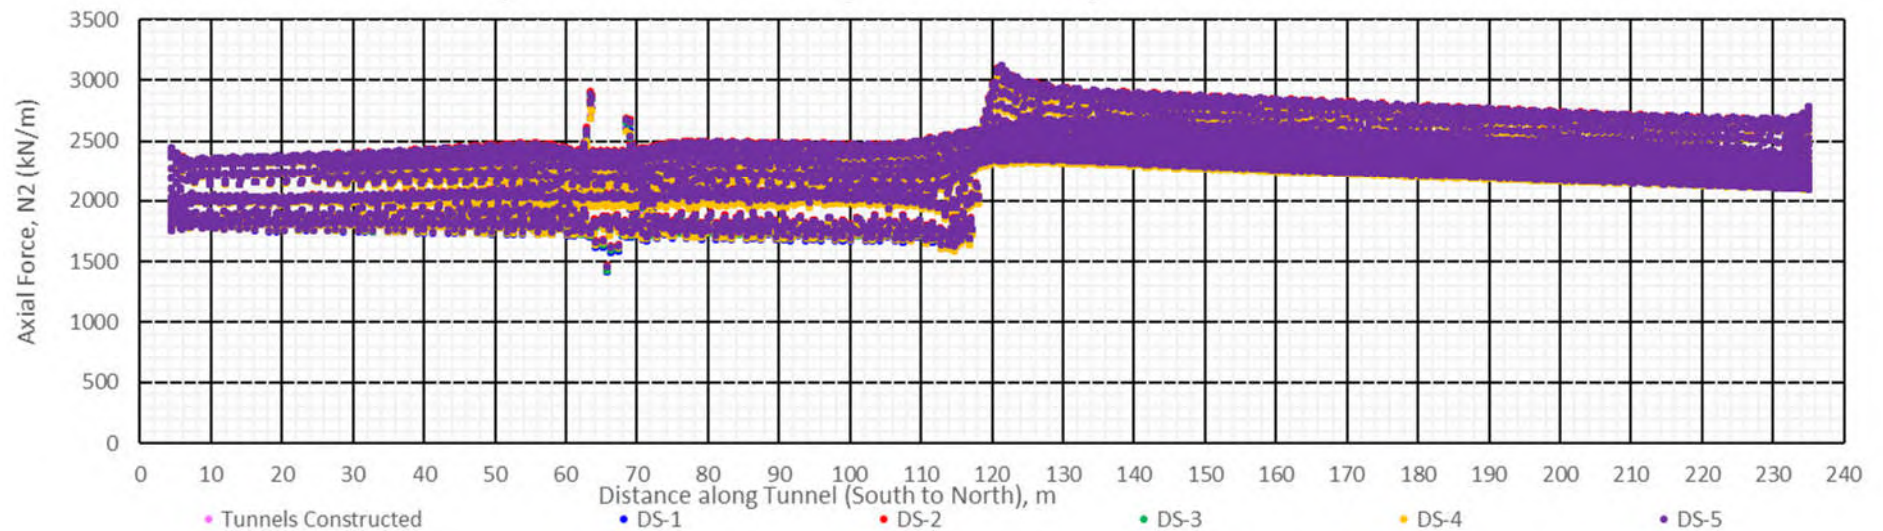


Figure C-14: Axial Force along DPTs (N2 i.e. Hoop Force) NB HSS

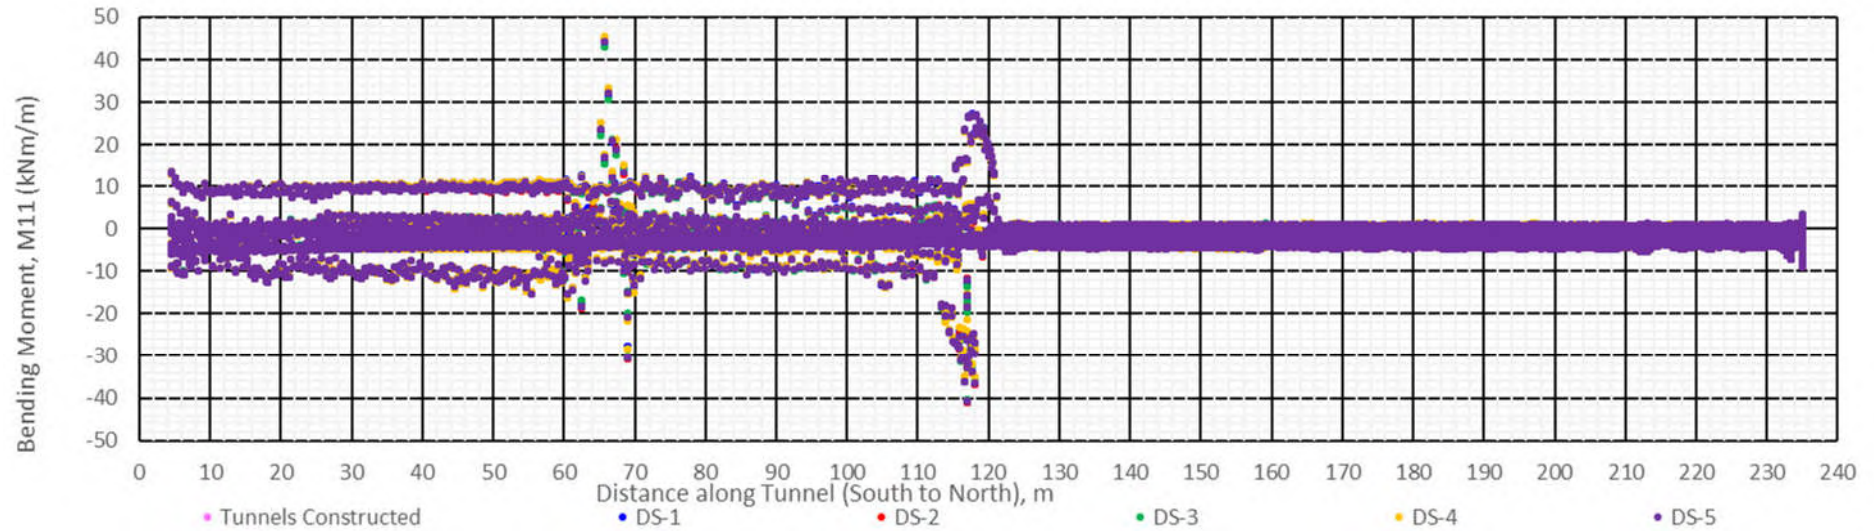


Figure C-15: Bending Moment along DPTs (M11 i.e. Longitudinally along tunnel) NB HSS

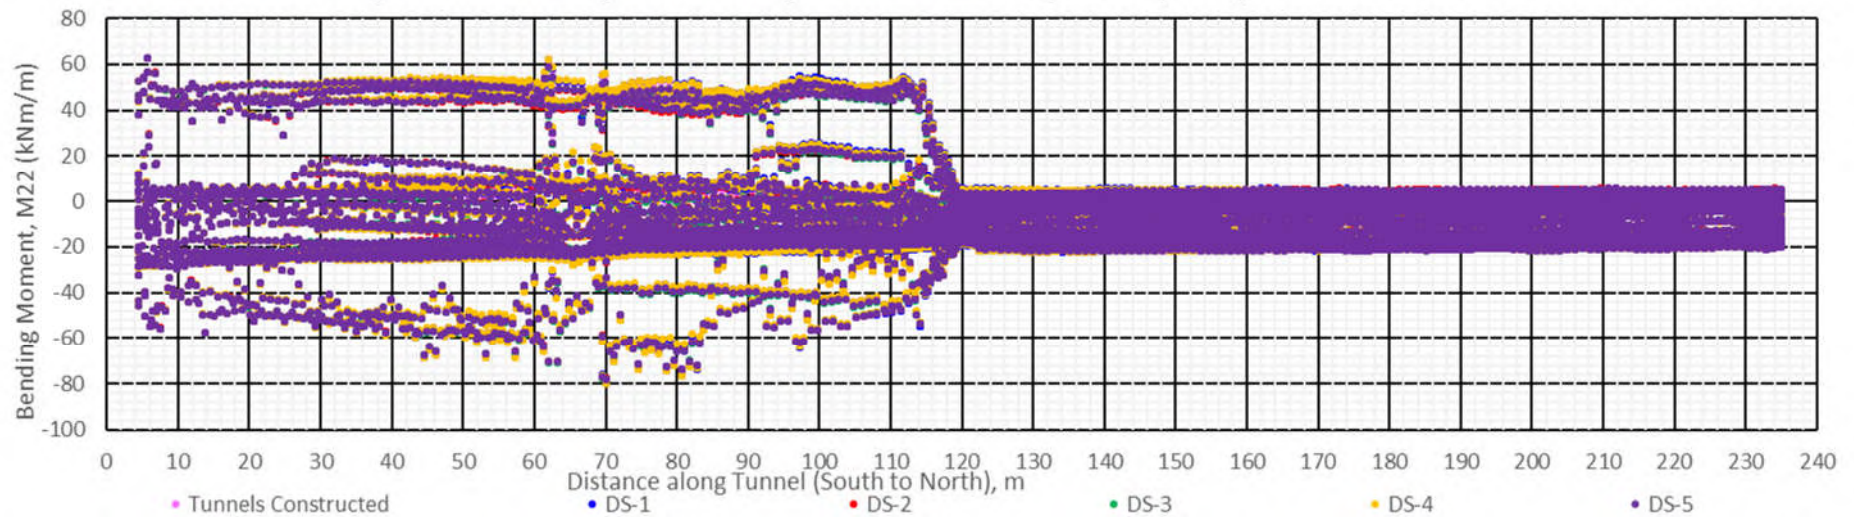


Figure C-16: Bending Moment along DPTs (M22 i.e. transversely across tunnel) SB HSS

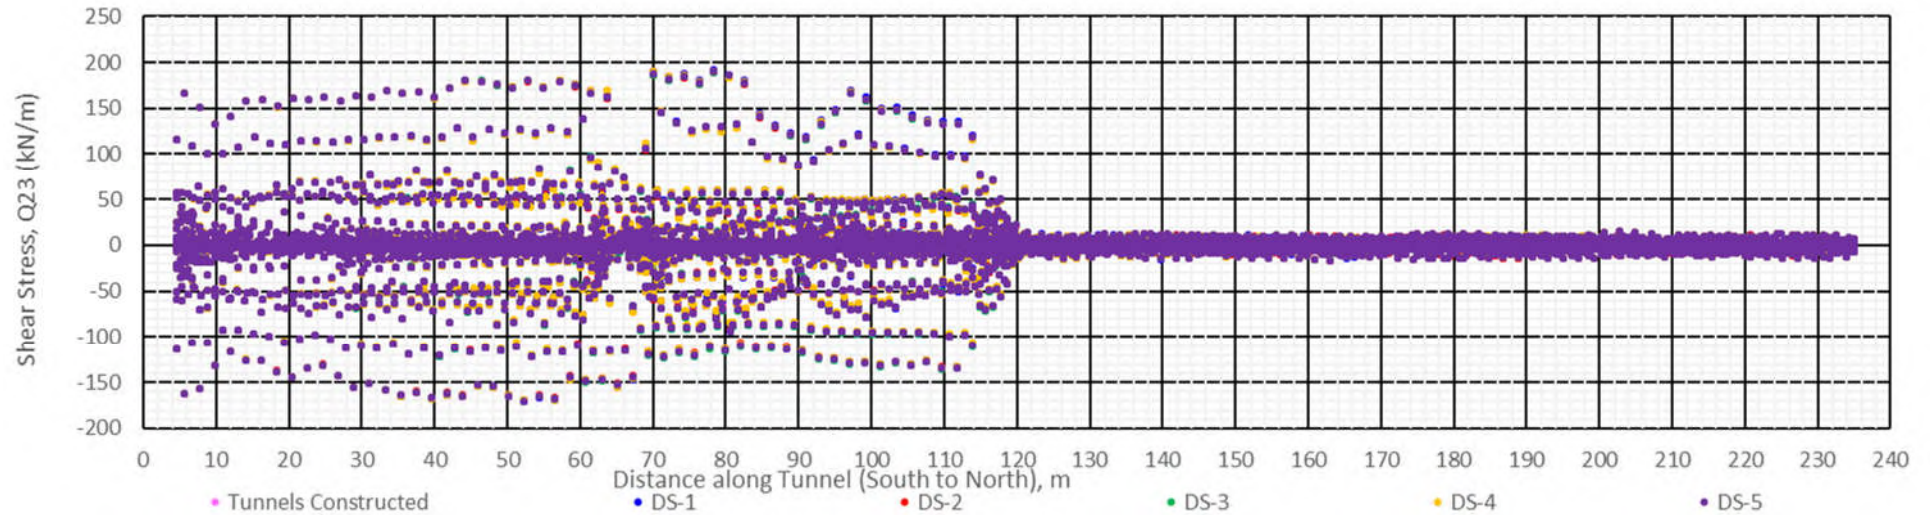


Figure C-17: Shear Force along DPTs (Q_{23} i.e. Transversely across tunnel) SB HSS

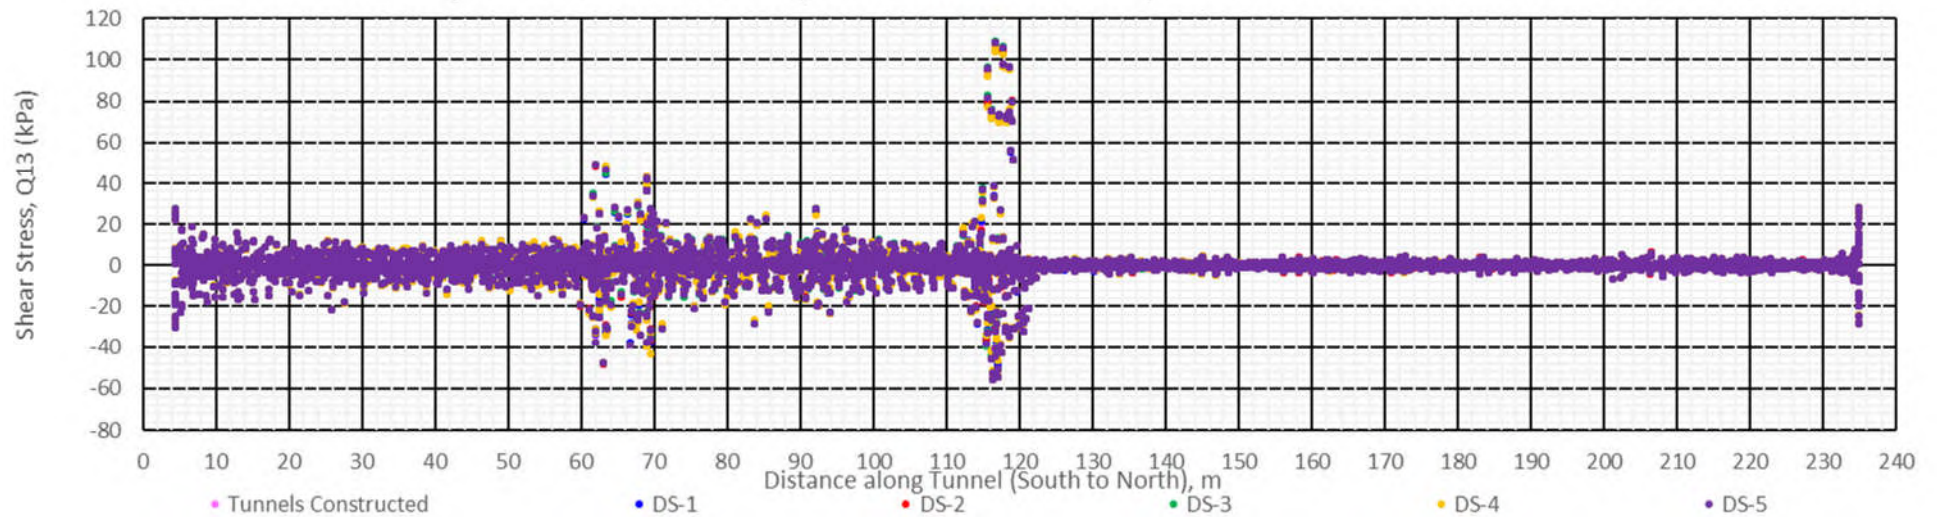



Figure C-18: Shear Force along DPTs (Q_{13} i.e. Longitudinally along tunnel) SB HSS

APPENDIX D

NOT USED

APPENDIX E

PUNCH CONSULTING CHARACTERISTIC BEARING PRESSURES BELOW BUILDINGS & BASEMENT

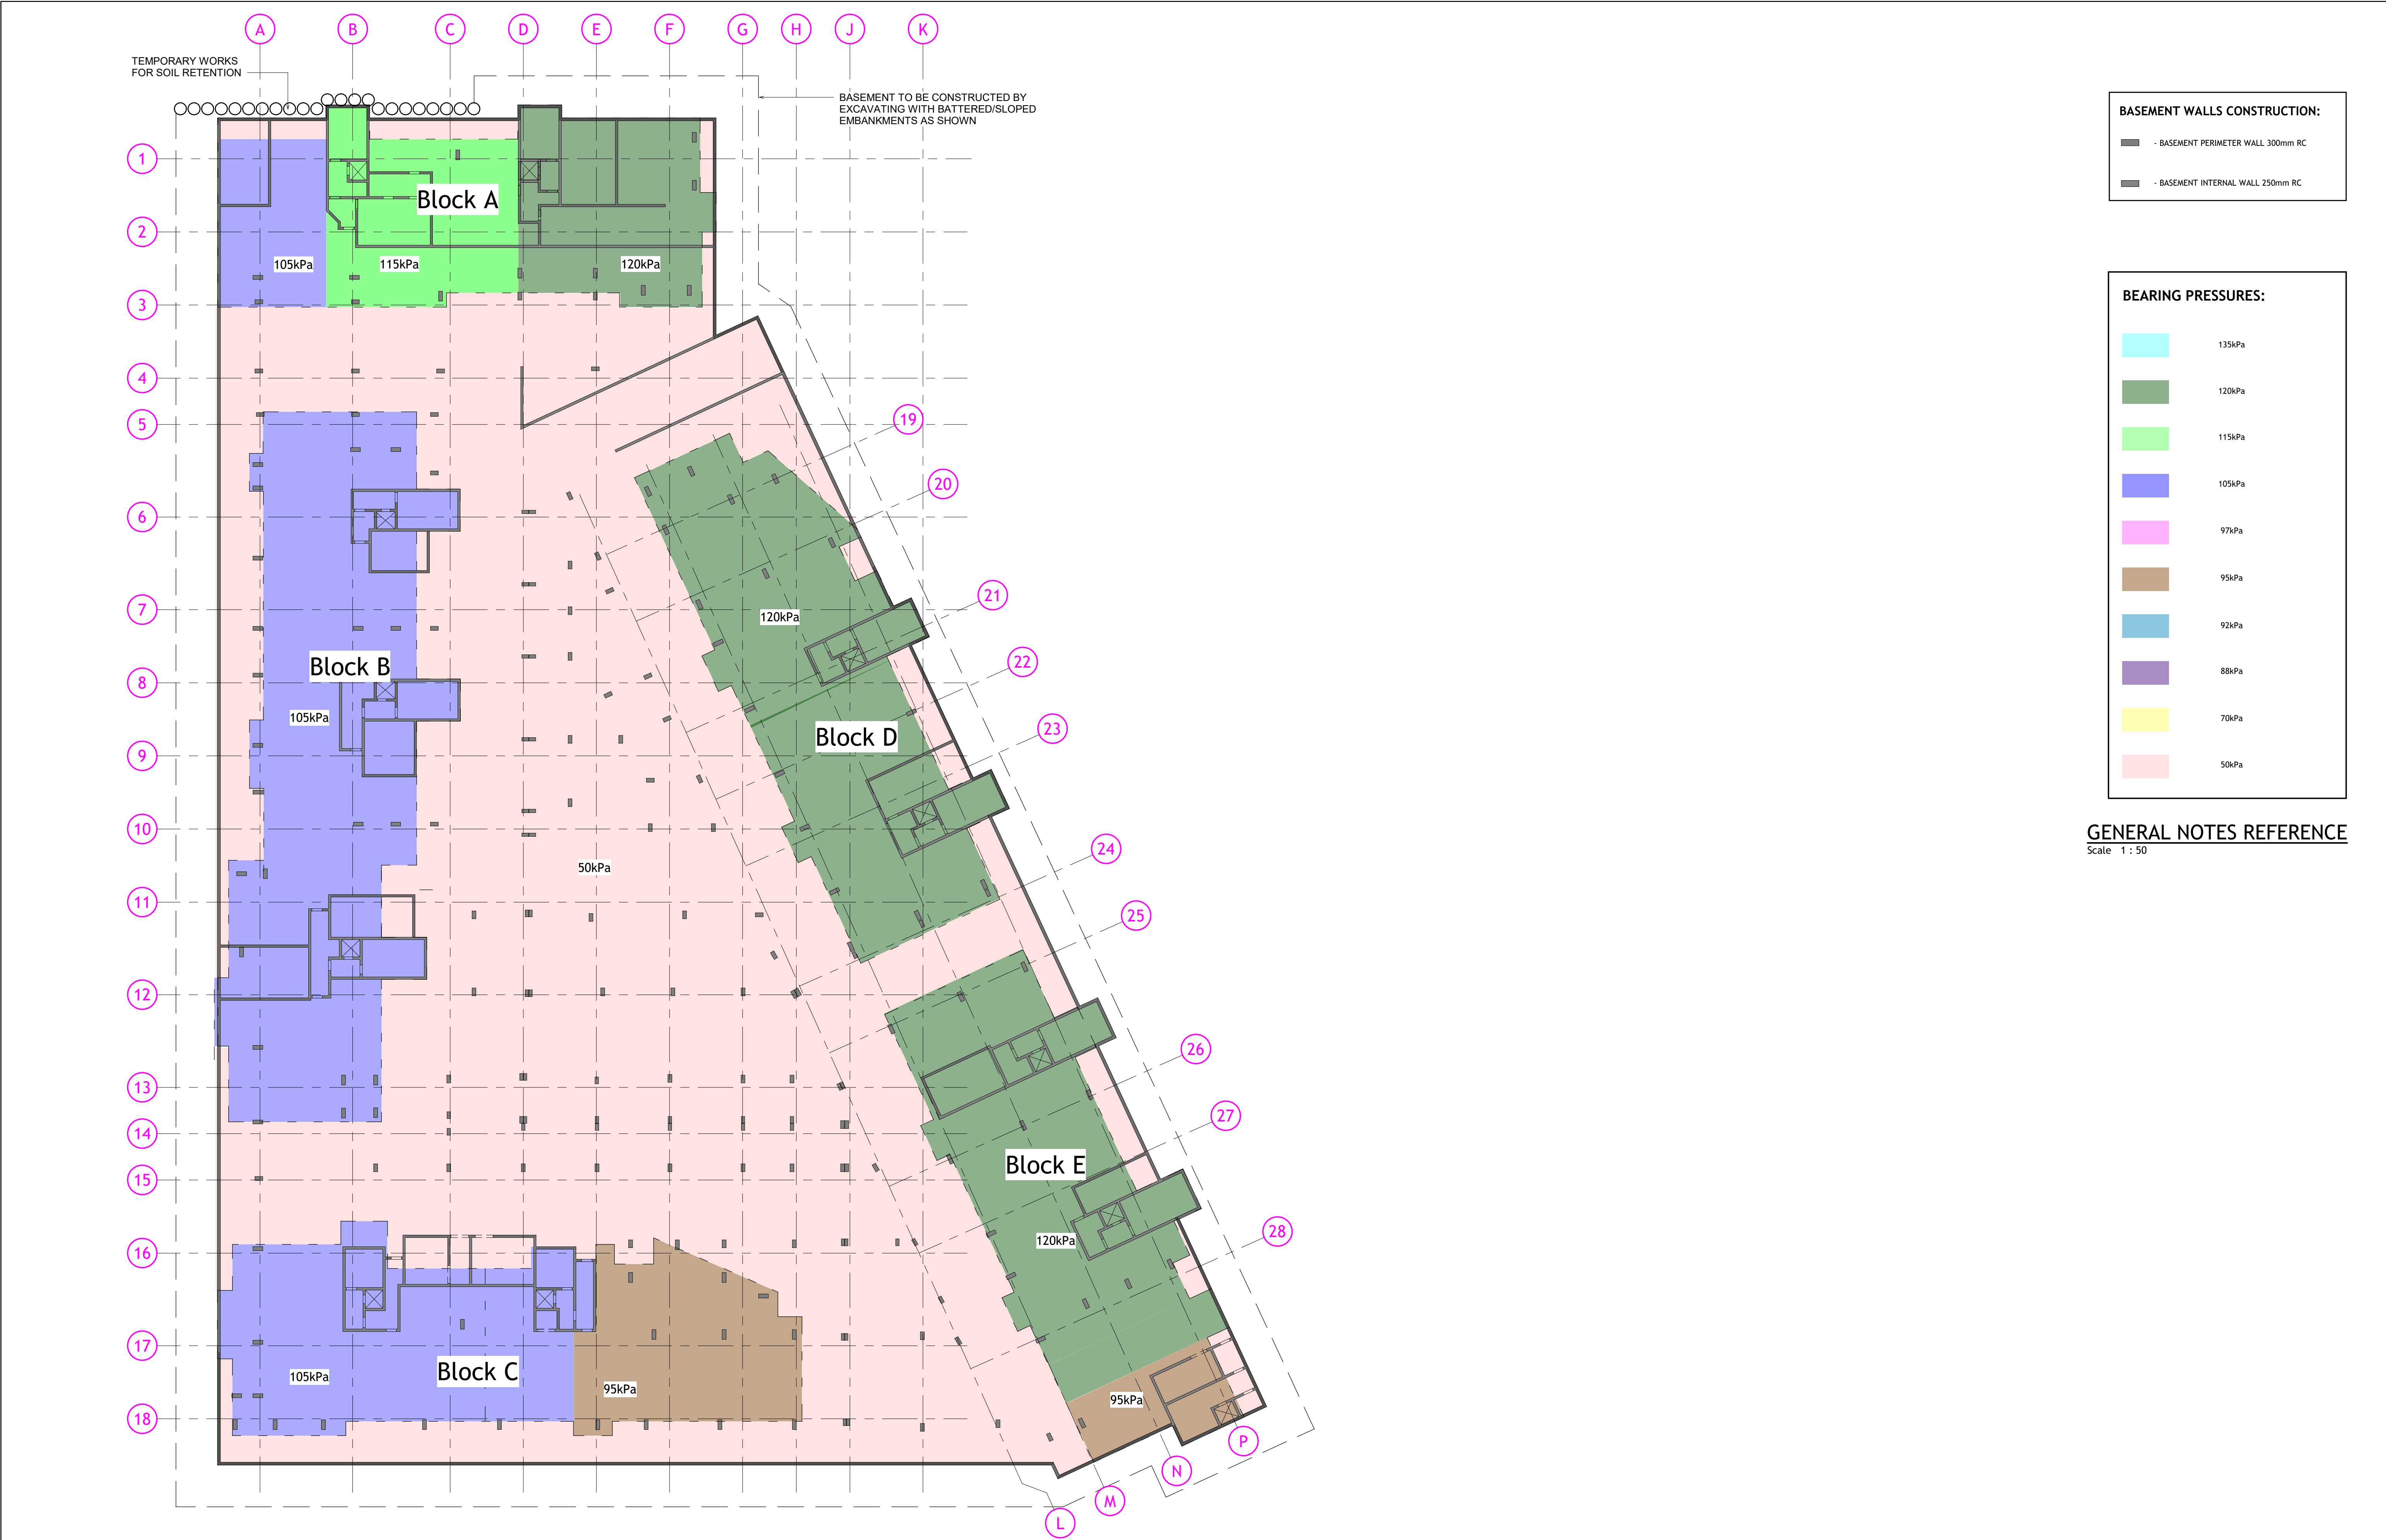

Rev	Amendment	By	Date
P02	ISSUED FOR INFORMATION	VB	2022-02-04

Client:

EASTWISE

2D contact stresses

Values: σ_z


Linear calculation

Combination: SLS-Char (auto)

Extreme: Global

Selection: All

Location: In nodes avg.. System: LCS
mesh element

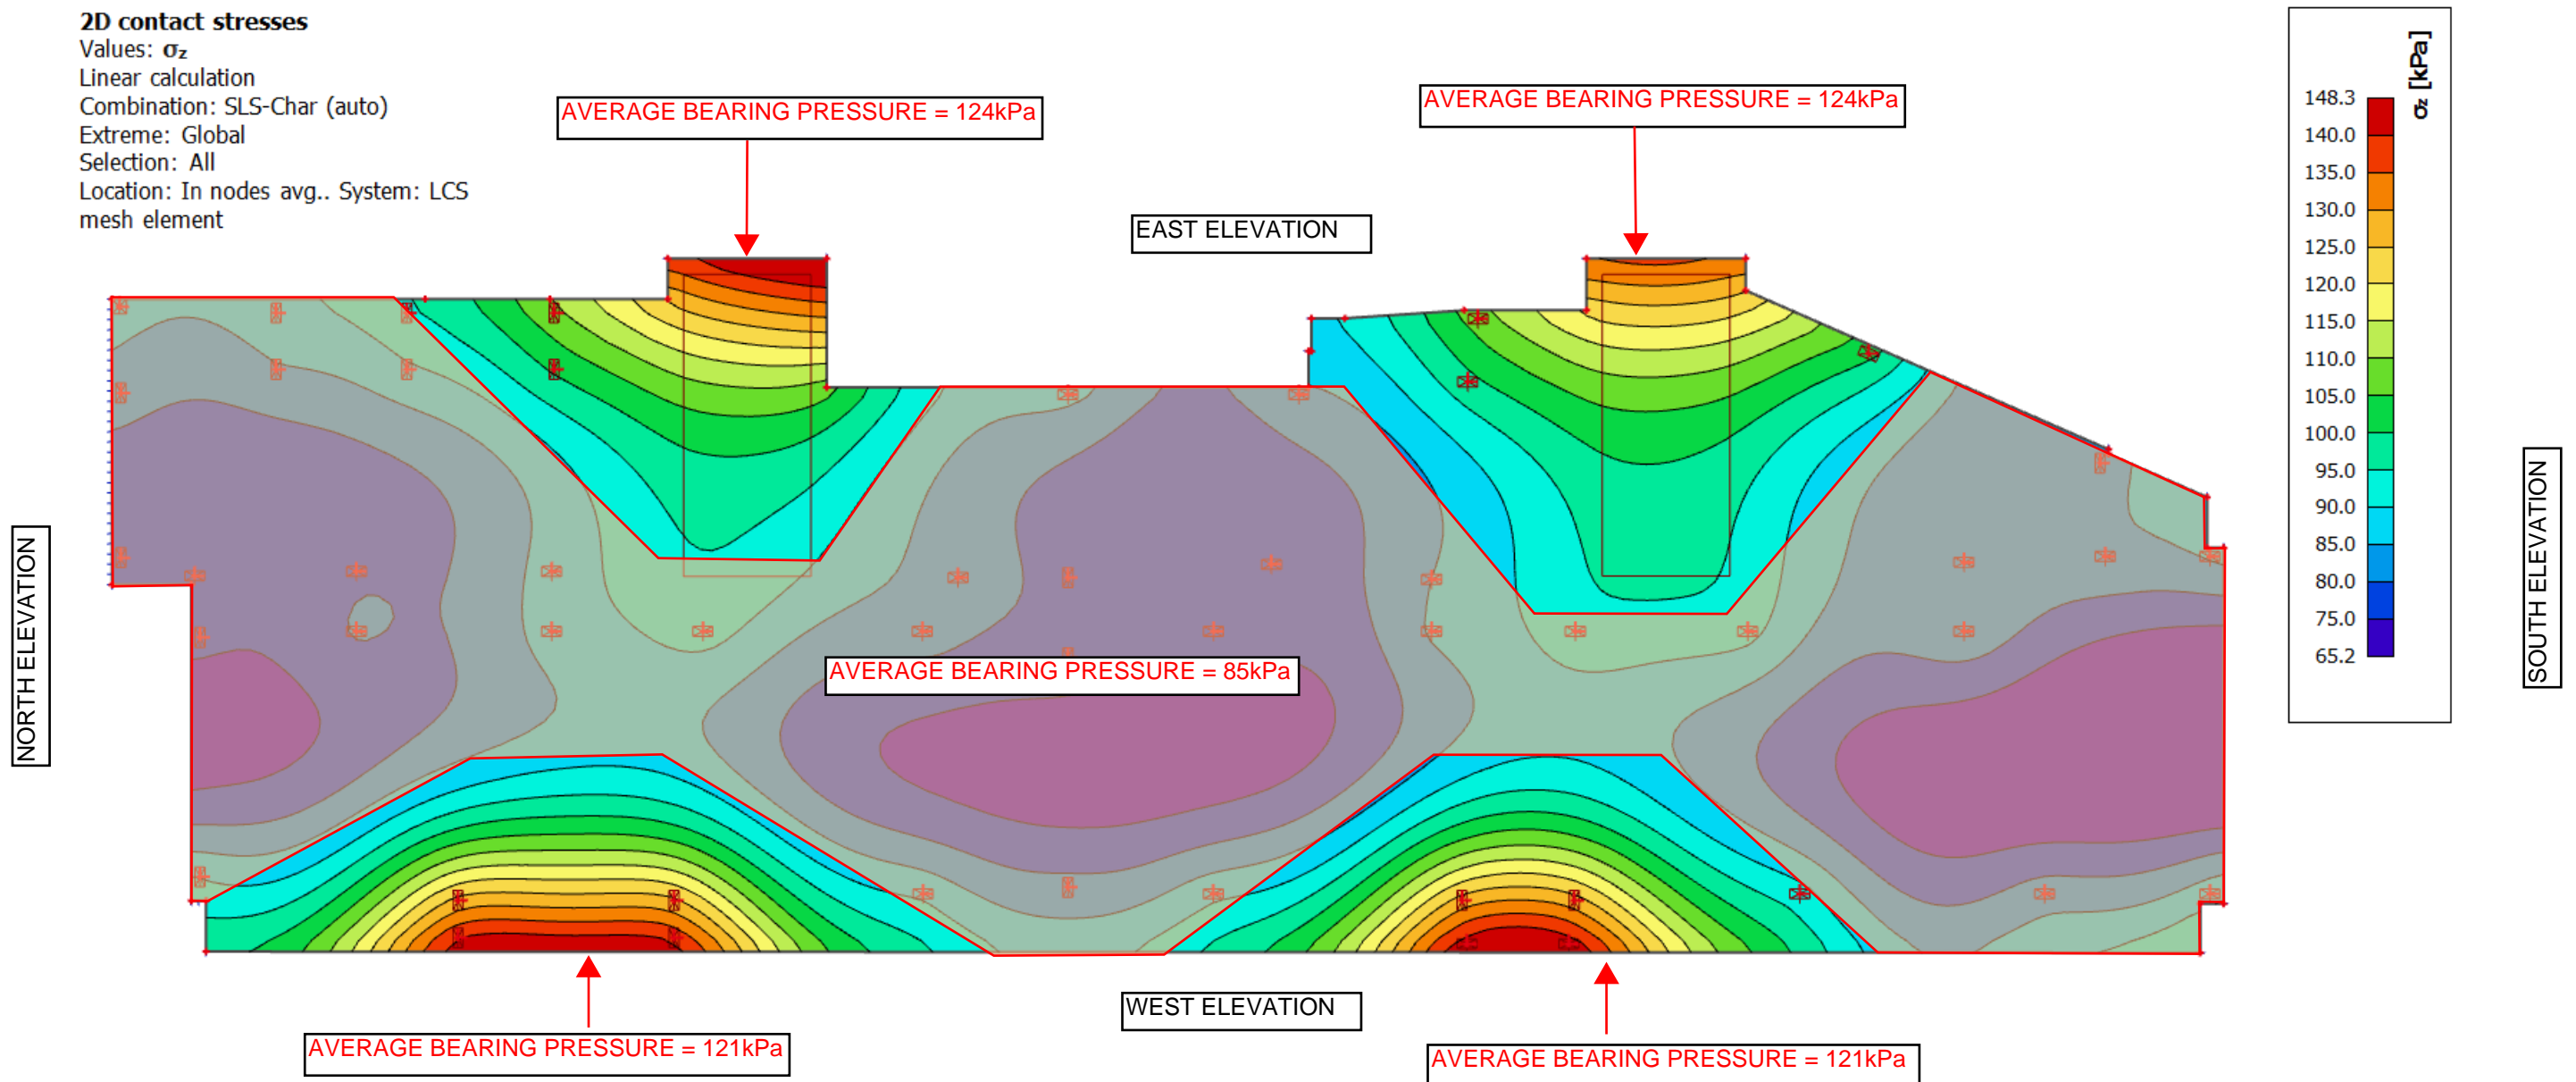

HARTFIELD PLACE
BLOCK F
Bearing Pressures



Sketch Ref:

202 _ 122 | RH | 14 _ 07 _ 23 |

Project No. By Date SK No.

2D contact stresses

Values: σ_z


Linear calculation

Combination: SLS-Char (auto)

Extreme: Global

Selection: All

Location: In nodes avg.. System: LCS
mesh element

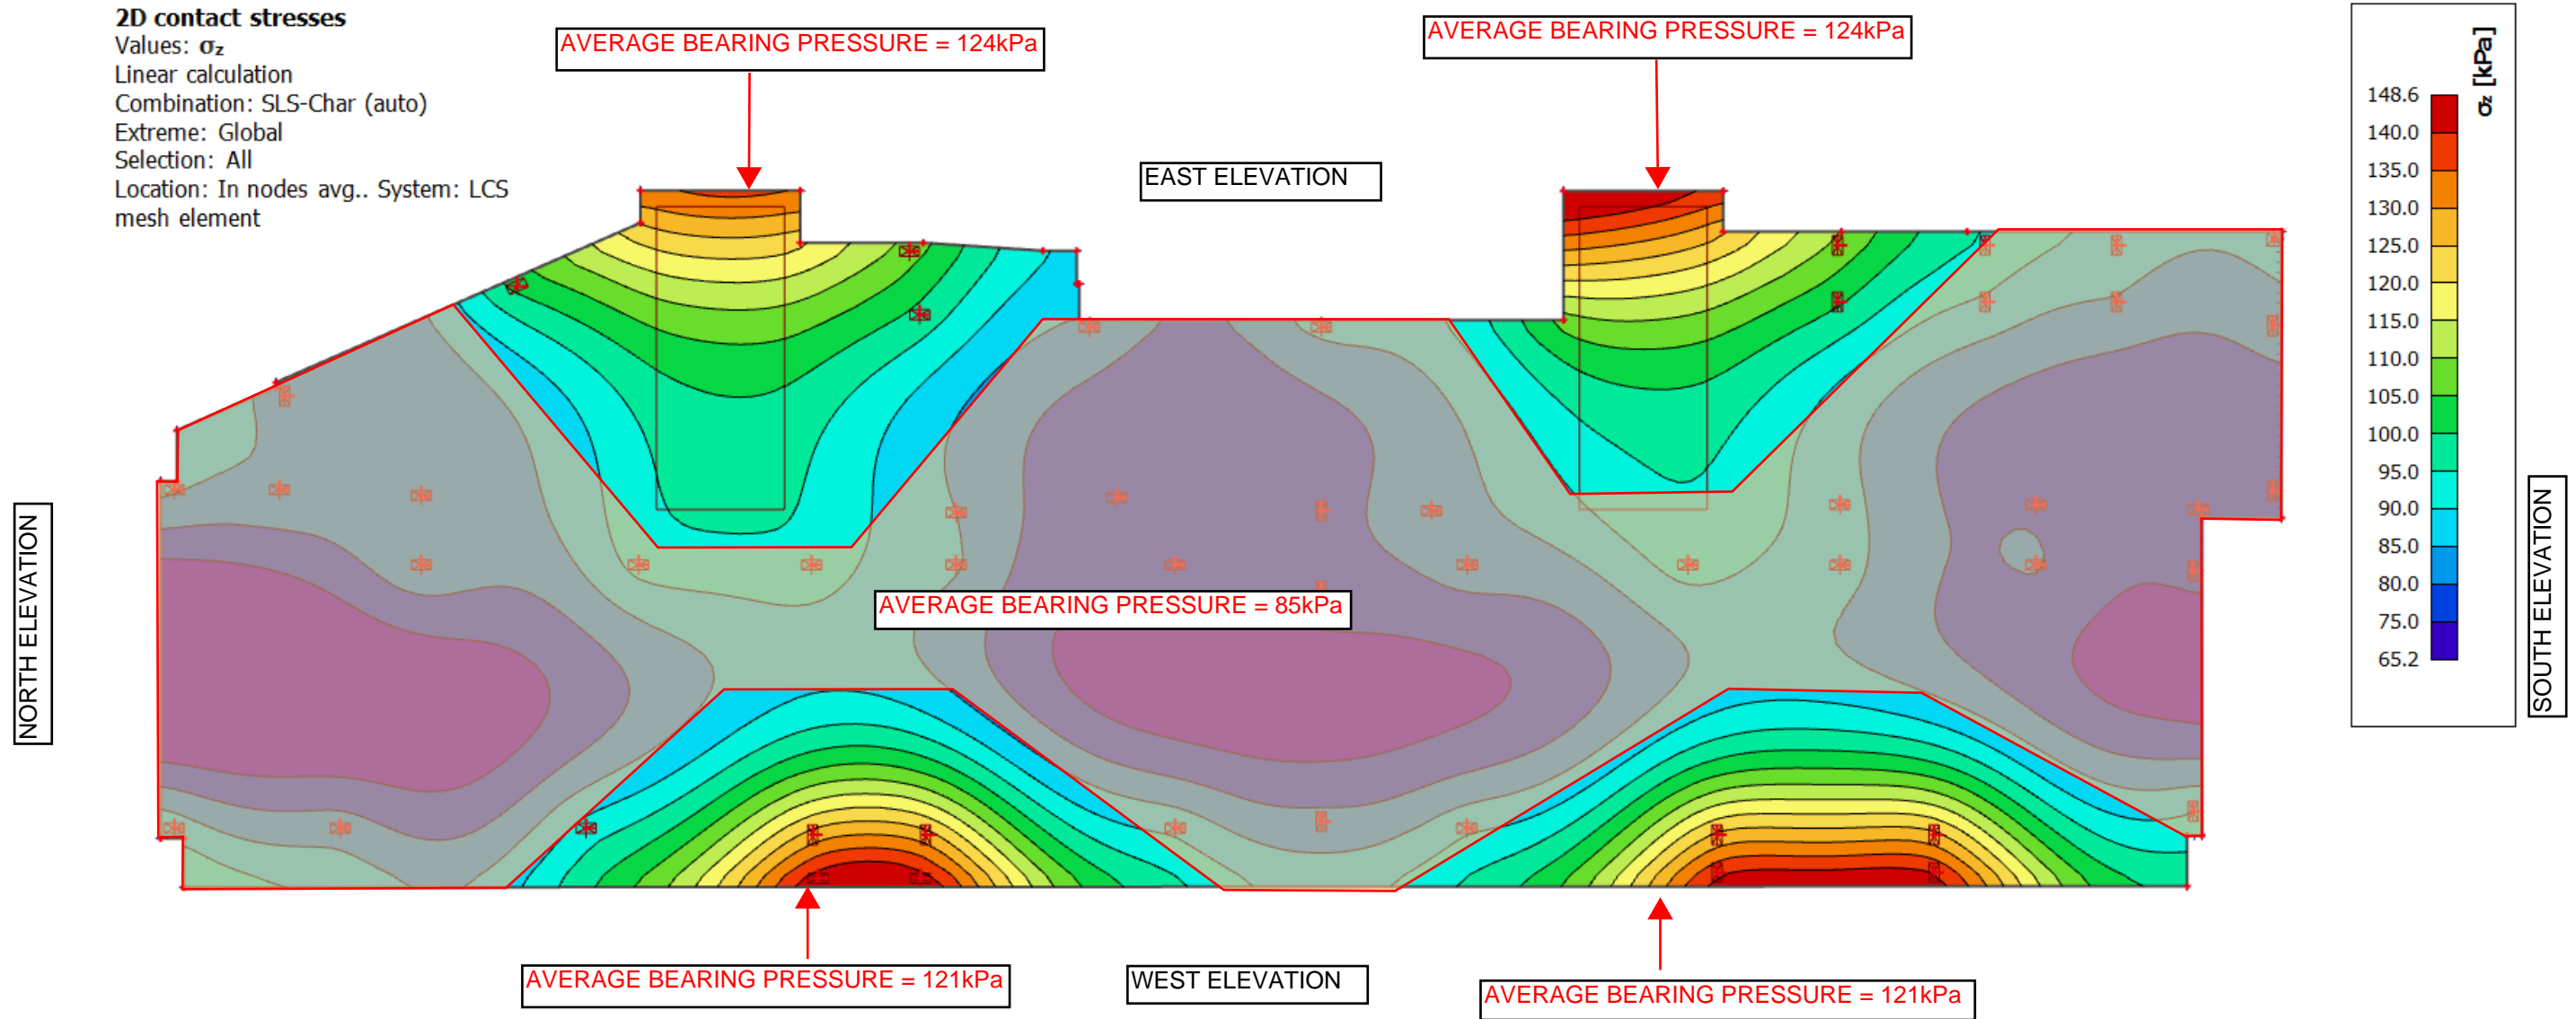

HARTFIELD PLACE
BLOCK G
Bearing Pressures



Sketch Ref:

202 _ 122 | RH | 14 _ 07 _ 23 |

Project No. By Date SK No.

APPENDIX F

PLAXIS 3D RESULTS – CONSTRUCTION SEQUENCE

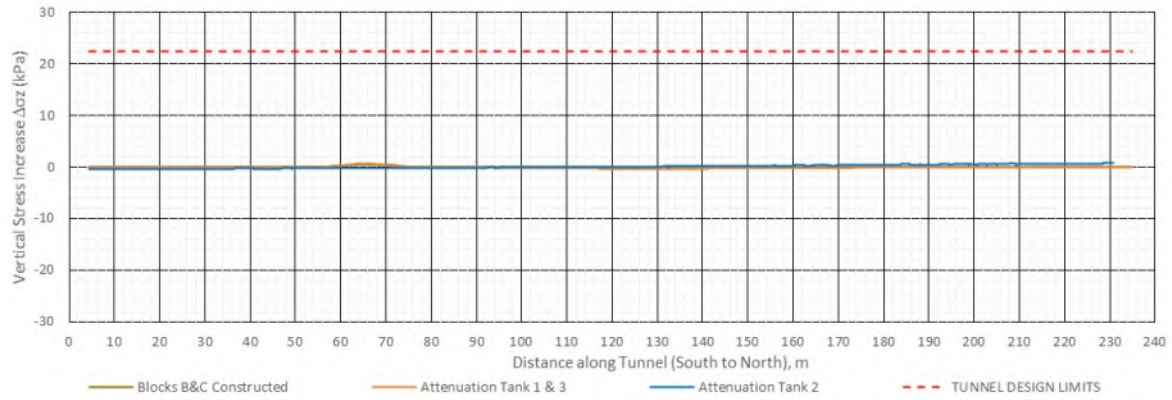


Figure F-1: Change in Total Stress on Tunnel Crown (Northbound) MC - increase is + ive: Blocks B&C (load applied), Attenuation tanks 1, 2, 3

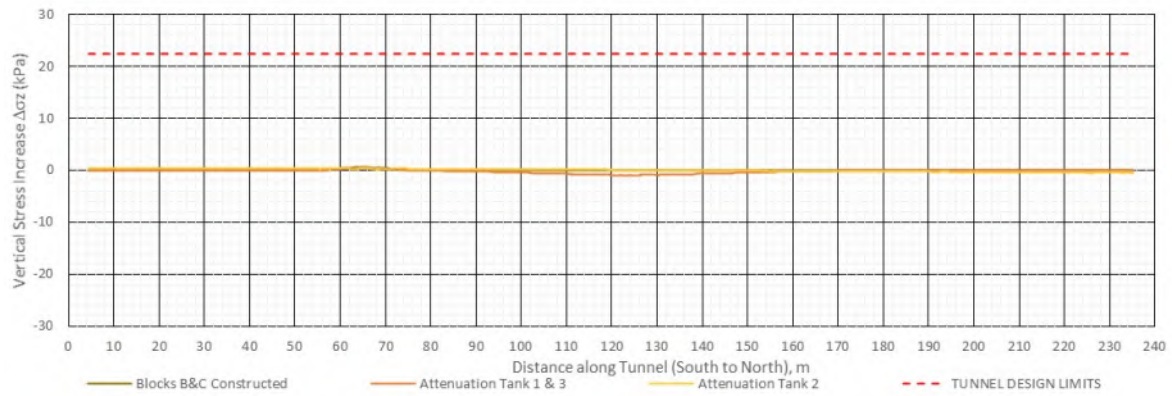


Figure F-2: Change in Total Stress on Tunnel Crown (Southbound) MC - increase is + ive: Blocks B&C (load applied), Attenuation tanks 1, 2, 3

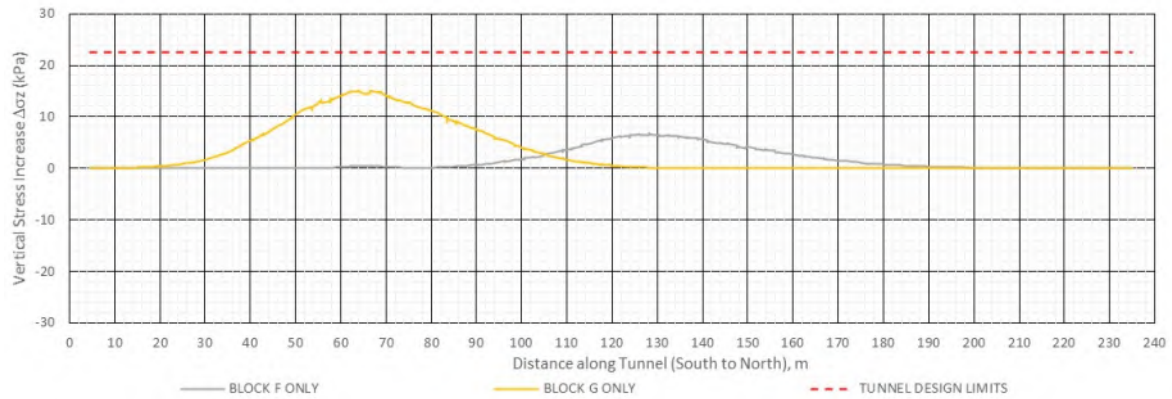


Figure F-3: Change in Total Stress on Tunnel Crown (Northbound) MC - increase is + ive: Blocks F & G

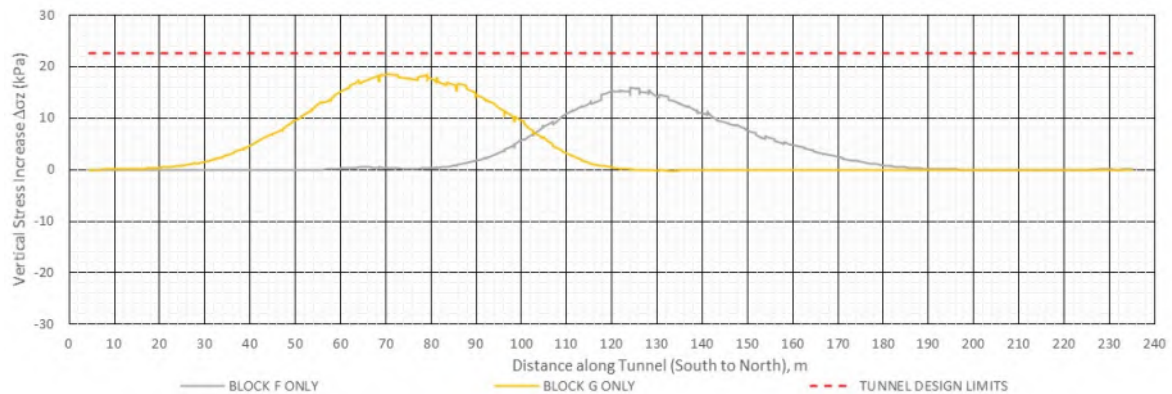


Figure F-4: Change in Total Stress on Tunnel Crown (Southbound) MC - increase is + ive: Blocks F & G

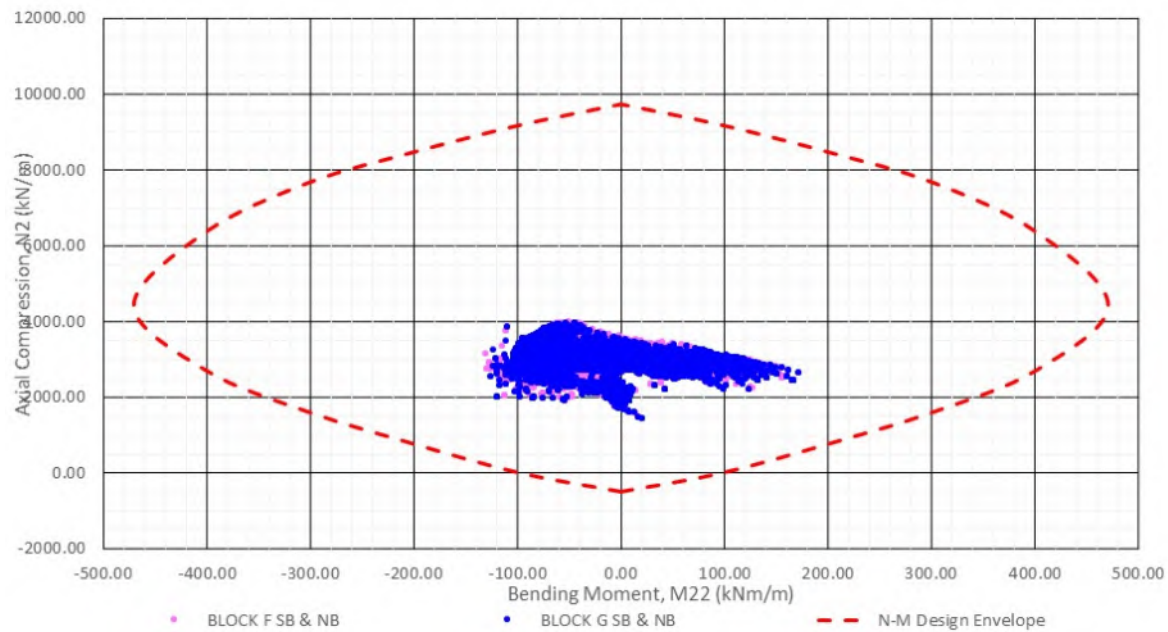


Figure F-5: Design N-M Interaction Chart for tunnel lining along transverse direction with Plaxis 3D results plotted - MC NB&SB: Blocks F & G

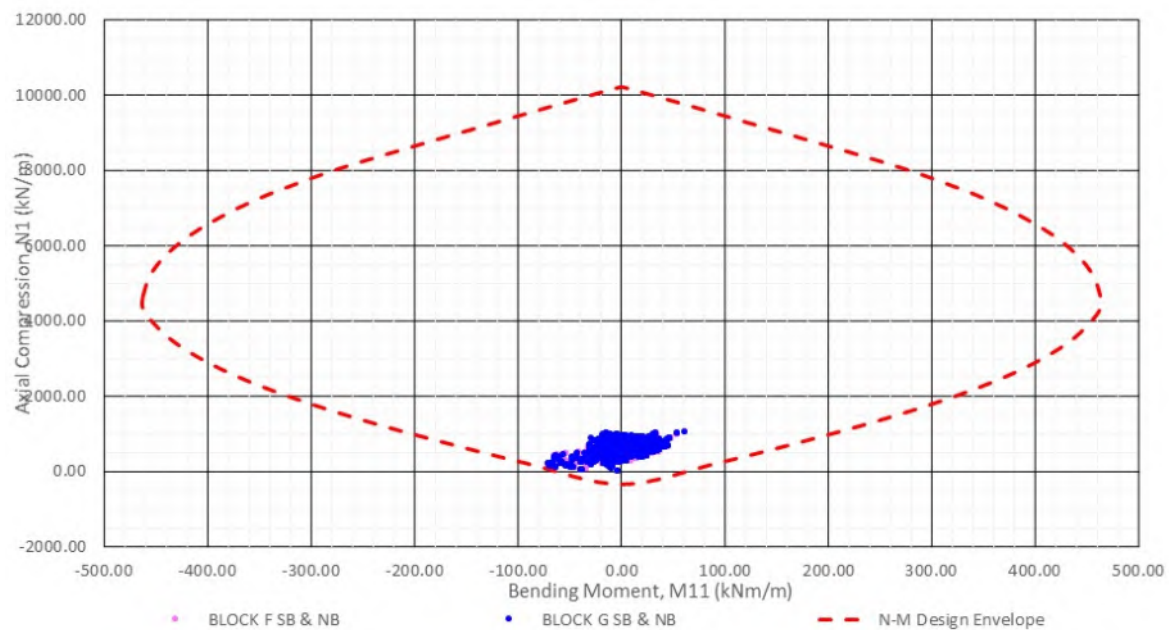


Figure F-6: Design N-M Interaction Chart for tunnel lining along longitudinal direction with Plaxis 3D results plotted - MC NB&SB: Blocks F & G

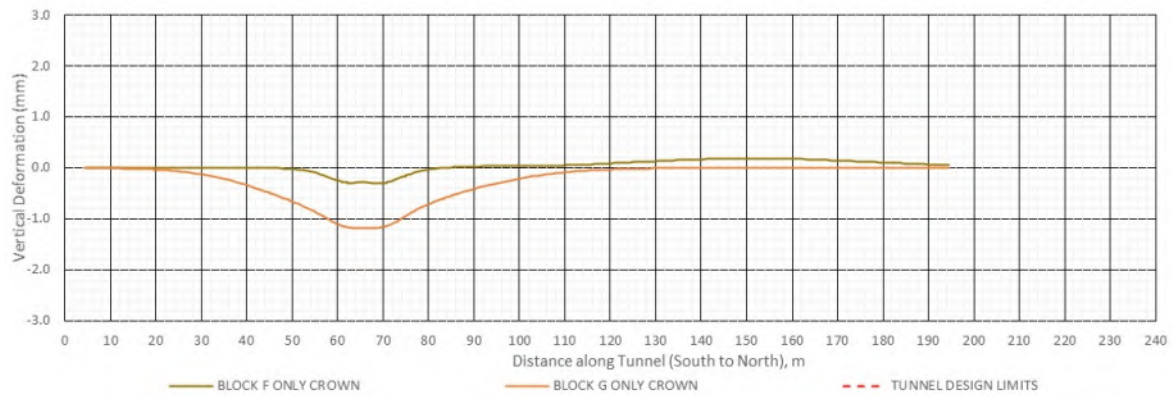


Figure F-7: Vertical Displacements on Tunnel Crown (Northbound) MC: Blocks F & G

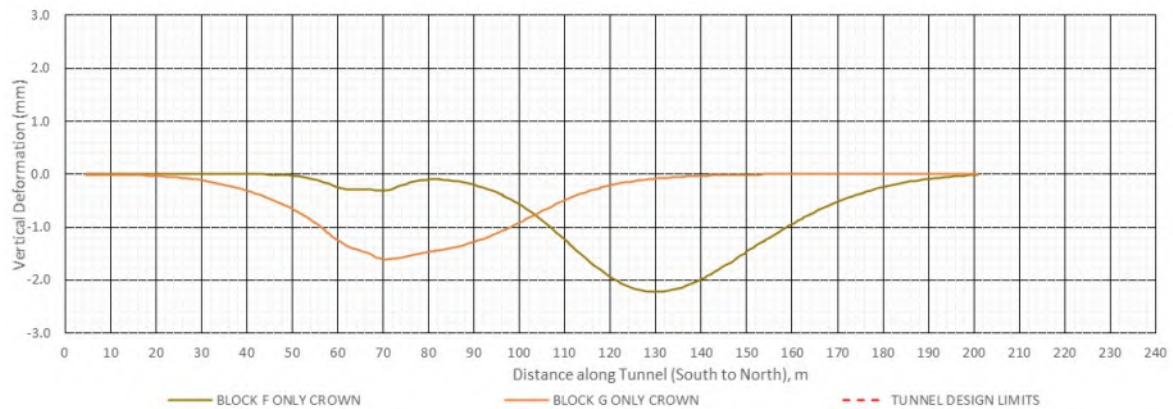


Figure F-8: Vertical Displacements on Tunnel Crown (Southbound) MC: Blocks F & G

APPENDIX G

GII 2010 GROUND INVESTIGATION REPORT

REPORT ON SITE INVESTIGATION

AT

SWORDS ROAD

WHITEHALL

DUBLIN 9

Prepared by: EurGeol Fergal Mc Namara P.Geo.

Signed:.....

Date: 10th May, 2010.

File No: 2442-02-10

Contents

1.0 Preamble

2.0 Overview

2.1 Background

2.2 Purpose and Scope

3.0 Subsurface Exploration

3.1 General

Appendix 1 Borehole Records

Appendix 2 Rock Core Photographs

Appendix 3 Site Plan

1.0 Preamble

On the instructions of Colm Doyle of DBFL Consulting Engineers, a site investigation consisting of four no. rotary cored boreholes was carried out between 6th April and the 19th April 2010 on the above site.

2.0 Overview

2.1 Background

It is proposed to construct a new multi storey apartment development on the site.

2.2 Purpose and Scope

The purpose of the site investigation was to determine the depth to bedrock at the chosen locations and the nature and quality of the rock by means of rotary coring.

The scope of the work undertaken for this study included the following:

- Visit project site to observe existing conditions
- Carrying out of the subsurface exploration programme consisting of 4 no. rotary cored boreholes.
- Detailed logs as per specification

3.0 Subsurface Exploration

3.1 General

Four number 100mm diameter rotary cored boreholes were proposed in positions designed to give a rock profile over the site in the vicinity of the port tunnel.

Competent Bedrock was encountered at 25.50mBGL at the location of RC1, 22.00mBGL at the location of RC2, 21.00mBGL at the location of RC3 and 26.30mBGL at the location of RC4. The bedrock generally consisted of strong dark grey medium grained LIMESTONE with minor black calcareous MUDSTONE.

Recovery was generally 75% to 95% and the rock was slightly to moderately weathered. Poor recovery was encountered in RC2 of 15% due to weaker black calcareous mudstone in this area being washed away. Rotary cored borehole logs from the Dublin Port Tunnel site investigation were supplied to GII by the engineer for comparison. The nearest borehole to RC1 and RC4 is rotary cored borehole 262 which notes competent LIMESTONE bedrock at 26.00mBGL. Bedrock consists of

LIMESTONES with minor calcareous mudstone, this is consistent with the findings in this report from RC1 and RC4. The nearest boreholes to RC2 and RC3 are rotary cored boreholes 211 and 507 which note competent LIMESTONE bedrock at 20.00mBGL and 24.17mBGL respectively consisting of LIMESTONES with minor calcareous mudstones. This is consistent with the findings in this report from RC2 and RC3.

The locations of the exploratory holes are shown on the accompanying site plan.

Detailed logs of the boreholes can be found at the rear of this report.

BOREHOLE RECORD (Rotary core)

Project Name: Swords Road	Hole ID: RC1
---------------------------	--------------

Hole ID: RC1

—

—

2442-02-10

T. Collins

N. Sheehan

Strata Description	Legend	Depth	Level mAOD	Discontinuities	FSI	RQD	SCR	TCR	CORE RUN
OVERBURDEN - driller notes boulder clay with sand seams									

Continued next sheet

Remarks:
Rotary openhole borehole to 23.10mBGL then hole continued by rotary coring techniques. Driller notes that between 30.00 and 31.00mBGL, 0.60m of core was lost downhole from the core barrel.

KEY	
TCR	Total Core Recovery.
SCR	Solid Core Recovery
RQD	Rock Quality Designation
FSI	Fracture Spacing Index

Total Core Recovery.
Solid Core Recovery
Rock Quality Designation
Fracture Spacing Index



BOREHOLE RECORD (Rotary core)

Project Name: Swords Road	Hole ID: RC1
---------------------------	--------------

Hole ID: RC1

Client:

Co-ordinates:	-
	-

Consultant: DBFL

Elevation: -

Location: Whitehall, Dublin

Project no. 2442-02-10

Start date: 12/04/2010 End date: 14/04/2010

End date: 14/04/2010

Drilled by: T. Collins

Type of drilling: RC Hole diameter: 63 mm

Hole diameter: 63 mm

mm	Logged by:	N. Sheehan							7
----	------------	------------	--	--	--	--	--	--	---

Logged by: N. Sheehan

[illegible]

Continued next sheet

Remarks:

Rotary openhole borehole to 23.10mBGL then hole continued by rotary coring techniques. Driller notes that between 30.00 and 31.00mBGL, 0.60m of core was lost downhole from the core barrel.

KEY

TCR
SCR
RQD
FSI

Total Core Recovery.
Solid Core Recovery
Rock Quality Designation
Fracture Spacing Index



BOREHOLE RECORD (Rotary core)

Project Name: Swords Road

Hole ID: RC1

Client:

Consultant: DBFL

Location: Whitehall, Dublin

Start date: 12/04/2010

End date: 14/04/2010

Type of drilling: RC

Hole diameter: 63 mm

Co-ordinates: -

Elevation: -

Project no. 2442-02-10

Drilled by: T. Collins

Logged by: N. Sheehan

Strata Description	Legend	Depth	Level mAOD	Discontinuities	FSI	RQD	SCR	TCR	CORE RUN
OVERBURDEN - driller notes boulder clay with sand seams									
			21						
			22						
			23						
			23.10						
Recovery consists of stiff dark grey black sandy gravelly CLAY with cobbles and boulders						0	0	78	23.10
			24						
			25			0	0	61	24.60
Band of grey brown fine SAND			25.10						
			25.50						
Strong dark grey LIMESTONE with interbanding layers of calcareous mudstone, calcite veining present, fresh to slightly weathered				Mostly Non-Intact	N.I				
			26						
			27	Fractures range from medium to closely spaced, sub-horizontal to 20degrees, planar, rough to smooth, tight to open and clay coated	8	47	56	77	26.10
			28			38	38	95	27.60
			29	Mostly Non-Intact	N.I				
				Fractures range from medium to closely spaced, 30degrees, planar, rough to smooth, tight to open and clay coated		67	88	100	28.60
					10				

Continued next sheet

Remarks:

Rotary openhole borehole to 23.10mBGL then hole continued by rotary coring techniques.
Driller notes that between 30.00 and 31.00mBGL, 0.60m of core was lost downhole from the core barrel.

KEY

TCR Total Core Recovery.
SCR Solid Core Recovery
RQD Rock Quality Designation
FSI Fracture Spacing Index



BOREHOLE RECORD (Rotary core)

Project Name: Swords Road	Hole ID: RC2
---------------------------	--------------

Hole ID: RC2

Client:	Co-ordinates:	-
Consultant: DBFL		-
Location: Whitehall, Dublin	Elevation:	-
Start date: 06/04/2010	Project no.	2442-02-10
End date: 12/04/2010	Drilled by:	T. Collins
Type of drilling: RC	Hole diameter: 63 mm	Logged by: N. Sheehan

Strata Description	Legend	Depth Level mAOD	Discontinuities	FSI	RQD	SCR	TCR	CORE RUN
OVERBURDEN - driller notes boulder clay with boulders and sand bands		<div><div>1</div><div>2</div><div>3</div><div>4</div><div>5</div><div>6</div><div>7</div><div>8</div><div>9</div></div>						
Continued next sheet								

Remarks:

Rotary openhole borehole to 22.00mBGL then hole continued by rotary coring techniques.

TCR	Total Core Recovery.
SCR	Solid Core Recovery
RQD	Rock Quality Designation
FSI	Fracture Spacing Index



BOREHOLE RECORD (Rotary core)

Project Name: Swords Road

Hole ID: RC2

Client:

Co-ordinates: -

Consultant: DBFL

Elevation: -

Location: Whitehall, Dublin

Project no. 2442-02-10

Start date: 06/04/2010



End date: 12/04/2010

Drilled by: T. Collins

Type of drilling: RC

Hole diameter: 63 mm

Logged by: N. Sheehan

Strata Description	Legend	Depth	Level mAOD	Discontinuities	FSI	RQD	SCR	TCR	CORE RUN
OVERBURDEN - driller notes boulder clay with boulders and sand bands									
Weak to medium strong dark grey decomposed LIMESTONE driller notes black mudstone bands which washed away during coring process, calcite veining present and moderately weathered		22.00	22	Insufficient recovery to determine fracture pattern due to washed away core		10	30	65	22.00
						8	10	15	23.10
					N.I				

Continued next sheet

Remarks:

Rotary openhole borehole to 22.00mBGL then hole continued by rotary coring techniques.

KEY

TCR Total Core Recovery.
SCR Solid Core Recovery
RQD Rock Quality Designation
FSI Fracture Spacing Index



BOREHOLE RECORD (Rotary core)

Project Name: Swords Road

Hole ID: RC2

Client:

Co-ordinates: -

Consultant: DBFL

Elevation: -

Location: Whitehall, Dublin

Project no. 2442-02-10

Start date: 06/04/2010

End date: 12/04/2010

Drilled by: T. Collins

Type of drilling: RC

Hole diameter: 63 mm

Logged by: N. Sheehan

Strata Description

Legend

Depth

Level
m AOD

Discontinuities

FSI

RQD

SCR

TCR

CORE RUN

Weak to medium strong dark grey decomposed LIMESTONE driller notes black mudstone bands which washed away during coring process, calcite veining present and moderately weathered

End of Borehole Log at 31.00 m

31.00 31

32

33

34

35

36

37

38

39

Remarks:

Rotary openhole borehole to 22.00mBGL then hole continued by rotary coring techniques.

KEY

TCR
SCR
RQD
FSI

Total Core Recovery.
Solid Core Recovery
Rock Quality Designation
Fracture Spacing Index



BOREHOLE RECORD (Rotary core)

Project Name: Swords Road	Hole ID: RC3
---------------------------	--------------

Hole ID: RC3

Client:

Consultant: DBFL

Location: Whitehall, Dublin

Start date: 15/04/2010 End date: 19/04/2010

End date: 19/04/2010

Co-ordinates:	-
	-

Elevation: -

Project no. 2442-02-10

Drilled by: T. Collins

Hole diameter: 63 mm

Logged by: N. Sheehan

N. Sheehan					7
------------	--	--	--	--	---

[illegible]

Remarks:

Rotary openhole borehole to 21.00mBGL then hole continued by rotary coring techniques.

KEY

TCR	Total Core Recovery.
SCR	Solid Core Recovery
RQD	Rock Quality Designation
FSI	Fracture Spacing Index

Total Core Recovery.
Solid Core Recovery
Rock Quality Designation
Fracture Spacing Index



BOREHOLE RECORD (Rotary core)

Project Name: Swords Road

Hole ID: RC3

Client:

Consultant: DBFL

Location: Whitehall, Dublin

Start date: 15/04/2010

End date: 19/04/2010

Type of drilling: RC

Hole diameter: 63 mm

Co-ordinates: -

Elevation: -

Project no. 2442-02-10

Drilled by: T. Collins

Logged by: N. Sheehan

Strata Description	Legend	Depth	Level mAOD	Discontinuities	FSI	RQD	SCR	TCR	CORE RUN
OVERBURDEN - driller notes boulder clay with sand seams									
Medium strong to strong dark grey LIMESTONE with interbanding layers of black calcareous mudstone, calcite veining present, fresh to slightly weathered		21.00	21	Fractures range from close to very closely spaced, 20degrees, smooth, tight to open and clay coated. Non intact from 24.20 to 24.60mBGL	14	39	67	81	21.00
						16	27	73	23.10
Strong to very strong dark grey LIMESTONE, calcite veining present, fresh to slightly weathered		24.60	25	Fractures range from medium to closely spaced, sub-horizontal to 30degrees, undulating, rough to smooth, tight to open	9	58	69	81	24.60
						57	69	85	26.10
						36	78	85	27.60
						29	29	49	29.10
Continued next sheet				Fractures range from very close to extremely closely spaced,					

Remarks:

Rotary openhole borehole to 21.00mBGL then hole continued by rotary coring techniques.

KEY

TCR Total Core Recovery.
SCR Solid Core Recovery
RQD Rock Quality Designation
FSI Fracture Spacing Index



BOREHOLE RECORD (Rotary core)

Project Name: Swords Road

Hole ID: RC3

Client:

Co-ordinates: -

Consultant: DBFL

Elevation: -

Location: Whitehall, Dublin

Project no. 2442-02-10

Start date: 15/04/2010

End date: 19/04/2010

Drilled by: T. Collins

Type of drilling: RC

Hole diameter: 63 mm

Logged by: N. Sheehan

Strata Description

Legend

Depth

Level
mAOD

Discontinuities

FSI

RQD

SCR

TCR

CORE RUN

Strong to very strong dark grey
LIMESTONE, calcite veining
present, fresh to slightly
weathered

End of Borehole Log at 30.60 m

sub-horizontal, undulating, rough to
smooth, tight to open

30.60

31

32

33

34

35

36

37

38

39

20

Remarks:

Rotary openhole borehole to 21.00mBGL then hole continued by rotary coring techniques.

KEY

TCR
SCR
RQD
FSI

Total Core Recovery.
Solid Core Recovery
Rock Quality Designation
Fracture Spacing Index



BOREHOLE RECORD (Rotary core)

Project Name: Swords Road	Hole ID: RC4
---------------------------	--------------

Hole ID: RC4

Client:	Co-ordinates:	-
Consultant: DBFL		-
Location: Whitehall, Dublin	Elevation:	-
Start date: 14/04/2010	Project no.	2442-02-10
End date: 15/04/2010	Drilled by:	T. Collins
Type of drilling: RC	Hole diameter: 63 mm	Logged by: N. Sheehan

Strata Description	Legend	Depth Level mAOD	Discontinuities	FSI	RQD	SCR	TCR	CORE RUN
OVERBURDEN - driller notes boulder clay		<div>1</div> <div>2</div> <div>3</div> <div>4</div> <div>5</div> <div>6</div> <div>7</div> <div>8</div> <div>9</div>						
Continued next sheet								

Remarks:	Rotary openhole borehole to 22.60mBGL then hole continued by rotary coring techniques.
----------	--

TCR	Total Core Recovery.
SCR	Solid Core Recovery
RQD	Rock Quality Designation
FSI	Fracture Spacing Index



BOREHOLE RECORD (Rotary core)

Project Name: Swords Road	Hole ID: RC4
---------------------------	--------------

Hole ID: RC4

Client:	Co-ordinates:	-
Consultant: DBFL		-
Location: Whitehall, Dublin	Elevation:	-
Start date: 14/04/2010	Project no.	2442-02-10
End date: 15/04/2010	Drilled by:	T. Collins
Type of drilling: RC	Hole diameter: 63 mm	Logged by: N. Sheehan

Strata Description	Legend	Depth Level mAOD	Discontinuities	FSI	RQD	SCR	TCR	CORE RUN
OVERBURDEN - driller notes boulder clay		<div> <div></div> <div>11</div> <div></div> <div>12</div> <div></div> <div>13</div> <div></div> <div>14</div> <div></div> <div>15</div> <div></div> <div>16</div> <div></div> <div>17</div> <div></div> <div>18</div> <div></div> <div>19</div> </div>						

Remarks:
Rotary openhole borehole to 22.60mBGL then hole continued by rotary coring techniques.

KEY	
TCR	Total Core Recovery.
SCR	Solid Core Recovery
RQD	Rock Quality Designation
FSI	Fracture Spacing Index



BOREHOLE RECORD (Rotary core)

Project Name: Swords Road

Hole ID: RC4

Client:

Consultant: DBFL

Location: Whitehall, Dublin

Start date: 14/04/2010

End date: 15/04/2010

Type of drilling: RC

Hole diameter: 63 mm




Co-ordinates: -

Elevation: -

Project no. 2442-02-10

Drilled by: T. Collins

Logged by: N. Sheehan

Strata Description	Legend	Depth	Level mAOD	Discontinuities	FSI	RQD	SCR	TCR	CORE RUN
OVERBURDEN - driller notes boulder clay									
		21							
		22							
		22.60							
Recovery consists of stiff dark grey black sandy gravelly CLAY with cobbles and boulders						0	0	70	22.60
		23							
		24				0	0	100	23.10
		25							
		26				0	0	100	24.60
		26.30							
Strong to very strong dark grey LIMESTONE with interbanding layers of black calcareous mudstone, calcite veining present and fresh to slightly weathered				Fractures range from medium to closely spaced, 45degrees, undulating, rough to smooth, tight to open and clay coated	7	59	67	91	26.20
		27							
		28				73	90	93	27.60
		29		Fractures range from very close to closely spaced, sub-horizontal to 20degrees, planar, rough to smooth, tight to open and clay coated	18	17	55	76	28.60
Continued next sheet									

Remarks:

Rotary openhole borehole to 22.60mBGL then hole continued by rotary coring techniques.

KEY

TCR Total Core Recovery.
SCR Solid Core Recovery
RQD Rock Quality Designation
FSI Fracture Spacing Index



BOREHOLE RECORD (Rotary core)

Project Name: Swords Road

Hole ID: RC4

Client:

Consultant: DBFL

Location: Whitehall, Dublin

Start date: 14/04/2010

End date: 15/04/2010

Type of drilling: RC

Hole diameter: 63 mm


Co-ordinates: -

Elevation: -

Project no. 2442-02-10

Drilled by: T. Collins

Logged by: N. Sheehan

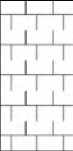Strata Description	Legend	Depth	Level mAOD	Discontinuities	FSI	RQD	SCR	TCR	CORE RUN
Strong to very strong dark grey LIMESTONE with interbanding layers of black calcareous mudstone, calcite veining present and fresh to slightly weathered				Fractures range from medium to closely spaced, sub-horizontal to 20degrees, planar, rough to smooth, tight to open	9	66	86	100	29.90
End of Borehole Log at 31.00 m		31.00	31						
			32						
			33						
			34						
			35						
			36						
			37						
			38						
			39						

Remarks:

Rotary openhole borehole to 22.60mBGL then hole continued by rotary coring techniques.

KEY

TCR
SCR
RQD
FSI

Total Core Recovery.
Solid Core Recovery
Rock Quality Designation
Fracture Spacing Index














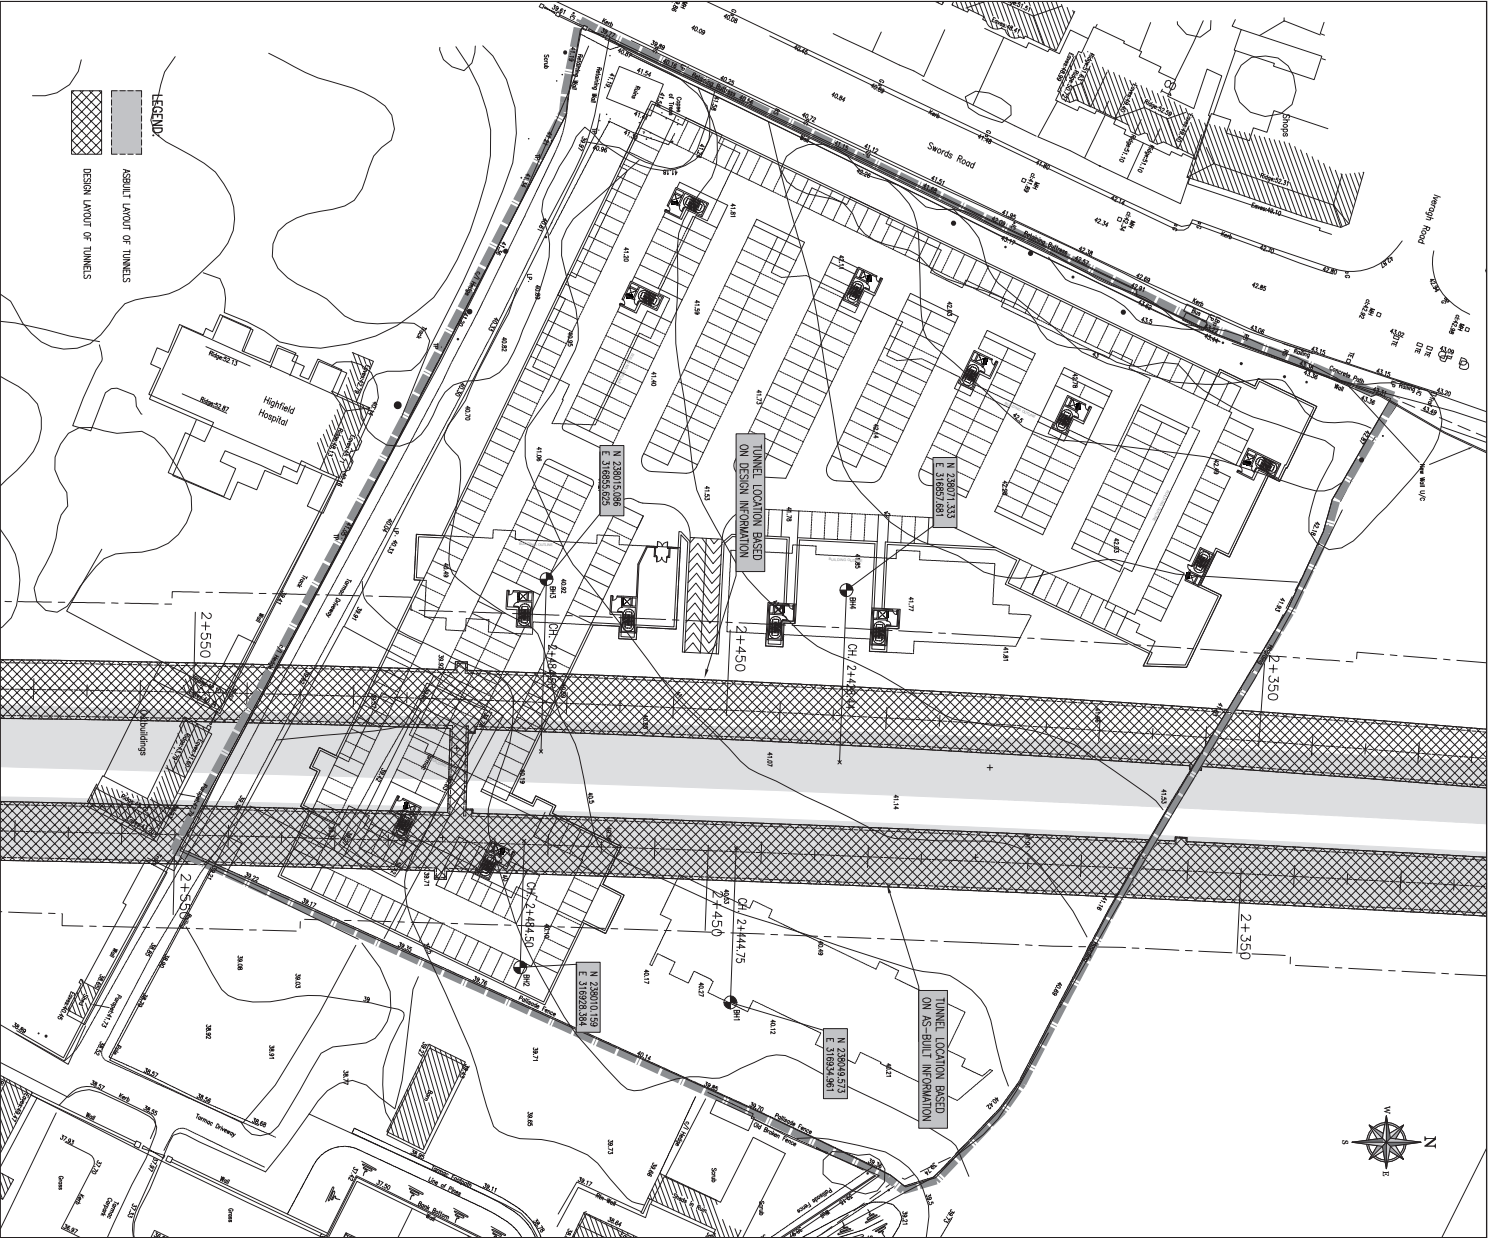

APPENDIX H

GII 2020 GROUND INVESTIGATION REPORT



GROUND INVESTIGATIONS IRELAND
Geotechnical & Environmental

Catherinestown House,
Hazelhatch Road,
Newcastle,
Co. Dublin.
D22 YD52

Tel: 01 601 5175 / 5176
Email: info@gii.ie
Web: www.gii.ie

Ground Investigations Ireland

Swords Road Whitehall Development

Eastwise Construction Ltd

Ground Investigation Report

August 2020





GROUND INVESTIGATIONS IRELAND
Geotechnical & Environmental

Catherinestown House,
Hazelhatch Road,
Newcastle,
Co. Dublin.
D22 YD52

Tel: 01 601 5175 / 5176
Email: info@gii.ie
Web: www.gii.ie

DOCUMENT CONTROL SHEET

Project Title	Swords Road Whitehall Development
Engineer	AECOM
Client	Eastwise Construction Ltd
Project No	9429-02-20
Document Title	Ground Investigation Report

Rev.	Status	Author(s)	Reviewed By	Approved By	Office of Origin	Issue Date
A	Draft	M Sutton	A McDonnell	F McNamara	Dublin	25 August 2020

Ground Investigations Ireland Ltd. present the results of the fieldworks and laboratory testing in accordance with the specification and related documents provided by or on behalf of the client. The possibility of variation in the ground and/or groundwater conditions between or below exploratory locations or due to the investigation techniques employed must be taken into account when this report and the appendices inform designs or decisions where such variation may be considered relevant. Ground and/or groundwater conditions may vary due to seasonal, man-made or other activities not apparent during the fieldworks and no responsibility can be taken for such variation. The data presented and the recommendations included in this report and associated appendices are intended for the use of the client and the client's geotechnical representative only and any duty of care to others is excluded unless approved in writing.



GROUND INVESTIGATIONS IRELAND
Geotechnical & Environmental

Catherinestown House,
Hazelhatch Road,
Newcastle,
Co. Dublin.
D22 YD52

Tel: 01 601 5175 / 5176
Email: info@gii.ie
Web: www.gii.ie

CONTENTS

1.0	Preamble.....	4
2.0	Overview.....	4
2.1.	Background.....	4
2.2.	Purpose and Scope	4
3.0	Subsurface Exploration	4
3.1.	General	4
3.2.	Trial Pits.....	5
3.3.	Soakaway Testing	5
3.4.	Cable Percussion Boreholes.....	5
3.5.	Rotary Boreholes.....	6
3.6.	Surveying	6
3.7.	Groundwater/Gas Monitoring Installations.....	6
3.8.	TRL Dynamic Cone Penetrometer	7
3.9.	Laboratory Testing	7
4.0	Ground Conditions.....	7
4.1.	General	7
4.2.	Groundwater	8
4.3.	Laboratory Testing	8
4.3.1.	Geotechnical Laboratory Testing	8
4.3.1.	Chemical Laboratory Testing.....	9
4.3.1.	Environmental Laboratory Testing	9
4.3.1.	Rock Laboratory Testing	9

APPENDICES

Appendix 1	Site Location Plan
Appendix 2	Trial Pit Records
Appendix 3	Soakaway Test Records
Appendix 4	TRL Dynamic Cone Penetrometer Records
Appendix 5	Borehole Records
Appendix 6	Laboratory Testing
Appendix 7	Groundwater Monitoring



www.gii.ie

1.0 Preamble

On the instructions of Aecom Consulting Engineers, a site investigation was carried out by Ground Investigations Ireland Ltd., between March and June 2020 at the site of the proposed residential development on Swords Road Whitehall, Dublin.

2.0 Overview

2.1. Background

It is proposed to construct a new residential development comprising seven multi story blocks of apartments and an eighth low level building housing a creche at the site including associated services, access roads and car parking. The site is currently brownfield with grass and low-level vegetation covering the majority of the site. The proposed construction is envisaged to consist of conventional or piled foundations and pavement make up with some local excavations for services and plant. A basement is proposed as part of the proposed scheme which will require excavation of approximately 4m BGL in parts of the site.

2.2. Purpose and Scope

The purpose of the site investigation was to investigate subsurface conditions utilising a variety of investigative methods in accordance with the project specification. The scope of the work undertaken for this project included the following:

- Visit project site to observe existing conditions
- Carry out 13 No. Trial Pits to a maximum depth of 4.5m BGL
- Carry out 3 No. Soakaways to determine a soil infiltration value to BRE digest 365
- Carry out 10 No. Cable Percussion boreholes to a maximum depth of 8m BGL
- Carry out 3 No. Rotary Geobore Follow on boreholes to a maximum depth of 37m BGL
- Installation of 3 No. Groundwater monitoring wells
- Geotechnical & Environmental Laboratory testing
- Factual Report

3.0 Subsurface Exploration

3.1. General

During the ground investigation a programme of intrusive investigation specified by the Consulting Engineer was undertaken to determine the sub surface conditions at the proposed site. Regular sampling and in-situ testing was undertaken in the exploratory holes to facilitate the geotechnical descriptions and to enable laboratory testing to be carried out on the soil samples recovered during excavation and drilling.

The procedures used in this site investigation are in accordance with Eurocode 7 Part 2: Ground Investigation and testing (ISEN 1997 – 2:2007) and B.S. 5930:2015.

3.2. Trial Pits

The trial pits were excavated using a 13T tracked excavator at the locations shown in the exploratory hole location plan in Appendix 1. The locations were checked using a CAT scan to minimise the potential for encountering services during the excavation. The trial pits were sampled, logged and photographed by a Geotechnical Engineer/Engineering Geologist prior to backfilling with arisings. Notes were made of any services, inclusions, pit stability, groundwater encountered and the characteristics of the strata encountered and are presented on the trial pit logs which are provided in Appendix 2 of this Report.

3.3. Soakaway Testing

The soakaway testing was carried out in selected trial pits at the locations shown in the exploratory hole location plan in Appendix 1. These pits were carefully excavated and filled with water to assess the infiltration characteristics of the proposed site. The pits were allowed to drain and the drop in water level was recorded over time as required by BRE Digest 365. The pits were logged prior to completing the soakaway test and were backfilled with arising's upon completion. The soakaway test results are provided in Appendix 3 of this Report.

3.4. Cable Percussion Boreholes

The Cable Percussion Boreholes were drilled using a Dando 2000 drilling rig with regular in-situ testing and sampling undertaken to facilitate the production of geotechnical logs and laboratory testing.

The standard method of boring in soil for site investigation is known as the Cable Percussion method. It consists of using a Shell in non cohesive soils and a clay cutter in cohesive soils, both operated on a wire cable. Very hard soils, boulders and other hard obstructions are broken up by chiselling and the fragments removed with the Shell. Where ground conditions made it necessary, the borehole was lined with 200mm diameter steel casing. While the use of the Cable Percussion method of boring gives the maximum data on soil conditions, some mixing of laminated soil is inevitable. For this reason, thin lenses of granular material may not be noticed. Disturbed samples were taken from the boring tools at suitable depths, so that there is a representative sample at the top of each change in stratum and thereafter at regular intervals down the borehole until the next stratum was encountered. The disturbed samples were then sealed and sent to the laboratory where they were visually examined to confirm the description of the relevant strata. Standard Penetration Tests were carried out in the boreholes. The results of these tests, together with the depths at which the tests were taken are shown on the accompanying borehole records. The test consists of a thick wall sampler tube, 50mm external diameter, being driven into the soil by a monkey weighing 63.5kg and with a free drop of 760mm. For gravels and glacial till the driving shoe was replaced by a solid 60° cone. The Standard Penetration Test number referred to as the 'N' value is the number of blows required to drive the tube 300mm, after an initial penetration of 150mm. The number gives a guide to the consistency of the soil and can also be used to estimate the relative strength/density at the depth of the test and also to estimate the bearing capacity and compressibility of the soil. The cable percussion borehole logs are provided in Appendix 5 of this Report.

3.5. Rotary Boreholes

The rotary coring was carried out by a track mounted Comacchio Geo 405 rig at the locations shown on the location plan in Appendix 1. The rotary boreholes were completed from the ground surface or alternatively, where noted on the individual borehole log, from the base of the cable percussion borehole where a temporary liner was installed to facilitate follow-on rotary coring.

The Comacchio Geo 405 is equipped with rubber tracks which allow for short travel on pavement surfaces avoiding any damage to the surface. The Comacchio Geo 405 utilises a triple tube core barrel system operated using a wireline drilling process. The outer barrel is rotated by the drill rods and at its lower end, carries the coring bit. The inner barrel is mounted on a swivel so that it does not rotate during the process. The third barrel or liner is placed within the second one to retain the core intact and to preserve as much as possible the fabric of the drilling stratum. The core is cut by the coring bit and passes to the inner liner. The core is brought up to the surface within the inner barrel on a small diameter wire rope or line attached to the “overshoot” recovery tool which is then placed into a core box in order of recovery. A drilling fluid, typically air mist or water flush is passed from the surface through hollow drill rods to the drill bit, and is used to cool the drill bit. Temporary casing is used in some situations to support unstable ground or to seal off fissures or voids.

It should be noted that the rotary coring can only achieve limited recovery in overburden, particularly granular or weakly cemented strata due to the flushing medium washing away the cohesive fraction during coring. The recovery achieved, where required is noted on the borehole logs and core photographs are provided to allow assessment of the core recovered. The rotary borehole logs are provided in Appendix 5 of this Report.

3.6. Surveying

The exploratory hole locations have been recorded using a KQ GEO Technologies KQ-M8 System which records the coordinates and elevation of the locations to ITM or Irish National Grid as required by the project specification. The coordinates and elevations are provided on the exploratory hole logs in the appendices of this Report.

3.7. Groundwater/Gas Monitoring Installations

Groundwater and or Gas Monitoring Installation were installed upon the completion of the boreholes to enable sampling and the determination of the equilibrium groundwater level. The typical groundwater monitoring installation consists of a 50mm HDPE slotted pipe with a pea gravel response zone and bentonite seal installed to the Engineers specification. Where required the standpipe is sealed with a gas tap and finished with a durable steel cover fixed in place with a concrete surround. The installation details are provided on the exploratory hole logs in the appendices of this Report.

3.8. TRL Dynamic Cone Penetrometer

The TRL DCP tests were carried out at locations specified by the Consulting Engineer to determine a CBR design value for the design of external pavements. The testing was carried out below the Topsoil or existing pavement at the depths detailed on the test report. The test consists of dropping a 10kg weight on an anvil to drive a small diameter cone and recording the blows for a given penetration. The results of the DCP testing is included in Appendix 4 of this Report.

3.9. Laboratory Testing

Samples were selected from the exploratory holes for a range of geotechnical and environmental testing to assist in the classification of soils and to provide information for the proposed design.

Environmental & Chemical testing as required by the specification, including the Rilta Suite pH and sulphate testing was carried out by Element Materials Technology Laboratory in the UK. The Rilta suite testing includes both Solid Waste and Leachate Waste Acceptance Criteria.

Geotechnical testing consisting of moisture content, Atterberg limits, Particle Size Distribution (PSD), hydrometer and California Bearing Ratio (CBR) tests were carried out in NMTL's Geotechnical Laboratory in Carlow. Specialist shear strength testing consisting of quick undrained, consolidated undrained triaxial, carried out on undisturbed U100 samples cut from Geobore core.

Rock strength testing including Point Load (Is_{50}) and Unconfined Compressive Strength (UCS) testing was carried out in Pro Soils Geotechnical Laboratory in the UK.

The results of the laboratory testing are included in Appendix 6 of this Report.

4.0 Ground Conditions

4.1. General

The ground conditions encountered during the investigation are summarised below with reference to insitu and laboratory test results. The full details of the strata encountered during the ground investigation are provided in the exploratory hole logs included in the appendices of this report.

The sequence of strata encountered were consistent across the site and are generally comprised;

- Topsoil/Surfacing
- Made Ground
- Cohesive Deposits
- Bedrock

TOPSOIL: Topsoil was encountered in the majority of exploratory holes and was present to a maximum depth of 0.65m BGL.

MADE GROUND: Made Ground deposits were encountered beneath the Topsoil/Surfacing and were present to a depth of between 0.2m and 1.5m BGL. These deposits were described generally as *brown sandy slightly gravelly Clay with occasional cobbles or grey sandy angular Gravel*. In some pits *occasional*

fragments of concrete, red brick, wood, ceramic, metal and cloth were noted. TP05, TP05A and TP05B encountered a concrete slab at depths of between 0.90m and 1.20m BGL where the trial were terminated.

COHESIVE DEPOSITS: Cohesive deposits were encountered beneath the Made Ground and were described typically as *brown sandy gravelly CLAY with occasional cobbles and boulders* overlying a *stiff black sandy gravelly CLAY with occasional cobbles and boulders*. A second sequence of brown overlying black CLAY was also encountered at depth in BH05 and BH09 that were drilled to prove rock level. The secondary sand and gravel constituents varied across the site and with depth, with granular lenses occasionally present in the glacial till matrix. The strength of the cohesive deposits typically increased with depth and was firm to stiff becoming stiff or very stiff in the majority of the exploratory holes. These deposits had some or occasional cobble and boulder content where noted on the exploratory hole logs.

BEDROCK: Boreholes BH05 and BH09 recovered Medium strong to very strong grey/dark grey fine to medium grained laminated LIMESTONE interbedded with weak black fine grained laminated Mudstone. This is typical of the Calp Formation, which is noted on the geological mapping to the east of the proposed site.

The depth to rock varies from 22.0m BGL in BH05 to a maximum of 32.3m BGL in BH09. The total core recovery is good, typically 100%. The SCR and RQD both vary with some areas recovered as non-intact.

4.2. Groundwater

Groundwater strikes are noted on the exploratory hole logs where they occurred and where possible drilling was suspended for twenty minutes to allow the subsequent rise in groundwater to be recorded. We would point out that these exploratory holes did not remain open for sufficiently long periods of time to establish the hydrogeological regime and groundwater levels would be expected to vary with the tide, time of year, rainfall, nearby construction and other factors. For this reason, standpipes were installed in BH01, BH06 and BH10 to allow the equilibrium groundwater level to be determined. The groundwater monitoring is included in Appendix 7 of this Report.

4.3. Laboratory Testing

4.3.1. Geotechnical Laboratory Testing

The geotechnical testing carried out on soil samples recovered generally confirm the descriptions on the logs with the primary constituent of the cohesive deposits found to be a CLAY of low to intermediate plasticity. The Particle Size Distribution tests confirm that generally the cohesive deposits are well-graded with percentages of sands and gravels ranging between 8.9% and 43.9% generally with fines contents of 26.6 to 57.1%.

The CBR testing on remoulded samples gave results ranging between 0.1% and 14.3% for the cohesive deposits.

The results from all the completed laboratory testing including MCV and triaxial testing is included in Appendix 6 of this report.

4.3.1. Chemical Laboratory Testing

The pH and sulphate testing carried out indicate that pH results are near neutral and that the water soluble sulphate results is low when compared to the guideline values from BRE Special Digest 1:2005. The samples tested classify the soil as a Design Sulphate Level DS-1.

4.3.1. Environmental Laboratory Testing

A number of samples were analysed for a suite of parameters which allows for the assessment of the sampled material in terms of total pollutant content for classification of materials as *hazardous* or *non-hazardous*. The suite also allows for the assessment of the sampled material in terms of suitability for placement at licenced landfills (inert, stable non-reactive, hazardous etc.). The parameter list for the suite includes analysis of the solid samples for arsenic, barium, cadmium, chromium, copper, cyanide, lead, nickel, mercury, zinc, speciated aliphatic and aromatic petroleum hydrocarbons, pH, sulphate, sulphide, moisture content, soil organic matter and an asbestos screen.

The suite also includes those parameters specified in the EU Council Decision establishing criteria for the acceptance of waste at Landfills (Council Decision 2003/33/EC), which for the solid samples are total organic carbon (TOC), speciated aliphatic and aromatic petroleum hydrocarbons, BTEX, phenol, polychlorinated biphenyls (PCB) and PAH.

As part of the suite a leachate is generated from the solid sample which is analysed for antimony, arsenic, barium, cadmium, chromium, copper, lead, mercury, molybdenum, nickel, selenium, zinc, chloride, fluoride, soluble sulphate, sulphide, phenols, dissolved organic carbon (DOC) and total dissolved solids (TDS).

While the laboratory report provides a comparison with the waste acceptance criteria limits it does not provide a waste classification of the material sampled nor does it comment on any potentially hazardous properties of the materials tested. The possibility for contamination, not revealed by the testing undertaken should be borne in mind particularly where Made Ground deposits are present or the previous site use or location indicate a risk of environmental variation. A waste classification report is recommended to be carried out to provide an interpretation of the laboratory data should any material be required to be disposed of off site.

4.3.1. Rock Laboratory Testing

The rock testing carried out on samples recovered from the boreholes reported Unconfined Compressive Strength (UCS) values ranging between 36.9 and 105.2 MPa while the point load testing gave I_{s50} values ranging between 0.25 to 6.10 MPa.

The results from the completed laboratory testing is included in Appendix 6 of this report.

APPENDIX 1 - Site Location Plan

716700E

716850E

738150N

738000N



- Borehole
- Trial Pit
- Indicative Site Boundary

Client:

AECOM

Project Code:

9429-02-20

Project Title:

Whitehall Swords Road
Extension

Drawing Title:

Investigation Location Plan

GROUND INVESTIGATIONS IRELAND
Geotechnical & EnvironmentalGround Investigations Ireland Ltd.
Catherinstown House,
Hazelhatch Road,
Newcastle, Co. Dublin
www.gii.ie 01-6015175/5176

0 10 20 30 40 50 m

Drawn By:
MSDate:
10/08/2020

716700E

716850E

APPENDIX 2 – Trial Pit Records





Site	Swords Road, Whitehall
-------------	------------------------

**Trial Pit
Number**
TP01

Method : Trial Pit

Dimensions
5.20 X 1.20 X 4.50

Ground Level (mOD)	42.39
--------------------	-------

Client	Eastwise
---------------	----------












Job Number	9429-02-20
------------	------------

Location
716756 1 E 738158 8 N

Dates	05/03/2020
--------------	------------

Project Contractor	GII
---------------------------	-----

Sheet
1/2

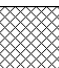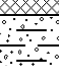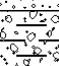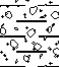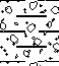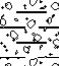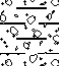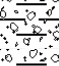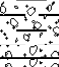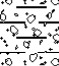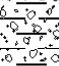Depth (m)	Sample / Tests	Water Depth (m)	Field Records	Level (mOD)	Depth (m) (Thickness)	Description	Legend	Water
0.70	B				(0.25)	MADE GROUND: Grey slightly sandy angular to sub-angular fine to coarse Gravel.		
0.70	T			42.14	0.25 (0.20)	Soft brown slightly sandy slightly gravelly CLAY.		
				41.94	0.45	Firm to stiff grey mottled brown slightly sandy gravelly CLAY with occasional sub-angular to sub-rounded cobbles. Gravel is sub-angular to sub-rounded fine to coarse.		
1.00	SV 115kPa		101,90,70/Av. 87.00		(1.45)			
1.60	B							
1.60	T							
				40.49	1.90 (0.50)	Stiff dark grey slightly sandy gravelly CLAY with occasional sub-rounded cobbles. Gravel is sub-angular to sub-rounded fine to coarse.		
2.40	B			39.99	2.40	Very stiff dark grey slightly sandy gravelly CLAY with occasional sub-angular to sub-rounded cobbles. Gravel is sub-angular to sub-rounded fine to coarse.		
2.40	T							
					(2.10)			
4.00	B							

Plan

Remarks

Trial pit complete at 4.50m BGL
No Groundwater encountered during excavation.
Trial pit stable.
Trial pit backfilled on completion.

Scale (approx)

1:25

Logged By

Tmcl

Figure No.

9429-02-20.TP01



Site	Swords Road, Whitehall
-------------	------------------------

**Trial Pit
Number
TP01**

Machine : 13.5T Excavator
Method : Trial Pit

Dimensions
5.20 X 1.20 X 4.50

Ground Level (mOD)	42.39
--------------------	-------

Client	Eastwise
---------------	----------


Job Number	9429-02-20
------------	------------

Location
716756.1 E 738158.8 N

Dates	05/03/2020
--------------	------------

Project Contractor
GII

Sheet
2/2

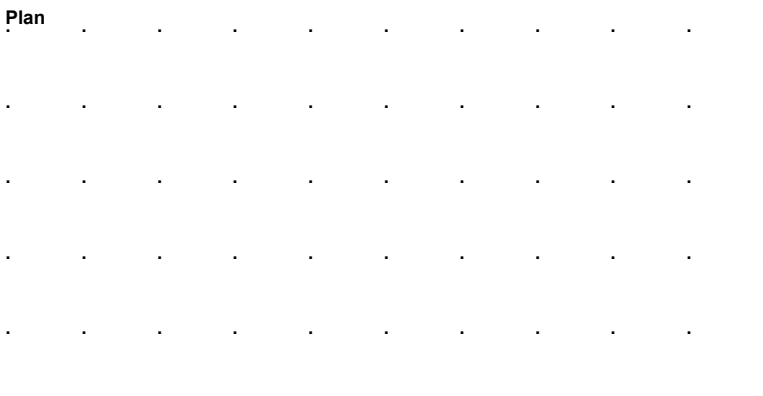Plan 	Remarks		
Scale (approx) 1:25		Logged By Tmcl	Figure No. 9429-02-20.TP0



Ground Investigations Ireland Ltd

www.gii.ie

Site Swords Road, Whitehall		Trial Pit Number TP02
Machine : 13.5T Excavator Method : Trial Pit		Job Number 9429-02-20
Dimensions 4.60 X 1.20 X 3.20		Sheet 1/1
Location 716730.1 E 738109.8 N		Project Contractor GII
Ground Level (mOD) 42.38		Dates 05/03/2020

Depth (m)	Sample / Tests	Water Depth (m)	Field Records	Level (mOD)	Depth (m) (Thickness)	Description	Legend	Water
0.50 0.50	B T			42.08	(0.30) 0.30	Brown slightly sandy slightly gravelly TOPSOIL with rootlets.		
1.00	SV 101kPa				(1.80)	Firm grey mottled brown slightly sandy gravelly CLAY with occasional sub-angular to sub-rounded cobbles. Gravel is sub-angular to sub-rounded fine to coarse.		
1.50 1.50	B T			40.28	2.10	Stiff dark grey slightly sandy gravelly CLAY with occasional sub-rounded cobbles. Gravel is sub-angular to sub-rounded fine to coarse.		
2.70 2.70	B T			39.18	3.20	Complete at 3.20m		

Plan					Remarks		
.	Trial pit complete at 3.2m BGL. No Groundwater encountered during excavation. Trial pit stable. Trial pit backfilled on completion.		
.			
.			
.			
.			
					Scale (approx)	Logged By	Figure No.
					1:25	Tmcl	9429-02-20.TP02



Swords Road, Whitehall

**Trial Pit
Number**
TP03

Method : Trial Pit

Dimensions
4.60 X 1.20 X 3.20

40.79

Eastwise












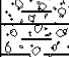
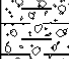
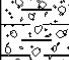
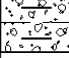



Job Number	9429-02-2
------------	-----------

716721 6 F 738061 4 N

05/03/2020

GII

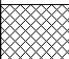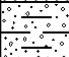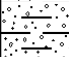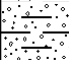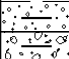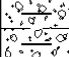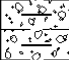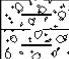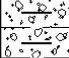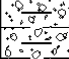Sheet
1/1

Depth (m)	Sample / Tests	Water Depth (m)	Field Records	Level (mOD)	Depth (m) (Thickness)	Description	Legend
0.50 0.50	B T		76,77,77/Av. 76.67	40.59	(0.20)	MADE GROUND: Grey sandy angular to sub-angular fine to coarse Gravel.	
					0.20	Soft brown slightly sandy slightly gravelly CLAY. Gravel is sub-angular to sub-rounded fine to coarse.	
1.00	SV 101kPa			39.89	(0.70)		
							
							
1.80 1.80	B T			0.90		Firm grey mottled brown slightly sandy gravelly CLAY with occasional sub-angular to sub-rounded cobbles. Gravel is sub-angular to sub-rounded fine to coarse.	
							
							
							
2.70 2.70	B T			(1.40)			
							
							
							
		38.49	2.30		Stiff dark grey slightly sandy gravelly CLAY with occasional sub-angular to sub-rounded cobbles. Gravel is sub-angular to sub-rounded fine to coarse.		
							
							
		(0.70)					
		37.79	3.00	Complete at 3.00m			

Trial pit complete at 3.0m BGL.
No Groundwater encountered during excavation.
Trial pit stable.
Trial pit backfilled on completion.

1:25

Tmcl

9429-02-20.TP03



Site	Swords Road, Whitehall
-------------	------------------------

**Trial Pit
Number**
TP04

Machine : 13.5T Excavator
Method : Trial Pit

Dimensions
4.30 X 1.20 X 3.00

Ground Level (mOD)	41.77
--------------------	-------

Client	Eastwise
---------------	----------


Job Number	9429-02-20
------------	------------

Location	716800.4 E 738132.1 N
-----------------	-----------------------

Dates	05/03/2020
--------------	------------

Project Contractor
GII

Sheet
1/1
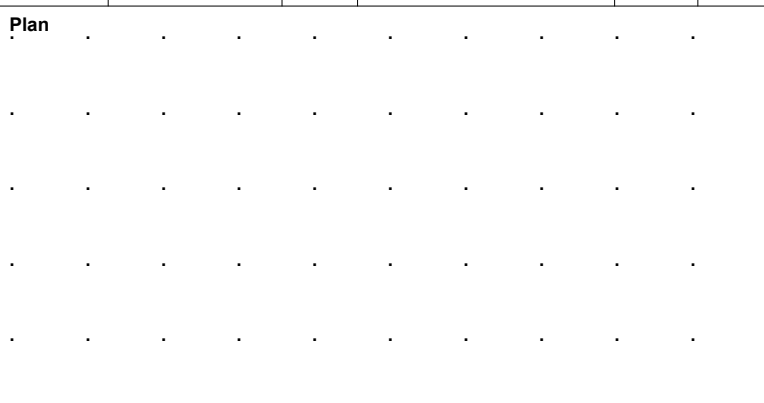
<div><div>Plan</div></div>	<div>Remarks</div> <div>Trial pit complete at 3.0m BGL. No Groundwater encountered during excavation. Trial pit stable. Trial pit backfilled on completion.</div>		
	<div>Scale (approx)</div> <div>1:25</div>	<div>Logged By</div> <div>Tmcl</div>	<div>Figure No.</div> <div>9429-02-20.TP0</div>



Swords Road, Whitehall

**Trial Pit
Number
TP05**

Method : Trial Pit

Dimensions
2.40 X 1.20 X 1.20

40.29

Eastwise

Job Number
9429-02-20

716864.2 E 738100.3 N

05/03/2020

GII

1/1

[illegible]



Ground Investigations Ireland Ltd

www.gii.ie

Site
Swords Road, Whitehall

Trial Pit Number
TP05A

Machine : 13.5T Excavator Method : Trial Pit	Dimensions 2.20 X 1.20 X 0.90	Ground Level (mOD) 39.94	Client Eastwise	Job Number 9429-02-20
	Location 716877.8 E 738099.1 N	Dates 06/03/2020	Project Contractor GII	Sheet 1/1

Depth (m)	Sample / Tests	Water Depth (m)	Field Records	Level (mOD)	Depth (m) (Thickness)	Description	Legend	Water
0.50 0.50	B T			39.54	0.40 (0.40)	Dark brown slightly sandy slightly gravelly TOPSOIL with rootlets.		
				39.04	0.90 (0.50)	MADE GROUND: Dark greyish brown slightly sandy gravelly CLAY with occasional fragments of metal and concrete.		
						Obstruction: CONCRETE.		
						Complete at 0.90m		

Plan .	Remarks Trial pit complete at 0.9m BGL. No Groundwater encountered during excavation. Trial pit sidewalls spalling. Trial pit backfilled on completion.		
	Scale (approx) 1:25	Logged By Tmcl	Figure No. 9429-02-20.TP05A



Ground Investigations Ireland Ltd

www.gii.ie

Site
Swords Road, Whitehall

Trial Pit Number
TP05B

Machine : 13.5T Excavator Method : Trial Pit	Dimensions 2.20 X 1.20 X 0.90	Ground Level (mOD) 39.93	Client Eastwise	Job Number 9429-02-20
	Location 716880.3 E 738107.7 N	Dates 06/03/2020	Project Contractor GII	Sheet 1/1

Depth (m)	Sample / Tests	Water Depth (m)	Field Records	Level (mOD)	Depth (m) (Thickness)	Description	Legend	Water
0.50 0.50	B T			39.63	(0.30) 0.30	Dark brown slightly sandy slightly gravelly TOPSOIL with rootlets.		
					(0.60)	MADE GROUND: Dark greyish brown slightly sandy gravelly CLAY with occasional fragments of plastic and ceramic.		
				39.03	0.90	Obstruction: CONCRETE. Complete at 0.90m		

Plan .	Remarks Trial pit complete at 0.9m BGL. No Groundwater encountered during excavation. Trial pit stable. Trial pit backfilled on completion.		
	Scale (approx) 1:25	Logged By Tmcl	Figure No. 9429-02-20.TP05A



Ground Investigations Ireland Ltd

www.gii.ie

Site
Swords Road, Whitehall

Trial Pit Number
TP05C

Machine : 13.5T Excavator Method : Trial Pit	Dimensions 3.70 X 1.20 X 3.00	Ground Level (mOD) 40.41	Client Eastwise	Job Number 9429-02-20
	Location 716853.3 E 738107.1 N	Dates 06/03/2020	Project Contractor GII	Sheet 1/1

Depth (m)	Sample / Tests	Water Depth (m)	Field Records	Level (mOD)	Depth (m) (Thickness)	Description	Legend	Water
0.90 0.90	B T			40.16	(0.25)	Brown slightly sandy slightly gravelly TOPSOIL with rootlets.		
					0.25 (0.30)	MADE GROUND: Dark grey slightly sandy gravelly Clay with occasional fragments of red brick.		
					39.86 0.55 (0.35)	MADE GROUND: Greyish brown slightly sandy slightly gravelly Clay with occasional fragments of clay pipe.		
2.00 2.00	B T			39.51	0.90 (1.20)	Firm grey mottled brown slightly sandy gravelly CLAY with occasional sub-angular to sub-rounded cobbles. Gravel is sub-angular to sub-rounded fine to coarse.		
					38.31 2.10 (0.90)	Stiff dark grey slightly sandy gravelly CLAY with occasional sub-angular to sub-rounded cobbles. Gravel is sub-angular to sub-rounded fine to coarse.		
2.90 2.90	B T			37.41	3.00	Complete at 3.00m		

Plan .	Remarks Trial pit complete at 3.0m BGL. No Groundwater encountered during excavation. Trial pit stable. Trial pit backfilled on completion.		
	Scale (approx) 1:25	Logged By Tmcl	Figure No. 9429-02-20.TP05C



**Trial Pit
Number**
TP06

Job Number	9429-02-20
------------	------------

Sheet
1/2

Remarks

9429-02-20.TP06



Site	Swords Road, Whitehall
-------------	------------------------

**Trial Pit
Number
TP06**

Machine : 13.5T Excavator
Method : Trial Pit

Dimensions
6.00 X 1.20 X 4.30

Ground Level (mOD)	41.57
--------------------	-------

Client	Eastwise
---------------	----------


Job Number	9429-02-20
------------	------------

Location	716798.2 E 738099.6 N
-----------------	-----------------------

Dates	05/03/2020
--------------	------------

Project Contractor
GII

Sheet
2/2

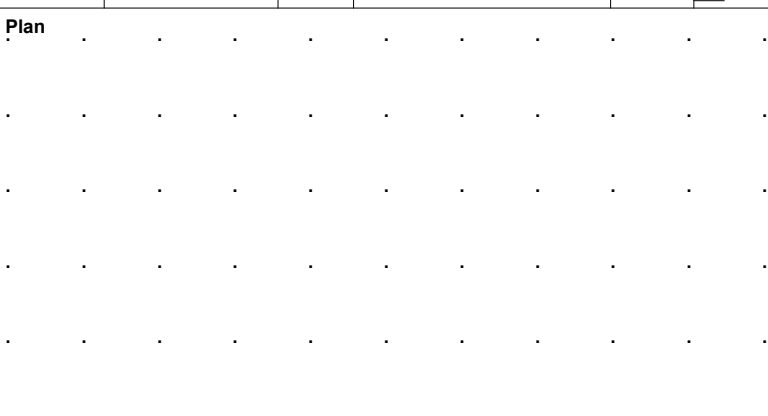Plan 	Remarks		
	Scale (approx) 1:25	Logged By Tmcl	Figure No. 9429-02-20.TP06



Swords Road, Whitehall

**Trial Pit
Number**
TP07

Method : Trial Pit

Dimensions
4.40 X 1.20 X 3.40

40.64

Eastwise

Job Number	9429-02-2
------------	-----------

716790 F 738033 8 N

05/03/2020

GII

Sheet
1/1

 ∇_1

Remarks

Trial pit complete at 3.40m BGL.
Groundwater encountered - Slight Seepage at 2.80m BGL.
Trial pit collapsed from 1.60m to 2.90m BGL.
Trial pit backfilled on completion.

Scale (approx)

1:25

Logged By

Tmcl

Figure No.

9429-02-20.TP07



Swords Road, Whitehall

**Trial Pit
Number
TP08**

Method : Trial Pit

Dimensions
4.20 X 1.20 X 3.20

39.78

Eastwise

Number

9429-02-20

716841.8 E 738022.4 N

05/03/2020

GII

1/1

1/1

Depth (m)	Sample / Tests	Water Depth (m)	Field Records	Level (mOD)	Depth (m) (Thickness)	Description	Legend	Water
0.70 0.70	B T					Dark brown slightly sandy slightly gravelly TOPSOIL with rootlets.		
				39.13	0.65	Firm grey mottled brown slightly sandy gravelly CLAY with sub-angular to sub-rounded cobbles. Gravel is sub-angular to sub-rounded fine to coarse.		
1.00	SV 86kPa		60,70,65/Av. 65.00					
1.50 1.50	B T				(1.85)			
				37.28	2.50	Stiff dark grey slightly sandy gravelly CLAY with occasional sub-angular cobbles. Gravel is sub-angular to sub-rounded fine to coarse.		
2.80 2.80	B T				(0.70)			
				36.58	3.20	Complete at 3.20m		

Trial pit complete at 3.20m BGL.
No Groundwater encountered during excavation.
Trial pit stable.
Trial pit backfilled on completion.
Soakaway completed adjacent to Trial pit.

1:25

Tmcl

9429-02-20.TP08



Swords Road, Whitehall

**Trial Pit
Number**
TP09

Method : Trial Pit

Dimensions
4.30 X 1.20 X 3.20

40.37

Eastwise

Job Number	9429-02-20
------------	------------

716762.6 E 738021 N

05/03/2020

GII

Sheet
1/1

Depth (m)	Sample / Tests	Water Depth (m)	Field Records	Level (mOD)	Depth (m) (Thickness)	Description	Legend	Water
0.60	B					Brown slightly sandy slightly gravelly TOPSOIL with rootlets.		
0.60	T			39.97	0.40 (0.40)	MADE GROUND: Greyish brown slightly sandy slightly gravelly CLAY with rare fragments of red brick.		
1.00	SV 82kPa		65,60,62/Av. 62.33	39.67	0.70	Firm grey mottled brown slightly sandy gravelly CLAY with occasional sub-angular to sub-rounded cobbles. Gravel is sub-angular to sub-rounded fine to coarse.		
1.90	B							
1.90	T							
2.80	B			37.77	2.60	Stiff dark grey slightly sandy gravelly CLAY with occasional sub-angular to sub-rounded cobbles. Gravel is sub-angular to sub-rounded fine to coarse.		
2.80	T				(0.60)			
				37.17	3.20	Complete at 3.20m		

Trial pit complete at 3.20m BGL.
No Groundwater encountered during excavation.
Trial pit stable.
Trial pit backfilled on completion.
Soakaway completed adjacent to Trial pit.

1:25

Tmcl

9429-02-20.TP09



Swords Road, Whitehall

**Trial Pit
Number**
TP10

Method : Trial Pit

Dimensions
4.50 X 1.20 X 3.00

40.69

Eastwise

 
Number

716848.7 E 738129.3 N

05/03/2020

GII

1/1

Plan 	Remarks Trial pit complete at 3.00m BGL. No Groundwater encountered during excavation. Trial pit collapsed below 0.60m BGL. Trial pit backfilled on completion.		
	Scale (approx) 1:25	Logged By Tmcl	Figure No. 9429-02-20.TP10

Swords Road, Whitehall – Trial Pit Photographs

TP01



TP01



TP02



TP02



TP03



TP03



TP04



TP04



TP05



TP05



TP05A



TP05A



TP05B



TP05B



TP05C



TP05C



TP06



TP06



TP07



TP07



TP08



TP08



TP09



TP09



TP10





APPENDIX 3 – Soakaway Test Records





Catherinestown House,
Hazelhatch Road,
Newcastle,
Co. Dublin.
D22 YD52

Tel: 01 601 5175 / 5176
Email: info@gii.ie
Web: www.gii.ie

TP06


Soakaway Test to BRE Digest 365

Trial Pit Dimensions: 2.3m x 0.60m x 0.9m (L x W x D)

Date	Time	Water level (m bgl)
06/03/2020	0	-0.240
06/03/2020	60	-0.260
06/03/2020	100	-0.260
06/03/2020	240	-0.260
06/03/2020	290	-0.260

***Soakaway failed - Pit backfilled**

Start depth	Depth of Pit	Diff	75% full	25%full
0.24	0.900	0.660	0.405	0.735

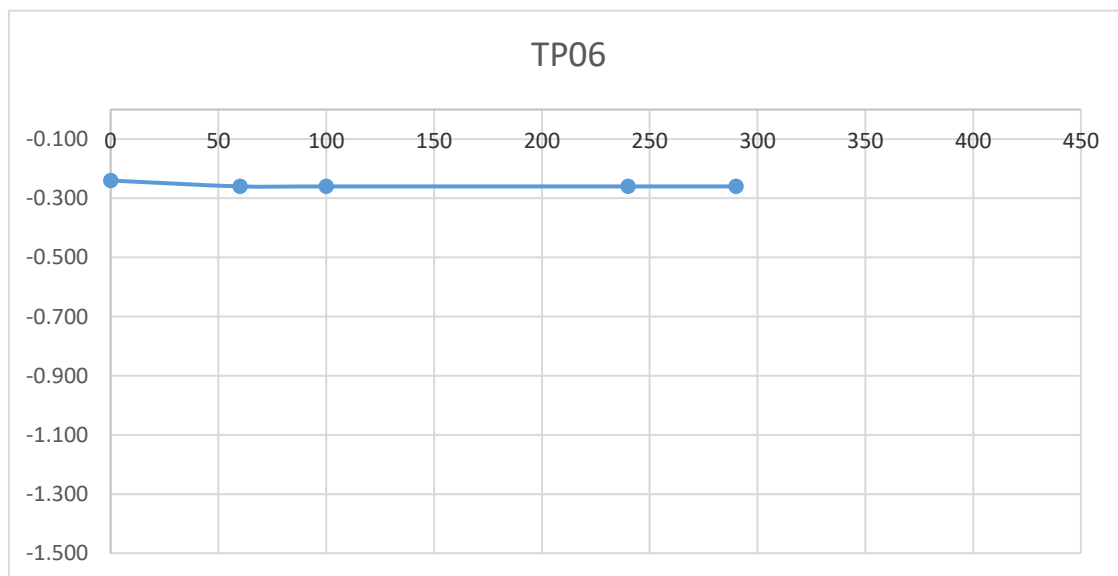



Catherinestown House,
Hazelhatch Road,
Newcastle,
Co. Dublin.
D22 YD52

Tel: 01 601 5175 / 5176
Email: info@gii.ie
Web: www.gii.ie

TP08


Soakaway Test to BRE Digest 365

Trial Pit Dimensions: 2.4m x 0.60m 1.5m (L x W x D)

Date	Time	Water level (m bgl)
06/03/2020	0	-0.460
06/03/2020	70	-0.470
06/03/2020	120	-0.470
06/03/2020	210	-0.470
06/03/2020	280	-0.470

***Soakaway failed - Pit backfilled**

Start depth	Depth of Pit	Diff	75% full	25%full
0.46	1.500	1.040	0.72	1.24

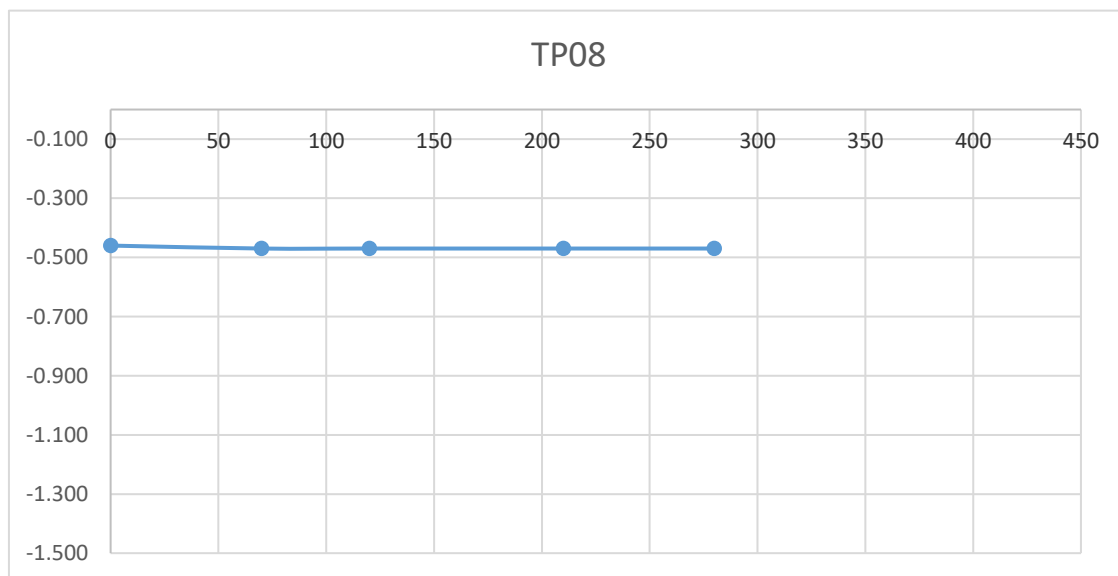



Catherinestown House,
Hazelhatch Road,
Newcastle,
Co. Dublin.
D22 YD52

Tel: 01 601 5175 / 5176
Email: info@gii.ie
Web: www.gii.ie

TP09


Soakaway Test to BRE Digest 365

Trial Pit Dimensions: 2.2m x 0.60m 1.5m (L x W x D)

Date	Time	Water level (m bgl)
06/03/2020	0	-0.300
06/03/2020	70	-0.300
06/03/2020	120	-0.300
06/03/2020	210	-0.300
06/03/2020	280	-0.300

***Soakaway failed - Pit backfilled**

Start depth	Depth of Pit	Diff	75% full	25%full
0.30	1.500	1.200	0.6	1.2

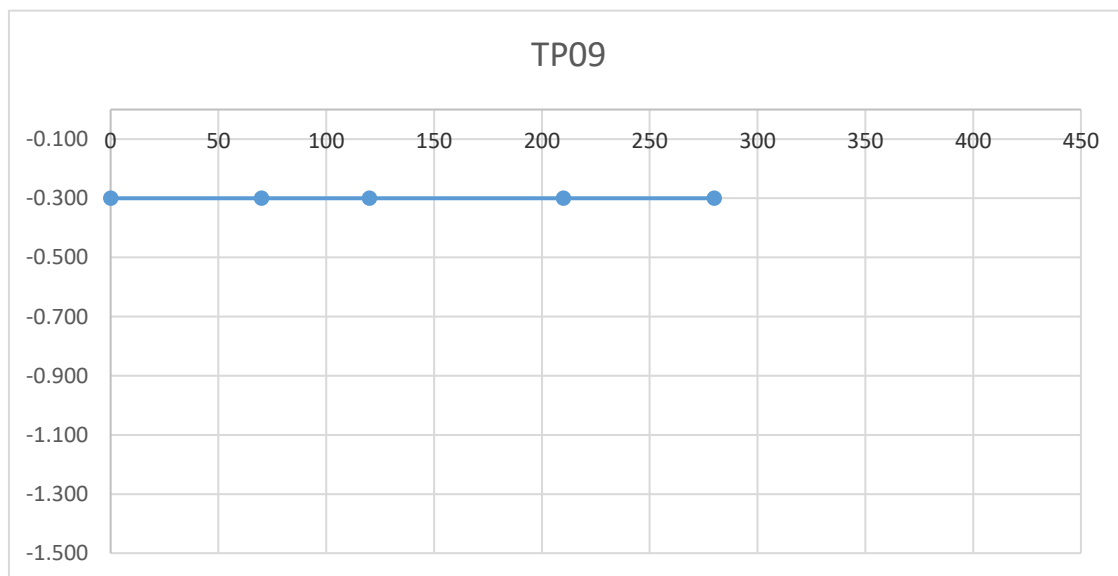

APPENDIX 4 – TRL Dynamic Cone Penetration Records





GROUND INVESTIGATIONS IRELAND
Geotechnical & Environmental


Catherinestown House,
Hazelhatch Road,
Newcastle,
Co. Dublin.
D22 YD52

Tel: 01 601 5175 / 5176
Email: info@gii.ie
Web: www.gii.ie

Job Name	Swords Road, Whitehall	Test Type	Dynamic Cone Penetration Test
Job No.	9429-02-20	Test Reference	TP02
Client	AECOM	By	T McIntyre
		Date	06/03/2020
Initial Depth	Ground level		

Depth (mm bgl)	No. of Blows per 100mm	Penetration per Blow (mm)	CBR (%)
0	-	-	0.0
100	1	100.0	1.2
200	1	100.0	1.2
300	2	50.0	2.9
400	3	33.3	4.8
500	2	50.0	2.9
600	3	33.3	4.8
700	4	25.0	7.0
800	4	25.0	7.0
900	7	14.3	14.2
1000	-		
1100	-		
1200	-		
1300	-		
1400	-		
1500	-		

Reference Kleyn and Van Heerden (60° Cone)
Formula $\text{Log}_{10}(\text{CBR}) = 2.632 - 1.28 \text{Log}_{10}(\text{mm/blow})$

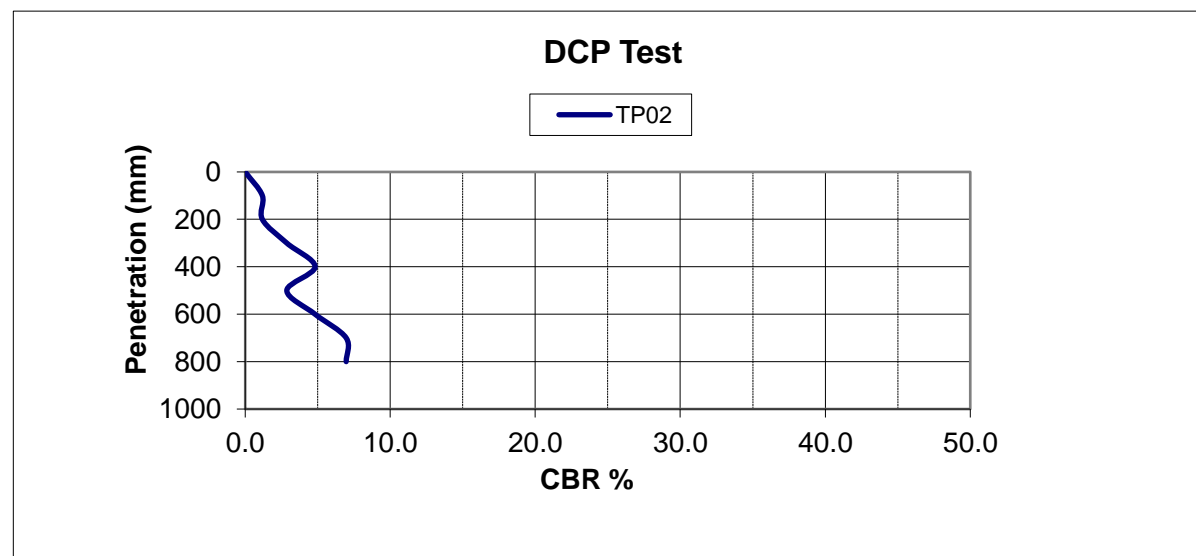



GROUND INVESTIGATIONS IRELAND
Geotechnical & Environmental


Catherinestown House,
Hazelhatch Road,
Newcastle,
Co. Dublin.
D22 YD52

Tel: 01 601 5175 / 5176
Email: info@gii.ie
Web: www.gii.ie

Job Name	Swords Road, Whitehall	Test Type	Dynamic Cone Penetration Test
Job No.	9429-02-20	Test Reference	TP03
Client	AECOM	By	T McIntyre
		Date	06/03/2020
Initial Depth	Ground level		

Depth (mm bgl)	No. of Blows per 100mm	Penetration per Blow (mm)	CBR (%)
0	-	-	0.0
100	2	50.0	2.9
200	8	12.5	16.9
300	7	14.3	14.2
400	4	25.0	7.0
500	5	20.0	9.3
600	4	25.0	7.0
700	4	25.0	7.0
800	4	25.0	7.0
900	6	16.7	11.7
1000	-		
1100	-		
1200	-		
1300	-		
1400	-		
1500	-		

Reference Kleyn and Van Heerden (60° Cone)
Formula $\text{Log}_{10}(\text{CBR}) = 2.632 - 1.28 \text{ Log}_{10}(\text{mm/blow})$

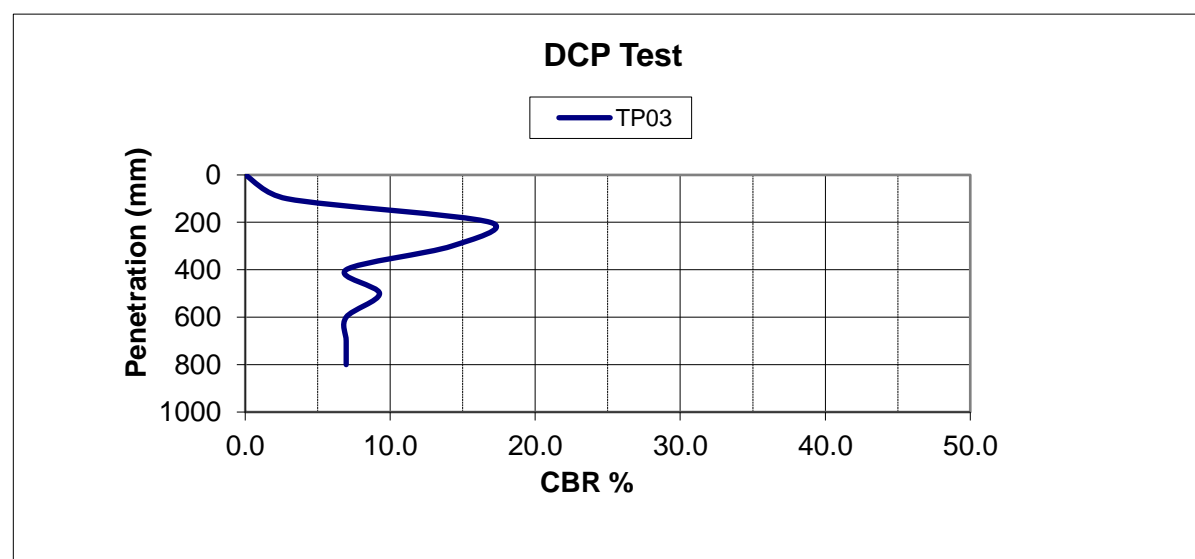



GROUND INVESTIGATIONS IRELAND
Geotechnical & Environmental


Catherinestown House,
Hazelhatch Road,
Newcastle,
Co. Dublin.
D22 YD52

Tel: 01 601 5175 / 5176
Email: info@gii.ie
Web: www.gii.ie

Job Name	Swords Road, Whitehall	Test Type	Dynamic Cone Penetration Test
Job No.	9429-02-20	Test Reference	TP04
Client	AECOM	By	T McIntyre
Initial Depth	Ground level	Date	06/03/2020

Depth (mm bgl)	No. of Blows per 100mm	Penetration per Blow (mm)	CBR (%)
0	-	-	0.0
100	1	100.0	1.2
200	0	200.0	0.5
300	6	16.7	11.7
400	6	16.7	11.7
500	17	5.9	44.4
600	17	5.9	44.4
700	25	4.0	72.7
800	-	-	-
900	-	-	-
1000	-	-	-
1100	-	-	-
1200	-	-	-
1300	-	-	-
1400	-	-	-
1500	-	-	-

Reference Kleyn and Van Heerden (60° Cone)
Formula $\text{Log}_{10}(\text{CBR}) = 2.632 - 1.28 \text{ Log}_{10}(\text{mm/blow})$

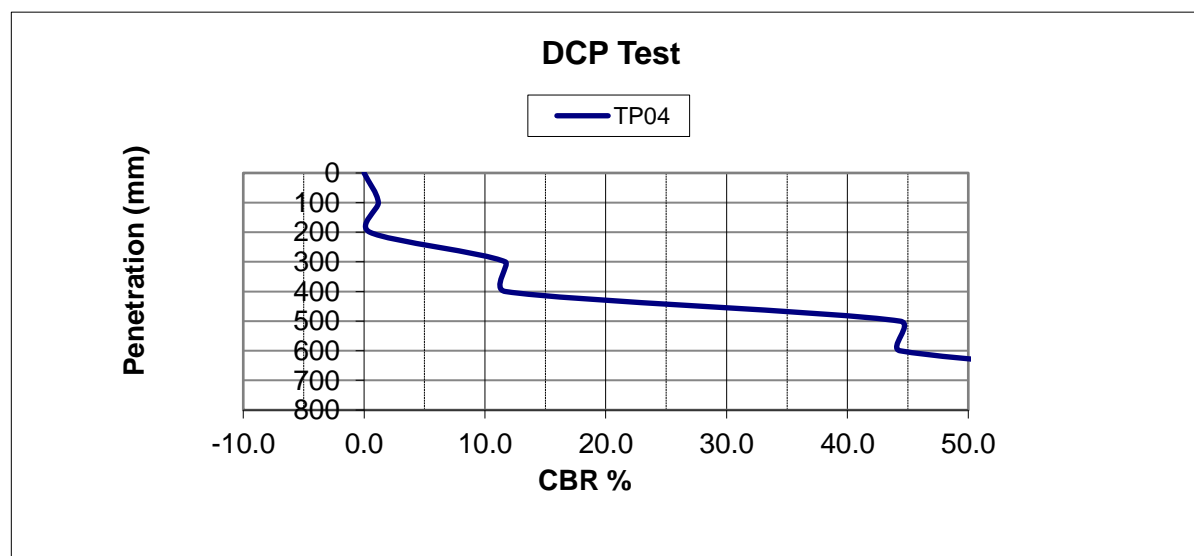



GROUND INVESTIGATIONS IRELAND
Geotechnical & Environmental


Catherinestown House,
Hazelhatch Road,
Newcastle,
Co. Dublin.
D22 YD52

Tel: 01 601 5175 / 5176
Email: info@gii.ie
Web: www.gii.ie

Job Name	Swords Road, Whitehall	Test Type	Dynamic Cone Penetration Test
Job No.	9429-02-20	Test Reference	TP05
Client	AECOM	By	T McIntyre
Initial Depth	Ground level	Date	06/03/2020

Depth (mm bgl)	No. of Blows per 100mm	Penetration per Blow (mm)	CBR (%)
0	-	-	0.0
100	1	100.0	1.2
200	2	50.0	2.9
300	3	33.3	4.8
400	4	25.0	7.0
500	3	33.3	4.8
600	4	25.0	7.0
700	4	25.0	7.0
800	4	25.0	7.0
900	15	6.7	37.8
1000	-		
1100	-		
1200	-		
1300	-		
1400	-		
1500	-		

Reference Kleyn and Van Heerden (60° Cone)
Formula $\text{Log}_{10}(\text{CBR}) = 2.632 - 1.28 \text{ Log}_{10}(\text{mm/blow})$

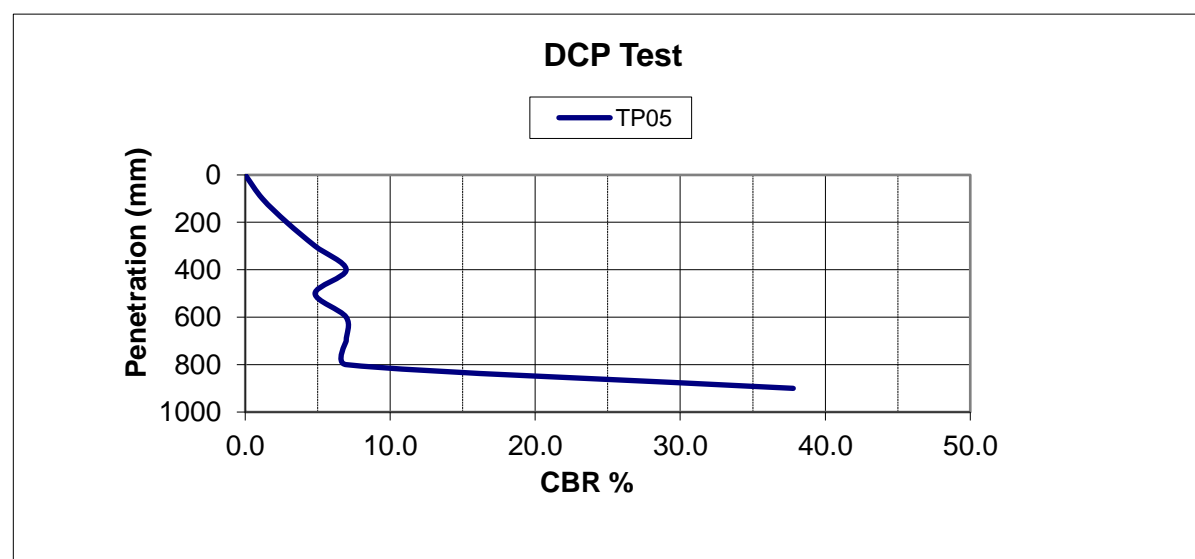



GROUND INVESTIGATIONS IRELAND
Geotechnical & Environmental


Catherinestown House,
Hazelhatch Road,
Newcastle,
Co. Dublin.
D22 YD52

Tel: 01 601 5175 / 5176
Email: info@gii.ie
Web: www.gii.ie

Job Name	Swords Road, Whitehall	Test Type	Dynamic Cone Penetration Test
Job No.	9429-02-20	Test Reference	TP06
Client	AECOM	By	T McIntyre
Initial Depth	Ground level	Date	06/03/2020

Depth (mm bgl)	No. of Blows per 100mm	Penetration per Blow (mm)	CBR (%)
0	-	-	0.0
100	1	100.0	1.2
200	2	50.0	2.9
300	5	20.0	9.3
400	4	25.0	7.0
500	6	16.7	11.7
600	23	4.3	65.3
700	23	4.3	65.3
800	23	4.3	65.3
900	8	12.5	16.9
1000	-		
1100	-		
1200	-		
1300	-		
1400	-		
1500	-		

Reference Kleyn and Van Heerden (60° Cone)
Formula $\text{Log}_{10}(\text{CBR}) = 2.632 - 1.28 \text{Log}_{10}(\text{mm/blow})$

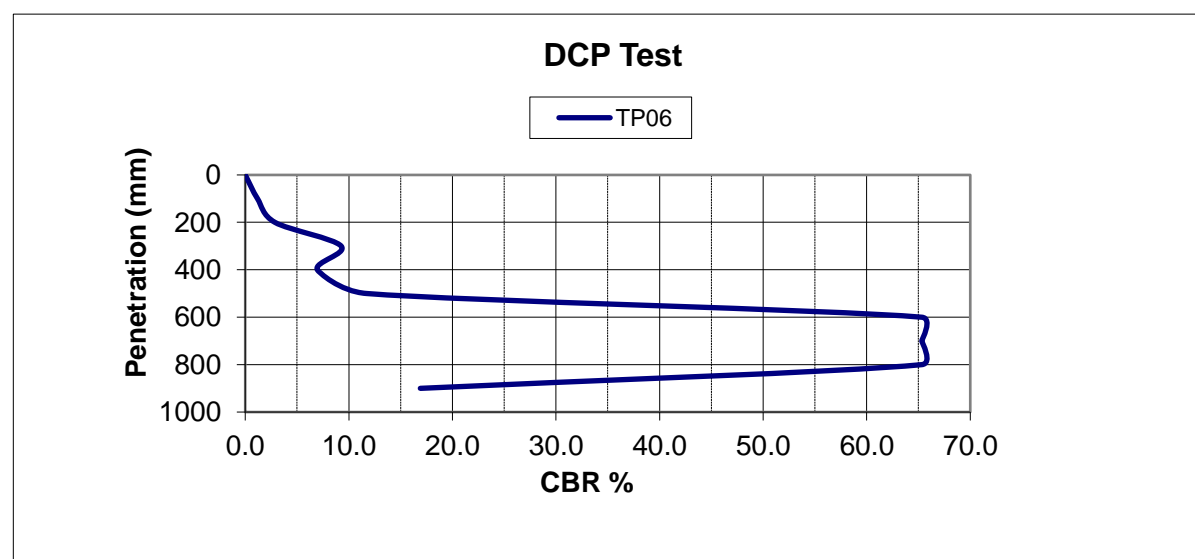



GROUND INVESTIGATIONS IRELAND
Geotechnical & Environmental


Catherinestown House,
Hazelhatch Road,
Newcastle,
Co. Dublin.
D22 YD52

Tel: 01 601 5175 / 5176
Email: info@gii.ie
Web: www.gii.ie

Job Name	Swords Road, Whitehall	Test Type	Dynamic Cone Penetration Test
Job No.	9429-02-20	Test Reference	TP07
Client	AECOM	By	T McIntyre
Initial Depth	Ground level	Date	06/03/2020

Depth (mm bgl)	No. of Blows per 100mm	Penetration per Blow (mm)	CBR (%)
0	-	-	0.0
100	1	100.0	1.2
200	0	200.0	0.5
300	3	33.3	4.8
400	2	50.0	2.9
500	2	50.0	2.9
600	2	50.0	2.9
700	2	50.0	2.9
800	1	100.0	1.2
900	2	50.0	2.9
1000	-		
1100	-		
1200	-		
1300	-		
1400	-		
1500	-		

Reference Kleyn and Van Heerden (60° Cone)
Formula $\text{Log}_{10}(\text{CBR}) = 2.632 - 1.28 \text{Log}_{10}(\text{mm/blow})$

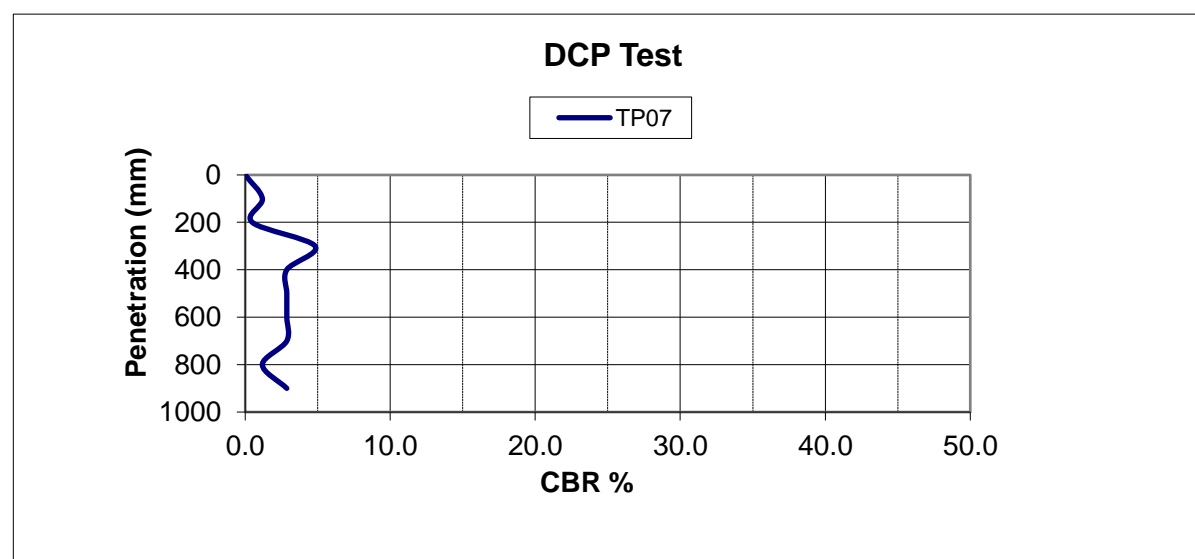



GROUND INVESTIGATIONS IRELAND
Geotechnical & Environmental


Catherinestown House,
Hazelhatch Road,
Newcastle,
Co. Dublin.
D22 YD52

Tel: 01 601 5175 / 5176
Email: info@gii.ie
Web: www.gii.ie

Job Name	Swords Road, Whitehall	Test Type	Dynamic Cone Penetration Test
Job No.	9429-02-20	Test Reference	TP08
Client	AECOM	By	T McIntyre
Initial Depth	Ground level	Date	06/03/2020

Depth (mm bgl)	No. of Blows per 100mm	Penetration per Blow (mm)	CBR (%)
0	-	-	0.0
100	1	100.0	1.2
200	1	100.0	1.2
300	2	50.0	2.9
400	3	33.3	4.8
500	3	33.3	4.8
600	3	33.3	4.8
700	3	33.3	4.8
800	4	25.0	7.0
900	4	25.0	7.0
1000	-		
1100	-		
1200	-		
1300	-		
1400	-		
1500	-		

Reference Kleyn and Van Heerden (60° Cone)
Formula $\text{Log}_{10}(\text{CBR}) = 2.632 - 1.28 \text{ Log}_{10}(\text{mm/blow})$

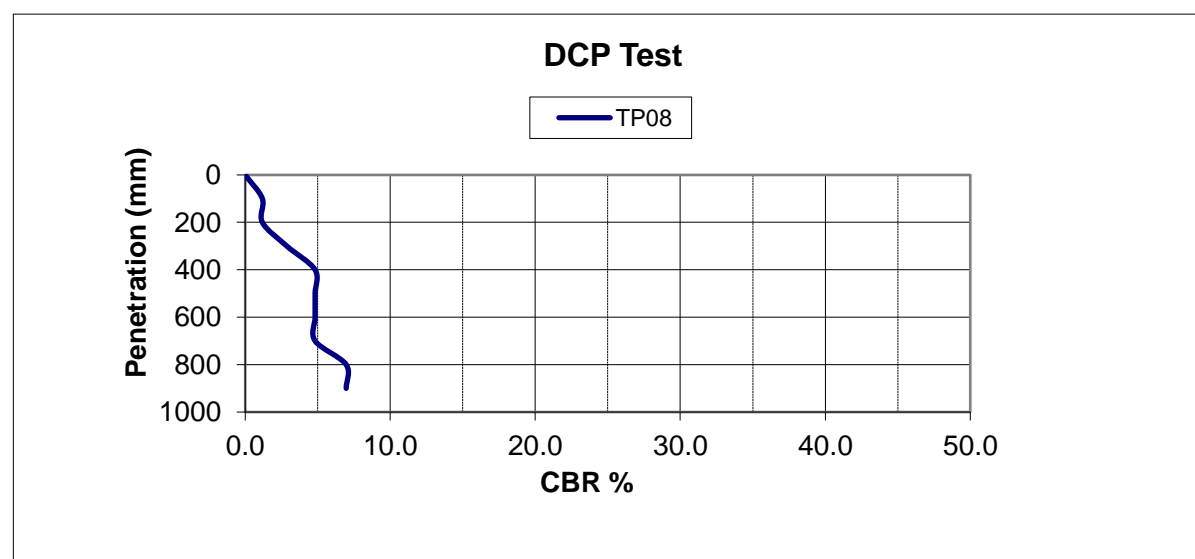



GROUND INVESTIGATIONS IRELAND
Geotechnical & Environmental


Catherinestown House,
Hazelhatch Road,
Newcastle,
Co. Dublin.
D22 YD52

Tel: 01 601 5175 / 5176
Email: info@gii.ie
Web: www.gii.ie

Job Name	Swords Road, Whitehall	Test Type	Dynamic Cone Penetration Test
Job No.	9429-02-20	Test Reference	TP09
Client	AECOM	By	T McIntyre
Initial Depth	Ground level	Date	06/03/2020

Depth (mm bgl)	No. of Blows per 100mm	Penetration per Blow (mm)	CBR (%)
0	-	-	0.0
100	1	100.0	1.2
200	2	50.0	2.9
300	3	33.3	4.8
400	3	33.3	4.8
500	3	33.3	4.8
600	3	33.3	4.8
700	6	16.7	11.7
800	6	16.7	11.7
900	6	16.7	11.7
1000	-		
1100	-		
1200	-		
1300	-		
1400	-		
1500	-		

Reference Kleyn and Van Heerden (60° Cone)
Formula $\text{Log}_{10}(\text{CBR}) = 2.632 - 1.28 \text{Log}_{10}(\text{mm/blow})$

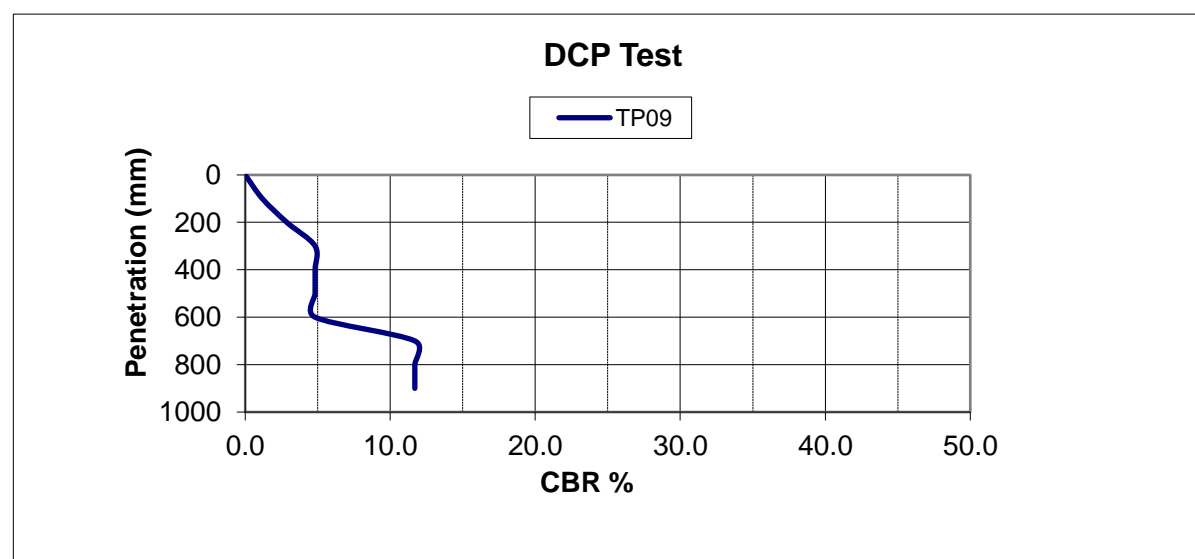



GROUND INVESTIGATIONS IRELAND
Geotechnical & Environmental


Catherinestown House,
Hazelhatch Road,
Newcastle,
Co. Dublin.
D22 YD52

Tel: 01 601 5175 / 5176
Email: info@gii.ie
Web: www.gii.ie

Job Name	Swords Road, Whitehall	Test Type	Dynamic Cone Penetration Test
Job No.	9429-02-20	Test Reference	TP10
Client	AECOM	By	T McIntyre
Initial Depth	Ground level	Date	06/03/2020

Depth (mm bgl)	No. of Blows per 100mm	Penetration per Blow (mm)	CBR (%)
0	-	-	0.0
100	1	100.0	1.2
200	4	25.0	7.0
300	4	25.0	7.0
400	9	11.1	19.7
500	14	7.1	34.6
600	24	4.2	69.0
700	-	-	-
800	-	-	-
900	-	-	-
1000	-	-	-
1100	-	-	-
1200	-	-	-
1300	-	-	-
1400	-	-	-
1500	-	-	-

Reference Kleyn and Van Heerden (60° Cone)
Formula $\text{Log}_{10}(\text{CBR}) = 2.632 - 1.28 \text{ Log}_{10}(\text{mm/blow})$

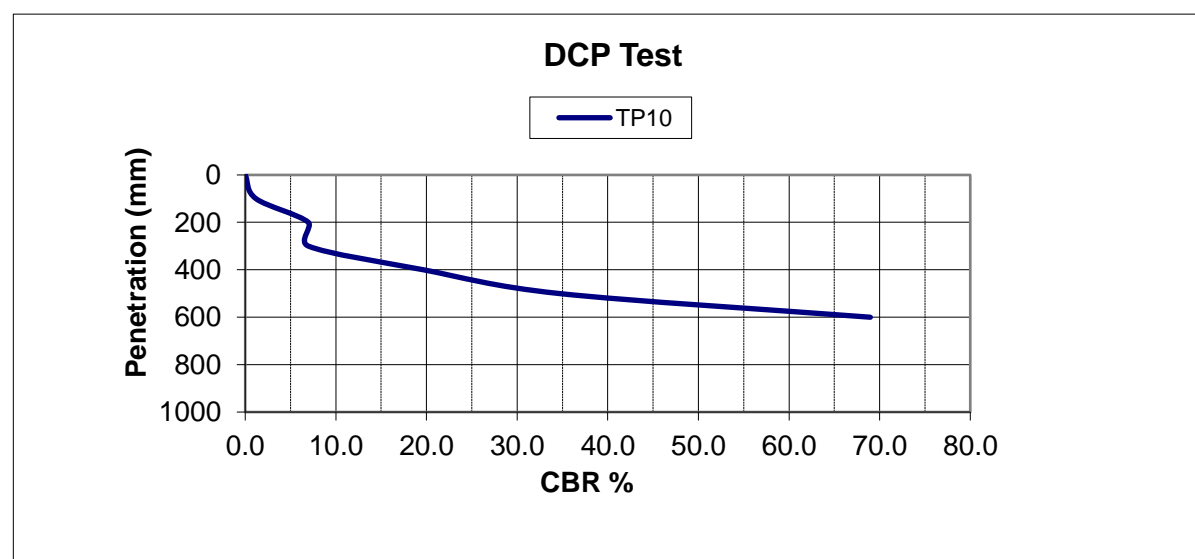

APPENDIX 5 - Borehole Records





Ground Investigations Ireland Ltd

www.gii.ie

Site Swords Road, Whitehall	Borehole Number BH01
Machine : Dando 2000 Method : Cable Percussion	Job Number 9429-02-20
Casing Diameter 200mm to 5.60m	Sheet 1/1
Ground Level (mOD) 42.29	Project Contractor GII
Location 716774.9 E 738180.3 N	Dates 24/06/2020

Depth (m)	Sample / Tests	Casing Depth (m)	Water Depth (m)	Field Records	Level (mOD)	Depth (m) (Thickness)	Description	Legend	Water	Instr
1.00-1.45 1.00	SPT(C) N=12 B			2,3/7,1,2,2	41.09	(1.20)	MADE GROUND: Dark grey slightly sandy slightly silty slightly gravelly CLAY with occasional subangular to subrounded cobbles of predominantly limestone, crushed brick and concrete fragments.			
2.00-2.45 2.00	SPT(C) N=15 B			3,4/4,4,3,4		(2.30)	Firm-stiff greyish brown slightly sandy slightly gravelly CLAY with occasional subangular to subrounded cobbles of limestone. Gravel is subangular to subrounded fine to coarse.			
3.00-3.45 3.00	SPT(C) N=11 B			2,3/3,2,3,3	38.79	3.50	Very stiff dark grey/ black slightly sandy slightly gravelly CLAY with occasional subangular to subrounded cobbles and boulders of predominantly limestone. Gravel is subangular to subrounded fine to coarse.		▼1	
4.00-4.45 4.00	SPT(C) N=31 B			5,6/7,7,10,7		(2.10)				
5.00-5.45 5.00	SPT(C) N=43 B			8,9/11,9,11,12	36.69	5.60	Refusal at 5.60m			

Remarks

Groundwater encountered at 3.50m BGL.
Refusal at 5.60m BGL; obstruction possible hard strata or boulder.
Slotted pipe installed from 5.60m BGL to 1.50m BGL with pea gravel filter zone from 5.60m BGL to 1.00m BGL and bentonite seal and from 1.00m BGL to GL, finished with an upright cover.
Chiselling from 5.60m to 5.60m for 1 hour.

Scale (approx)
1:50

Logged By
C. Byrne

Figure No.
9429-02-20.BH01



Ground Investigations Ireland Ltd

www.gii.ie

Site
Swords Road, Whitehall

Borehole Number
BH02

Machine : Dando 2000 Method : Cable Percussion	Casing Diameter 200mm to 7.80m	Ground Level (mOD) 42.71	Client Eastwise	Job Number 9429-02-20
	Location 716740.1 E 738129.8 N	Dates 16/06/2020	Project Contractor GII	Sheet 1/1

Depth (m)	Sample / Tests	Casing Depth (m)	Water Depth (m)	Field Records	Level (mOD)	Depth (m) (Thickness)	Description	Legend	Water
1.00-1.45 1.00	SPT(C) N=20 B			2,4/4,5,6,5	41.41	(1.30) 1.30	Stiff brown slightly silty slightly sandy slightly gravelly CLAY with occasional subangular to subrounded cobbles of predominantly limestone. Gravel is subangular to subrounded fine to coarse.		
2.00-2.45 2.00	SPT(C) N=36 B			2,5/7,8,9,12	40.51	(0.90) 2.20	Very stiff greyish brown slightly sandy slightly gravelly CLAY with occasional subangular to subrounded cobbles of limestone. Gravel is subangular to subrounded fine to coarse.		
3.00-3.45 3.00	SPT(C) N=42 B			3,7/9,9,12,12			Very stiff dark grey/ black slightly sandy slightly gravelly CLAY with occasional subangular to subrounded cobbles and boulders of predominantly limestone. Gravel is subangular to subrounded fine to coarse.		
4.00-4.45 4.00	SPT(C) N=50 B			7,7/12,13,13,12					
5.00-5.34 5.00	SPT(C) 50/190 B			10,11/17,18,15		(5.60)			
6.00-6.07 6.00	SPT(C) 25*/70 50/0 B			25/50					
7.00-7.05 7.00	SPT(C) 25*/50 50/0 B			25/50	34.91	7.80	Refusal at 7.80m		

Remarks No groundwater encountered during drilling. Refusal at 7.80m BGL; obstruction possible hard strata or boulder. Borehole backfilled upon completion. Chiselling from 7.80m to 7.80m for 1 hour.	Scale (approx) 1:50	Logged By C. Byrne
	Figure No. 9429-02-20.BH02	



Ground Investigations Ireland Ltd

www.gii.ie

Site
Swords Road, Whitehall

Borehole Number
BH03

Machine : Dando 2000	Casing Diameter 200mm to 7.40m	Ground Level (mOD) 42.02	Client Eastwise	Job Number 9429-02-20
Method : Cable Percussion	Location 716780.9 E 738118.9 N	Dates 17/06/2020	Project Contractor GII	Sheet 1/1

Depth (m)	Sample / Tests	Casing Depth (m)	Water Depth (m)	Field Records	Level (mOD)	Depth (m) (Thickness)	Description	Legend	Water
1.00-1.45 1.00	SPT(C) N=12 B			1,2/2,3,3,4	41.22	(0.80) 0.80	MADE GROUND: Brown slightly sandy slightly gravelly Clay with broken brick fragments. Gravel is subangular to subrounded fine to coarse.		
2.00-2.45 2.00	SPT(C) N=31 B			4,7/7,7,8,9	39.72	(1.50) 2.30	Firm-stiff greyish brown slightly sandy slightly gravelly CLAY with occasional subangular to subrounded cobbles of limestone. Gravel is subangular to subrounded fine to coarse.		
3.00-3.45 3.00	SPT(C) N=41 B			4,10/11,10,10,10			Very stiff dark grey/ black slightly sandy slightly gravelly CLAY with occasional subangular to subrounded cobbles and boulders of predominantly limestone. Gravel is subangular to subrounded fine to coarse.		
4.00-4.45 4.00	SPT(C) N=44 B			8,9/9,9,15,11					
5.00-5.34 5.00	SPT(C) 50/190 B			7,14/15,21,14		(5.10)			
6.00-6.21 6.00	SPT(C) 50/60 B			16,23/50					
7.00-7.07 7.00	SPT(C) 25*/70 50/0 B			25/50	34.62	7.40	Refusal at 7.40m		

Remarks No groundwater encountered during drilling. Refusal at 7.40m BGL; obstruction possible hard strata or boulder. Borehole backfilled upon completion. Chiselling from 7.40m to 7.40m for 1 hour.	Scale (approx) 1:50	Logged By C. Byrne
	Figure No. 9429-02-20.BH03	



Ground Investigations Ireland Ltd

www.gii.ie

Site
Swords Road, Whitehall

Borehole Number
BH04

Machine : Dando 2000, Beretta T44 Method : Cable Percussion with Rotary Core follow on	Casing Diameter 200mm to 7.40m 148mm to 13.00m	Ground Level (mOD) 42.01	Client Eastwise	Job Number 9429-02-20
	Location 716718.8 E 738088.6 N	Dates 17/06/2020- 18/06/2020	Project Contractor GII	Sheet 1/2

Depth (m)	Sample / Tests	Casing Depth (m)	Water Depth (m)	Field Records	Level (mOD)	Depth (m) (Thickness)	Description	Legend	Water
1.00 1.00-1.45	B SPT(C) N=9			1,4/1,3,2,3		(1.40)	Firm brown slightly silty slightly sandy slightly gravelly CLAY with occasional subangular to subrounded cobbles of predominantly limestone. Gravel is subangular to subrounded fine to coarse.		
2.00 2.00-2.45	B SPT(C) N=23			2,5/7,7,3,6	40.61	1.40 (1.10)	Stiff greyish brown slightly sandy slightly gravelly CLAY with occasional subangular to subrounded cobbles and boulders of limestone. Gravel is subangular to subrounded fine to coarse.		
3.00 3.00-3.45	B SPT(C) N=38			5,5/8,9,8,13	39.51	2.50	Very stiff dark grey/ black slightly sandy slightly gravelly CLAY with occasional subangular to subrounded cobbles and boulders of predominantly limestone. Gravel is subangular to subrounded fine to coarse.		
4.00 4.00-4.40	B SPT(C) 50/245			9,12/13,14,18,5					
5.00 5.00-5.22	B SPT(C) 50/70			16,24/50		(4.90)			
6.00 6.00-6.32	B SPT(C) 50/170			20,22/17,26,7					
7.00 7.00-7.14	B SPT(C) 33*/75 50/60			33/50					
7.50	TCR	SCR	RQD	FI	34.61	7.40	Very stiff dark grey/ black slightly sandy slightly gravelly CLAY with occasional subangular to subrounded cobbles and boulders of predominantly limestone. Gravel is subangular to subrounded fine to coarse.		
8.05-8.35	100			U					
9.00	100								

Remarks No groundwater encountered during cable percussion drilling. Cable percussion drilling to 7.40m BGL with rotary follow on to 13.00m BGL. Borehole backfilled upon completion. Chiselling from 7.40m to 7.40m for 1 hour.	Scale (approx) 1:50	Logged By C. Byrne
	Figure No. 9429-02-20.BH04	



Ground Investigations Ireland Ltd

www.gii.ie

Site
Swords Road, Whitehall

Borehole Number
BH04

Machine : Dando 2000, Beretta T44 Flush : Polymer Core Dia : 102 mm Method : Cable Percussion with Rotary Core follow on	Casing Diameter 200mm to 7.40m 148mm to 13.00m	Ground Level (mOD) 42.01	Client Eastwise	Job Number 9429-02-20
	Location 716718.8 E 738088.6 N	Dates 17/06/2020- 18/06/2020	Project Contractor GII	Sheet 2/2

Depth (m)	TCR	SCR	RQD	FI	Field Records	Level (mOD)	Depth (m) (Thickness)	Description	Legend	Water
10.50-10.80 10.50					U		(5.60)			
	100									
12.00										
	100									
13.00						29.01	13.00	Complete at 13.00m		

Remarks	Scale (approx) 1:50	Logged By C. Byrne
	Figure No. 9429-02-20.BH04	



Ground Investigations Ireland Ltd

www.gii.ie

Site
Swords Road, Whitehall

Borehole Number
BH05

Machine : Dando 2000, Beretta T44 Method : Cable Percussion with Rotary Core follow on	Casing Diameter 200mm to 7.00m 148mm to 37.00m	Ground Level (mOD) 41.45	Client Eastwise	Job Number 9429-02-20
	Location (dGPS) 716777.9 E 738074.8 N	Dates 17/06/2020-02/07/2020	Project Contractor GII	Sheet 1/4

Depth (m)	Sample / Tests	Casing Depth (m)	Water Depth (m)	Field Records	Level (mOD)	Depth (m) (Thickness)	Description	Legend	Water
1.00 1.00-1.45	B SPT(C) N=15			2,2/3,3,4,5		(1.60)	Firm-stiff brown slightly silty slightly sandy slightly gravelly CLAY with occasional subangular to subrounded cobbles of predominantly limestone. Gravel is subangular to subrounded fine to coarse.		
2.00 2.00-2.45	B SPT(C) N=22			3,4/6,5,5,6	39.85	1.60 (0.70)	Stiff greyish brown slightly sandy slightly gravelly CLAY with occasional subangular to subrounded cobbles of limestone. Gravel is subangular to subrounded fine to coarse.		
3.00 3.00-3.45	B SPT(C) N=38			6,7/8,9,11,10	39.15	2.30	Very stiff dark grey/ black slightly sandy slightly gravelly CLAY with occasional subangular to subrounded cobbles and boulders of predominantly limestone. Gravel is subangular to subrounded fine to coarse.		
4.00 4.00-4.45	B SPT(C) N=41			7,8/9,9,11,12					
5.00 5.00-5.34	B SPT(C) 50/190			10,11/19,18,13		(5.70)			
6.00 6.00-6.33	B SPT(C) 50/180			21,20/19,19,12					
7.00 7.00-7.07 7.00	TCR SCR RQD FI			25/50 B SPT(C) 25*/70 50/0			7.00 to 8.00 No recovery		
8.00 8.30-8.70				U	33.45	8.00	Very stiff grey slightly sandy gravelly CLAY with occasional subangular to subrounded cobbles of predominantly limestone. Gravel is subangular to subrounded fine to coarse.		
9.50						(3.00)			

Remarks No groundwater encountered during drilling. Cable percussion drilling to 7.00m BGL with rotary drilling to 37.00m BGL. Rotary core follow on complete at 37.00m BGL. Borehole backfilled upon completion. Chiselling from 7.00m to 7.00m for 1 hour.	Scale (approx) 1:50	Logged By C. Byrne
	Figure No. 9429-02-20.BH05	



Ground Investigations Ireland Ltd

www.gii.ie

Site
Swords Road, Whitehall

Borehole Number
BH05

Machine : Dando 2000, Beretta T44 Flush : Polymer Core Dia : 102 mm Method : Cable Percussion with Rotary Core follow on	Casing Diameter 200mm to 7.00m 148mm to 37.00m	Ground Level (mOD) 41.45	Client Eastwise	Job Number 9429-02-20
	Location (dGPS) 716777.9 E 738074.8 N	Dates 17/06/2020- 02/07/2020	Project Contractor GII	Sheet 2/4

Depth (m)	TCR	SCR	RQD	FI	Field Records	Level (mOD)	Depth (m) (Thickness)	Description	Legend	Water
11.00	86					30.45	11.00 (0.55)	Grey subangular to subrounded fine to coarse GRAVEL.		
12.50 12.75-13.05	90				U	29.90	11.55 (2.45)	Very stiff grey slightly sandy gravelly CLAY with occasional subangular to subrounded cobbles of predominantly limestone. Gravel is subangular to subrounded fine to coarse.		
14.00 14.60-15.00	100				U	27.45	14.00 (5.00)	Very stiff dark brown slightly sandy gravelly CLAY with occasional subangular to subrounded cobbles of predominantly limestone. Gravel is subangular to subrounded fine to coarse.		
15.50 17.00 17.50-17.80	97				U					
18.50 18.80-19.05	86				U					
20.00	100				U					
	10				U	22.45	19.00	Very stiff grey slightly sandy gravelly CLAY with some subangular to subrounded cobbles of predominantly limestone. Gravel is subangular to subrounded fine to coarse.		

Remarks	Scale (approx) 1:50	Logged By C. Byrne
	Figure No. 9429-02-20.BH05	



Ground Investigations Ireland Ltd

www.gii.ie

Site
Swords Road, Whitehall

Borehole Number
BH05

Machine : Dando 2000, Beretta T44 Flush : Polymer Core Dia : 102 mm Method : Cable Percussion with Rotary Core follow on	Casing Diameter 200mm to 7.00m 148mm to 37.00m	Ground Level (mOD) 41.45	Client Eastwise	Job Number 9429-02-20
	Location (dGPS) 716777.9 E 738074.8 N	Dates 17/06/2020-02/07/2020	Project Contractor GII	Sheet 3/4

Depth (m)	TCR	SCR	RQD	FI	Field Records	Level (mOD)	Depth (m) (Thickness)	Description	Legend	Water
21.50	100						(3.00)			
22.00	100	24	24			19.45	22.00	Medium strong-strong thinly bedded-thickly laminated fine grained argillaceous LIMESTONE with rare mudstone beds. Partially weathered to unweathered. From 22.00 to 24.30 - 2 sets of fractures. F1: 40-50 degrees closely spaced planar smooth closed with occasional brown staining and clay smearing. F2: 5-15 degrees medium spaced undulating smooth closed with clay smearing.		
23.00	100	70	70	8			(4.00)			
24.30				N.I.				From 24.30 to 24.90 - Non Intact core		
24.50										
24.90	100	56	56	7				From 24.90 to 26.00 - 1 set of fractures. F1: 40-50 degrees closely spaced planar smooth closed with occasional brown staining and clay smearing.		
26.00	100	0	0	N.I.		15.45	26.00	Medium strong-strong thinly bedded-thickly laminated fine grained argillaceous LIMESTONE with calcite veining interbedded with extremely weak-very weak black calcareous mudstone beds. Partially weathered to unweathered. From 26.00 to 27.80 - Non Intact core		
27.50										
27.80	93	60	55					Frm 27.80 - 2 sets of fractures. F1: 40-50 degrees closely spaced planar smooth closed with occasional brown staining and clay smearing. F2: 5-15 degrees medium spaced undulating smooth closed with clay smearing.		
29.00	100	76	72							

Remarks	Scale (approx) 1:50	Logged By C. Byrne
	Figure No. 9429-02-20.BH05	



Ground Investigations Ireland Ltd

www.gii.ie

Site
Swords Road, Whitehall

Borehole Number
BH05

Machine : Dando 2000, Beretta T44 Flush : Polymer Core Dia : 102 mm Method : Cable Percussion with Rotary Core follow on	Casing Diameter 200mm to 7.00m 148mm to 37.00m	Ground Level (mOD) 41.45	Client Eastwise	Job Number 9429-02-20
	Location (dGPS) 716777.9 E 738074.8 N	Dates 17/06/2020-02/07/2020	Project Contractor GII	Sheet 4/4

Depth (m)	TCR	SCR	RQD	FI	Field Records	Level (mOD)	Depth (m) (Thickness)	Description	Legend	Water
30.50										
	100	50	50				(11.00)			
32.00				10						
	100	45	45							
33.50										
	100	52	52							
35.00										
	100	55	55							
36.50										
	70	0	0							
37.00						4.45	37.00	Complete at 37.00m		

Remarks	Scale (approx) 1:50	Logged By C. Byrne
	Figure No. 9429-02-20.BH05	



Ground Investigations Ireland Ltd

www.gii.ie

Site Swords Road, Whitehall	Borehole Number BH06
Machine : Dando 2000 Method : Cable Percussion	Job Number 9429-02-20
Casing Diameter 200mm to 8.00m	Sheet 1/1
Ground Level (mOD) 41.64	Project Contractor GII
Location 716695 E 738068.6 N	Dates 17/06/2020- 18/06/2020

Depth (m)	Sample / Tests	Casing Depth (m)	Water Depth (m)	Field Records	Level (mOD)	Depth (m) (Thickness)	Description	Legend	Water	Instr
1.00-1.45 1.00	SPT(C) N=10 B			3,4/2,2,2,4	41.24	(0.40) 0.40	MADE GROUND: Black slightly sandy slightly gravelly Clay fill with brick and rubbish fragments. . Gravel is subangular to subrounded fine to coarse.			
2.00	B					(2.10)	Firm brown slightly silty slightly sandy slightly gravelly CLAY with occasional subangular to subrounded cobbles of predominantly limestone. Gravel is subangular to subrounded fine to coarse.			
3.00-3.45 3.00	SPT(C) N=22 B			6,4/5,5,5,7	39.14	2.50 (0.60)	Stiff greyish brown slightly sandy slightly gravelly CLAY with occasional subangular to subrounded cobbles of limestone. Gravel is subangular to subrounded fine to coarse.			
4.00-4.45 4.00	SPT(C) N=41 B			4,8/8,10,11,12	38.54	3.10	Very stiff dark grey/ black slightly sandy slightly gravelly CLAY with occasional subangular to subrounded cobbles and boulders of predominantly limestone. Gravel is subangular to subrounded fine to coarse.			
5.00-5.45 5.00	SPT(C) N=46 B			5,9/11,11,12,12		(4.90)				
6.00-6.33 6.00	SPT(C) 50/180 B			14,22/18,20,12						
7.00-7.14 7.00	SPT(C) 31*/75 50/60 B			31/50						
8.00-8.07 8.00	SPT(C) 25*/70 50/0 B			25/50	33.64	8.00	Refusal at 8.00m			

Remarks

No groundwater encountered during drilling.
Refusal at 8.00m BGL; obstruction possible hard strata or boulder.
Slotted pipe installed from 8.00m BGL to 1.50m BGL with pea gravel filter zone from 8.00m BGL to 1.00m BGL and bentonite seal from 1.00m BGL to GL, finished with an upright cover.
Chiselling from 8.00m to 8.00m for 1 hour.

Scale (approx)
1:50

Logged By
C. Byrne

Figure No.
9429-02-20.BH06



Ground Investigations Ireland Ltd

www.gii.ie

Site
Swords Road, Whitehall

Borehole Number
BH07

Machine : Dando 2000	Casing Diameter 200mm to 7.00m	Ground Level (mOD) 40.96	Client Eastwise	Job Number 9429-02-20
Method : Cable Percussion	Location 716735.8 E 738044.8 N	Dates 17/06/2020- 18/06/2020	Project Contractor GII	Sheet 1/1

Depth (m)	Sample / Tests	Casing Depth (m)	Water Depth (m)	Field Records	Level (mOD)	Depth (m) (Thickness)	Description	Legend	Water
1.00-1.45 1.00	SPT(C) N=17 B			1,4/4,5,3,5	39.86	(1.10) 1.10	Firm brown slightly silty slightly sandy slightly gravelly CLAY with occasional subangular to subrounded cobbles of predominantly limestone. Gravel is subangular to subrounded fine to coarse.		
2.00-2.45 2.00	SPT(C) N=25 B			3,4/6,6,7,6	38.56	(1.30) 2.40	Stiff greyish brown slightly sandy slightly gravelly CLAY with occasional subangular to subrounded cobbles of limestone. Gravel is subangular to subrounded fine to coarse.		
3.00-3.45 3.00	SPT(C) N=15 B			3,3/3,4,4,4			Very stiff dark grey/ black slightly sandy slightly gravelly CLAY with occasional subangular to subrounded cobbles and boulders of predominantly limestone. Gravel is subangular to subrounded fine to coarse.		
4.00-4.45 4.00	SPT(C) N=43 B			8,8/11,7,13,12		(4.60)			
5.00-5.40 5.00	SPT(C) 50/245 B			9,11/14,14,13,9					
6.00-6.27 6.00	SPT(C) 50/115 B			17,20/26,24					
7.00-7.07 7.00	SPT(C) 25*/70 50/0 B			25/50	33.96	7.00	Refusal at 7.00m		

Remarks No groundwater encountered during drilling. Refusal at 7.00m BGL; obstruction possible hard strata or boulder. Borehole backfilled upon completion. Chiselling from 7.00m to 7.00m for 1 hour.	Scale (approx) 1:50	Logged By C. Byrne
	Figure No. 9429-02-20.BH07	



Ground Investigations Ireland Ltd

www.gii.ie

Site
Swords Road, Whitehall

Borehole Number
BH08

Machine : Dando 2000	Casing Diameter 200mm to 7.00m	Ground Level (mOD) 40.88	Client Eastwise	Job Number 9429-02-20
Method : Cable Percussion	Location 716781.1 E 738036.1 N	Dates 25/06/2020	Project Contractor GII	Sheet 1/1

Depth (m)	Sample / Tests	Casing Depth (m)	Water Depth (m)	Field Records	Level (mOD)	Depth (m) (Thickness)	Description	Legend	Water
1.00-1.45 1.00	SPT(C) N=7 B			1,1/2,1,2,2	39.78	(1.10) 1.10	MADE GROUND: Brown slightly sandy slightly silty slightly gravelly Clay with occasional subangular to subrounded cobbles of predominantly limestone and red brick fragments. Gravel is subangular to subrounded fine to coarse.		
2.00-2.45 2.00	SPT(C) N=9 B			3,2/2,3,3,1		(3.20)	Firm greyish brown slightly sandy slightly gravelly CLAY with occasional subangular to subrounded cobbles of limestone. Gravel is subangular to subrounded fine to coarse.		
3.00-3.45 3.00	SPT(C) N=14 B			2,4/2,4,4,4					
4.00-4.45 4.00	SPT(C) N=36 B			11,5/6,7,10,13	36.58	4.30	Very stiff dark grey/ black slightly sandy slightly gravelly CLAY with occasional subangular to subrounded cobbles and boulders of predominantly limestone. Gravel is subangular to subrounded fine to coarse.		
5.00-5.34 5.00	SPT(C) 50/190 B			16,13/12,17,21		(2.70)			
6.00-6.07 6.00	SPT(C) 25*/0 50/70 B			25/50					
7.00-7.15 7.00	SPT(C) 33*/75 50/70 B			33/50	33.88	7.00	Refusal at 7.00m		

Remarks No Groundwater encountered during drilling. Refusal at 7.00m BGL; obstruction possible hard strata or boulder. Borehole backfilled upon completion. Chiselling from 7.00m to 7.00m for 1 hour.								Scale (approx) 1:50	Logged By C. Byrne
								Figure No. 9429-02-20.BH08	



Ground Investigations Ireland Ltd

www.gii.ie

Site
Swords Road, Whitehall

Borehole Number
BH09

Machine : Dando 2000	Casing Diameter 200mm to 7.20m 148mm to 34.00m	Ground Level (mOD) 40.29	Client Eastwise	Job Number 9429-02-20
Method : Cable Percussion with Rotary Core follow on	Location (dGPS) 716872.7 E 738108.8 N	Dates 22/06/2020- 02/07/2020	Project Contractor GII	Sheet 1/4

Depth (m)	Sample / Tests	Casing Depth (m)	Water Depth (m)	Field Records	Level (mOD)	Depth (m) (Thickness)	Description	Legend	Water
1.00 1.00-1.07	B SPT(C) 25*/0 50/70			25/50		(1.80)	MADE GROUND: Dark grey slightly sandy slightly silty slightly gravelly Clay with occasional subangular to subrounded cobbles of limestone, concrete, red brick and tarmac fragments. Gravel is subangular to subrounded fine to coarse.		
2.00 2.00-2.45	B SPT(C) N=9			2,2/2,2,2,3	38.49	1.80 (0.50)	MADE GROUND: Dark grey/ black slightly sandy slightly gravelly Clay with occasional subangular to subrounded cobbles of limestone, mortar and plastic fragments. Gravel is subangular to subrounded fine to coarse.		
3.00 3.00-3.45	B SPT(C) N=22			4,6/6,6,6,4	37.99 37.79	2.30 (0.20) 2.50	Firm greyish brown slightly sandy slightly gravelly CLAY with occasional subangular to subrounded cobbles of limestone. Gravel is subangular to subrounded fine to coarse.		
	0 -				36.79	3.50	Stiff dark grey/ black slightly sandy slightly gravelly CLAY with occasional subangular to subrounded cobbles and boulders of predominantly limestone. Gravel is subangular to subrounded fine to coarse.		
4.00 4.00-4.45	B SPT(C) N=49			6,8/12,12,13,12			Very stiff dark grey/ black slightly sandy slightly gravelly CLAY with occasional subangular to subrounded cobbles and boulders of predominantly limestone. Gravel is subangular to subrounded fine to coarse.		
5.00 5.00-5.35	B SPT(C) 68/200			8,18/18,22,28					
6.00 6.00-6.20	B SPT(C) 50/50			29,37/50					
7.00 7.00-7.07	B 50/70 SPT(C) 34*/0			34/50					
7.20	TCR 0	SCR -	RQD	FI			7.20m to 8.00m no recovery		
8.00	93	-							
9.65-10.00 9.50				U		(12.00)			

Remarks SPT Fail at 1.00m BGL due to obstruction. No Groundwater encountered during drilling. Cable percussion drilling to 7.20m BGL with rotary follow on to 34.00m BGL. Borehole backfilled upon completion. Chiselling from 7.20m to 7.20m for 1 hour.	Scale (approx) 1:50	Logged By C. Byrne
Figure No. 9429-02-20.BH09		



Ground Investigations Ireland Ltd

www.gii.ie

Site
Swords Road, Whitehall

Borehole Number
BH09

Machine : Dando 2000		Casing Diameter 200mm to 7.20m 148mm to 34.00m		Ground Level (mOD) 40.29	Client Eastwise	Job Number 9429-02-20
Flush :		Location (dGPS) 716872.7 E 738108.8 N		Dates 22/06/2020- 02/07/2020	Project Contractor GII	Sheet 2/4
Core Dia: mm						
Method : Cable Percussion with Rotary Core follow on						

Depth (m)	TCR	SCR	RQD	FI	Field Records	Level (mOD)	Depth (m) (Thickness)	Description	Legend	Water
11.00	100	-								
11.70-12.00	100	-			U					
12.50										
14.00	100	-								
14.40-14.70	100	-			U					
15.50						24.79	15.50	Very stiff brown slightly sandy gravelly CLAY with some subangular to subrounded cobbles of predominantly limestone. Gravel is subangular to subrounded fine to coarse.		
17.00	100	-								
18.50										
19.70-20.00	100	-			U					
20.00										

Remarks								Scale (approx) 1:50	Logged By C. Byrne
								Figure No. 9429-02-20.BH09	



Ground Investigations Ireland Ltd

www.gii.ie

Site
Swords Road, Whitehall

Borehole Number
BH09

Machine : Dando 2000		Casing Diameter 200mm to 7.20m 148mm to 34.00m		Ground Level (mOD) 40.29	Client Eastwise	Job Number 9429-02-20
Flush :		Location (dGPS) 716872.7 E 738108.8 N		Dates 22/06/2020- 02/07/2020	Project Contractor GII	Sheet 3/4
Core Dia: mm						
Method : Cable Percussion with Rotary Core follow on						

Depth (m)	TCR	SCR	RQD	FI	Field Records	Level (mOD)	Depth (m) (Thickness)	Description	Legend	Water
20.30-20.70					U		(9.00)			
21.15-21.45	93	-			U					
21.50										
23.00	80	-								
24.50	93	-								
24.50						15.79	24.50	Grey slightly sandy slightly clayey subangular to subrounded fine to coarse GRAVEL with many subangular to subrounded cobbles of predominantly limestone.		
	100	-					(1.20)			
26.00						14.59	25.70	Very stiff dark grey slightly sandy gravelly CLAY with some subangular to subrounded cobbles of predominantly limestone. Gravel is subangular to subrounded fine to coarse.		
27.40-27.90	83	-			U					
27.50										
29.00	100	-					(6.60)			

Remarks								Scale (approx)	Logged By
								1:50	C. Byrne
								Figure No. 9429-02-20.BH09	



Ground Investigations Ireland Ltd

www.gii.ie

Site
Swords Road, Whitehall

Borehole Number
BH09

Machine : Dando 2000		Casing Diameter 200mm to 7.20m 148mm to 34.00m		Ground Level (mOD) 40.29	Client Eastwise	Job Number 9429-02-20
Flush :		Location (dGPS) 716872.7 E 738108.8 N		Dates 22/06/2020- 02/07/2020	Project Contractor GII	Sheet 4/4
Core Dia: mm						
Method : Cable Percussion with Rotary Core follow on						

Depth (m)	TCR	SCR	RQD	FI	Field Records	Level (mOD)	Depth (m) (Thickness)	Description	Legend	Water
30.50										
	100	-								
32.00						7.99	32.30	Medium strong to strong thinly bedded-thickly laminated fine grained grey argillaceous LIMESTONE interbedded with weak black calcareous mudstone. Partially weathered. 2 sets of fractures. F1: 40-50 degrees very closely to closely spaced planar smooth closed with occasional clay smearing. F2: 30-40 degrees very closely to closely spaced undulating to planar smooth to rough closed.		
	100	27	27				(1.70)			
33.50										
	100	78	78							
34.00						6.29	34.00	Complete at 34.00m		

Remarks	Scale (approx)		Logged By
	1:50		C. Byrne
	Figure No. 9429-02-20.BH09		



Ground Investigations Ireland Ltd

www.gii.ie

Site Swords Road, Whitehall	Borehole Number BH10
Machine : Dando 2000 Method : Cable Percussion	Job Number 9429-02-20
Casing Diameter 200mm to 7.20m	Sheet 1/1
Ground Level (mOD) 39.90	Project Contractor GII
Location 716878.8 E 738078.8 N	Dates 23/06/2020

Depth (m)	Sample / Tests	Casing Depth (m)	Water Depth (m)	Field Records	Level (mOD)	Depth (m) (Thickness)	Description	Legend	Water	Instr
1.00-1.45 1.00	SPT(C) N=10 B			1,1/1,3,3,3		(1.50)	MADE GROUND: brown slightly sandy slightly gravelly Clay with red brick fragments. Gravel is subangular to subrounded fine to coarse.			
2.00-2.45 2.00	SPT(C) N=7 B			2,2/1,1,2,3	38.40	1.50 (1.00)	Soft to firm greyish brown slightly sandy slightly gravelly CLAY with occasional subangular to subrounded cobbles of limestone. Gravel is subangular to subrounded fine to coarse.			
3.00-3.45 3.00	SPT(C) N=30 B			3,4/6,6,9,9	37.40	2.50	Very stiff dark grey/ black slightly sandy slightly gravelly CLAY with occasional subangular to subrounded cobbles and boulders of predominantly limestone. Gravel is subangular to subrounded fine to coarse.			
4.00-4.45 4.00	SPT(C) N=44 B			7,9/9,11,11,13		(4.70)				
5.00-5.45 5.00	SPT(C) N=50 B			8,10/12,12,12,14						
6.00-6.27 6.00	SPT(C) 50/115 B			16,16/23,27						
7.00-7.06 7.00	SPT(C) 25*/0 50/60 B			25/50	32.70	7.20	Refusal at 7.20m			

Remarks No Groundwater encountered during drilling. Refusal at 7.20m BGL; obstruction possible hard strata or boulder. Slotted pipe installed from 7.20m BGL to 1.50m BGL with pea gravel filter zone from 7.20m BGL to 1.00m BGL and bentonite seal from 1.00m BGL to GL, finished with an upright cover. Chiselling from 7.20m to 7.20m for 1 hour.	Scale (approx)	Logged By
	1:50	C. Byrne
	Figure No. 9429-02-20.BH10	

Whitehall, Swords Road Extension – Aecom
9429-02-20 RC Photographs

BH04 - 7.50 to 10.50 m BGL



BH04 - 10.50 to 13.00m BGL



Whitehall, Swords Road Extension – Aecom
9429-02-20 RC Photographs

BH05 – 7.00 to 12.50m BGL



BH05 – 12.50 to 17.00m BGL



Whitehall, Swords Road Extension – Aecom
9429-02-20 RC Photographs

BH05 – 17.00 to 21.50m BGL



BH05 – 21.50 to 26.00m BGL



Whitehall, Swords Road Extension – Aecom
9429-02-20 RC Photographs

BH05 – 26.00 to 30.50m BGL



BH05 – 30.50 to 35.00m BGL



Whitehall, Swords Road Extension – Aecom
9429-02-20 RC Photographs

BH05 – 35.00 to 37.00m BGL



Whitehall, Swords Road Extension – Aecom
9429-02-20 RC Photographs

BH09 – 7.20 to 12.50m BGL



BH09 – 12.50 to 17.00m BGL



Whitehall, Swords Road Extension – Aecom
9429-02-20 RC Photographs

BH09 – 17.00 to 21.50m BGL



BH09 – 21.50 to 26.00m BGL



Whitehall, Swords Road Extension – Aecom
9429-02-20 RC Photographs

BH09 – 26.00 to 30.50m BGL



BH09 – 30.50 to 34.00m BGL



APPENDIX 6 – Laboratory Testing



National Materials Testing Laboratory Ltd.

SUMMARY OF TEST RESULTS

				Particle			Index Properties		Bulk	Cell	Undrained Triaxial Tests		Lab	
BH/TP	Depth	sample	Moisture	Density	<425um	LL	PL	PI	Density	Presssure	Compressive	Strain at	Vane	Remarks
No	m	No.	%	Mg/m3	%	%	%	%	Mg/m3	kPa	Stress kPa	Failure %	kPa	
TP01	0.70	T	13.9											
TP01	1.60	T	14.1		56.8	30	21	9						
TP01	2.40	B/T	9.3											
TP02	0.50	T	15.2											
TP02	1.50	B	16.0		61.7	28	19	9						
TP02	2.70	T	8.2											
TP03	0.50	T	32.4											
TP03	1.80	T	11.5											
TP03	2.70	B	14.5		54.3	30	16	14						
TP04	0.50	T	14.4		45.1	39	21	18						
TP04	1.80	T	12.7											
TP05C	0.90	T												missing
TP05C	2.00	T	10.9											
TP05C	2.90	T	15.1											
TP06	0.60	T	14.5		44.5	37	20	17						
TP06	1.50	T	12.4											
TP06	2.70	T	11.9											
TP06	3.70	T	11.9											
TP07	0.70	T	35.3		71.4	49	29	20						
TP07	1.40	T	19.6											
TP07	3.30	B/T	15.3											
TP08	0.70	B/T	14.6		64.8	40	23	17						
TP08	1.50	T	11.4											
TP08	2.80	T	10.4											
TP09	1.90	B/T	12.6		61.2	29	18	11						
TP09	2.80	T	8.8											
NMTL		Notes : 1. All BS tests carried out using preferred (definitive) method unless otherwise stated.									Job ref No.	NMTL 3243 GII Project ID		9255-11-19
19/08/2020											Location	Whitehall, Swords		

National Materials Testing Laboratory Ltd.

SUMMARY OF TEST RESULTS

				Particle			Index Properties		Bulk	Cell	Undrained Triaxial Tests		Lab	
BH/TP	Depth	sample	Moisture	Density	<425um	LL	PL	PI	Density	Presssure	Compressive	Strain at	Vane	Remarks
No	m	No.	%	Mg/m3	%	%	%	%	Mg/m3	kPa	Stress kPa	Failure %	kPa	
TP10	0.50	B	18.4		55.1	35	23	12						
TP10	1.40	T	14.68											
TP10	2.80	T	9.51											
BH01	1.00	B	19.6											
BH01	2.00	B	15.0		65.2	32	17	15						
BH01	3.00	B	14.2											
BH01	4.00	B	14.4											
BH01	5.00	B	14.8											
BH02	1.00	B	16.7											
BH02	2.00	B	14.3											
BH02	3.00	B	10.2											
BH02	4.00	B	11.9											
BH02	5.00	B	11.1		65.8	28	15	13						
BH02	6.00	B	14.0		57.8	28	14	14						
BH02	7.00	B	8.9											
BH03	1.00	B	13.7											
BH03	2.00	B	14.6		58.9	31	16	15						
BH03	3.00	B	12.0											
BH03	4.00	B	11.6											
BH03	5.00	B	13.1		63.7	29	14	15						
BH03	6.00	B	11.1											
BH03	7.00	B	9.6											
BH04	1.00	B	13.2											
BH04	2.00	B	14.5											
BH04	3.00	B	12.7											
NMTL		Notes : 1. All BS tests carried out using preferred (definitive) method unless otherwise stated.									Job ref No.	NMTL 3243 GII Project ID		9255-11-19
19/08/2020											Location	Whitehall, Swords		

National Materials Testing Laboratory Ltd.

SUMMARY OF TEST RESULTS

				Particle			Index Properties		Bulk	Cell	Undrained Triaxial Tests		Lab	
BH/TP	Depth	sample	Moisture	Density	<425um	LL	PL	PI	Density	Presssure	Compressive	Strain at	Vane	Remarks
No	m	No.	%	Mg/m3	%	%	%	%	Mg/m3	kPa	Stress kPa	Failure %	kPa	
BH04	4.00	B	9.7											
BH04	5.00	B	12.6											
BH04	6.00	B	11.6											
BH04	7.00	B	12.1											
BH04	10.5-10.9	C	9.3		59.6	34	17	17						
BH05	1.00	B	17.8		51.7	38	20	18						
BH05	2.00	B	14.3		57.8	30	15	15						
BH05	3.00	B	12.2											
BH05	4.00	B	13.4		50.7	29	15	14						
BH05	5.00	B	10.4											
BH05	6.00	B	12.0											
BH05	7.00	B	13.9											
BH05	8.3-8.7	C	7.8		51.4	32	18	14						
BH05	14.6-15.0	C	9.9		66.2	33	18	15						
BH06	1.00	B	24.7											
BH06	2.00	B	14.5											
BH06	3.00	B	11.2											
BH06	4.00	B	12.6											
BH06	5.00	B	12.0											
BH06	6.00	B	10.6											
BH06	7.00	B	12.2		59.5	28	14	14						
BH06	8.00	B	9.5											
BH07	1.00	B	18.4											
BH07	2.00	B	19.1											
BH07	3.00	B	12.9											
BH07	4.00	B	11.7											
NMTL		Notes : 1. All BS tests carried out using preferred (definitive) method unless otherwise stated.									Job ref No.	NMTL 3243 GII Project ID		9255-11-19
19/08/2020											Location	Whitehall, Swords		


National Materials Testing Laboratory Ltd.

SUMMARY OF TEST RESULTS

				Particle			Index Properties		Bulk	Cell	Undrained Triaxial Tests		Lab	
BH/TP	Depth	sample	Moisture	Density	<425um	LL	PL	PI	Density	Presssure	Compressive	Strain at	Vane	Remarks
No	m	No.	%	Mg/m3	%	%	%	%	Mg/m3	kPa	Stress kPa	Failure %	kPa	
BH07	5.00	B	12.6											
BH07	6.00	B	11.0											
BH07	7.00	B	14.5		57.2	29	15	14						
BH08	1.00	B	21.5											
BH08	2.00	C	29.9		76.9	46	24	22						
BH08	3.00	B	14.5											
BH08	4.00	B	13.7											
BH08	5.00	B	10.6											
BH08	6.00	B	15.4											
BH08	7.00	B	13.5											
BH09	3.00	B	12.4		53.9	28	14	14						
BH09	4.00	B	11.4											
BH09	5.00	B	12.0		59.2	28	15	13						
BH09	6.00	B	12.3											
BH09	7.00	B	13.7											
BH09	9.65-10.0	C	7.6		48.9	34	18	16						
BH09	14.6-15.0	C	10.7		85.6	32	16	16						
BH10	2.00	B	11.0											
BH10	3.00	B	12.9		55.8	28	16	12						
BH10	4.00	B	11.7											
BH10	5.00	B	15.2											
BH10	6.00	B	11.0											
BH10	7.00	B	8.2											
NMTL		Notes : 1. All BS tests carried out using preferred (definitive) method unless otherwise stated.									Job ref No.	NMTL 3243 GII Project ID		9255-11-19
19/08/2020											Location	Whitehall, Swords		


NMTL LTD
Unit 18c, Tullow Industrial Estate
Tullow
County Carlow
Tel: 00353 59 9180822
Mob: 00353 872575508
billa@nmtl.ie

Contract: Whitehall, Swords
Client: Ground Investigations Ireland Ltd
Engineer: Mike Sutton
GII Project ID 9255-11-19
Date: 19/08/2020
Tested By: Tzr/Sb/Ms **Checked:** Bc
Job ref No. NMTL 3243

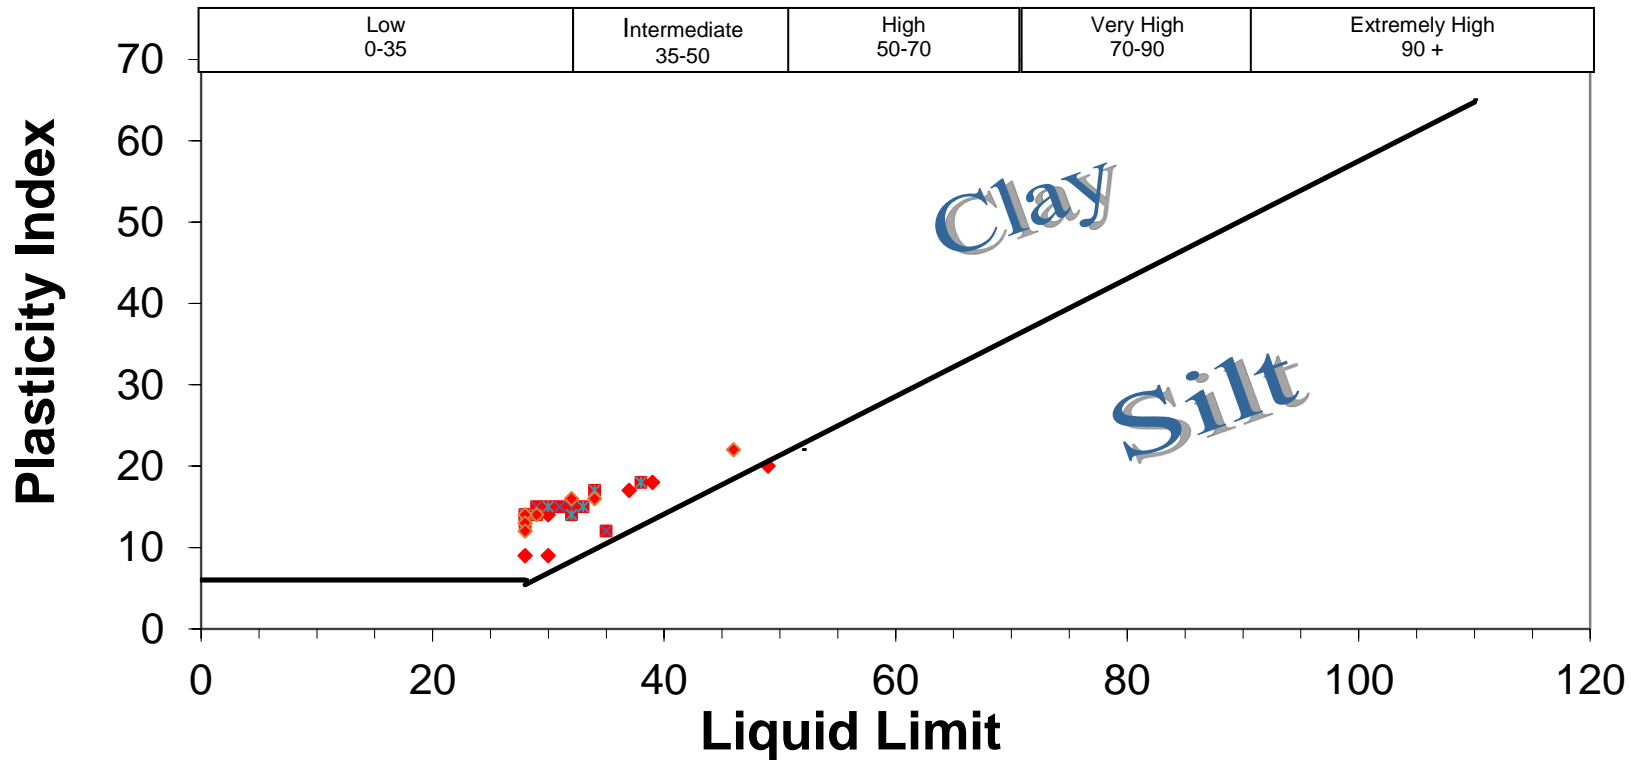

NMTL Ltd

Sieve	%
Size mm	Passing
125.000	100.0
75.000	100.0
63.000	100.0
50.000	100.0
37.500	96.9
28.000	94.5
20.000	90.4
14.000	89.4
10.000	86.6
6.300	82.5
5.000	78.3
3.350	74.5
2.000	69.1
1.180	64.2
0.600	59.1
0.425	56.8
0.300	54.7
0.212	52.5
0.150	50.4
0.063	44.9
0.053	43.2
0.038	40.1
0.019	35.5
0.010	30.4
0.007	27.0
0.005	24.1
0.004	22.2
0.002	17.0

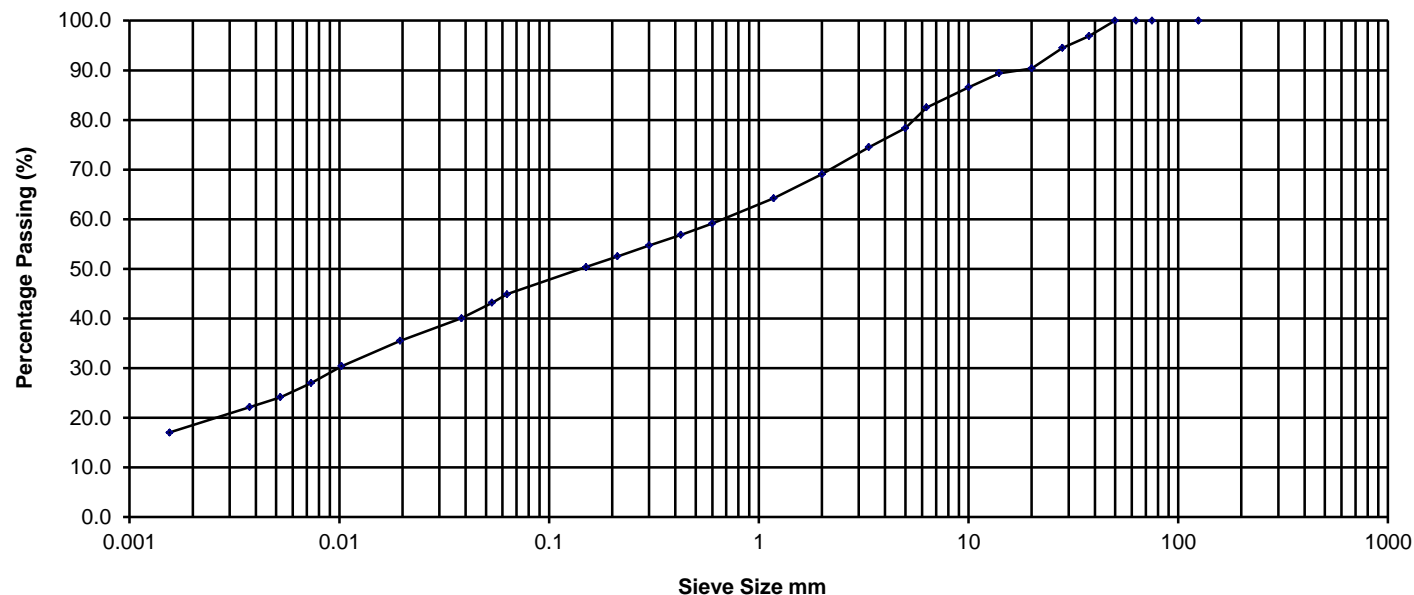NM**TL****Ltd****Determination of Particle Size Distribution****BS 1377 : 1990 : Part 2 : Clauses 9.2 & 9.5**

Percentage Particle Size

Clay	Fine	Medium	Coarse	Fine	Medium	Coarse	Fine	Medium	Coarse	Cobbles	Boulder
	Silt			Sand			Gravel				
17.0	27.8			24.2			30.9			0.0	0.0

Sample Description Brown slightly sandy slightly gravelly silty CLAY.

Project No. NMTL 3243

BH/TP No. TP01

Project Whitehall, Swords

GII Project ID-9225-11-19

Sample No. B

Operator

Tzr

Checked

Nc

Approved

Bc

Date sample tested

08/08/2020

Depth


1.60m

NMTL Ltd

Sieve	%
Size mm	Passing
125.000	100.0
75.000	100.0
63.000	100.0
50.000	100.0
37.500	96.5
28.000	89.7
20.000	88.1
14.000	86.3
10.000	82.3
6.300	78.4
5.000	76.2
3.350	73.4
2.000	68.1
1.180	62.8
0.600	56.9
0.425	54.3
0.300	51.8
0.212	49.3
0.150	46.8
0.063	40.7

Determination of Particle Size Distribution

BS 1377 : 1990 : Part 2 : Clauses 9.2 & 9.5

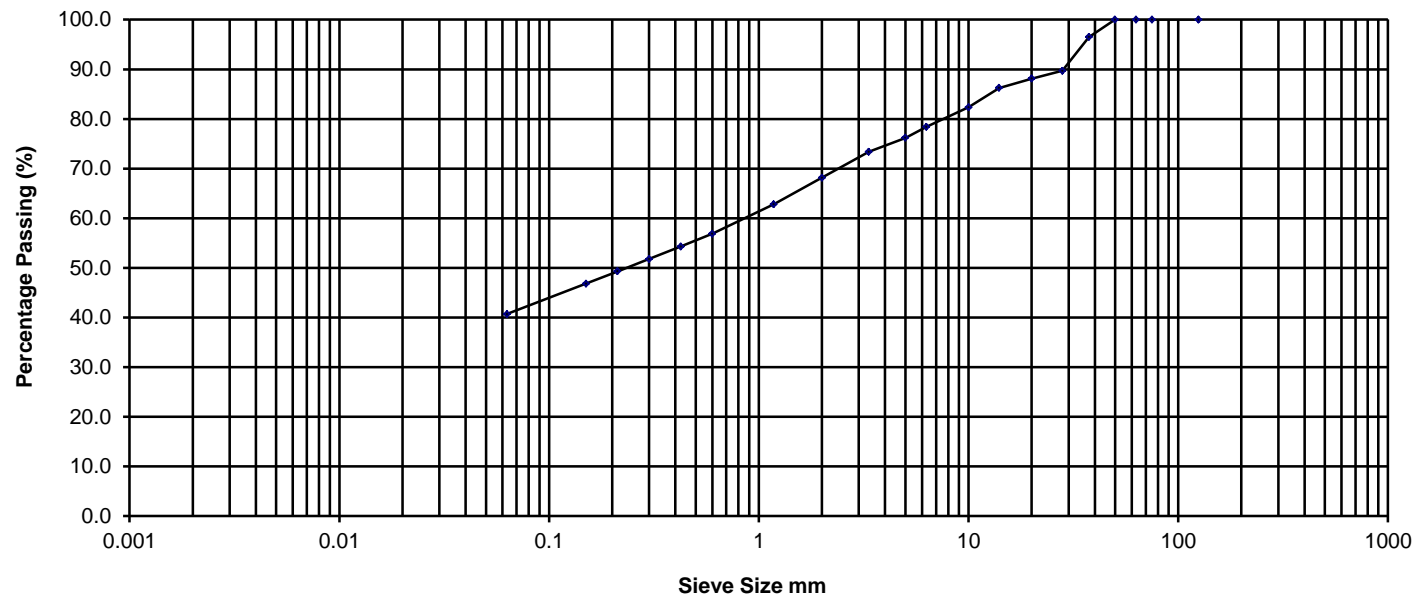

Percentage Particle Size

Clay	Fine	Medium	Coarse	Fine	Medium	Coarse	Fine	Medium	Coarse	Cobbles	Boulder
	Silt			Sand			Gravel				
	40.7			27.5			31.9			0.0	0.0

Sample Description Grey slightly sandy slightly gravelly SILT/CLAY.

Project No. NMTL 3243

BH/TP No. TP03

Project Whitehall, Swords

GII Project ID-9225-11-19

Sample No. B

NM**TL****Ltd**


Operator	Tzr	Checked	Nc	Approved	Bc	Date sample tested	04/08/2020	Depth	2.70m
----------	-----	---------	----	----------	----	--------------------	------------	-------	-------

NMTL Ltd

Sieve	%
Size mm	Passing
125.000	100.0
75.000	100.0
63.000	100.0
50.000	100.0
37.500	100.0
28.000	100.0
20.000	91.6
14.000	83.4
10.000	77.7
6.300	70.6
5.000	65.7
3.350	61.7
2.000	56.1
1.180	51.6
0.600	47.0
0.425	45.1
0.300	43.2
0.212	41.4
0.150	39.5
0.063	34.9

Determination of Particle Size Distribution

BS 1377 : 1990 : Part 2 : Clauses 9.2 & 9.5

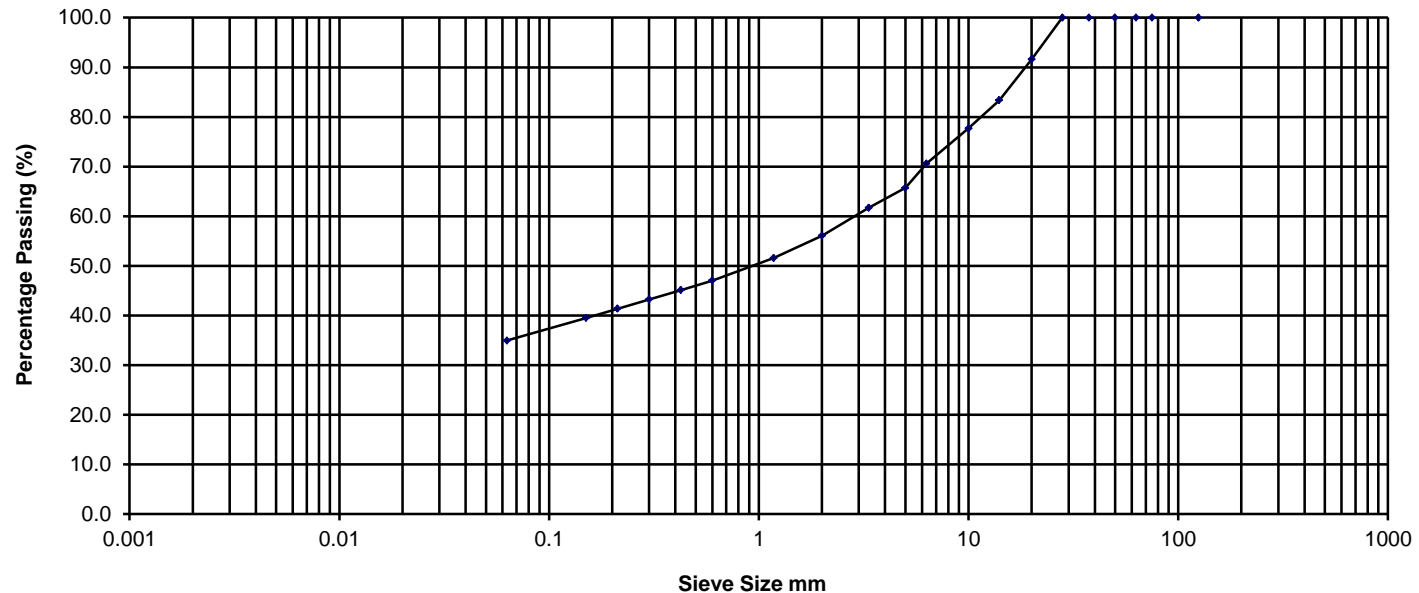

Percentage Particle Size

Clay	Fine	Medium	Coarse	Fine	Medium	Coarse	Fine	Medium	Coarse	Cobbles	Boulder
	Silt			Sand			Gravel			0.0	0.0
	34.9			21.1			43.9				

Sample Description Light brown/grey slightly sandy gravelly SILT/CLAY.

Project No. NMTL 3243

BH/TP No. TP04

Project Whitehall, Swords

GII Project ID-9225-11-19

Sample No. T

NM

TL

Ltd

Operator

Tzr

Checked

Nc

Approved

Bc

Date sample tested

08/08/2020

Depth


0.50m

NMTL Ltd

Sieve	%
Size mm	Passing
125.000	100.0
75.000	94.1
63.000	94.1
50.000	90.6
37.500	87.2
28.000	83.2
20.000	79.5
14.000	74.6
10.000	71.7
6.300	66.7
5.000	63.1
3.350	59.5
2.000	53.8
1.180	49.6
0.600	46.1
0.425	44.5
0.300	42.9
0.212	41.3
0.150	39.6
0.063	35.4

Determination of Particle Size Distribution

BS 1377 : 1990 : Part 2 : Clauses 9.2 & 9.5

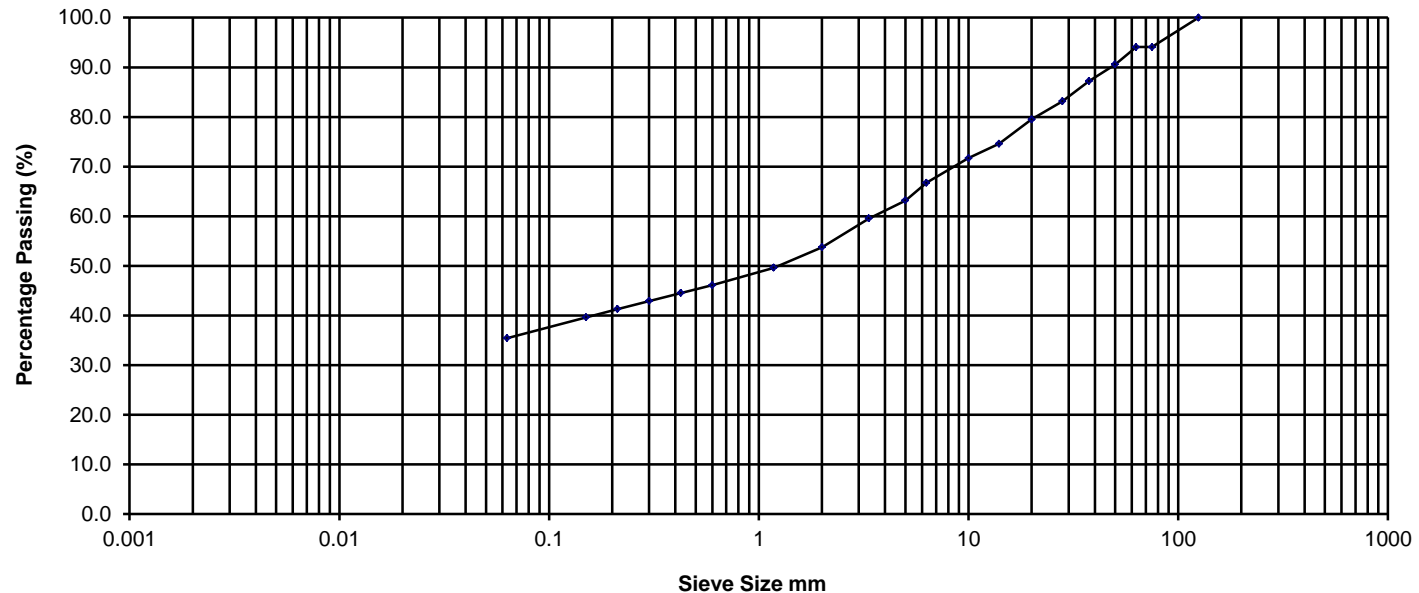

Percentage Particle Size

Clay	Fine	Medium	Coarse	Fine	Medium	Coarse	Fine	Medium	Coarse	Cobbles	Boulder
	Silt			Sand			Gravel				
	35.4			18.3			40.3			5.9	0.0

Sample Description Light brown/grey slightly sandy gravelly SILT/CLAY, with some cobbles.

Project No. NMTL 3243

BH/TP No. TP06

Project Whitehall, Swords

GII Project ID-9225-11-19

Sample No. B

NMTL Ltd


Operator	Tzr	Checked	Nc	Approved	Bc	Date sample tested	05/08/2020	Depth	0.60m
----------	-----	---------	----	----------	----	--------------------	------------	-------	-------

NMTL Ltd

Sieve	%
Size mm	Passing
125.000	100.0
75.000	100.0
63.000	97.3
50.000	94.7
37.500	93.1
28.000	91.5
20.000	89.2
14.000	85.3
10.000	81.7
6.300	75.3
5.000	72.7
3.350	70.4
2.000	65.7
1.180	60.8
0.600	55.4
0.425	52.9
0.300	50.3
0.212	47.6
0.150	44.9
0.063	38.4

Determination of Particle Size Distribution

BS 1377 : 1990 : Part 2 : Clauses 9.2 & 9.5

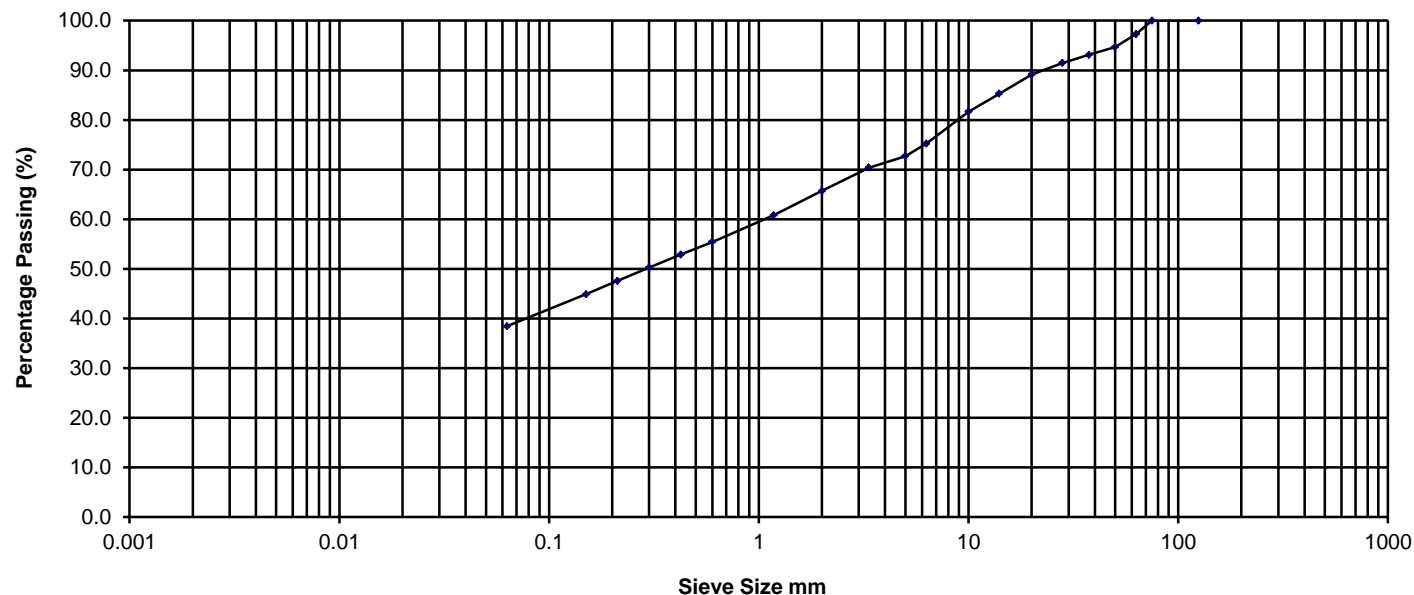

Percentage Particle Size

Clay	Fine	Medium	Coarse	Fine	Medium	Coarse	Fine	Medium	Coarse	Cobbles	Boulder
	Silt			Sand			Gravel				
	38.4			27.3			31.6			2.7	0.0

Sample Description Light brown slightly sandy slightly gravelly SILT/CLAY, with occasional cobbles.

Project No. NMTL 3243

BH/TP No. TP07

Project Whitehall, Swords

GII Project ID-9225-11-19


Sample No. B

NMTL Ltd

Operator	Tzr	Checked	Nc	Approved	Bc	Date sample tested	06/08/2020	Depth	3.30m
----------	-----	---------	----	----------	----	--------------------	------------	-------	-------

NMTL Ltd

Sieve	%
Size mm	Passing
125.000	100.0
75.000	100.0
63.000	100.0
50.000	100.0
37.500	99.3
28.000	93.4
20.000	91.1
14.000	88.3
10.000	85.1
6.300	82.4
5.000	79.9
3.350	77.6
2.000	73.3
1.180	69.5
0.600	66.2
0.425	64.8
0.300	63.4
0.212	61.9
0.150	60.3
0.063	56.2
0.052	54.0
0.037	50.6
0.019	42.7
0.010	34.2
0.007	29.8
0.005	24.5
0.004	20.7
0.002	14.1

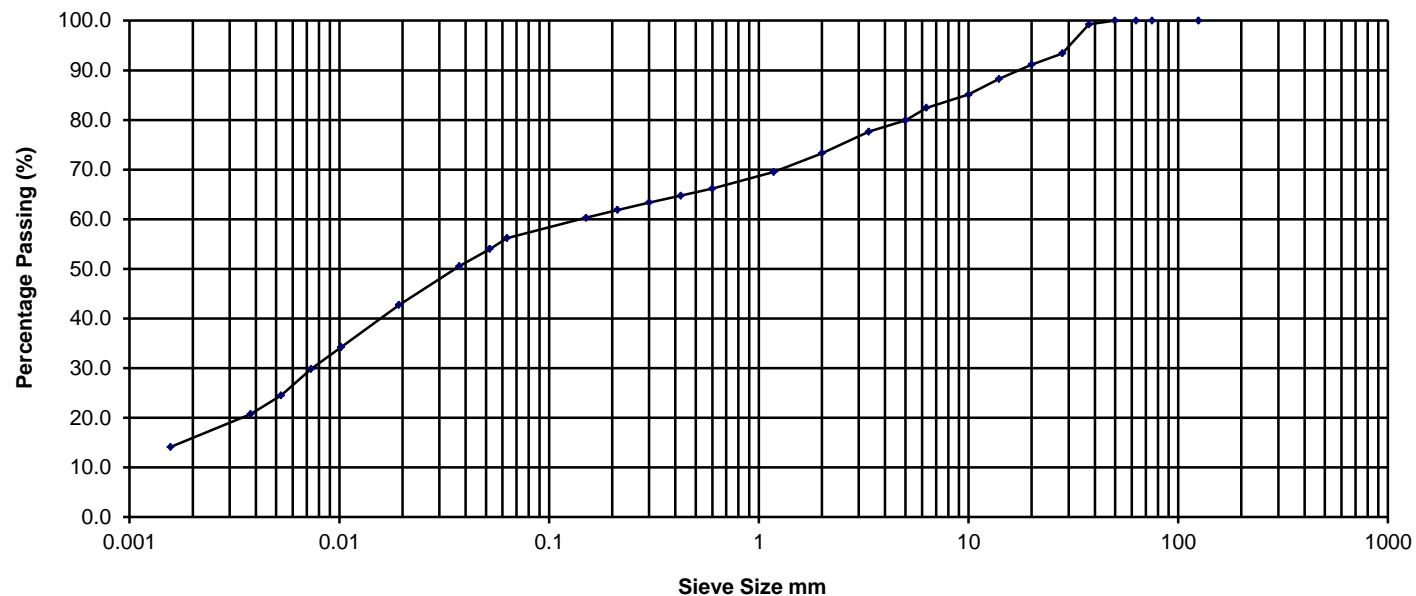NM**TL****Ltd****Determination of Particle Size Distribution****BS 1377 : 1990 : Part 2 : Clauses 9.2 & 9.5**

Percentage Particle Size

Clay	Fine	Medium	Coarse	Fine	Medium	Coarse	Fine	Medium	Coarse	Cobbles	Boulder
	Silt			Sand			Gravel				
14.1	42.1			17.1			26.7			0.0	0.0

Sample Description Brown slightly sandy slightly gravelly silty CLAY.

Project No. NMTL 3243

BH/TP No. TP08

Project Whitehall, Swords

GII Project ID-9225-11-19

Sample No. B

Operator

Tzr

Checked

Nc

Approved

Bc

Date sample tested

04/08/2020

Depth


0.70m

NMTL Ltd

Sieve	%
Size mm	Passing
125.000	100.0
75.000	100.0
63.000	100.0
50.000	100.0
37.500	97.6
28.000	94.4
20.000	90.1
14.000	88.7
10.000	84.4
6.300	79.8
5.000	77.4
3.350	74.1
2.000	68.6
1.180	63.8
0.600	58.0
0.425	55.1
0.300	52.1
0.212	48.8
0.150	45.4
0.063	36.7

Determination of Particle Size Distribution

BS 1377 : 1990 : Part 2 : Clauses 9.2 & 9.5

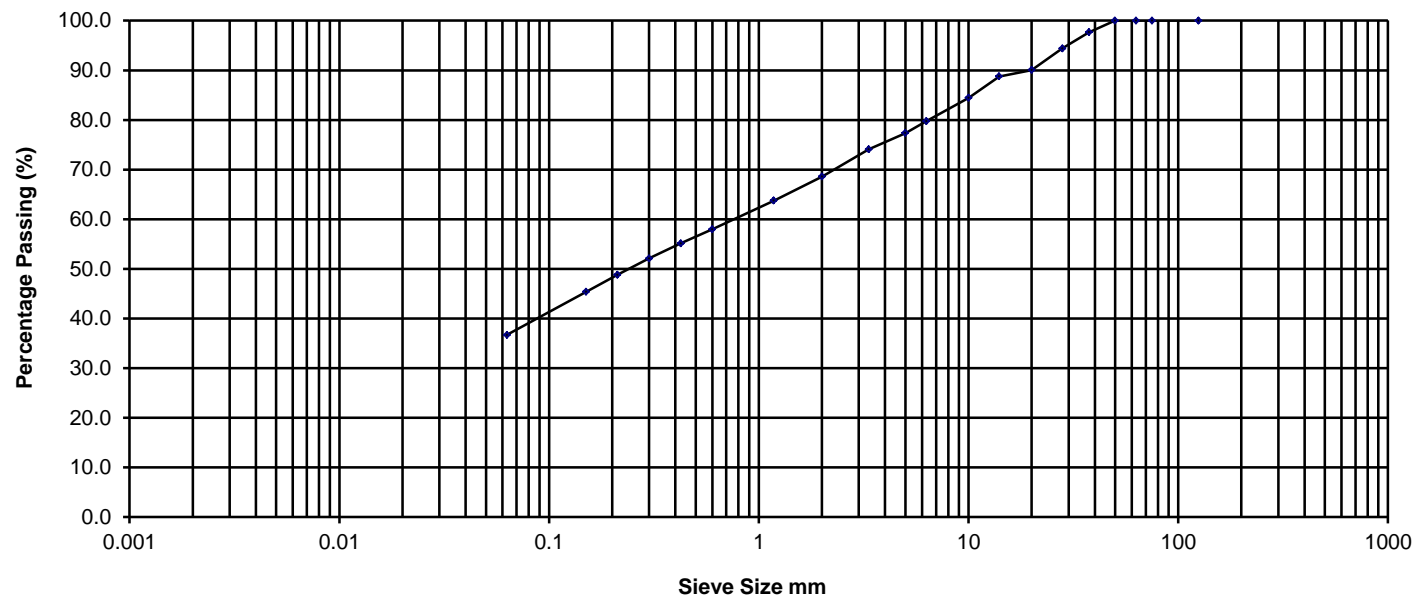

Percentage Particle Size

Clay	Fine	Medium	Coarse	Fine	Medium	Coarse	Fine	Medium	Coarse	Cobbles	Boulder
	Silt			Sand			Gravel				
	36.7			31.9			31.4			0.0	0.0

Sample Description Light brown slightly gravelly slightly sandy SILT/CLAY.

Project No. NMTL 3243

BH/TP No. TP10

Project Whitehall, Swords

GII Project ID-9225-11-19


Sample No. B

NMTL Ltd

Operator	Tzr	Checked	Nc	Approved	Bc	Date sample tested	07/08/2020	Depth	0.50m
----------	-----	---------	----	----------	----	--------------------	------------	-------	-------

NMTL Ltd

Sieve Size mm	% Passing
125.000	100.0
75.000	100.0
63.000	100.0
50.000	100.0
37.500	100.0
28.000	97.0
20.000	93.8
14.000	90.4
10.000	86.5
6.300	83.1
5.000	81.0
3.350	78.9
2.000	75.4
1.180	72.1
0.600	67.6
0.425	65.2
0.300	62.5
0.212	59.4
0.150	56.2
0.063	47.5
0.053	44.6
0.038	41.0
0.019	35.0
0.010	28.3
0.007	24.9
0.005	22.3
0.004	19.5
0.002	13.6

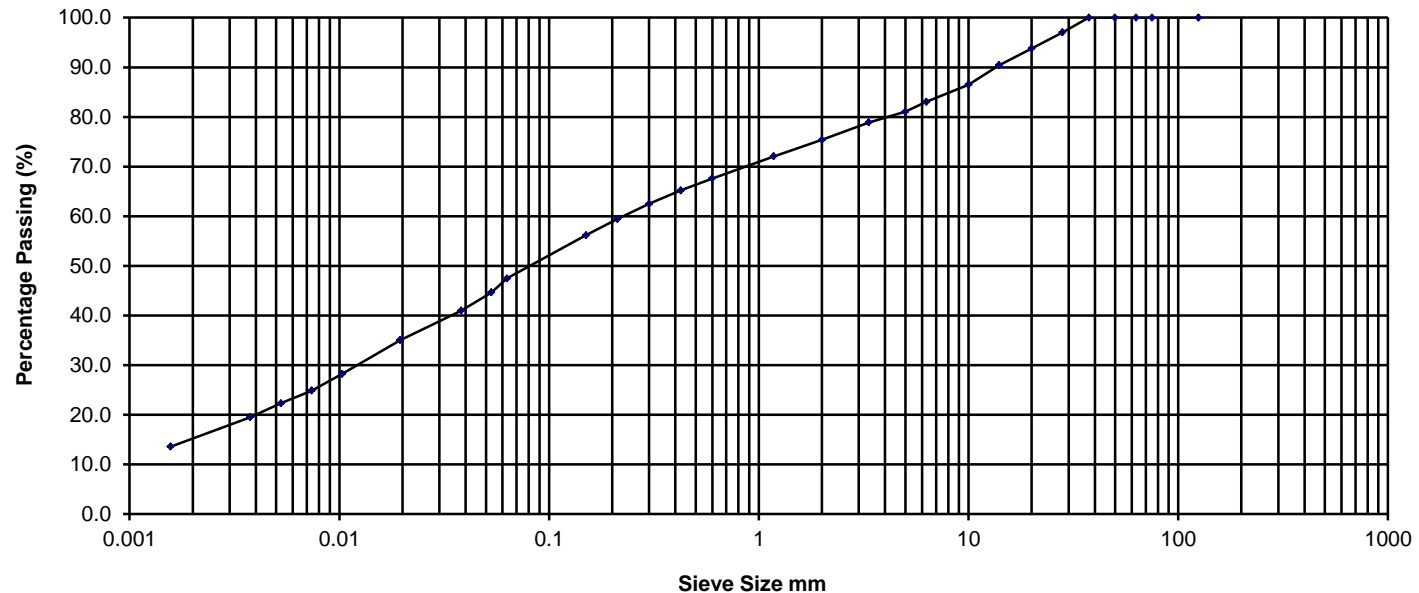NM**TL****Ltd****Determination of Particle Size Distribution****BS 1377 : 1990 : Part 2 : Clauses 9.2 & 9.5**

Percentage Particle Size

Clay	Fine	Medium	Coarse	Fine	Medium	Coarse	Fine	Medium	Coarse	Cobbles	Boulder
	Silt			Sand			Gravel				
13.6	33.9			27.9			24.6			0.0	0.0

Sample Description Light brown, orange grey slightly gravelly silty CLAY.

Project No. NMTL 3243

BH/TP No. BH01

Project Whitehall, Swords

GII Project ID-9225-11-19

Sample No. B

Operator

Tzr

Checked

Nc

Approved

Bc

Date sample tested


01/08/2020

Depth

2.0m

NMTL Ltd

Sieve	%
Size mm	Passing
125.000	100.0
75.000	100.0
63.000	100.0
50.000	100.0
37.500	100.0
28.000	100.0
20.000	98.3
14.000	97.8
10.000	96.4
6.300	91.7
5.000	87.4
3.350	82.1
2.000	74.3
1.180	67.5
0.600	61.3
0.425	58.8
0.300	56.5
0.212	54.4
0.150	52.4
0.063	48.2
0.053	46.1
0.038	43.5
0.019	36.7
0.010	31.2
0.007	27.3
0.005	25.0
0.004	22.0
0.002	16.2

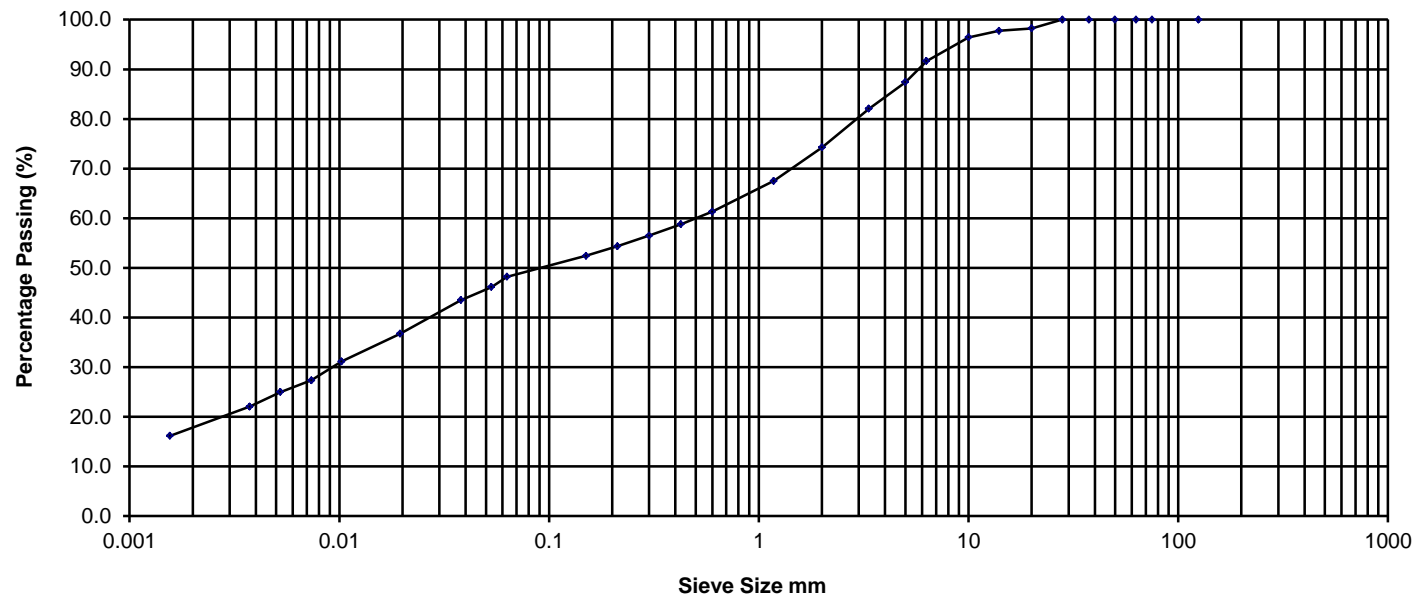NM**TL****Ltd****Determination of Particle Size Distribution****BS 1377 : 1990 : Part 2 : Clauses 9.2 & 9.5**

Percentage Particle Size

Clay	Fine	Medium	Coarse	Fine	Medium	Coarse	Fine	Medium	Coarse	Cobbles	Boulder
	Silt			Sand			Gravel				
16.2	32.0			26.1			25.7			0.0	0.0

Sample Description Grey slightly gravelly slightly sandy silty CLAY.

Project No. NMTL 3243

BH/TP No. BH02

Project Whitehall, Swords

GII Project ID-9225-11-19

Sample No. B

Operator

Tzr

Checked

Nc

Approved

Bc

Date sample tested


01/08/2020

Depth

6.0m

NMTL Ltd

Sieve Size mm	% Passing
125.000	100.0
75.000	100.0
63.000	100.0
50.000	100.0
37.500	100.0
28.000	94.6
20.000	91.1
14.000	91.1
10.000	86.0
6.300	82.0
5.000	79.1
3.350	76.4
2.000	72.1
1.180	67.1
0.600	61.6
0.425	58.9
0.300	56.2
0.212	53.5
0.150	50.9
0.063	44.8
0.052	42.5
0.037	39.5
0.019	33.6
0.010	27.4
0.007	24.9
0.005	21.9
0.004	18.9
0.002	12.9

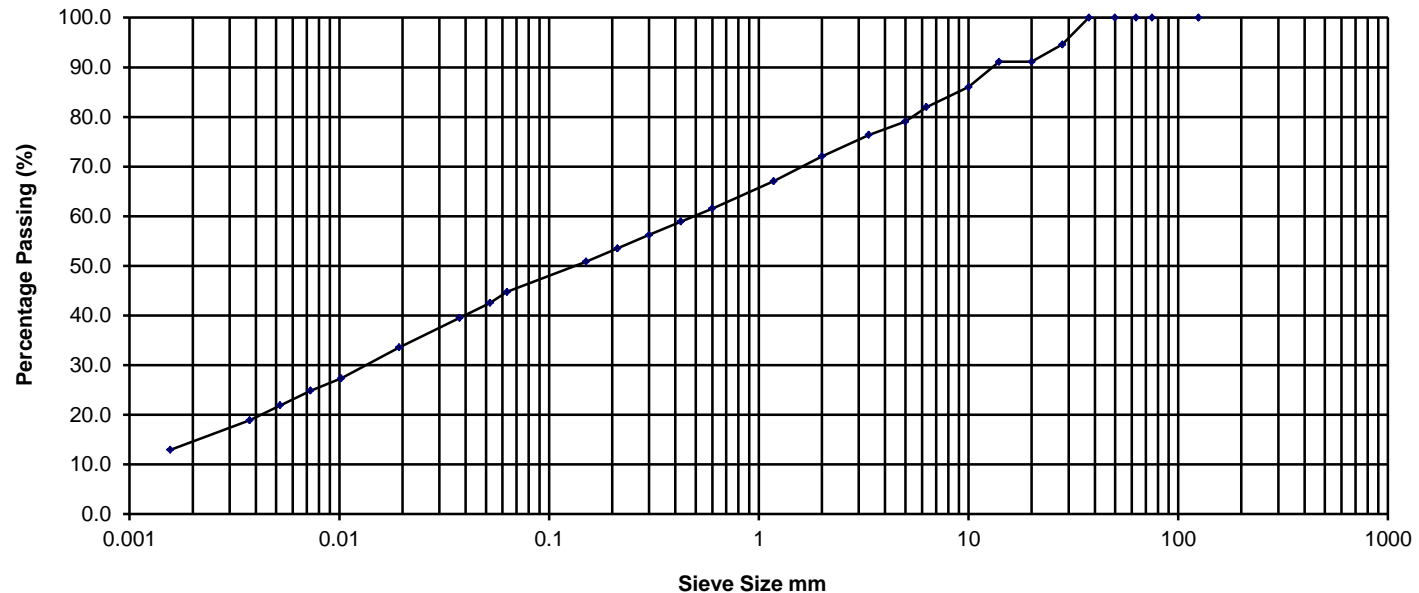NM**TL****Ltd****Determination of Particle Size Distribution****BS 1377 : 1990 : Part 2 : Clauses 9.2 & 9.5**

Percentage Particle Size

Clay	Fine	Medium	Coarse	Fine	Medium	Coarse	Fine	Medium	Coarse	Cobbles	Boulder
	Silt			Sand			Gravel				
12.9	31.8			27.3			27.9			0.0	0.0

Sample Description Light brown slightly sandy slightly gravelly silty CLAY.

Project No. NMTL 3243

BH/TP No. BH03

Project Whitehall, Swords

GII Project ID-9225-11-19

Sample No. B

Operator

Tzr

Checked

Nc

Approved

Bc

Date sample tested

01/08/2020

Depth

2.0m


NMTL Ltd

Sieve	%
Size mm	Passing
125.000	100.0
75.000	100.0
63.000	100.0
50.000	96.4
37.500	91.5
28.000	89.5
20.000	88.1
14.000	81.3
10.000	77.5
6.300	71.9
5.000	68.8
3.350	66.5
2.000	62.1
1.180	58.0
0.600	53.8
0.425	51.7
0.300	49.6
0.212	47.3
0.150	44.9
0.063	38.9
0.052	37.0
0.037	33.6
0.019	27.7
0.010	22.8
0.007	19.9
0.005	17.7
0.004	15.6
0.002	10.1

NMTL Ltd

Determination of Particle Size Distribution


BS 1377 : 1990 : Part 2 : Clauses 9.2 & 9.5

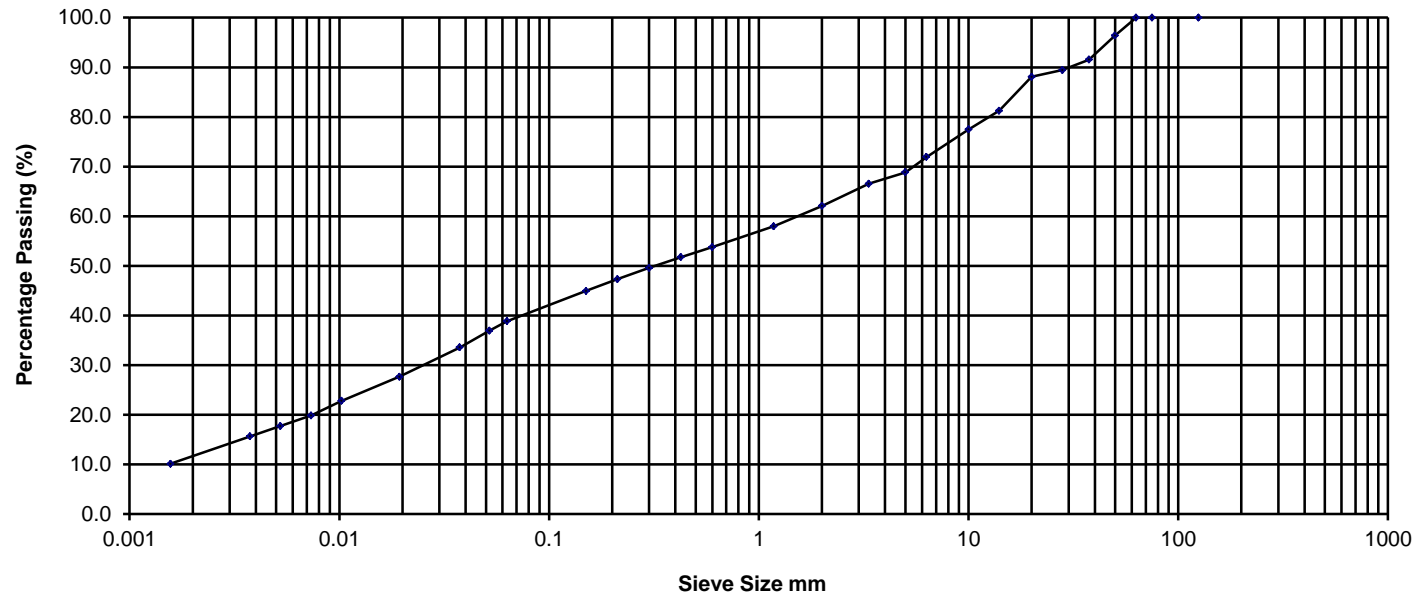

Percentage Particle Size											
Clay	Fine	Medium	Coarse	Fine	Medium	Coarse	Fine	Medium	Coarse	Cobbles	Boulder
	Silt			Sand			Gravel				
10.1	28.7			23.2			37.9			0.0	0.0

NMTL Ltd

Sieve Size mm	% Passing
125.000	100.0
75.000	100.0
63.000	100.0
50.000	100.0
37.500	96.6
28.000	93.5
20.000	91.1
14.000	87.2
10.000	84.8
6.300	80.6
5.000	78.9
3.350	75.6
2.000	70.5
1.180	65.7
0.600	60.3
0.425	57.8
0.300	55.3
0.212	52.7
0.150	50.1
0.063	43.3
0.053	40.7
0.038	37.4
0.019	32.3
0.010	26.9
0.007	23.8
0.005	21.2
0.004	17.9
0.002	12.3

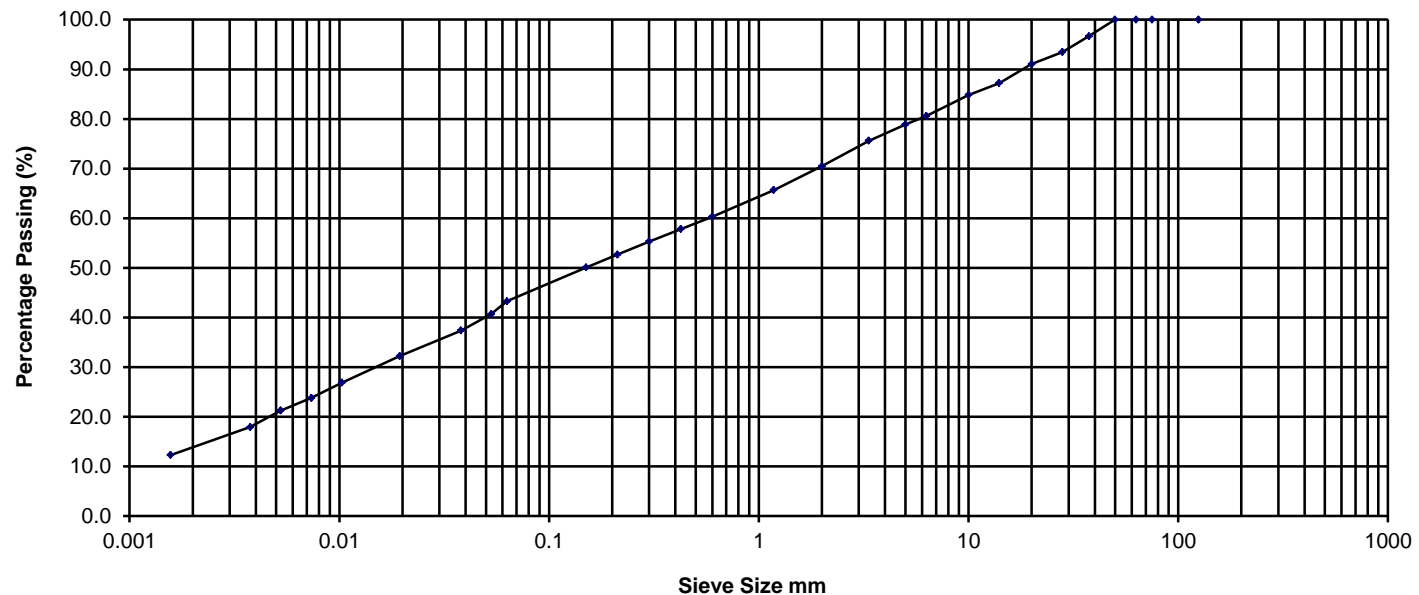NM**TL****Ltd****Determination of Particle Size Distribution****BS 1377 : 1990 : Part 2 : Clauses 9.2 & 9.5**

Percentage Particle Size

Clay	Fine	Medium	Coarse	Fine	Medium	Coarse	Fine	Medium	Coarse	Cobbles	Boulder
	Silt			Sand			Gravel				
12.3	31.0			27.2			29.5			0.0	0.0

Sample Description Light brown/orange slightly sandy slightly gravelly silty CLAY.

Project No.

NMTL 3243

BH/TP No.

BH05

Project

Whitehall, Swords

GII Project ID-9225-11-19

Sample No.

B

Operator

Tzr

Checked

Nc

Approved

Bc

Date sample tested

01/08/2020

Depth

2.0m


NMTL Ltd

Sieve	%
Size mm	Passing
125.000	100.0
75.000	100.0
63.000	100.0
50.000	100.0
37.500	87.9
28.000	86.3
20.000	83.9
14.000	81.4
10.000	78.5
6.300	74.6
5.000	70.7
3.350	67.9
2.000	62.7
1.180	57.7
0.600	52.8
0.425	50.7
0.300	48.7
0.212	46.6
0.150	44.6
0.063	39.3
0.054	37.6
0.038	34.6
0.020	29.4
0.010	25.6
0.007	22.4
0.005	20.9
0.004	18.2
0.002	12.7

NMTL
TL
Ltd

Determination of Particle Size Distribution

BS 1377 : 1990 : Part 2 : Clauses 9.2 & 9.5

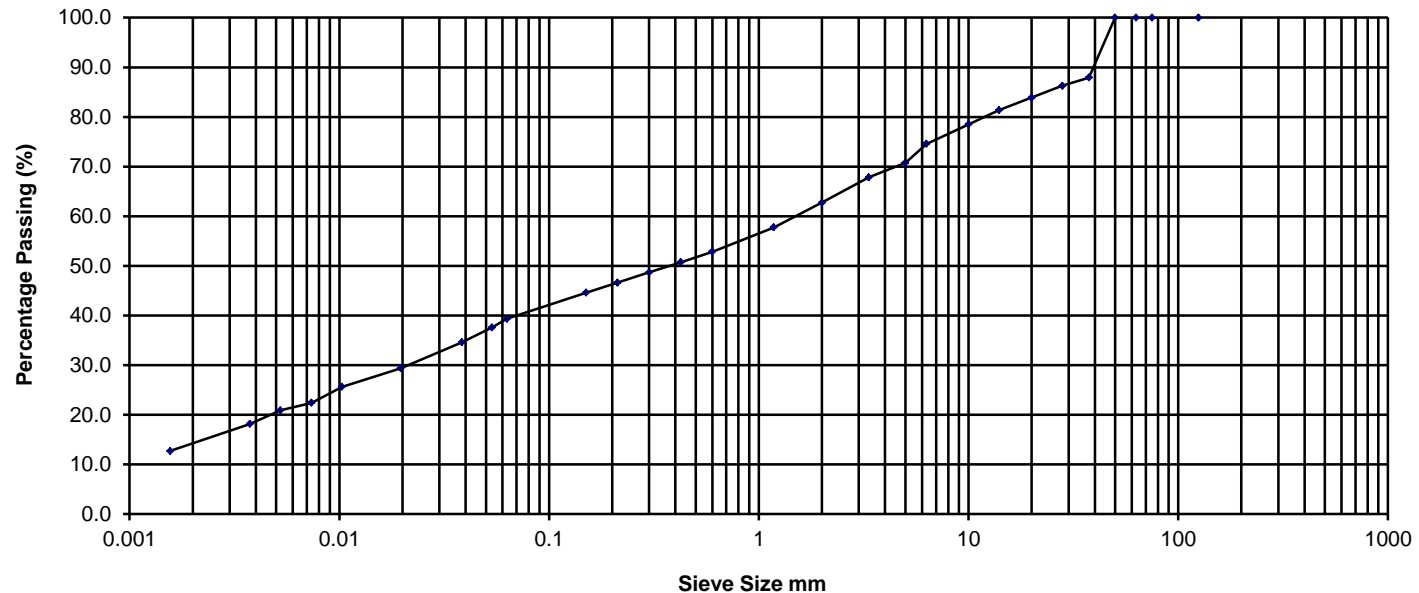

Percentage Particle Size

Clay	Fine	Medium	Coarse	Fine	Medium	Coarse	Fine	Medium	Coarse	Cobbles	Boulder
	Silt			Sand			Gravel				
12.7	26.6			23.4			37.3			0.0	0.0

Sample Description Grey slightly sandy gravelly silty CLAY.

Project No. NMTL 3243

BH/TP No. BH05

Project Whitehall, Swords

GII Project ID-9225-11-19

Sample No. B

Operator Tzr Checked Nc Approved Bc Date sample tested 01/08/2020 Depth 4.0m


NMTL Ltd

Sieve	%
Size mm	Passing
125.000	100.0
75.000	100.0
63.000	100.0
50.000	100.0
37.500	100.0
28.000	97.8
20.000	94.7
14.000	92.6
10.000	89.5
6.300	85.6
5.000	82.7
3.350	79.5
2.000	73.8
1.180	68.5
0.600	62.4
0.425	59.5
0.300	56.7
0.212	53.8
0.150	51.1
0.063	44.8
0.053	42.6
0.038	39.1
0.020	32.5
0.010	27.0
0.007	24.3
0.005	22.1
0.004	19.7
0.002	13.4

NMTL Ltd

Determination of Particle Size Distribution

BS 1377 : 1990 : Part 2 : Clauses 9.2 & 9.5

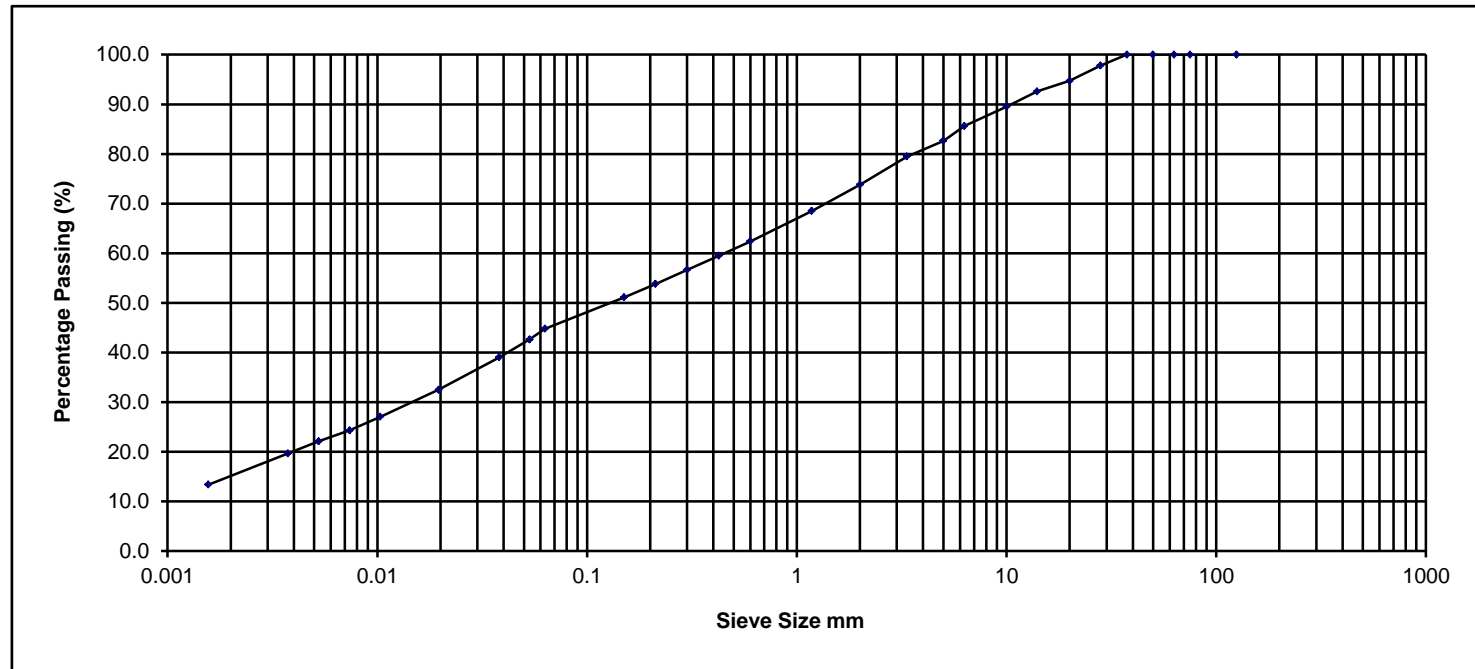

Percentage Particle Size											
Clay	Fine	Medium	Coarse	Fine	Medium	Coarse	Fine	Medium	Coarse	Cobbles	Boulder
	Silt			Sand			Gravel				
13.4	31.4			29.0			26.2			0.0	0.0

Sample Description Grey slightly gravelly slightly sandy silty CLAY.

Project No. NMTL 3243

BH/TP No. BH06

Project Whitehall, Swords


GII Project ID-9225-11-19

Sample No. B

Operator	Tzr	Checked	Nc	Approved	Bc	Date sample tested	01/08/2020	Depth	7.0m
----------	-----	---------	----	----------	----	--------------------	------------	-------	------

NMTL Ltd

Sieve Size mm	% Passing
125.000	100.0
75.000	100.0
63.000	100.0
50.000	100.0
37.500	100.0
28.000	95.7
20.000	93.4
14.000	88.2
10.000	86.1
6.300	82.0
5.000	78.1
3.350	75.1
2.000	70.3
1.180	65.7
0.600	60.0
0.425	57.2
0.300	54.3
0.212	51.6
0.150	49.0
0.063	43.7
0.054	42.0
0.038	38.7
0.020	33.0
0.010	27.9
0.007	24.6
0.005	22.3
0.004	19.2
0.002	13.0

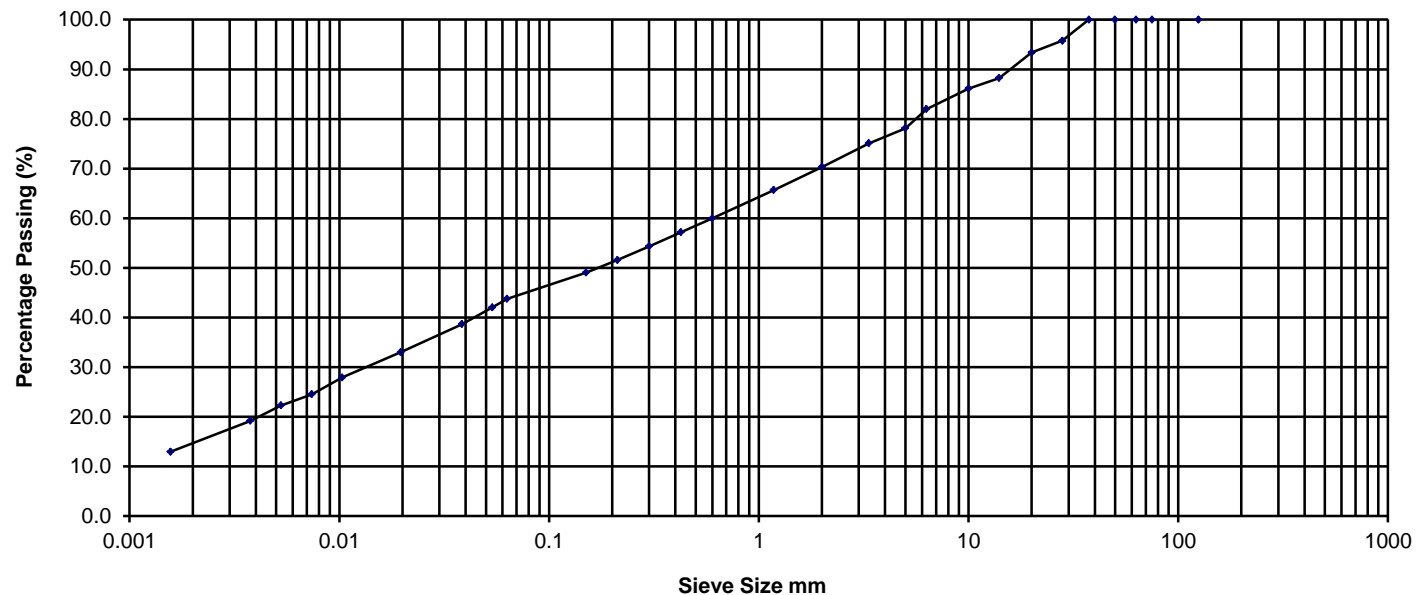NM**TL****Ltd****Determination of Particle Size Distribution****BS 1377 : 1990 : Part 2 : Clauses 9.2 & 9.5**

Percentage Particle Size

Clay	Fine	Medium	Coarse	Fine	Medium	Coarse	Fine	Medium	Coarse	Cobbles	Boulder
	Silt			Sand			Gravel				
13.0	30.8			26.6			29.7			0.0	0.0

Sample Description Grey slightly sandy slightly gravelly silty CLAY.

Project No. NMTL 3243

BH/TP No. BH07

Project Whitehall, Swords

GII Project ID-9225-11-19

Sample No. B

Operator

Tzr

Checked

Nc

Approved

Bc

Date sample tested

01/08/2020

Depth

7.0m


NMTL Ltd

Sieve Size mm	% Passing
125.000	100.0
75.000	100.0
63.000	100.0
50.000	100.0
37.500	100.0
28.000	100.0
20.000	98.8
14.000	97.4
10.000	96.1
6.300	93.7
5.000	92.7
3.350	91.1
2.000	86.3
1.180	81.6
0.600	78.3
0.425	76.9
0.300	75.3
0.212	73.4
0.150	71.2
0.063	64.8
0.051	61.5
0.037	56.5
0.019	47.9
0.010	39.2
0.007	35.6
0.005	31.6
0.004	27.9
0.002	19.6

NMTL
TL
Ltd

Determination of Particle Size Distribution

BS 1377 : 1990 : Part 2 : Clauses 9.2 & 9.5

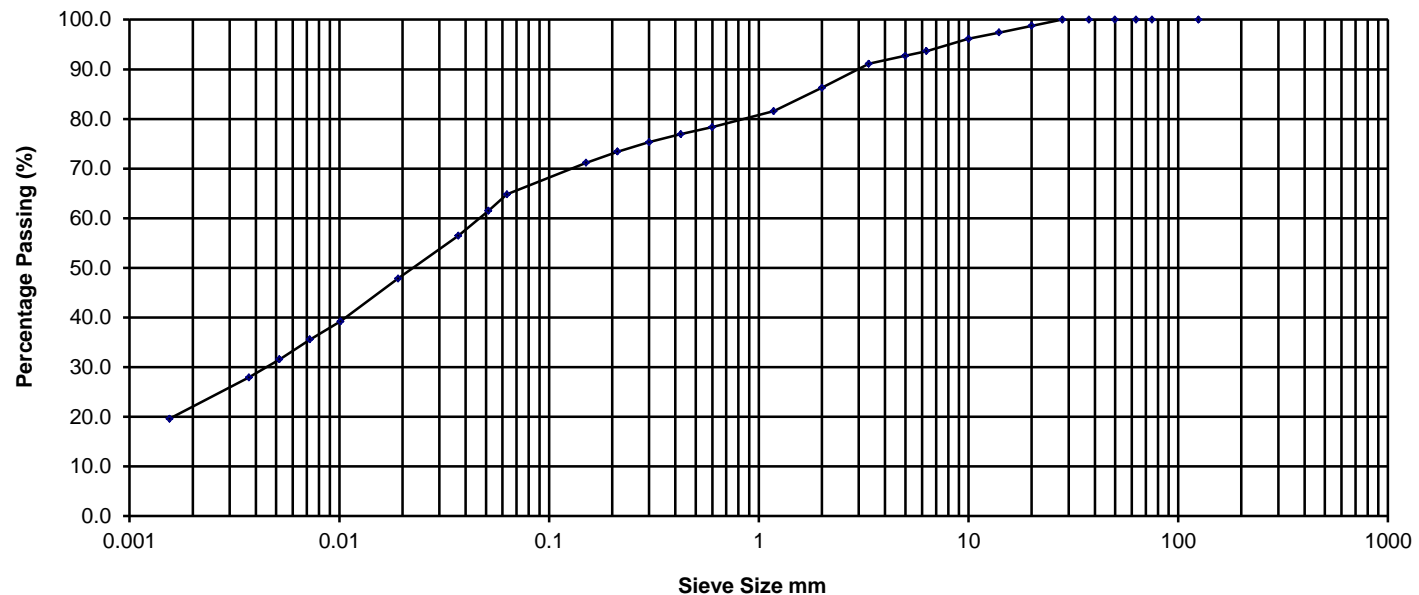

Percentage Particle Size

Clay	Fine	Medium	Coarse	Fine	Medium	Coarse	Fine	Medium	Coarse	Cobbles	Boulder
	Silt			Sand			Gravel				
19.6	45.2			21.5			13.7			0.0	0.0

Sample Description Light brown slightly gravelly slightly sandy silty CLAY.

Project No. NMTL 3243

BH/TP No. BH08

Project Whitehall, Swords

GII Project ID-9225-11-19

Sample No. B

Operator

Tzr

Checked

Nc

Approved

Bc

Date sample tested


01/08/2020

Depth

2.0m

NMTL Ltd

Sieve Size mm	% Passing
125.000	100.0
75.000	100.0
63.000	100.0
50.000	100.0
37.500	100.0
28.000	98.6
20.000	97.1
14.000	93.1
10.000	89.0
6.300	84.0
5.000	78.3
3.350	74.0
2.000	67.3
1.180	61.9
0.600	56.4
0.425	53.9
0.300	51.6
0.212	49.4
0.150	47.3
0.063	42.2
0.053	40.1
0.038	37.8
0.019	32.3
0.010	27.9
0.007	25.1
0.005	22.5
0.004	19.9
0.002	15.0

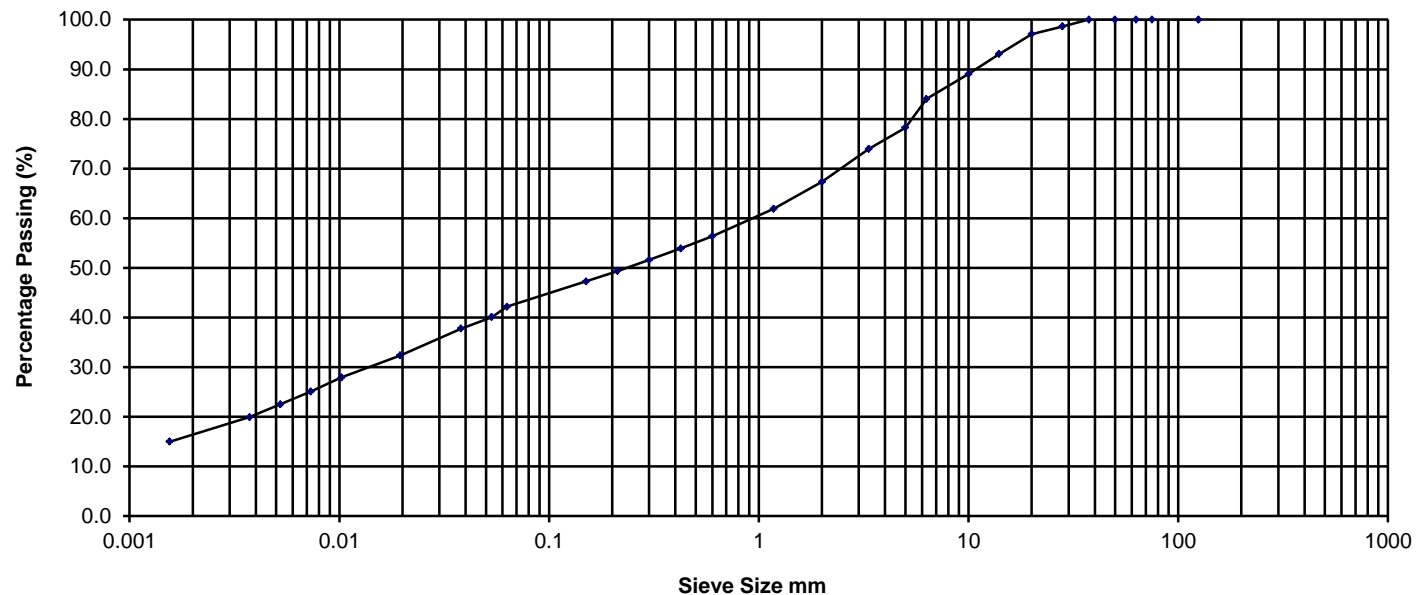NM**TL****Ltd****Determination of Particle Size Distribution****BS 1377 : 1990 : Part 2 : Clauses 9.2 & 9.5**

Percentage Particle Size

Clay	Fine	Medium	Coarse	Fine	Medium	Coarse	Fine	Medium	Coarse	Cobbles	Boulder
	Silt			Sand			Gravel				
15.0	27.2			25.2			32.7			0.0	0.0

Sample Description Grey slightly sandy slightly gravelly silty CLAY.

Project No. NMTL 3243

BH/TP No. BH09

Project Whitehall, Swords

GII Project ID-9225-11-19

Sample No. B

Operator

Tzr

Checked

Nc

Approved

Bc

Date sample tested


01/08/2020

Depth

3.0m

NMTL Ltd

Sieve	%
Size mm	Passing
125.000	100.0
75.000	100.0
63.000	100.0
50.000	100.0
37.500	100.0
28.000	97.9
20.000	95.4
14.000	95.4
10.000	90.4
6.300	85.4
5.000	81.8
3.350	78.5
2.000	72.6
1.180	67.5
0.600	61.9
0.425	59.2
0.300	56.5
0.212	53.7
0.150	51.1
0.063	44.6
0.053	42.4
0.038	39.7
0.019	34.3
0.010	29.2
0.007	26.2
0.005	23.8
0.004	21.6
0.002	15.7

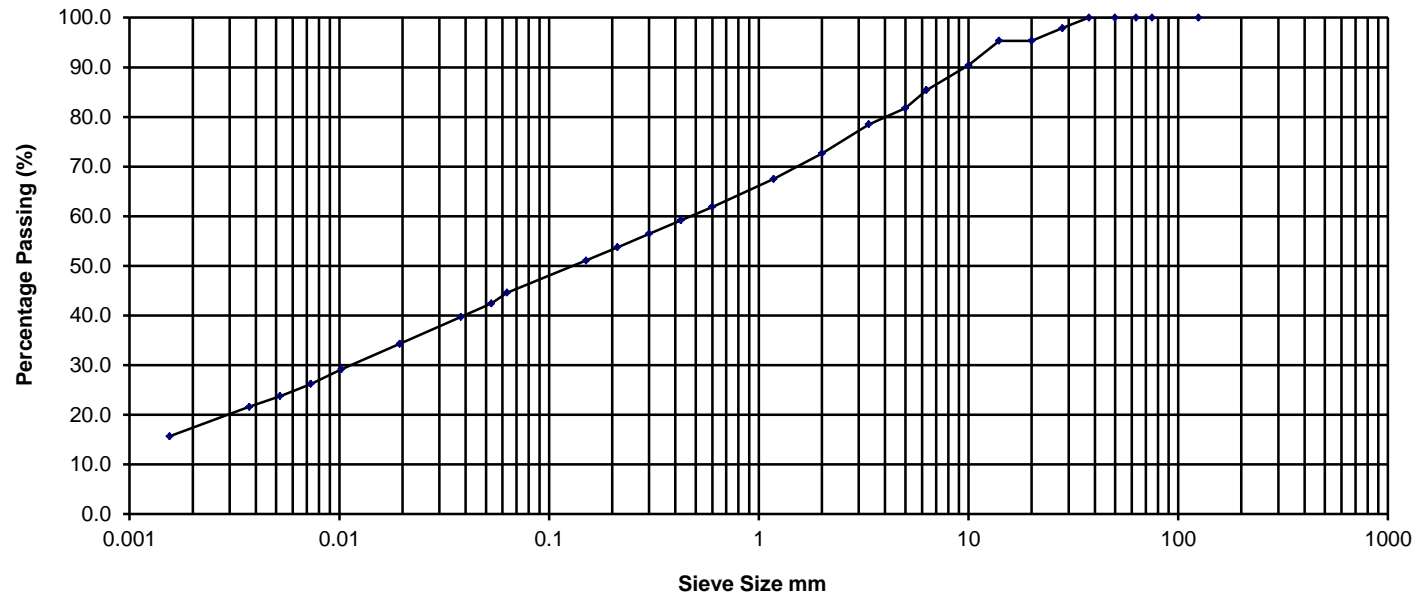NM**TL****Ltd****Determination of Particle Size Distribution****BS 1377 : 1990 : Part 2 : Clauses 9.2 & 9.5**

Percentage Particle Size

Clay	Fine	Medium	Coarse	Fine	Medium	Coarse	Fine	Medium	Coarse	Cobbles	Boulder
	Silt			Sand			Gravel				
15.7	28.9			28.1			27.4			0.0	0.0

Sample Description Grey slightly gravelly slightly sandy silty CLAY.

Project No.

NMTL 3243

BH/TP No.

BH09

Project

Whitehall, Swords

GII Project ID-9225-11-19

Sample No.

B

Operator

Tzr

Checked

Nc

Approved

Bc

Date sample tested


01/08/2020

Depth

5.0m

NMTL Ltd

Sieve	%
Size mm	Passing
125.000	100.0
75.000	100.0
63.000	100.0
50.000	100.0
37.500	96.8
28.000	94.6
20.000	90.4
14.000	89.6
10.000	87.0
6.300	82.3
5.000	79.1
3.350	75.8
2.000	69.4
1.180	63.9
0.600	58.3
0.425	55.8
0.300	53.4
0.212	51.0
0.150	48.7
0.063	42.9
0.053	40.7
0.038	37.8
0.019	32.4
0.010	27.0
0.007	24.6
0.005	22.2
0.004	19.7
0.002	14.9

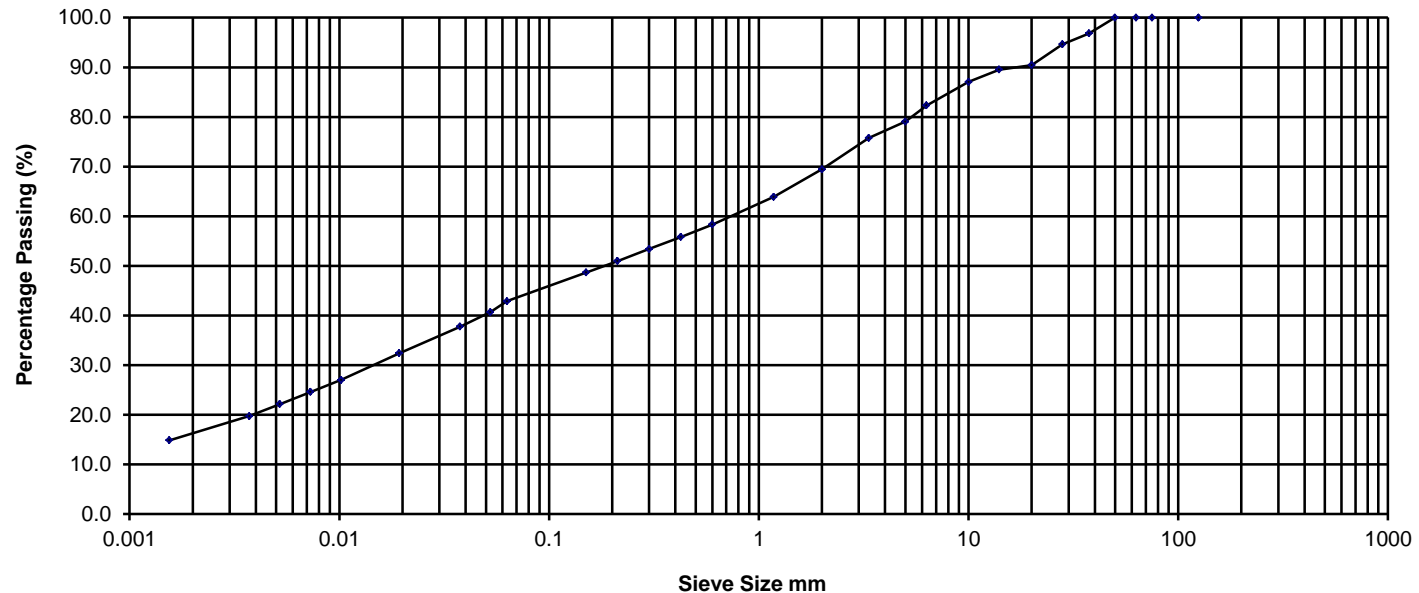NM**TL****Ltd****Determination of Particle Size Distribution****BS 1377 : 1990 : Part 2 : Clauses 9.2 & 9.5**

Percentage Particle Size

Clay	Fine	Medium	Coarse	Fine	Medium	Coarse	Fine	Medium	Coarse	Cobbles	Boulder
	Silt			Sand			Gravel				
14.9	28.0			26.6			30.6			0.0	0.0

Sample Description Grey slightly sandy slightly gravelly silty CLAY.

Project No. NMTL 3243

BH/TP No. BH10

Project Whitehall, Swords

GII Project ID-9225-11-19

Sample No. B

Operator

Tzr

Checked

Nc

Approved

Bc

Date sample tested

01/08/2020

Depth


3.0m

NMTL Ltd

Sieve	%
Size mm	Passing
125.000	100.0
75.000	100.0
63.000	100.0
50.000	100.0
37.500	93.2
28.000	92.2
20.000	91.4
14.000	86.6
10.000	84.0
6.300	80.0
5.000	76.9
3.350	73.5
2.000	69.1
1.180	65.4
0.600	61.6
0.425	59.6
0.300	57.6
0.212	55.3
0.150	52.7
0.063	46.2

Determination of Particle Size Distribution

BS 1377 : 1990 : Part 2 : Clauses 9.2 & 9.5

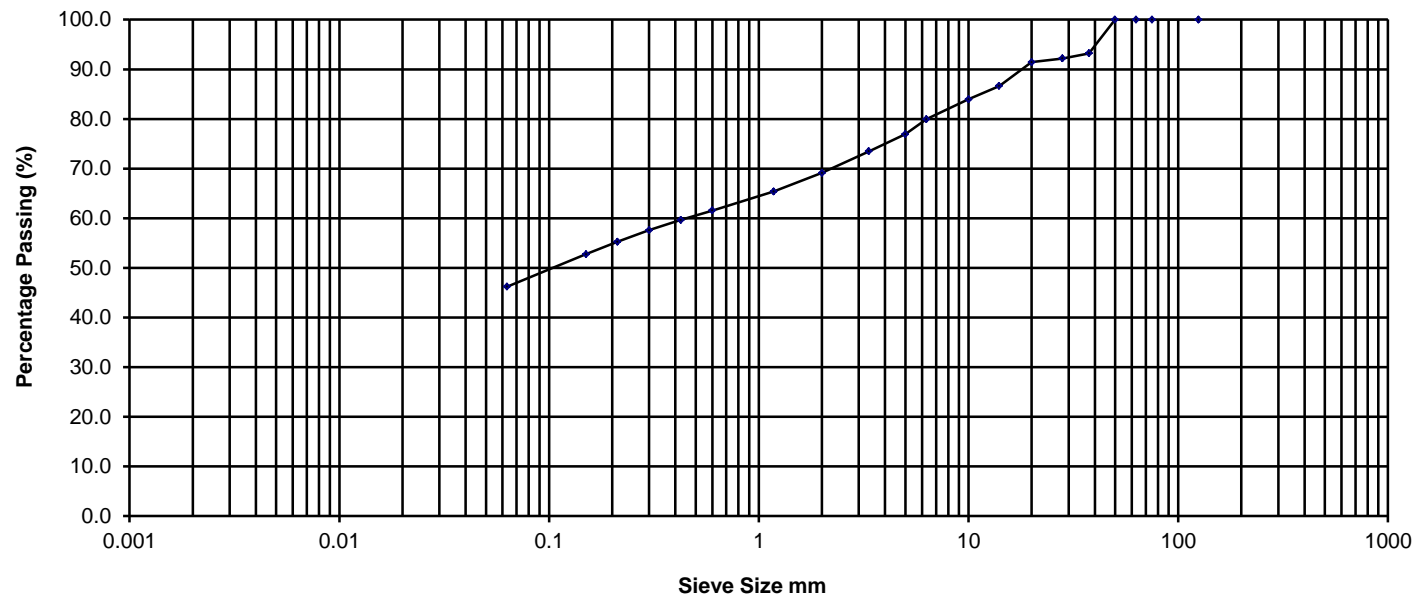

Percentage Particle Size

Clay	Fine	Medium	Coarse	Fine	Medium	Coarse	Fine	Medium	Coarse	Cobbles	Boulder
	Silt			Sand			Gravel				
	46.2			22.9			30.9			0.0	0.0

Sample Description Grey/brown slightly sandy slightly gravelly silty CLAY.

Project No. NMTL 3243

BH/TP No. BH04

Project Whitehall, Swords

GII Project ID-9225-11-19

Sample No. C

NM

TL

Ltd


Operator	Tzr	Checked	Nc	Approved	Bc	Date sample tested	11/08/2020	Depth	10.5-10.90m
----------	-----	---------	----	----------	----	--------------------	------------	-------	-------------

NMTL Ltd

Sieve	%
Size mm	Passing
125.000	100.0
75.000	100.0
63.000	100.0
50.000	100.0
37.500	94.7
28.000	93.9
20.000	91.6
14.000	82.4
10.000	78.6
6.300	73.5
5.000	68.9
3.350	65.7
2.000	61.2
1.180	57.3
0.600	53.4
0.425	51.4
0.300	49.3
0.212	46.9
0.150	44.3
0.063	37.8

Determination of Particle Size Distribution

BS 1377 : 1990 : Part 2 : Clauses 9.2 & 9.5

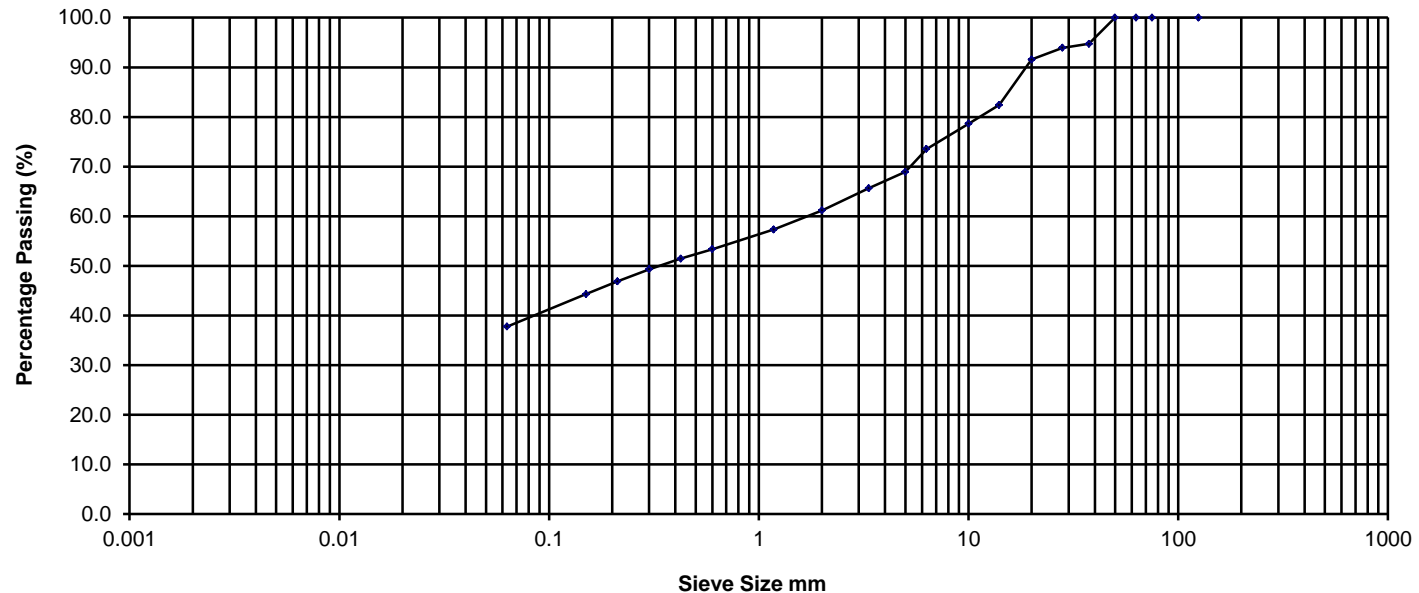

Percentage Particle Size

Clay	Fine	Medium	Coarse	Fine	Medium	Coarse	Fine	Medium	Coarse	Cobbles	Boulder
	Silt			Sand			Gravel			0.0	0.0
	37.8			23.4			38.8				

Sample Description Grey/brown slightly sandy gravelly silty CLAY.

Project No. NMTL 3243

BH/TP No. BH05

Project Whitehall, Swords

GII Project ID-9225-11-19

Sample No. C

NMTL Ltd


Operator	Tzr	Checked	Nc	Approved	Bc	Date sample tested	11/08/2020	Depth	8.30-8.70m
----------	-----	---------	----	----------	----	--------------------	------------	-------	------------

NMTL Ltd

Sieve	%
Size mm	Passing
125.000	100.0
75.000	100.0
63.000	100.0
50.000	100.0
37.500	100.0
28.000	97.2
20.000	95.2
14.000	90.9
10.000	87.8
6.300	84.4
5.000	82.8
3.350	80.0
2.000	76.0
1.180	72.2
0.600	68.2
0.425	66.2
0.300	63.7
0.212	60.5
0.150	56.8
0.063	47.4

Determination of Particle Size Distribution

BS 1377 : 1990 : Part 2 : Clauses 9.2 & 9.5

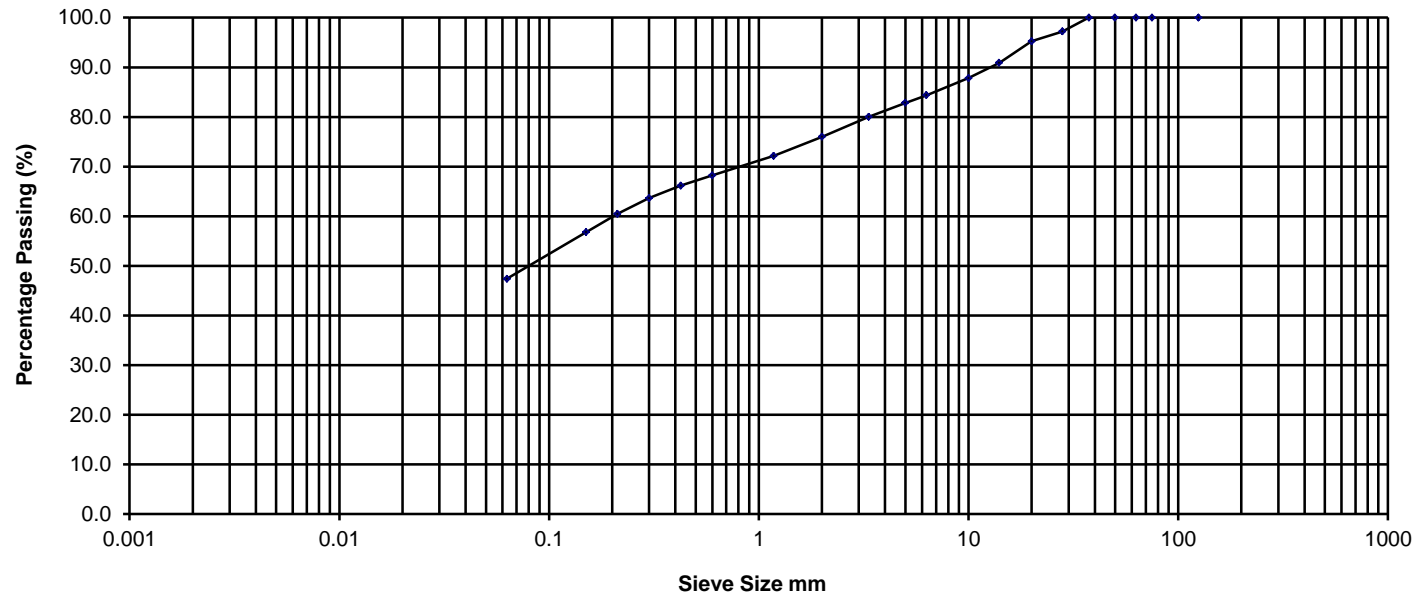

Percentage Particle Size

Clay	Fine	Medium	Coarse	Fine	Medium	Coarse	Fine	Medium	Coarse	Cobbles	Boulder
	Silt			Sand			Gravel			0.0	0.0
	47.4			28.6			24.0				

Sample Description Grey/brown slightly gravelly slightly sandy silty CLAY.

Project No. NMTL 3243

BH/TP No. BH05

Project Whitehall, Swords

GII Project ID-9225-11-19

Sample No. C

NM

TL

Ltd


Operator	Tzr	Checked	Nc	Approved	Bc	Date sample tested	11/08/2020	Depth	14.60-15.0m
----------	-----	---------	----	----------	----	--------------------	------------	-------	-------------

NMTL Ltd

Sieve	%
Size mm	Passing
125.000	100.0
75.000	100.0
63.000	100.0
50.000	89.5
37.500	85.4
28.000	82.3
20.000	79.9
14.000	74.0
10.000	71.8
6.300	67.1
5.000	63.4
3.350	61.2
2.000	57.3
1.180	54.2
0.600	50.7
0.425	48.9
0.300	47.0
0.212	44.7
0.150	42.4
0.063	37.0

Determination of Particle Size Distribution

BS 1377 : 1990 : Part 2 : Clauses 9.2 & 9.5

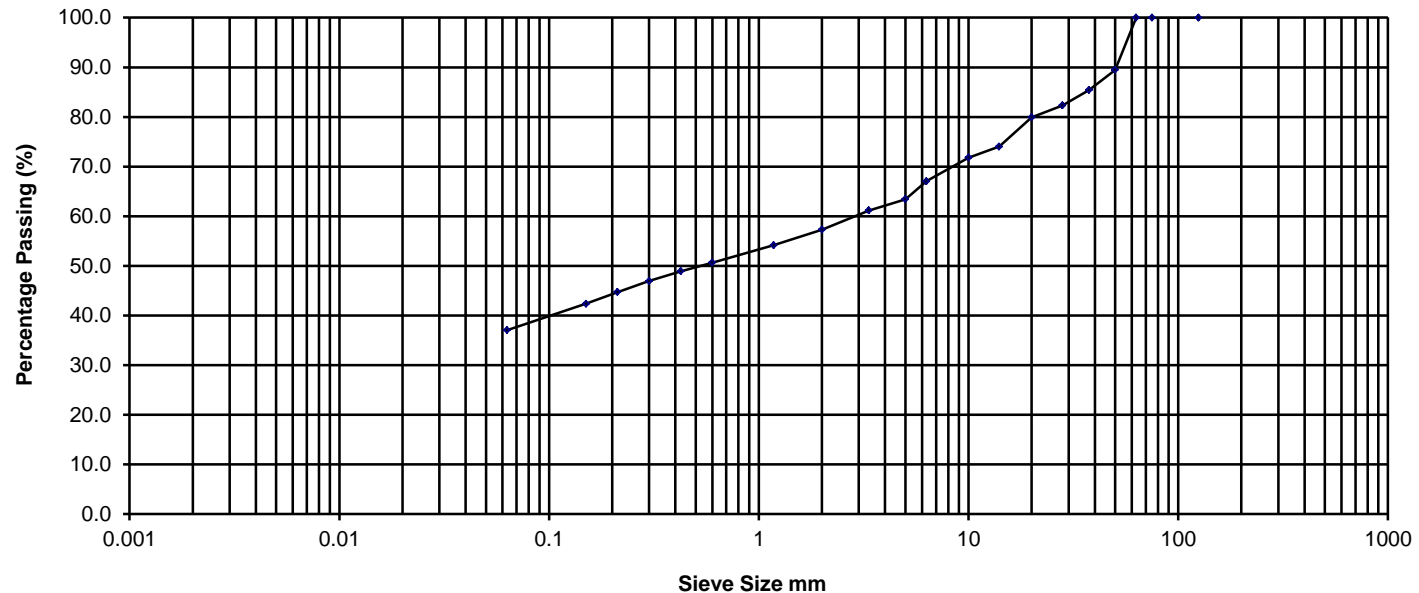

Percentage Particle Size

Clay	Fine	Medium	Coarse	Fine	Medium	Coarse	Fine	Medium	Coarse	Cobbles	Boulder
	Silt			Sand			Gravel			0.0	0.0
	37.0			20.2			42.7				

Sample Description Grey/brown slightly sandy gravelly silty CLAY.

Project No. NMTL 3243

BH/TP No. BH09

Project Whitehall, Swords

GII Project ID-9225-11-19

Sample No. C

NMTL Ltd


Operator	Tzr	Checked	Nc	Approved	Bc	Date sample tested	11/08/2020	Depth	9.65-10.0m
----------	-----	---------	----	----------	----	--------------------	------------	-------	------------

NMTL Ltd

Sieve	%
Size mm	Passing
125.000	100.0
75.000	100.0
63.000	100.0
50.000	100.0
37.500	100.0
28.000	100.0
20.000	98.5
14.000	97.7
10.000	96.9
6.300	95.5
5.000	94.3
3.350	93.0
2.000	91.1
1.180	89.4
0.600	87.0
0.425	85.6
0.300	83.4
0.212	79.6
0.150	73.8
0.063	57.1

Determination of Particle Size Distribution

BS 1377 : 1990 : Part 2 : Clauses 9.2 & 9.5

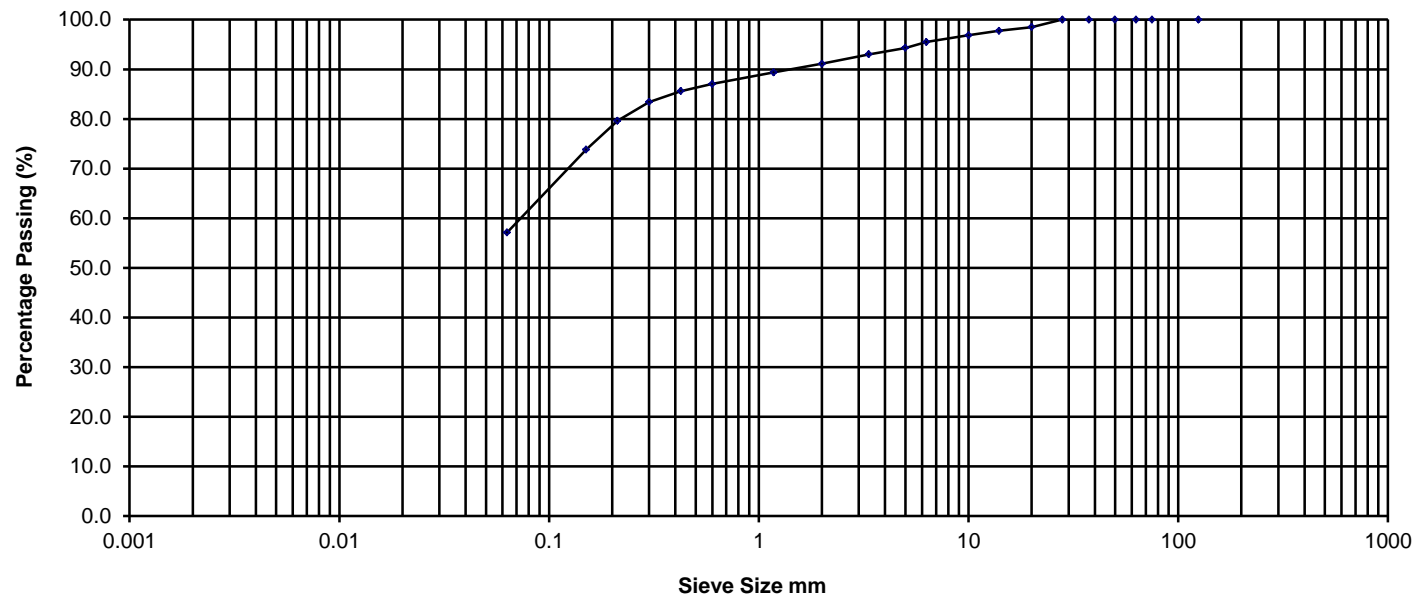

Percentage Particle Size

Clay	Fine	Medium	Coarse	Fine	Medium	Coarse	Fine	Medium	Coarse	Cobbles	Boulder
	Silt			Sand			Gravel				
	57.1			34.0			8.9			0.0	0.0

Sample Description Grey/brown slightly gravelly slightly sandy silty CLAY.

Project No. NMTL 3243

BH/TP No. BH09

Project Whitehall, Swords

GII Project ID-9225-11-19

Sample No. C

NM

TL

Ltd

Operator	Tzr	Checked	Nc	Approved	Bc	Date sample tested	11/08/2020	Depth	19.7-20.0m
----------	-----	---------	----	----------	----	--------------------	------------	-------	------------

SINGLE POINT MOISTURE CONDITION VALUE TEST


Single sample mass	
Initial sample mass	1495 g
Moisture content	13.9 %
Dry mass	1312.0 g
Mass retained on 20mm sieve	g 28.7 %

* Delete as appropriate

Project Name:	Job ref.	NMTL_3243
Whitehall, Swords	GII Project ID	9255-11-19
	TP/BH	TP01
Soil description:	Sample no.	B
Light brown slightly sandy slightly gravelly clayey SILT	Depth	0.70m
Test method	Date Tested	07/08/2020
BS 1377 : Part 4 : 1990 : 5	Date Sampled	N/A
	Date Received	29/07/2020

MCV 1.9 Natural

Total number of blows n	Penetration or protrusion mm	Change in penetration n to 4n mm
1	49.4	11.6
2	39.0	1.4
3	37.9	
4	37.8	
6	37.8	
8	37.6	
12		
16		
24		
32		
48		
64		
96		
128		
192		
256		

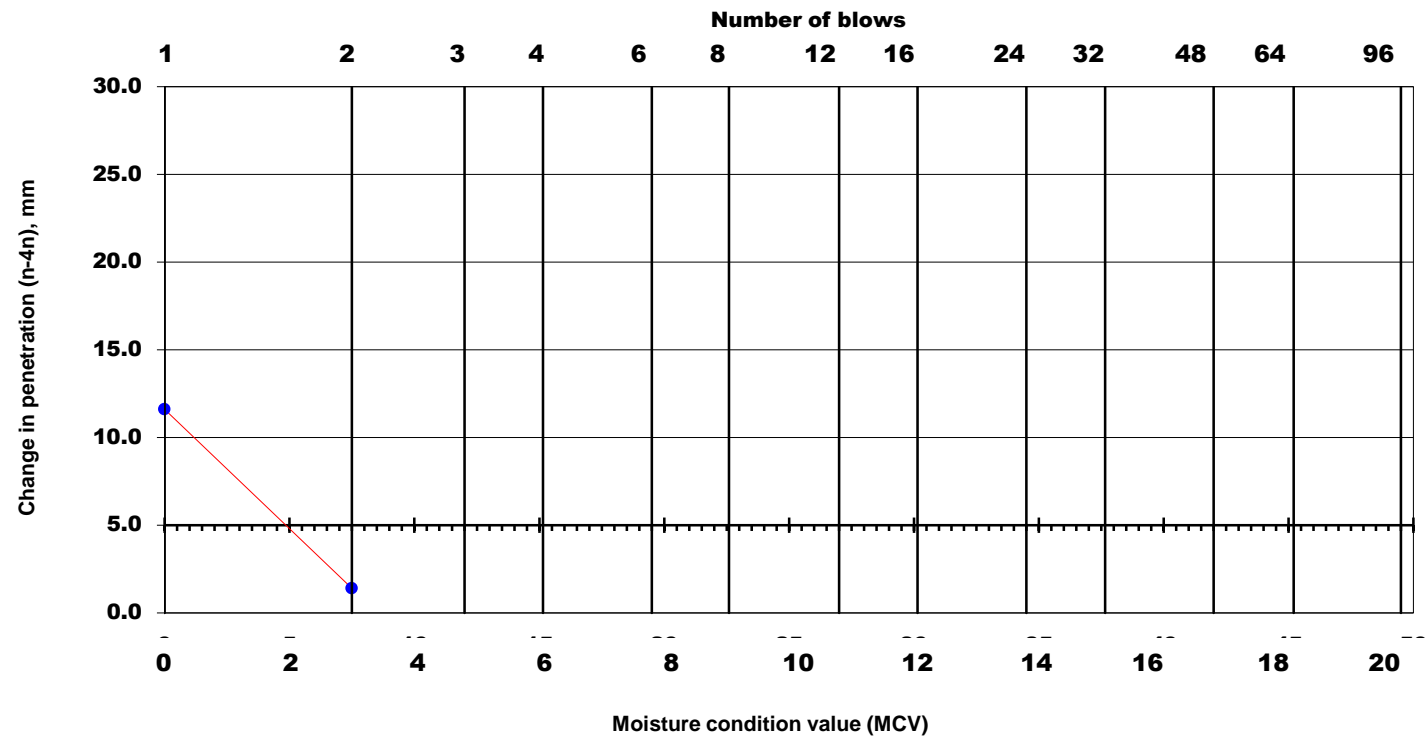

NMTL Ltd

Operator	Checked	Approved
Tch	Nc	Bc

SINGLE POINT MOISTURE CONDITION VALUE TEST


Single sample mass	
Initial sample mass	1492 g
Moisture content	12.3 %
Dry mass	1329.0 g
Mass retained on 20mm sieve	g 16 %

* Delete as appropriate

Project Name:	Job ref.	NMTL_3243
Whitehall, Swords	GII Project ID	9255-11-19
	TP/BH	TP01
Soil description:	Sample no.	B
Light brown slightly sandy slightly gravelly SILT/CLAY	Depth	2.40m
Test method	Date Tested	13/08/2020
BS 1377 : Part 4 : 1990 : 5	Date Sampled	N/A
	Date Received	12/08/2020

MCV 5.4 Natural

Total number of blows n	Penetration or protrusion mm	Change in penetration n to 4n mm
1	62.2	22.6
2	50.6	13.7
3	43.1	6.3
4	39.6	3.1
6	37.1	
8	36.9	
12	36.8	
16	36.5	
24		
32		
48		
64		
96		
128		
192		
256		

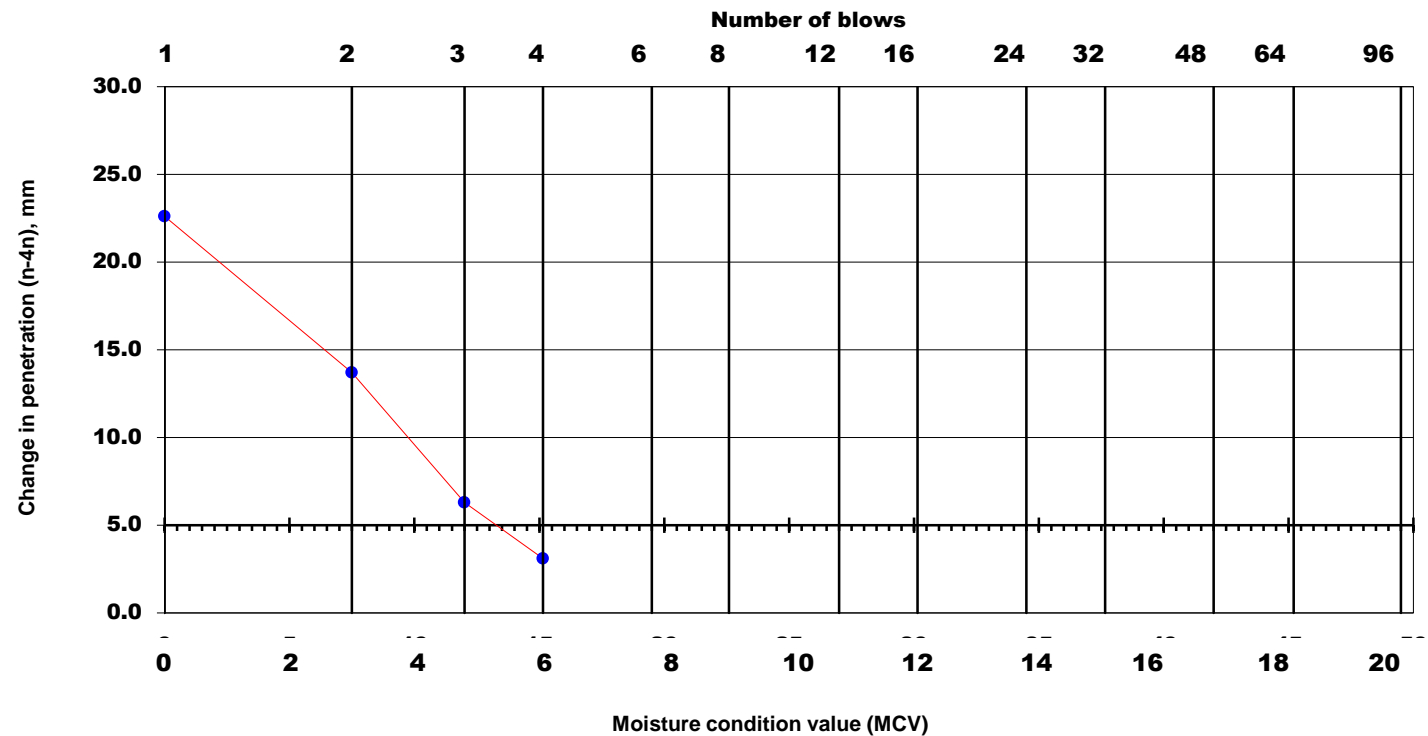

NMTL Ltd

Operator	Checked	Approved
Ms	Nc	Bc

SINGLE POINT MOISTURE CONDITION VALUE TEST


Single sample mass	
Initial sample mass	1491 g
Moisture content	16.0 %
Dry mass	1285.0 g
Mass retained on 20mm sieve	g 14.3 %

* Delete as appropriate

Project Name:	Job ref.	NMTL_3243
Whitehall, Swords	GII Project ID	9255-11-19
	TP/BH	TP02
Soil description:	Sample no.	B
Light brown slightly sandy slightly gravelly SILT/CLAY	Depth	1.50m
Test method	Date Tested	04/08/2020
BS 1377 : Part 4 : 1990 : 5	Date Sampled	N/A
	Date Received	29/07/2020

MCV N/A Natural

Total number of blows n	Penetration or protrusion mm	Change in penetration n to 4n mm
1	42.6	2.5
2	40.4	0.3
3	40.4	
4	40.1	
6	40.1	
8	40.1	
12		
16		
24		
32		
48		
64		
96		
128		
192		
256		

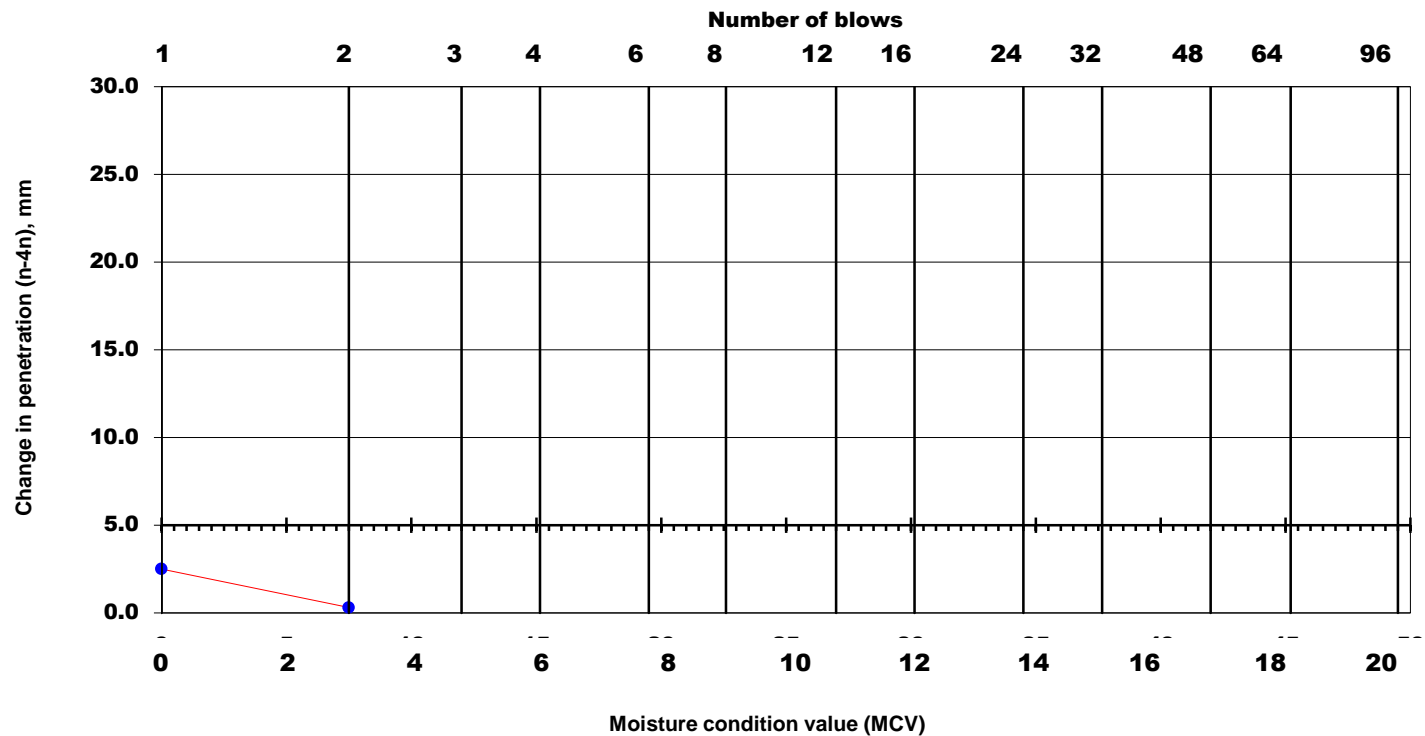

NMTL Ltd

Operator	Checked	Approved
Tch	Nc	Bc

SINGLE POINT MOISTURE CONDITION VALUE TEST


Single sample mass	
Initial sample mass	1481 g
Moisture content	32.4 %
Dry mass	1118.8 g
Mass retained on 20mm sieve	g 8.4 %

* Delete as appropriate

Project Name: Whitehall, Swords	Job ref. NMTL_3243
	GII Project ID 9255-11-19
	TP/BH TP03
Soil description: Light brown slightly sandy slightly gravelly SILT/CLAY	Sample no. B
	Depth 0.50m
Test method BS 1377 : Part 4 : 1990 : 5	Date Tested 07/08/2020
	Date Sampled N/A
	Date Received 29/07/2020

MCV 1.8 Natural

Total number of blows n	Penetration or protrusion mm	Change in penetration n to 4n mm
1	63.2	9.3
2	55.6	2.3
3	54.3	
4	53.9	
6	53.8	
8	53.3	
12		
16		
24		
32		
48		
64		
96		
128		
192		
256		

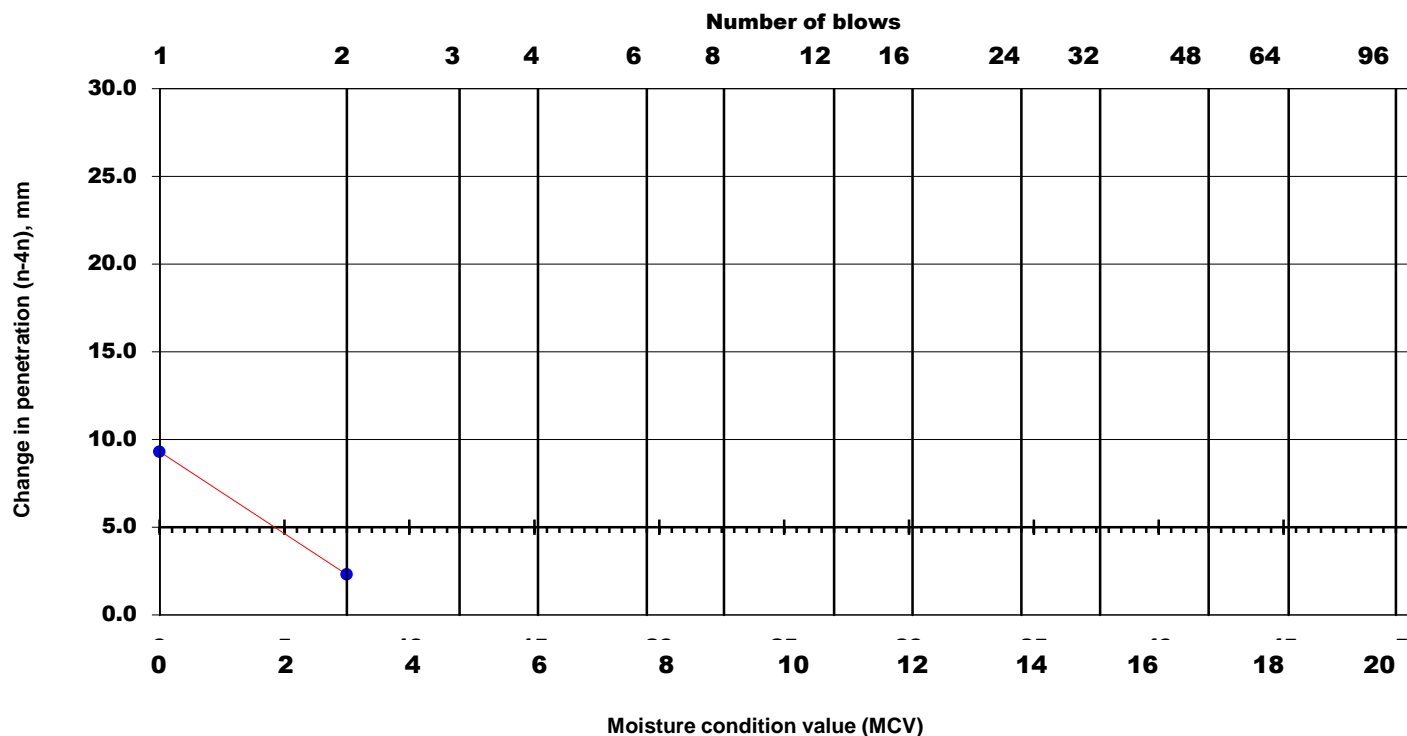

NMTL Ltd

Operator	Checked	Approved
Tch	Nc	Bc

SINGLE POINT MOISTURE CONDITION VALUE TEST


Single sample mass	
Initial sample mass	1491 g
Moisture content	14.4 %
Dry mass	1303.5 g
Mass retained on 20mm sieve	g 11.9 %

* Delete as appropriate

Project Name: Whitehall, Swords	Job ref. NMTL_3243
	GII Project ID 9255-11-19
	TP/BH TP03
Soil description: Grey slightly sandy gravelly silty CLAY	Sample no. B
	Depth 2.70m
Test method BS 1377 : Part 4 : 1990 : 5	Date Tested 04/08/2020
	Date Sampled N/A
	Date Received 29/07/2020

MCV 0.7 Natural

Total number of blows n	Penetration or protrusion mm	Change in penetration n to 4n mm
1	43.8	6.1
2	38.6	1.1
3	38.1	
4	37.7	
6	37.5	
8	37.5	
12		
16		
24		
32		
48		
64		
96		
128		
192		
256		

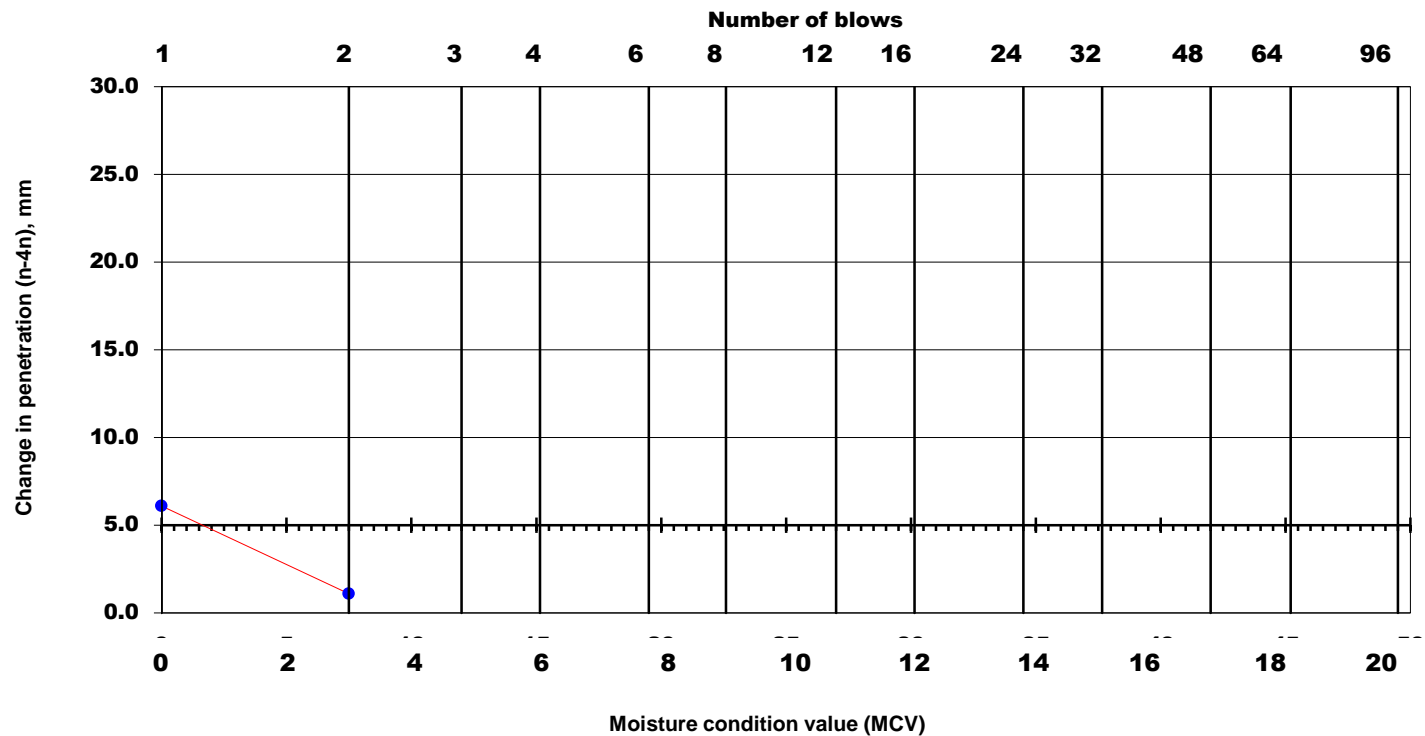

NMTL Ltd

Operator	Checked	Approved
Tch	Nc	Bc

SINGLE POINT MOISTURE CONDITION VALUE TEST


Single sample mass	
Initial sample mass	1494 g
Moisture content	14.5 %
Dry mass	1305.0 g
Mass retained on 20mm sieve	g 8.39 %

* Delete as appropriate

Project Name:	Job ref.	NMTL_3243
Whitehall, Swords	GII Project ID	9255-11-19
	TP/BH	TP04
Soil description:	Sample no.	T
Light brown/grey slightly sandy gravelly SILT/CLAY.	Depth	0.50m
Test method	Date Tested	08/08/2020
BS 1377 : Part 4 : 1990 : 5	Date Sampled	N/A
	Date Received	29/07/2020

MCV 8.2 Natural

Total number of blows n	Penetration or protrusion mm	Change in penetration n to 4n mm
1	76.7	26.0
2	63.1	22.2
3	56.1	17.5
4	50.7	12.2
6	44.4	6.0
8	40.9	2.9
12	38.6	
16	38.5	
24	38.4	
32	38.0	
48		
64		
96		
128		
192		
256		

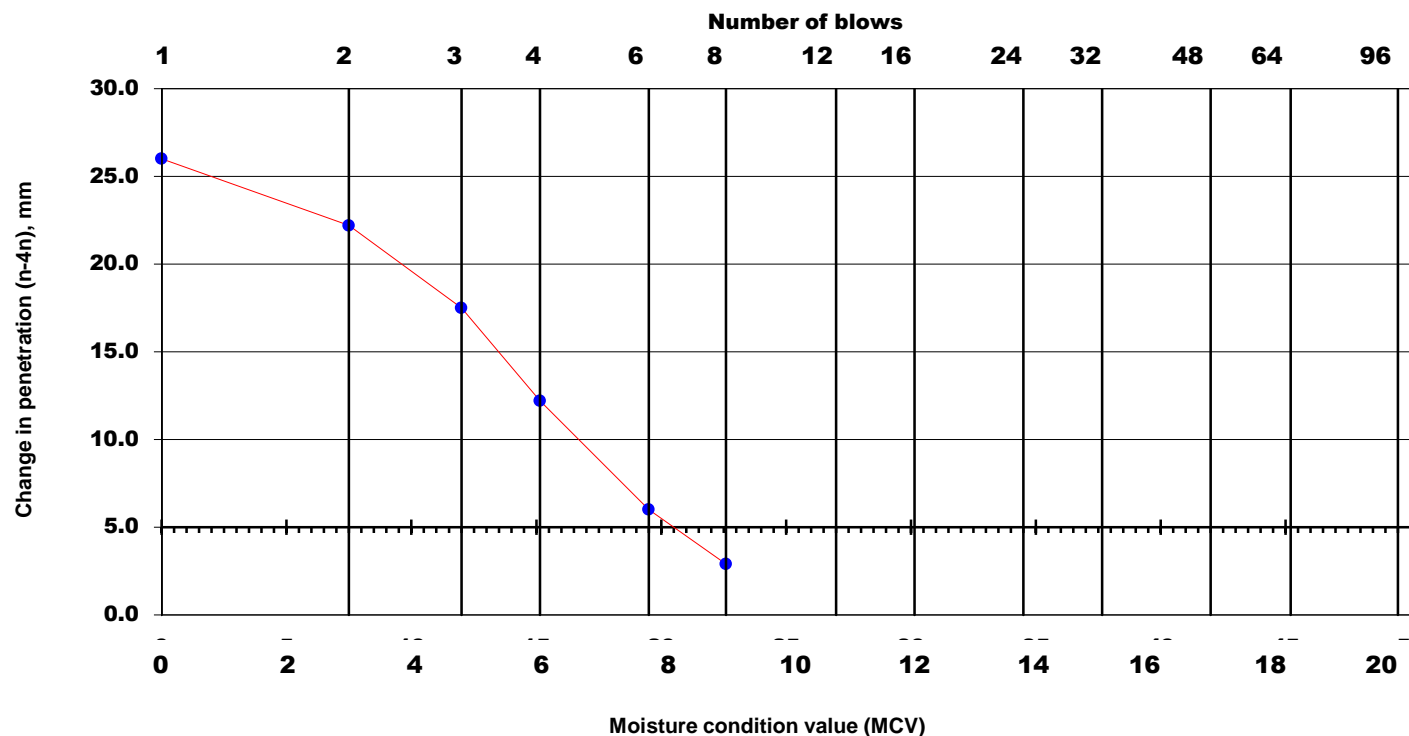

NMTL Ltd

Operator	Checked	Approved
Tch	Nc	Bc

SINGLE POINT MOISTURE CONDITION VALUE TEST


Single sample mass	
Initial sample mass	1478 g
Moisture content	20.2 %
Dry mass	1230.0 g
Mass retained on 20mm sieve	g 11.2 %

* Delete as appropriate

Project Name:	Job ref.	NMTL_3243
Whitehall, Swords	GII Project ID	9255-11-19
	TP/BH	TP05C
Soil description:	Sample no.	T
Light brown slightly sandy slightly gravelly SILT/CLAY.	Depth	0.90m
Test method	Date Tested	04/08/2020
BS 1377 : Part 4 : 1990 : 5	Date Sampled	N/A
	Date Received	29/07/2020

MCV N/A Natural

Total number of blows n	Penetration or protrusion mm	Change in penetration n to 4n mm
1	44.0	1.1
2	43.4	0.7
3	42.9	
4	42.9	
6	42.8	
8	42.7	
12		
16		
24		
32		
48		
64		
96		
128		
192		
256		

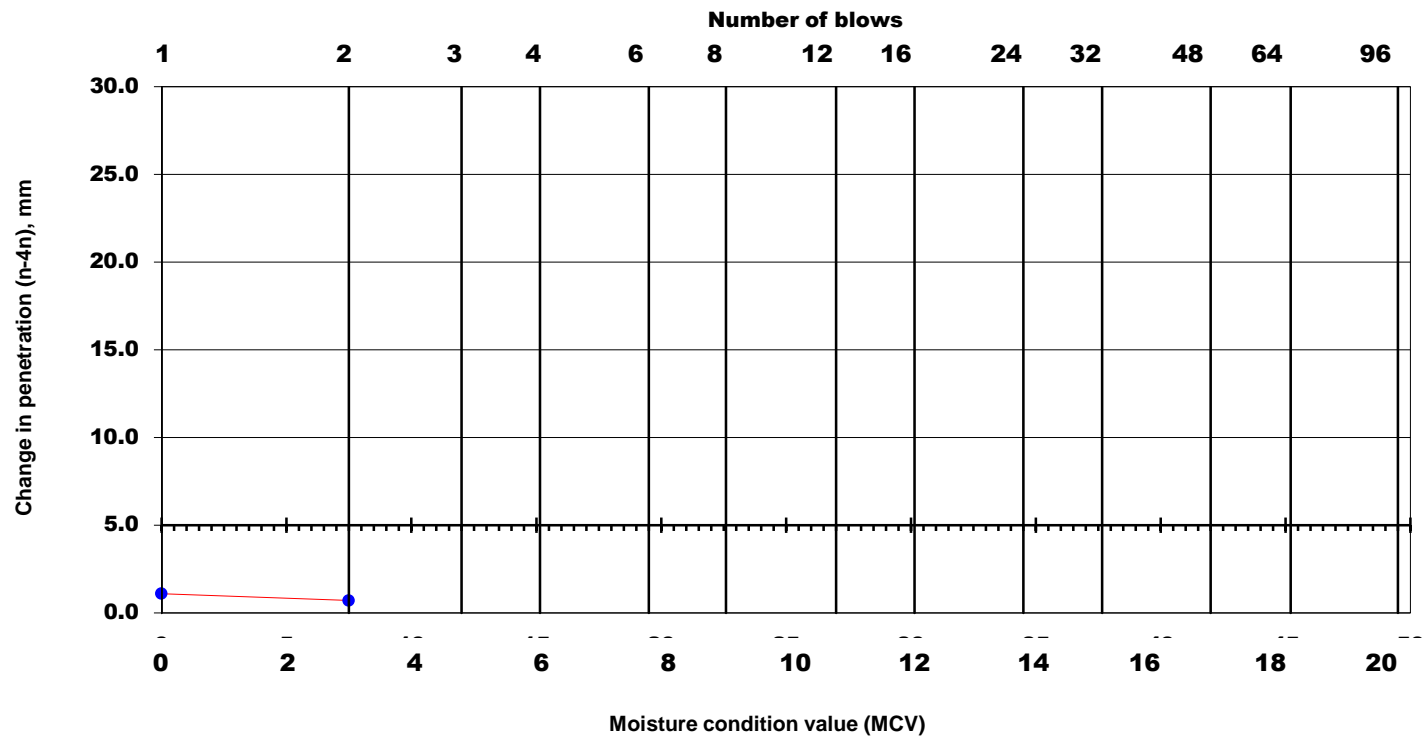

NMTL Ltd

Operator	Checked	Approved
Tch	Nc	Bc

SINGLE POINT MOISTURE CONDITION VALUE TEST


Single sample mass	
Initial sample mass	1490 g
Moisture content	14.5 %
Dry mass	1301.1 g
Mass retained on 20mm sieve	g psd %

* Delete as appropriate

Project Name: Whitehall, Swords	Job ref. NMTL_3243
	GII Project ID 9255-11-19
	TP/BH TP06
Soil description: Light brown/grey slightly sandy slightly gravelly SILT/CLAY.	Sample no. B
	Depth 0.60m
Test method BS 1377 : Part 4 : 1990 : 5	Date Tested 05/08/2020
	Date Sampled N/A
	Date Received 29/07/2020

MCV 9.5 Natural

Total number of blows n	Penetration or protrusion mm	Change in penetration n to 4n mm
1	84.3	29.3
2	70.1	26.3
3	62.2	22.9
4	55.0	17.2
6	48.4	10.8
8	43.8	6.2
12	39.3	1.9
16	37.8	
24	37.6	
32	37.6	
48	37.4	
64		
96		
128		
192		
256		

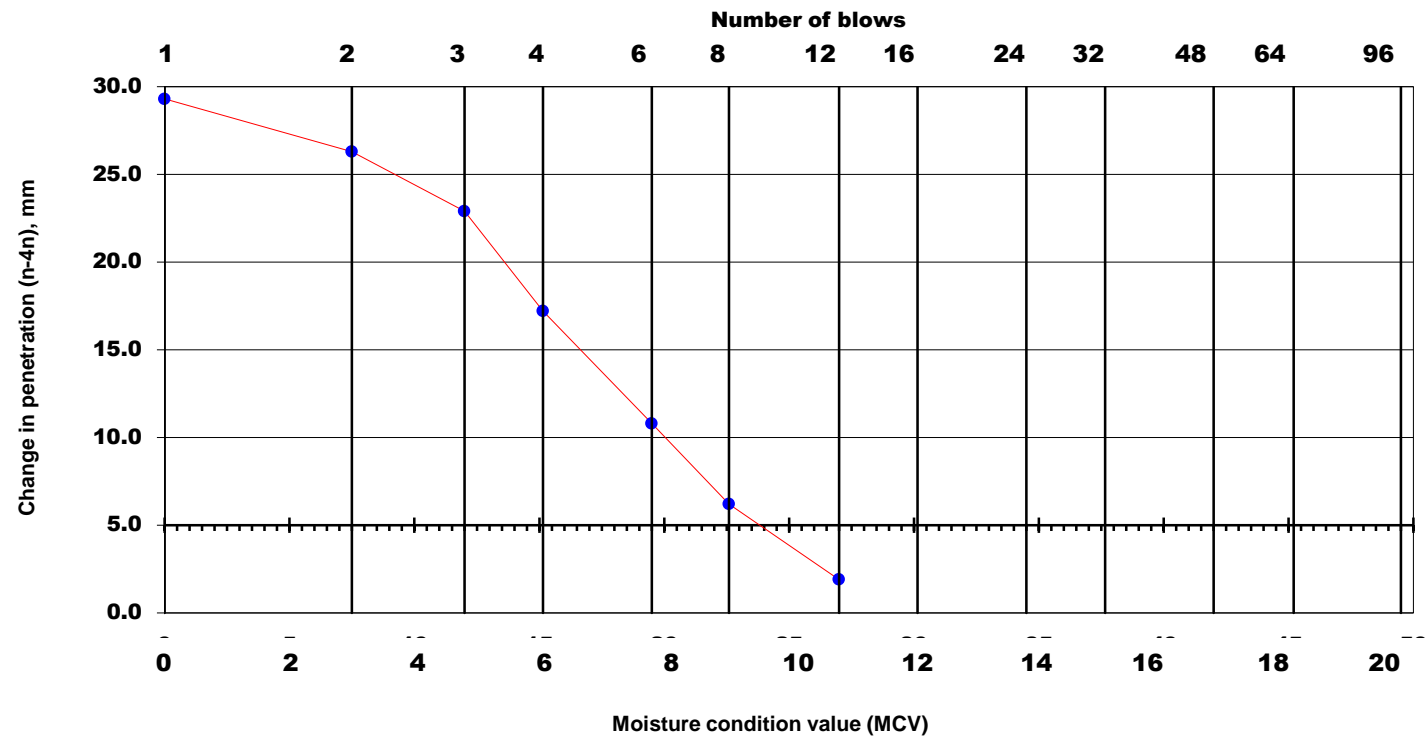

NMTL Ltd

Operator	Checked	Approved
Tch	Nc	Bc


SINGLE POINT MOISTURE CONDITION VALUE TEST

Single sample mass	
Initial sample mass	1489 g
Moisture content	35.3 %
Dry mass	1100.2 g
Mass retained on 20mm sieve	g 10.39 %

Project Name:	Job ref.	NMTL_3243
Whitehall, Swords	GII Project ID	9255-11-19
	TP/BH	TP07
Soil description:	Sample no.	B
Brown/grey slightly sandy slightly gravelly SILT/CLAY.	Depth	0.70m
Test method	Date Tested	06/08/2020
BS 1377 : Part 4 : 1990 : 5	Date Sampled	N/A
	Date Received	29/07/2020

MCV N/A Natural

Total number of blows n	Penetration or protrusion mm	Change in penetration n to 4n mm
1	60.3	3.7
2	56.8	0.3
3	56.7	
4	56.6	
6	56.5	
8	56.5	
12		
16		
24		
32		
48		
64		
96		
128		
192		
256		

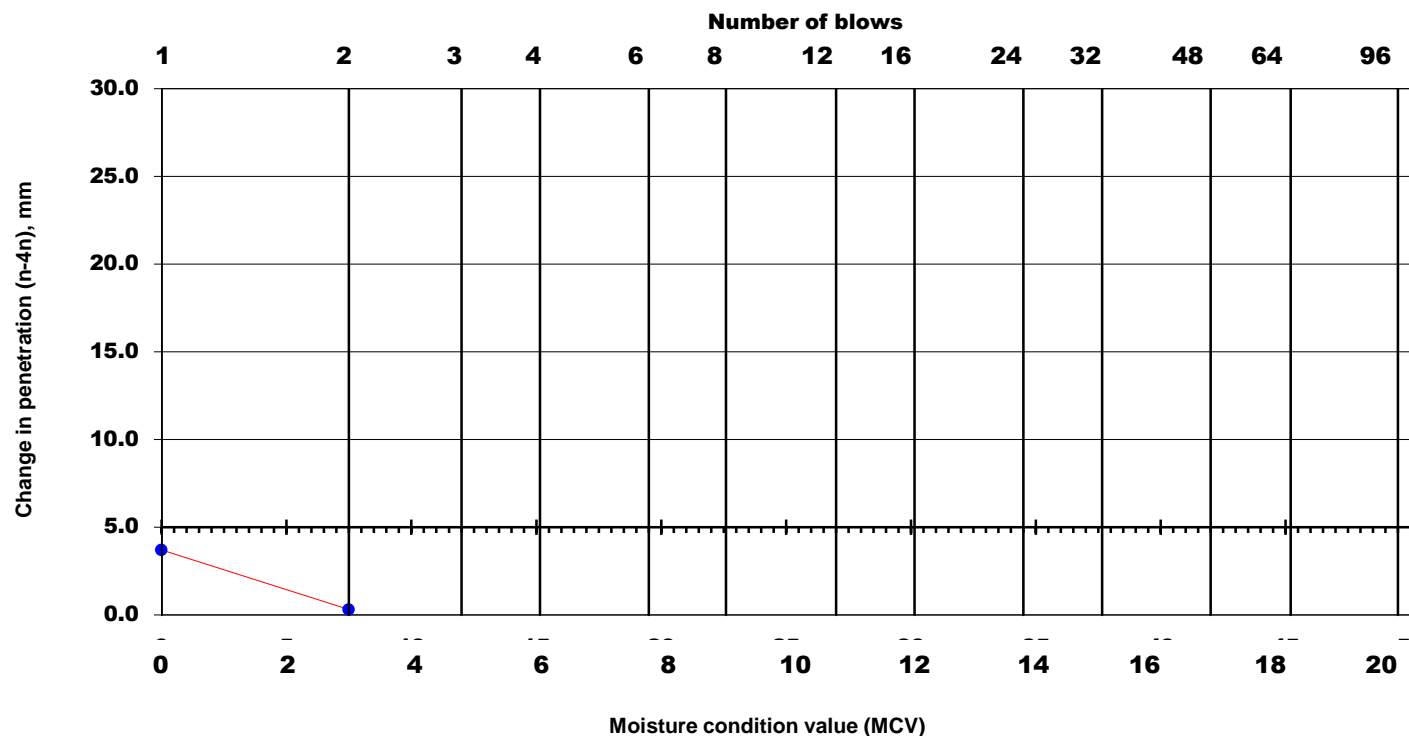

NMTL Ltd

Operator	Checked	Approved
Tch	Nc	Bc

SINGLE POINT MOISTURE CONDITION VALUE TEST


Single sample mass	
Initial sample mass	1496 g
Moisture content	15.4 %
Dry mass	1296.0 g
Mass retained on 20mm sieve	g 14.3 %

* Delete as appropriate

Project Name:	Job ref.	NMTL_3243
Whitehall, Swords	GII Project ID	9255-11-19
	TP/BH	TP07
Soil description:	Sample no.	B
Light brown slightly sandy slightly gravelly SILT/CLAY	Depth	3.30m
Test method	Date Tested	06/08/2020
BS 1377 : Part 4 : 1990 : 5	Date Sampled	N/A
	Date Received	29/07/2020

MCV N/A Natural

Total number of blows n	Penetration or protrusion mm	Change in penetration n to 4n mm
1	44.7	4.4
2	40.9	0.7
3	40.4	
4	40.3	
6	40.3	
8	40.2	
12		
16		
24		
32		
48		
64		
96		
128		
192		
256		

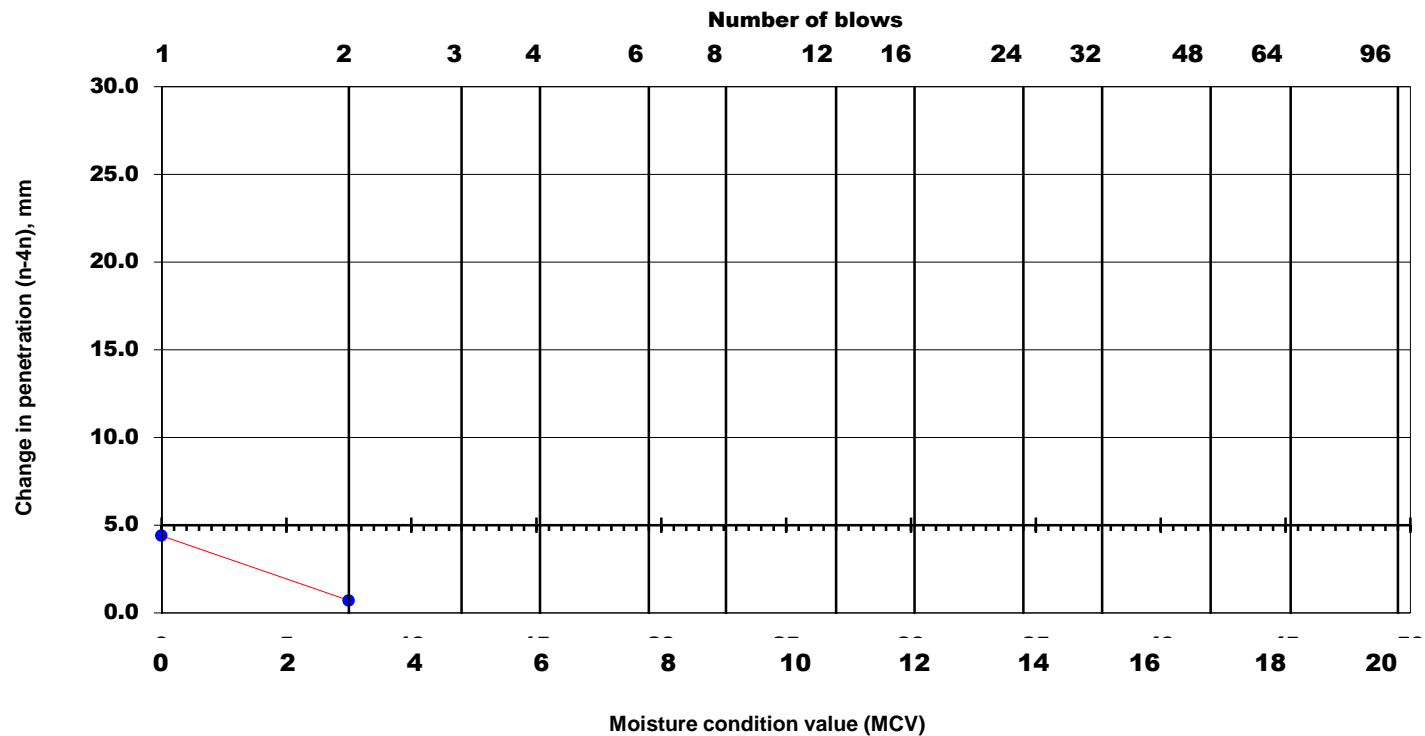

NMTL Ltd

Operator	Checked	Approved
Tch	Nc	Bc

SINGLE POINT MOISTURE CONDITION VALUE TEST


Single sample mass	
Initial sample mass	1493 g
Moisture content	14.7 %
Dry mass	1301.9 g
Mass retained on 20mm sieve	g psd %

* Delete as appropriate

Project Name:	Job ref.	NMTL_3243
Whitehall, Swords	GII Project ID	9255-11-19
	TP/BH	TP08
Soil description:	Sample no.	B
Brown slightly sandy slightly gravelly SILT/CLAY	Depth	0.70m
Test method	Date Tested	04/08/2020
BS 1377 : Part 4 : 1990 : 5	Date Sampled	N/A
	Date Received	29/07/2020

MCV 12.2 Natural

Total number of blows n	Penetration or protrusion mm	Change in penetration n to 4n mm
1	87.2	24.3
2	74.7	21.6
3	67.6	19.3
4	62.9	17.8
6	56.9	15.0
8	53.1	12.6
12	48.3	8.4
16	45.1	5.2
24	41.9	2.2
32	40.5	
48	39.9	
64	39.9	
96	39.7	
128		
192		
256		

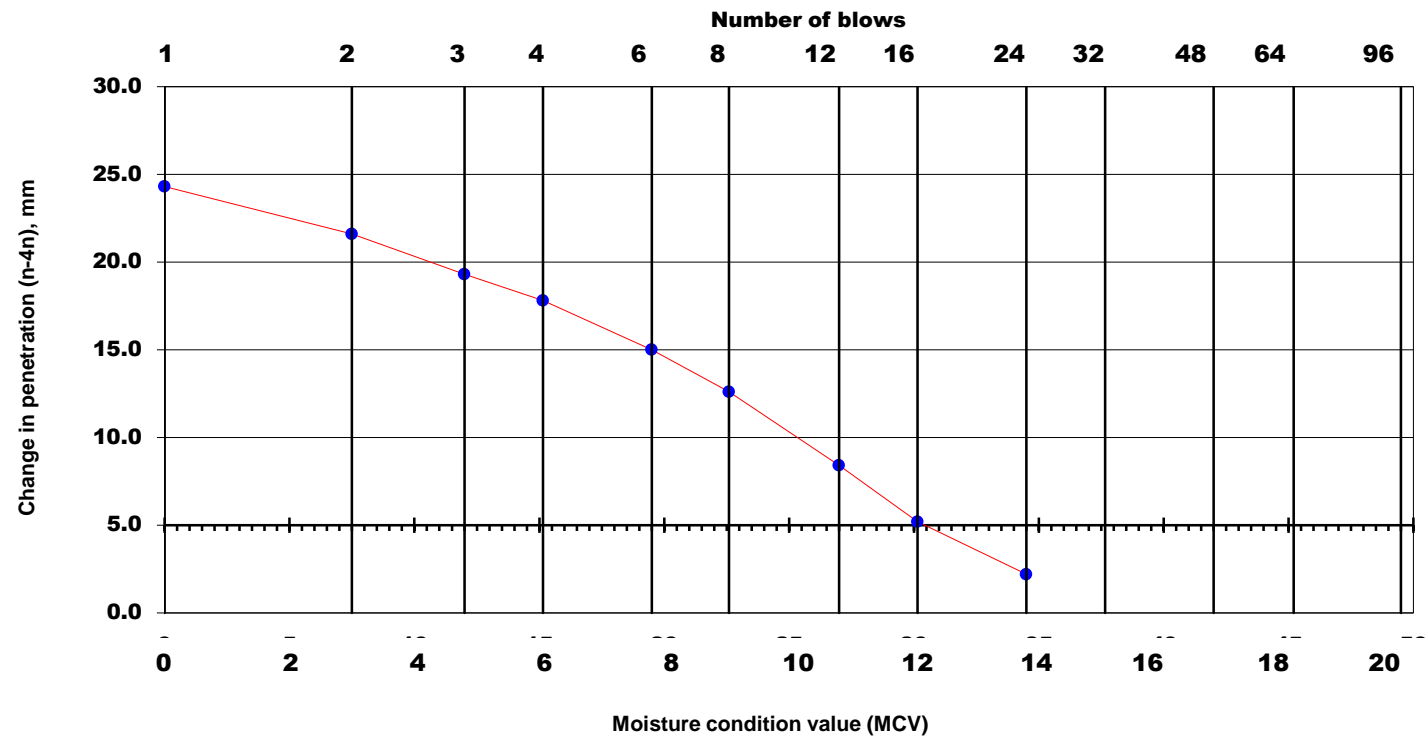

NMTL Ltd

Operator	Checked	Approved
Tch	Nc	Bc

SINGLE POINT MOISTURE CONDITION VALUE TEST


Single sample mass	
Initial sample mass	1494 g
Moisture content	12.6 %
Dry mass	1327.3 g
Mass retained on 20mm sieve	g 6.2 %

* Delete as appropriate

Project Name: Whitehall, Swords	Job ref. NMTL_3243
	GII Project ID 9255-11-19
	TP/BH TP09
Soil description: Brown slightly sandy slightly gravelly SILT/CLAY	Sample no. B
	Depth 1.90m
Test method BS 1377 : Part 4 : 1990 : 5	Date Tested 06/08/2020
	Date Sampled N/A
	Date Received 29/07/2020

MCV 7.3 Natural

Total number of blows n	Penetration or protrusion mm	Change in penetration n to 4n mm
1	72.6	27.5
2	56.9	21.1
3	50.9	15.7
4	45.1	9.9
6	38.3	3.1
8	35.8	
12	35.2	
16	35.2	
24	35.2	
32		
48		
64		
96		
128		
192		
256		

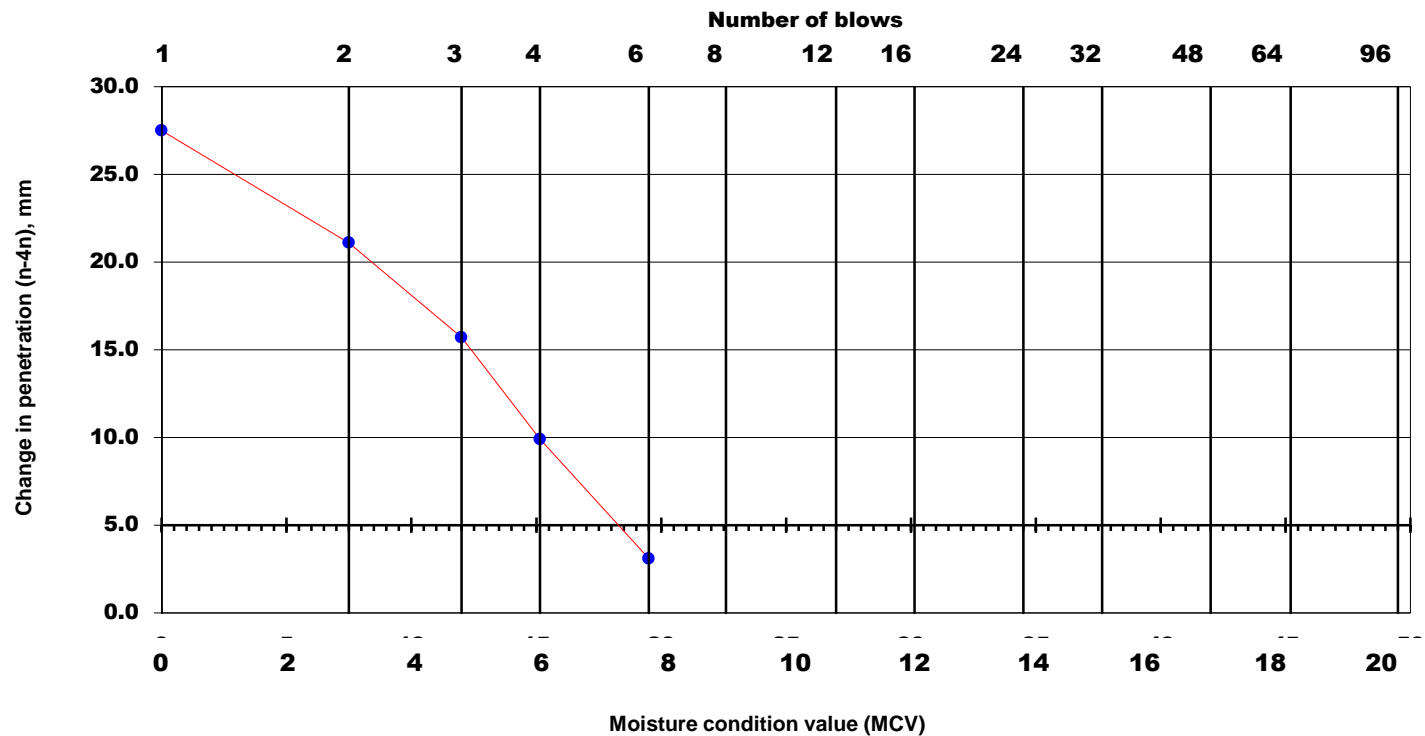

NMTL Ltd

Operator	Checked	Approved
Tch	Nc	Bc

SINGLE POINT MOISTURE CONDITION VALUE TEST


Single sample mass	
Initial sample mass	1497 g
Moisture content	18.4 %
Dry mass	1263.9 g
Mass retained on 20mm sieve	g 9.9 %

* Delete as appropriate

Project Name: Whitehall, Swords	Job ref. NMTL_3243
	GII Project ID 9255-11-19
	TP/BH TP10
Soil description: Light brown slightly gravelly slightly sandy SILT/CLAY.	Sample no. B
	Depth 0.50m
Test method BS 1377 : Part 4 : 1990 : 5	Date Tested 07/08/2020
	Date Sampled N/A
	Date Received 29/07/2020

MCV 2.9 Natural

Total number of blows n	Penetration or protrusion mm	Change in penetration n to 4n mm
1	52.4	9.6
2	46.8	4.7
3	43.8	1.8
4	42.8	
6	42.1	
8	42.1	
12	42.0	
16		
24		
32		
48		
64		
96		
128		
192		
256		

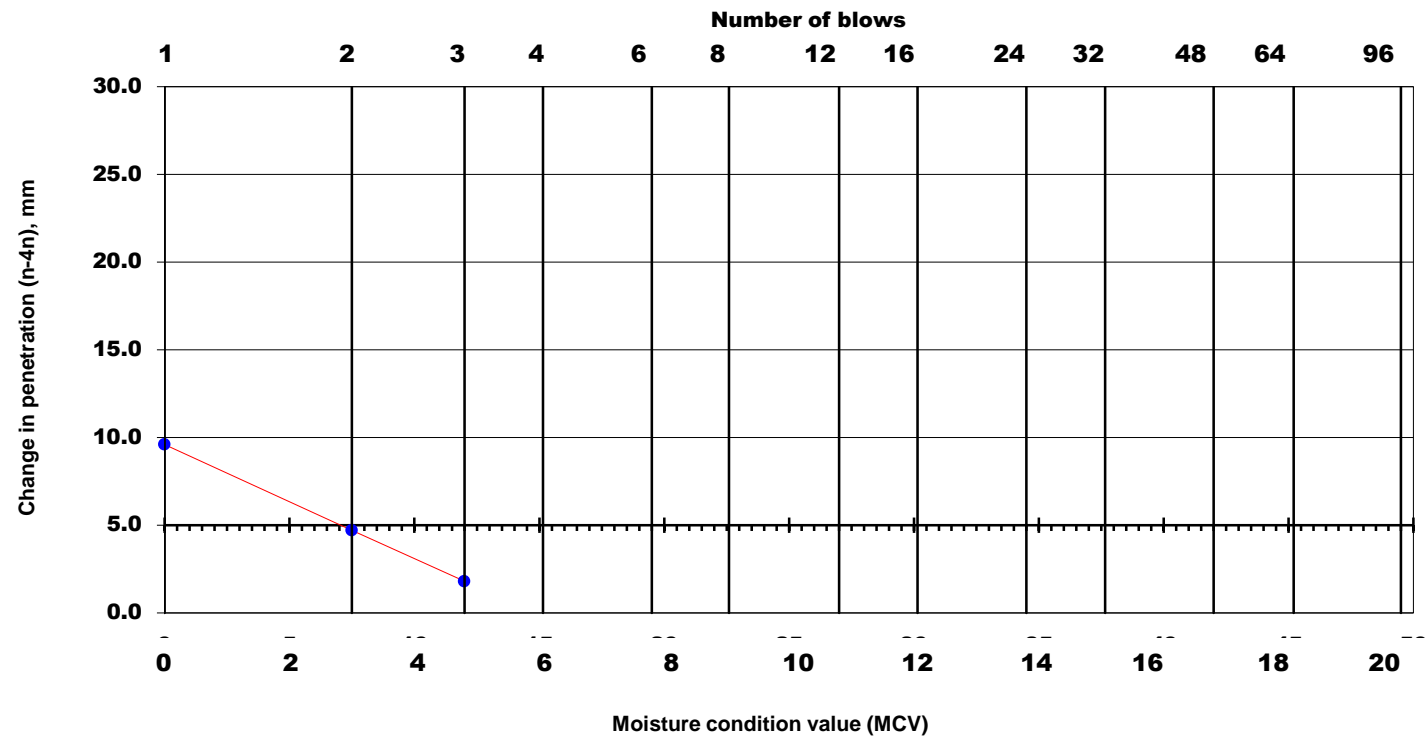

NMTL Ltd

Operator	Checked	Approved
Tch	Nc	Bc

DETERMINATION OF THE CALIFORNIA BEARING RATIO TEST
BS 1377 : PART 4 : CLAUSE 7 : 1990

Soil Description Light brown slightly slightly gravelly SILT/CLAY

Date 7-Aug-20

Test Method BS 1377: Part 4 : 1990 :7.4

Force Measuring Device VJT 08211

Test 1

Preparatic Remoulded with 2.5 kg rammer at natural moisture content

Surcharge

10 kPa

Mean Calibration

4.33

N/Div

Penetration

Force Gauge

Force on

4.33

N/Div

of plunger

reading

plunger

California Bearing Ratio Results

%

mm

divisions

kN

Top

Base

0.00

Top

Bottom

Top

Bottom

0.000

0.000

0.25

2.0

3.0

0.009

0.013

0.50

3.0

4.0

0.013

0.017

0.75

4.0

6.0

0.017

0.026

1.00

5.0

7.0

0.022

0.030

1.25

6.0

8.0

0.026

0.035

1.50

7.0

9.0

0.030

0.039

1.75

9.0

10.0

0.039

0.043

2.00

10.0

11.0

0.043

0.048

2.25

11.0

12.0

0.048

0.052

2.50

13.0

14.0

0.056

0.061

0.43

0.46

2.75

14.0

15.0

0.061

0.065

3.00

15.0

16.0

0.065

0.069

3.25

16.0

17.0

0.069

0.074

3.50

17.0

18.0

0.074

0.078

3.75

19.0

19.0

0.082

0.082

4.00

20.0

20.0

0.087

0.087

4.25

22.0

21.0

0.095

0.091

4.50

23.0

22.0

0.100

0.095

4.75

24.0

23.0

0.104

0.100

5.00

25.0

24.0

0.108

0.104

0.54

0.52

5.25

26.0

25.0

0.113

0.108

5.50

27.0

26.0

0.117

0.113

5.75

28.0

27.0

0.121

0.117

6.00

29.0

28.0

0.126

0.121

6.25

30.0

29.0

0.130

0.126

6.50

31.0

30.0

0.134

0.130

6.75

32.0

31.0

0.139

0.134

7.00

33.0

32.0

0.143

0.139

7.25

35.0

33.0

0.152

0.143

7.50

36.0

34.0

0.156

0.147

Moisture content after test

Top

Middle

Base

Specimen wt g

5090

Container No.

Tray

Tray

Tray

Diameter mm

152

Mass of wet soil + container

g

1889.0

1868.0

1810.0

Length mm

127.0

Mass of dry soil + container

g

1677.0

1651.0

1616.0

Weight of container

g

146.0

143.0

189.0

Mass of moisture

g

212.0

217.0

194.0

Average MC %

13.94

Dry weight

g

1531.0

1508.0

1427.0

Density Mg/m3

2.21

Moisture content

%


13.85

14.39

13.59

Dry Density Mg/m3

1.94

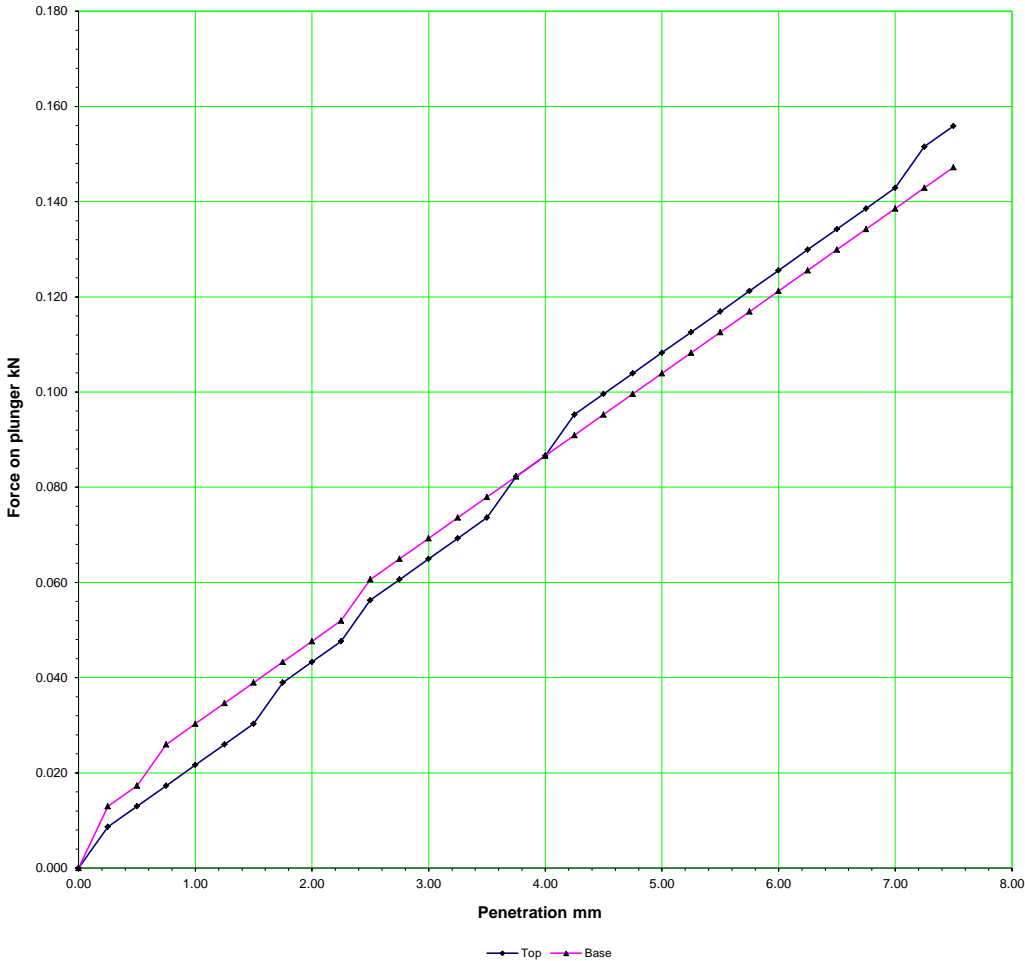

NM
TL
Ltd


Project: Whitehall, Swords

GII Project ID: 9225-11-19

	Date	Project No.	NMTL 3243
Operator	Ms 7-Aug-20	Trial Pit No.	TP01
Checked	Nc	Sample No.	B
Approved	Bc	Depth	0.70m

DETERMINATION OF THE CALIFORNIA BEARING RATIO TEST
BS 1377 : PART 4 : CLAUSE 7 : 1990


Soil Description	Grey slightly slightly gravelly SILT/CLAY				Date	13-Aug-20	
Test Method	BS 1377: Part 4 : 1990 :7.4						
Force Measuring Device	VJT-08211					Test 1	
Preperatic Remoulded with 2.5 kg rammer at natural moisture content							
Surcharge	10 kPa		Mean Calibration		4.33	N/Div	
Penetration	Force Gauge		Force on		4.33	N/Div	
of plunger	reading		plunger		California Bearing Ratio Results		
mm	divisions		kN			%	
	Top	Bottom	Top	Bottom	Top	Base	
0.00	0.0	0.0	0.000	0.000			
0.25	8.0	5.0	0.035	0.022			
0.50	15.0	8.0	0.065	0.035			
0.75	23.0	11.0	0.100	0.048			
1.00	29.0	15.0	0.126	0.065			
1.25	37.0	19.0	0.160	0.082			
1.50	45.0	23.0	0.195	0.100			
1.75	54.0	28.0	0.234	0.121			
2.00	62.0	32.0	0.268	0.139			
2.25	71.0	35.0	0.307	0.152			
2.50	79.0	39.0	0.342	0.169	2.59	1.28	
2.75	88.0	43.0	0.381	0.186			
3.00	95.0	47.0	0.411	0.204			
3.25	103.0	52.0	0.446	0.225			
3.50	111.0	56.0	0.481	0.242			
3.75	118.0	61.0	0.511	0.264			
4.00	125.0	65.0	0.541	0.281			
4.25	131.0	69.0	0.567	0.299			
4.50	138.0	73.0	0.598	0.316			
4.75	145.0	77.0	0.628	0.333			
5.00	151.0	81.0	0.654	0.351	3.27	1.75	
5.25	157.0	85.0	0.680	0.368			
5.50	163.0	89.0	0.706	0.385			
5.75	169.0	93.0	0.732	0.403			
6.00	174.0	97.0	0.753	0.420			
6.25	180.0	101.0	0.779	0.437			
6.50	185.0	105.0	0.801	0.455			
6.75	189.0	108.0	0.818	0.468			
7.00	194.0	113.0	0.840	0.489			
7.25	198.0	116.0	0.857	0.502			
7.50	203.0	120.0	0.879	0.520			
Moisture content after test		Top	Middle	Base	Specimen wt g	5140	
Container No.		Tray	Tray	Tray	Diameter mm	152	
Mass of wet soil + container	g	1845.0	2024.0	1718.0	Length mm	127.0	
Mass of dry soil + container	g	1659.0	1822.0	1545.0			
Weight of container	g	145.0	146.0	156.0			
Mass of moisture	g	186.0	202.0	173.0	Average MC %	12.26	
Dry weight	g	1514.0	1676.0	1389.0	Density Mg/m3	2.23	
Moisture content	%	12.29	12.05	12.46	Dry Density Mg/m3	1.99	

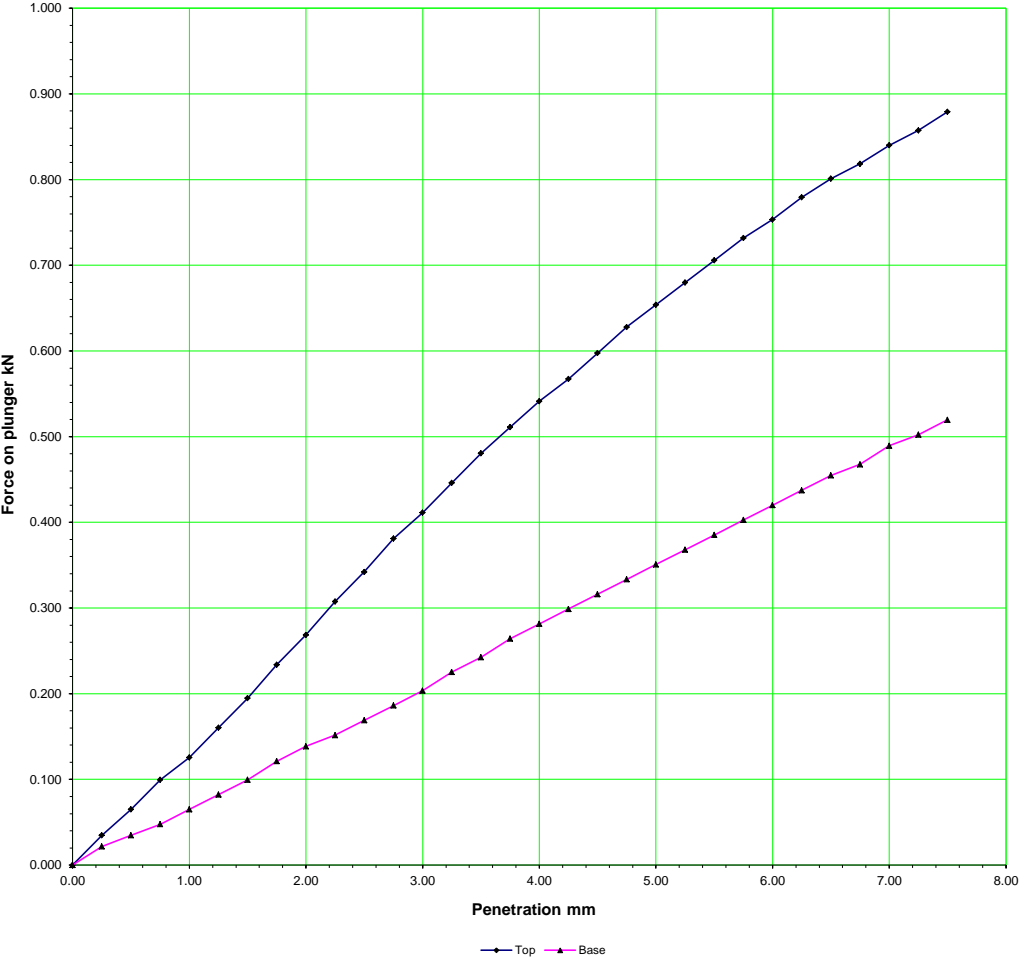

NM TL Ltd	Project: Whitehall, Swords	GII Project ID: 9225-11-19		Date	Project No.	NMTL 3243
			Operator	Ms 13-Aug-20	Trial Pit No.	TP01
			Checked	Nc	Sample No.	B
			Approved	Bc	Depth	2.40m

DETERMINATION OF THE CALIFORNIA BEARING RATIO TEST
BS 1377 : PART 4 : CLAUSE 7 : 1990


Soil Description	Light brown slightly slightly gravelly SILT/CLAY				Date	4-Aug-20
Test Method	BS 1377: Part 4 : 1990 :7.4					
Force Measuring Device	VJT 08211					Test 1
Preparatic Remoulded with 2.5 kg rammer at natural moisture content						
Surcharge	10 kPa		Mean Calibration		4.33	N/Div
Penetration	Force Gauge		Force on		4.33	N/Div
of plunger	reading		plunger		California Bearing Ratio	Results
mm	divisions		kN			
	Top	Bottom	Top	Bottom	Top	Base
0.00	0.0	0.0	0.000	0.000		
0.25	1.0	2.0	0.004	0.009		
0.50	2.0	2.5	0.009	0.011		
0.75	2.0	3.0	0.009	0.013		
1.00	2.5	3.5	0.011	0.015		
1.25	3.0	4.0	0.013	0.017		
1.50	3.5	4.5	0.015	0.019		
1.75	4.0	5.0	0.017	0.022		
2.00	4.5	5.0	0.019	0.022		
2.25	5.0	5.5	0.022	0.024		
2.50	5.5	6.0	0.024	0.026	0.18	0.20
2.75	5.5	6.0	0.024	0.026		
3.00	5.5	6.5	0.024	0.028		
3.25	6.0	7.0	0.026	0.030		
3.50	6.0	7.0	0.026	0.030		
3.75	6.5	7.5	0.028	0.032		
4.00	7.0	8.0	0.030	0.035		
4.25	7.0	8.0	0.030	0.035		
4.50	7.5	8.5	0.032	0.037		
4.75	7.5	8.5	0.032	0.037		
5.00	8.0	9.0	0.035	0.039	0.17	0.19
5.25	8.0	9.5	0.035	0.041		
5.50	8.5	9.5	0.037	0.041		
5.75	8.5	10.0	0.037	0.043		
6.00	9.0	10.0	0.039	0.043		
6.25	9.0	10.0	0.039	0.043		
6.50	9.0	10.5	0.039	0.045		
6.75	9.5	10.5	0.041	0.045		
7.00	9.5	11.0	0.041	0.048		
7.25	9.5	11.0	0.041	0.048		
7.50	10.0	11.0	0.043	0.048		
Moisture content after test		Top	Middle	Base	Specimen wt g	4995
Container No.		Tray	Tray	Tray	Diameter mm	152
Mass of wet soil + container	g	1928.0	1904.0	1596.0	Length mm	127.0
Mass of dry soil + container	g	1684.0	1660.0	1394.0		
Weight of container	g	145.0	145.0	147.0		
Mass of moisture	g	244.0	244.0	202.0	Average MC %	16.05
Dry weight	g	1539.0	1515.0	1247.0	Density Mg/m3	2.17
Moisture content	%	15.85	16.11	16.20	Dry Density Mg/m3	1.87

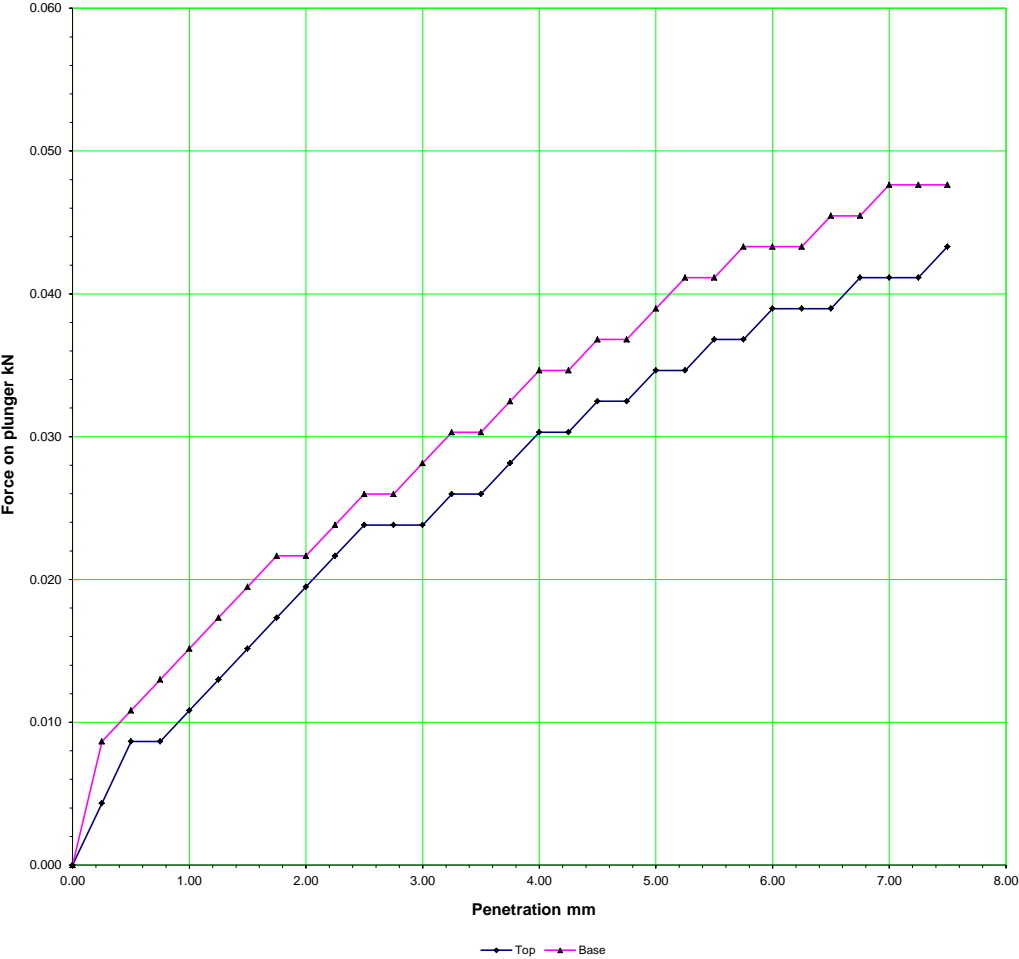

NM TL Ltd	Project: Whitehall, Swords	GII Project ID: 9225-11-19		Date	Project No.	NMTL 3243
			Operator	Ms 4-Aug-20	Trial Pit No.	TP02
			Checked	Nc	Sample No.	B
			Approved	Bc	Depth	1.50m

DETERMINATION OF THE CALIFORNIA BEARING RATIO TEST
BS 1377 : PART 4 : CLAUSE 7 : 1990

Soil Description	Light brown slightly slightly gravelly SILT/CLAY				Date	7-Aug-20	
Test Method	BS 1377: Part 4 : 1990 :7.4						
Force Measuring Device	VJT 08211					Test 1	
Preparatic Remoulded with 2.5 kg rammer at natural moisture content							
Surcharge	10 kPa		Mean Calibration		4.33	N/Div	
Penetration	Force Gauge		Force on		4.33	N/Div	
of plunger	reading		plunger		California Bearing Ratio Results		
mm	divisions		kN			%	
	Top	Bottom	Top	Bottom	Top	Base	
0.00	0.0	0.0	0.000	0.000			
0.25	2.0	1.5	0.009	0.006			
0.50	3.0	2.0	0.013	0.009			
0.75	4.0	3.0	0.017	0.013			
1.00	5.0	3.5	0.022	0.015			
1.25	6.0	4.0	0.026	0.017			
1.50	7.0	4.5	0.030	0.019			
1.75	7.5	5.0	0.032	0.022			
2.00	8.5	5.5	0.037	0.024			
2.25	9.0	6.0	0.039	0.026			
2.50	9.5	6.5	0.041	0.028	0.31	0.21	
2.75	10.0	7.0	0.043	0.030			
3.00	11.0	7.0	0.048	0.030			
3.25	11.0	7.5	0.048	0.032			
3.50	12.0	8.0	0.052	0.035			
3.75	12.5	8.5	0.054	0.037			
4.00	13.0	9.0	0.056	0.039			
4.25	13.5	9.5	0.058	0.041			
4.50	14.0	10.0	0.061	0.043			
4.75	14.5	10.0	0.063	0.043			
5.00	15.0	10.0	0.065	0.043	0.32	0.22	
5.25	15.0	10.5	0.065	0.045			
5.50	16.0	11.0	0.069	0.048			
5.75	16.0	11.0	0.069	0.048			
6.00	16.5	11.5	0.071	0.050			
6.25	17.0	12.0	0.074	0.052			
6.50	17.5	12.0	0.076	0.052			
6.75	18.0	12.5	0.078	0.054			
7.00	19.0	13.0	0.082	0.056			
7.25	19.5	13.0	0.084	0.056			
7.50	20.0	13.5	0.087	0.058			
Moisture content after test		Top	Middle	Base	Specimen wt g	4250	
Container No.		Tray	Tray	Tray	Diameter mm	152	
Mass of wet soil + container	g	1540.0	1644.0	1544.0	Length mm	127.0	
Mass of dry soil + container	g	1199.0	1287.0	1199.0			
Weight of container	g	144.0	191.0	147.0			
Mass of moisture	g	341.0	357.0	345.0	Average MC %	32.56	
Dry weight	g	1055.0	1096.0	1052.0	Density Mg/m3	1.84	
Moisture content	%	32.32	32.57	32.79	Dry Density Mg/m3	1.39	

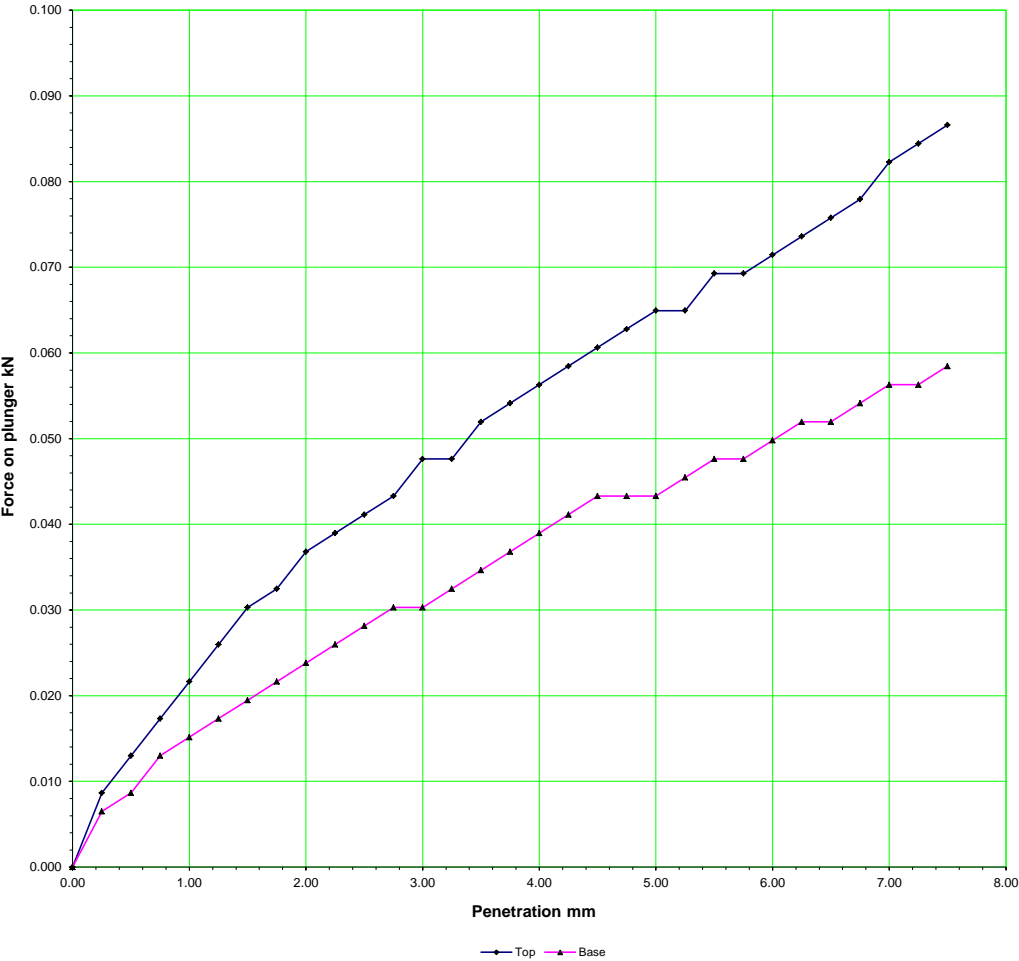

NM TL Ltd	Project: Whitehall, Swords	Date		Project No.	NMTL 3243
		Operator	Ms 7-Aug-20	Trial Pit No.	TP03
		Checked	Nc	Sample No.	B
		Approved	Bc	Depth	0.50m

GII Project ID: 9225-11-19

DETERMINATION OF THE CALIFORNIA BEARING RATIO TEST
BS 1377 : PART 4 : CLAUSE 7 : 1990

Soil Description Grey slightly slightly gravelly SILT/CLAY

Date 4-Aug-20

Test Method BS 1377: Part 4 : 1990 :7.4

Force Measuring Device VJT 08211

Test 1

Preparatic Remoulded with 2.5 kg rammer at natural moisture content

Surcharge 10 kPa

Mean Calibration 4.33

N/Div

Penetration Force Gauge

Force on 4.33

N/Div

of plunger

reading

plunger

California Bearing Ratio Results

%

mm

divisions


kN

Top

Base

	Top	Bottom	Top	Bottom	Top	Base
0.00	0.0	0.0	0.000	0.000		
0.25	2.0	2.0	0.009	0.009		
0.50	2.5	3.0	0.011	0.013		
0.75	3.5	4.0	0.015	0.017		
1.00	4.0	5.0	0.017	0.022		
1.25	4.5	5.5	0.019	0.024		
1.50	5.0	6.0	0.022	0.026		
1.75	6.0	6.5	0.026	0.028		
2.00	6.5	7.0	0.028	0.030		
2.25	7.0	8.0	0.030	0.035		
2.50	8.0	8.5	0.035	0.037	0.26	0.28
2.75	8.5	9.0	0.037	0.039		
3.00	9.5	10.0	0.041	0.043		
3.25	10.0	10.5	0.043	0.045		
3.50	10.5	11.0	0.045	0.048		
3.75	11.5	11.5	0.050	0.050		
4.00	12.0	12.0	0.052	0.052		
4.25	12.5	12.5	0.054	0.054		
4.50	13.0	13.0	0.056	0.056		
4.75	13.5	14.0	0.058	0.061		
5.00	14.0	14.5	0.061	0.063	0.30	0.31
5.25	14.5	15.0	0.063	0.065		
5.50	15.0	15.0	0.065	0.065		
5.75	15.5	15.5	0.067	0.067		
6.00	16.0	16.0	0.069	0.069		
6.25	16.5	16.5	0.071	0.071		
6.50	17.0	17.0	0.074	0.074		
6.75	17.0	17.5	0.074	0.076		
7.00	18.0	18.0	0.078	0.078		
7.25	18.0	18.5	0.078	0.080		
7.50	18.0	19.0	0.078	0.082		


Moisture content after test		Top	Middle	Base	Specimen wt g	5065
Container No.		Tray	Tray	Tray	Diameter mm	152
Mass of wet soil + container	g	1996.0	1821.0	1771.0	Length mm	127.0
Mass of dry soil + container	g	1764.0	1613.0	1572.0		
Weight of container	g	149.0	190.0	191.0		
Mass of moisture	g	232.0	208.0	199.0	Average MC %	14.46
Dry weight	g	1615.0	1423.0	1381.0	Density Mg/m3	2.20
Moisture content	%	14.37	14.62	14.41	Dry Density Mg/m3	1.92

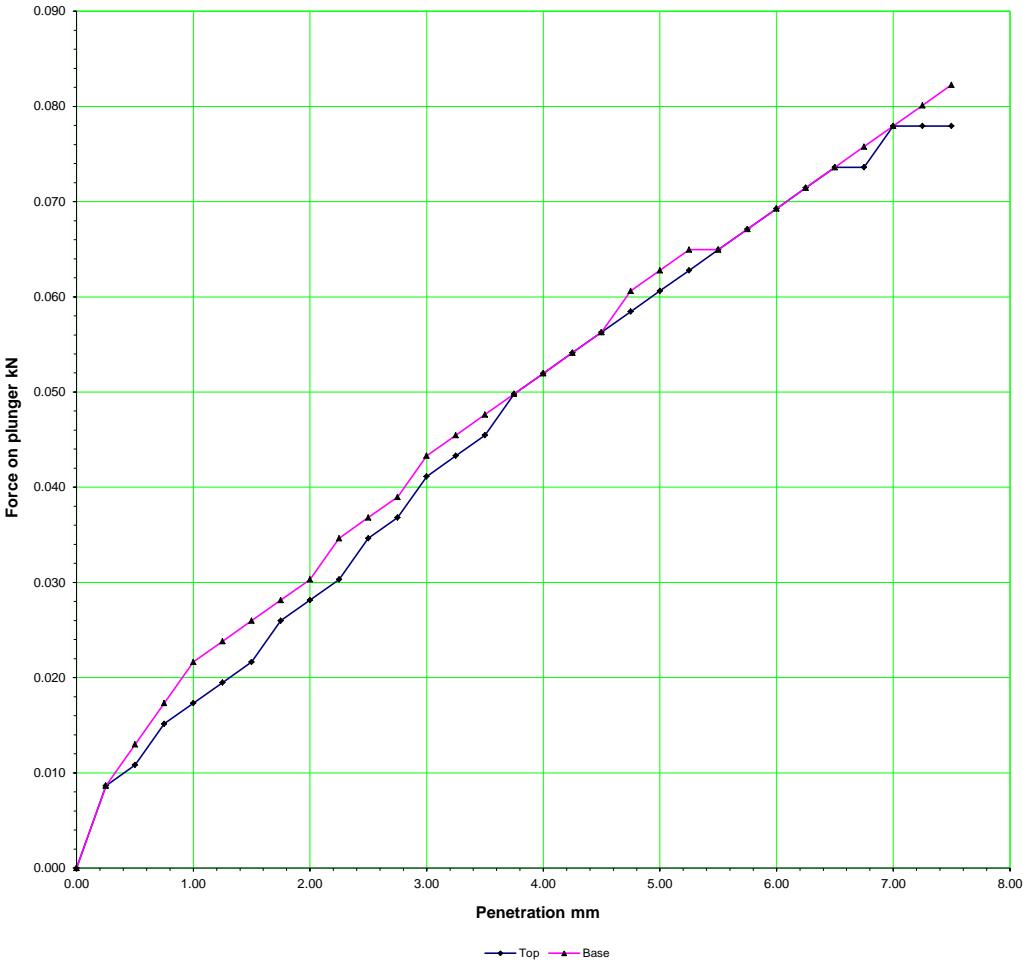

NM TL Ltd	Project: Whitehall, Swords	GII Project ID: 9225-11-19		Date	Project No.	NMTL 3243
			Operator	Ms	4-Aug-20	Trial Pit No.
			Checked	Nc		Sample No.
			Approved	Bc		Depth

DETERMINATION OF THE CALIFORNIA BEARING RATIO TEST
BS 1377 : PART 4 : CLAUSE 7 : 1990


Soil Description	Light brown/grey slightly slightly gravelly SILT/CLAY				Date	4-Aug-20
Test Method	BS 1377: Part 4 : 1990 :7.4					
Force Measuring Device	VJT 08211					Test 1
Preperatic Remoulded with 2.5 kg rammer at natural moisture content						
Surcharge	10 kPa		Mean Calibration		4.33	N/Div
Penetration	Force Gauge		Force on		4.33	N/Div
of plunger	reading		plunger		California Bearing Ratio Results	%
mm	divisions		kN			
	Top	Bottom	Top	Bottom	Top	Base
0.00	0.0	0.0	0.000	0.000		
0.25	23.0	33.0	0.100	0.143		
0.50	49.0	67.0	0.212	0.290		
0.75	75.0	100.0	0.325	0.433		
1.00	99.0	128.0	0.429	0.554		
1.25	124.0	157.0	0.537	0.680		
1.50	152.0	183.0	0.658	0.792		
1.75	179.0	208.0	0.775	0.901		
2.00	205.0	231.0	0.888	1.000		
2.25	228.0	255.0	0.987	1.104		
2.50	252.0	277.0	1.091	1.199	8.27	9.09
2.75	274.0	300.0	1.186	1.299		
3.00	294.0	318.0	1.273	1.377		
3.25	312.0	335.0	1.351	1.451		
3.50	329.0	355.0	1.425	1.537		
3.75	346.0	375.0	1.498	1.624		
4.00	363.0	391.0	1.572	1.693		
4.25	378.0	407.0	1.637	1.762		
4.50	393.0	423.0	1.702	1.832		
4.75	408.0	437.0	1.767	1.892		
5.00	421.0	452.0	1.823	1.957	9.11	9.79
5.25	435.0	467.0	1.884	2.022		
5.50	448.0	481.0	1.940	2.083		
5.75	461.0	494.0	1.996	2.139		
6.00	473.0	504.0	2.048	2.182		
6.25	485.0	517.0	2.100	2.239		
6.50	495.0	527.0	2.143	2.282		
6.75	506.0	539.0	2.191	2.334		
7.00	517.0	551.0	2.239	2.386		
7.25	527.0	563.0	2.282	2.438		
7.50	538.0	572.0	2.330	2.477		
Moisture content after test		Top	Middle	Base	Specimen wt g	4870
Container No.		Tray	Tray	Tray	Diameter mm	152
Mass of wet soil + container	g	1690.0	1989.0	1714.0	Length mm	127.0
Mass of dry soil + container	g	1499.0	1758.0	1519.0		
Weight of container	g	191.0	142.0	191.0		
Mass of moisture	g	191.0	231.0	195.0	Average MC %	14.53
Dry weight	g	1308.0	1616.0	1328.0	Density Mg/m3	2.11
Moisture content	%	14.60	14.29	14.68	Dry Density Mg/m3	1.85

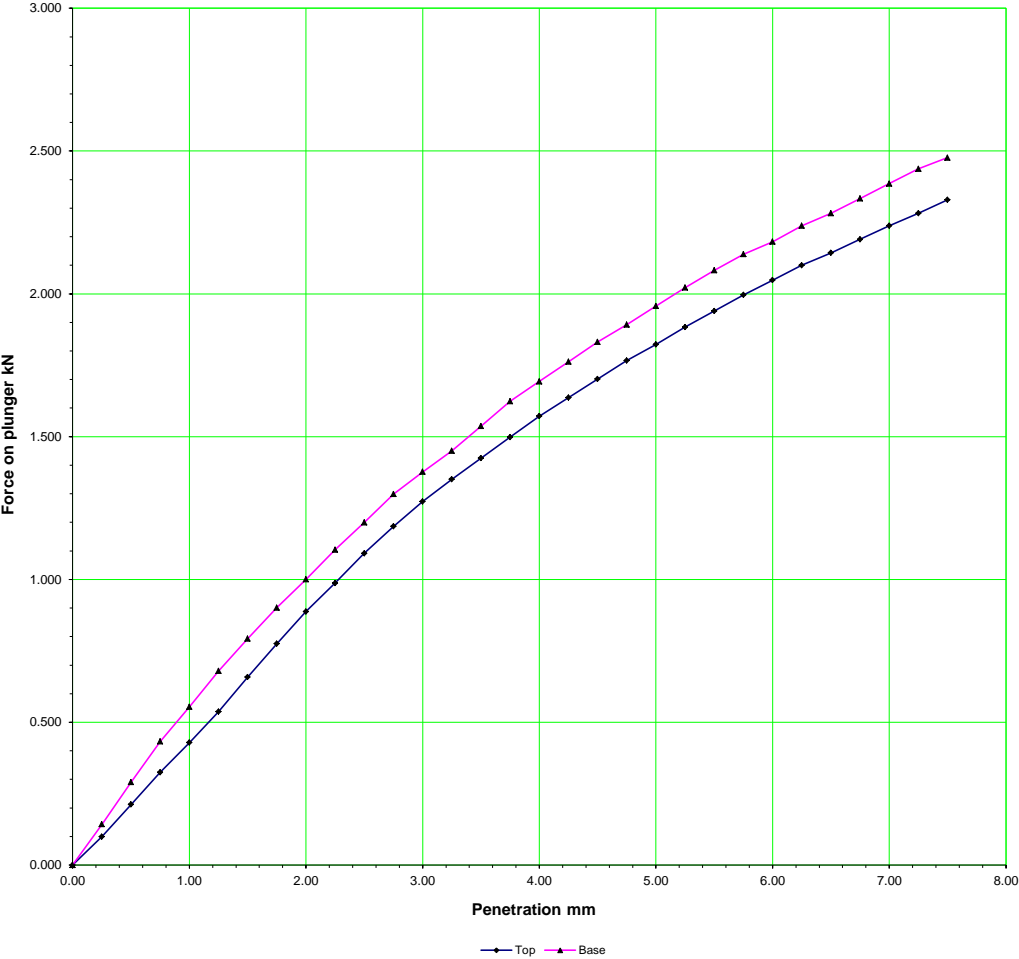

NM TL Ltd	Project: Whitehall, Swords	GII Project ID: 9225-11-19		Date	Project No.	NMTL 3243
			Operator	Ms 4-Aug-20	Trial Pit No.	TP06
			Checked	Nc	Sample No.	B
			Approved	Bc	Depth	0.60m

DETERMINATION OF THE CALIFORNIA BEARING RATIO TEST
BS 1377 : PART 4 : CLAUSE 7 : 1990

Soil Description	Grey slightly slightly gravelly SILT/CLAY				Date	7-Aug-20	
Test Method	BS 1377: Part 4 : 1990 :7.4						
Force Measuring Device	VJT 08211					Test 1	
Preparatic Remoulded with 2.5 kg rammer at natural moisture content							
Surcharge	10 kPa		Mean Calibration		4.33	N/Div	
Penetration	Force Gauge		Force on		4.33	N/Div	
of plunger	reading		plunger		California Bearing Ratio	Results	%
mm	divisions		kN				
	Top	Bottom	Top	Bottom	Top	Base	
0.00	0.0	0.0	0.000	0.000			
0.25	4.0	3.0	0.017	0.013			
0.50	6.0	5.0	0.026	0.022			
0.75	9.0	7.0	0.039	0.030			
1.00	11.0	9.0	0.048	0.039			
1.25	14.0	11.0	0.061	0.048			
1.50	16.0	12.0	0.069	0.052			
1.75	19.0	14.0	0.082	0.061			
2.00	21.0	15.0	0.091	0.065			
2.25	24.0	18.0	0.104	0.078			
2.50	26.0	20.0	0.113	0.087	0.85	0.66	
2.75	28.0	21.0	0.121	0.091			
3.00	31.0	23.0	0.134	0.100			
3.25	34.0	25.0	0.147	0.108			
3.50	36.0	26.0	0.156	0.113			
3.75	38.0	28.0	0.165	0.121			
4.00	40.0	30.0	0.173	0.130			
4.25	42.0	31.0	0.182	0.134			
4.50	44.0	33.0	0.191	0.143			
4.75	46.0	35.0	0.199	0.152			
5.00	49.0	36.0	0.212	0.156	1.06	0.78	
5.25	51.0	37.0	0.221	0.160			
5.50	53.0	39.0	0.229	0.169			
5.75	55.0	40.0	0.238	0.173			
6.00	58.0	42.0	0.251	0.182			
6.25	60.0	44.0	0.260	0.191			
6.50	62.0	45.0	0.268	0.195			
6.75	63.0	46.0	0.273	0.199			
7.00	65.0	47.0	0.281	0.204			
7.25	67.0	49.0	0.290	0.212			
7.50	70.0	50.0	0.303	0.217			
Moisture content after test		Top	Middle	Base	Specimen wt g	5240	
Container No.		Tray	Tray	Tray	Diameter mm	152	
Mass of wet soil + container	g	2084.0	1875.0	1799.0	Length mm	127.0	
Mass of dry soil + container	g	1890.0	1685.0	1628.0			
Weight of container	g	193.0	138.0	188.0			
Mass of moisture	g	194.0	190.0	171.0	Average MC %	11.86	
Dry weight	g	1697.0	1547.0	1440.0	Density Mg/m3	2.27	
Moisture content	%	11.43	12.28	11.88	Dry Density Mg/m3	2.03	

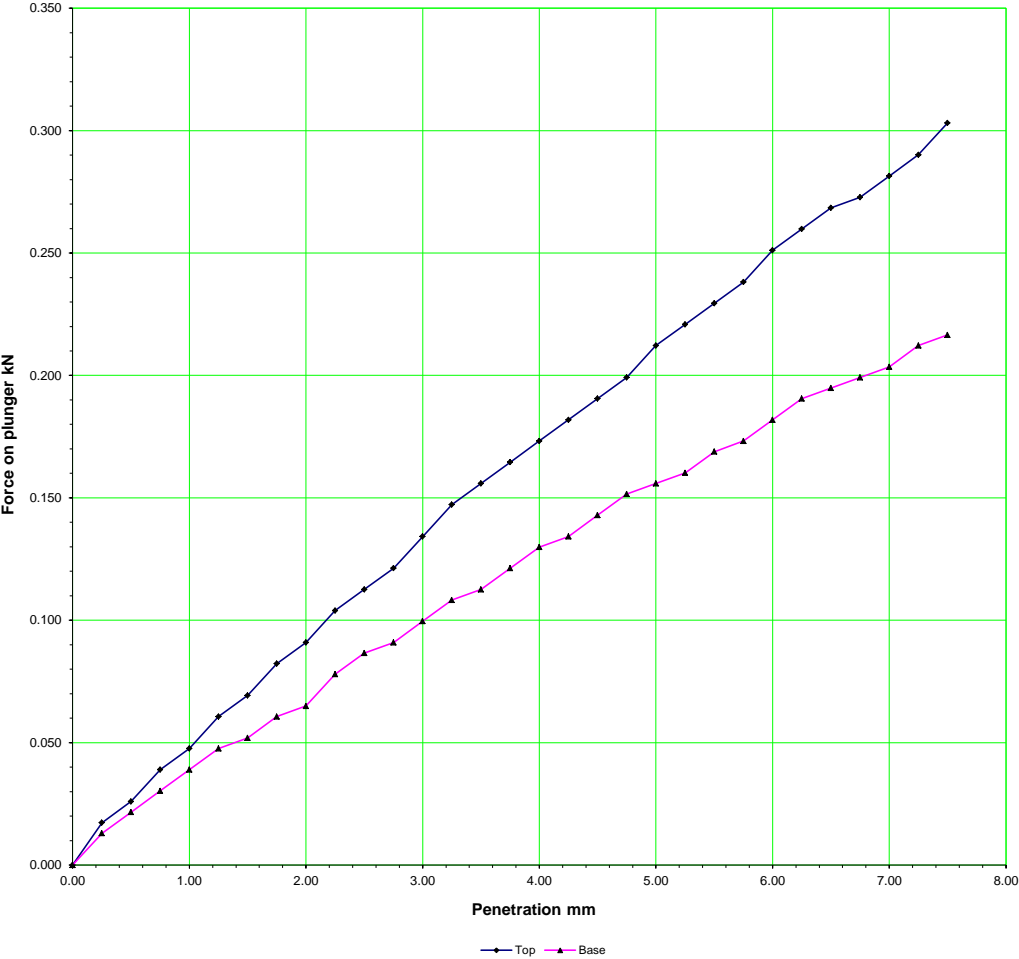


NM TL Ltd	Project: Whitehall, Swords	Date		Project No.	NMTL 3243
		Operator	Ms 7-Aug-20	Trial Pit No.	TP06
		Checked	Nc	Sample No.	B
		Approved	Bc	Depth	3.70m

GII Project ID: 9225-11-19

DETERMINATION OF THE CALIFORNIA BEARING RATIO TEST
BS 1377 : PART 4 : CLAUSE 7 : 1990


Soil Description	Grey/brown slightly slightly gravelly clayey SILT				Date	4-Aug-20
Test Method	BS 1377: Part 4 : 1990 :7.4					
Force Measuring Device	VJT 08211					Test 1
Preparatic Remoulded with 2.5 kg rammer at natural moisture content						
Surcharge	10 kPa		Mean Calibration		4.33	N/Div
Penetration	Force Gauge		Force on		4.33	N/Div
of plunger	reading		plunger		California Bearing Ratio Results	%
mm	divisions		kN			
	Top	Bottom	Top	Bottom	Top	Base
0.00	0.0	0.0	0.000	0.000		
0.25	1.0	0.5	0.004	0.002		
0.50	1.0	0.5	0.004	0.002		
0.75	1.5	1.0	0.006	0.004		
1.00	2.0	1.0	0.009	0.004		
1.25	2.0	1.5	0.009	0.006		
1.50	2.5	2.0	0.011	0.009		
1.75	3.0	2.0	0.013	0.009		
2.00	3.0	2.0	0.013	0.009		
2.25	3.5	2.5	0.015	0.011		
2.50	4.0	3.0	0.017	0.013	0.13	0.10
2.75	4.0	3.0	0.017	0.013		
3.00	4.5	3.5	0.019	0.015		
3.25	5.0	3.5	0.022	0.015		
3.50	5.0	3.5	0.022	0.015		
3.75	5.0	4.0	0.022	0.017		
4.00	5.5	4.0	0.024	0.017		
4.25	5.5	4.0	0.024	0.017		
4.50	6.0	4.5	0.026	0.019		
4.75	6.0	5.0	0.026	0.022		
5.00	6.5	5.0	0.028	0.022	0.14	0.11
5.25	6.5	5.0	0.028	0.022		
5.50	7.0	5.0	0.030	0.022		
5.75	7.0	5.5	0.030	0.024		
6.00	7.5	5.5	0.032	0.024		
6.25	8.0	6.0	0.035	0.026		
6.50	8.0	6.0	0.035	0.026		
6.75	8.0	6.0	0.035	0.026		
7.00	8.0	6.0	0.035	0.026		
7.25	8.5	6.5	0.037	0.028		
7.50	8.5	6.5	0.037	0.028		
Moisture content after test		Top	Middle	Base	Specimen wt g	4105
Container No.		Tray	Tray	Tray	Diameter mm	152
Mass of wet soil + container	g	1628.0	1699.0	1252.0	Length mm	127.0
Mass of dry soil + container	g	1250.0	1295.0	962.0		
Weight of container	g	185.0	145.0	145.0		
Mass of moisture	g	378.0	404.0	290.0	Average MC %	35.37
Dry weight	g	1065.0	1150.0	817.0	Density Mg/m3	1.78
Moisture content	%	35.49	35.13	35.50	Dry Density Mg/m3	1.32

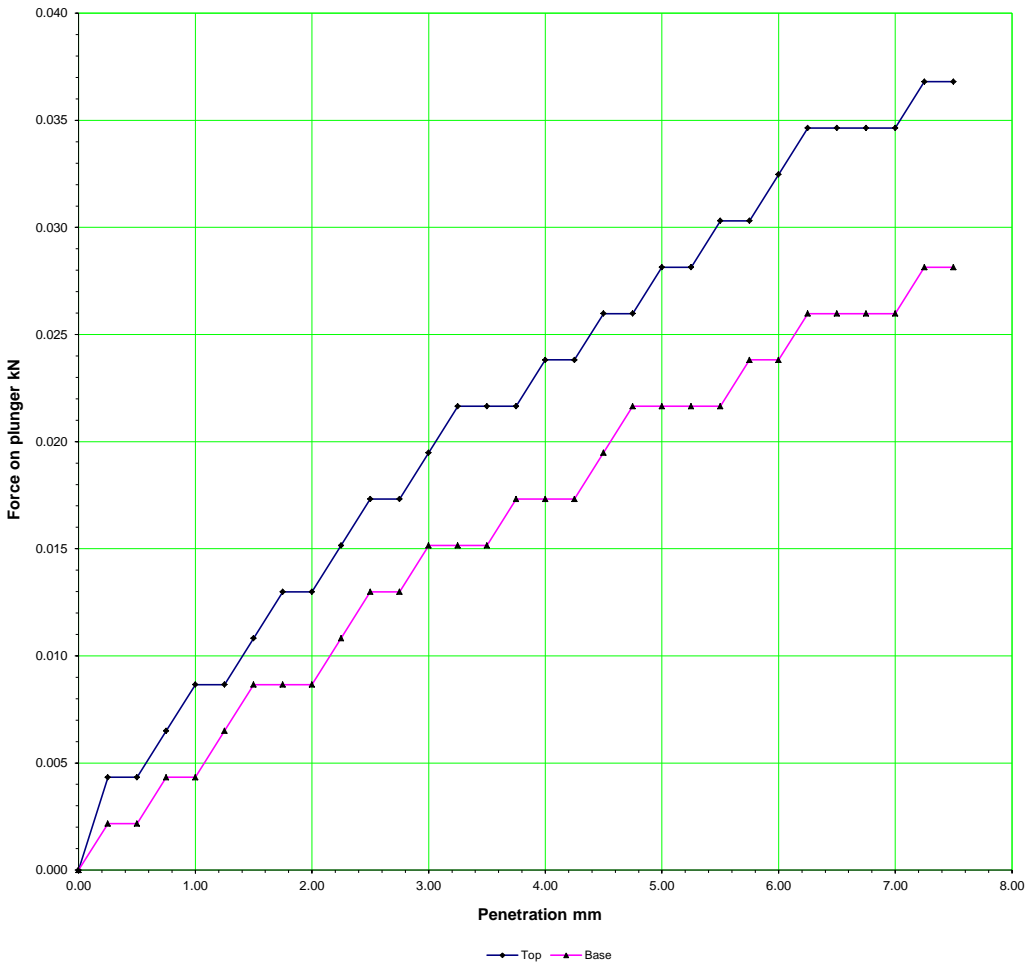

NM TL Ltd	Project: Whitehall, Swords	GII Project ID: 9225-11-19		Date	Project No.	NMTL 3243
			Operator	Ms 4-Aug-20	Trial Pit No.	TP07
			Checked	Nc	Sample No.	B
			Approved	Bc	Depth	0.70m

DETERMINATION OF THE CALIFORNIA BEARING RATIO TEST
BS 1377 : PART 4 : CLAUSE 7 : 1990

Soil Description	Light brown slightly slightly gravelly SILT/CLAY				Date	6-Aug-20	
Test Method	BS 1377: Part 4 : 1990 :7.4						
Force Measuring Device	VJT 08211					Test 1	
Preparatic Remoulded with 2.5 kg rammer at natural moisture content							
Surcharge	10 kPa		Mean Calibration		4.33	N/Div	
Penetration	Force Gauge		Force on		4.33	N/Div	
of plunger	reading		plunger		California Bearing Ratio	Results	
mm	divisions		kN			%	
	Top	Bottom	Top	Bottom	Top	Base	
0.00	0.0	0.0	0.000	0.000			
0.25	1.0	1.0	0.004	0.004			
0.50	2.0	2.0	0.009	0.009			
0.75	2.5	2.5	0.011	0.011			
1.00	3.0	3.0	0.013	0.013			
1.25	3.5	4.0	0.015	0.017			
1.50	4.0	4.5	0.017	0.019			
1.75	5.0	5.0	0.022	0.022			
2.00	5.0	5.0	0.022	0.022			
2.25	5.5	6.0	0.024	0.026			
2.50	5.5	6.5	0.024	0.028	0.18	0.21	
2.75	6.0	7.0	0.026	0.030			
3.00	6.5	7.0	0.028	0.030			
3.25	7.0	7.5	0.030	0.032			
3.50	7.5	8.0	0.032	0.035			
3.75	8.0	8.5	0.035	0.037			
4.00	8.5	9.0	0.037	0.039			
4.25	9.0	9.5	0.039	0.041			
4.50	9.5	10.0	0.041	0.043			
4.75	10.0	10.5	0.043	0.045			
5.00	10.0	10.5	0.043	0.045	0.22	0.23	
5.25	10.0	11.0	0.043	0.048			
5.50	10.5	11.5	0.045	0.050			
5.75	11.0	12.0	0.048	0.052			
6.00	11.0	13.0	0.048	0.056			
6.25	11.5	13.5	0.050	0.058			
6.50	12.0	14.0	0.052	0.061			
6.75	12.0	14.0	0.052	0.061			
7.00	12.5	14.5	0.054	0.063			
7.25	12.5	14.5	0.054	0.063			
7.50	13.0	15.0	0.056	0.065			
Moisture content after test		Top	Middle	Base	Specimen wt g	5035	
Container No.		Tray	Tray	Tray	Diameter mm	152	
Mass of wet soil + container	g	1923.0	2048.0	1513.0	Length mm	127.0	
Mass of dry soil + container	g	1685.0	1798.0	1335.0			
Weight of container	g	147.0	146.0	166.0			
Mass of moisture	g	238.0	250.0	178.0	Average MC %	15.28	
Dry weight	g	1538.0	1652.0	1169.0	Density Mg/m3	2.18	
Moisture content	%	15.47	15.13	15.23	Dry Density Mg/m3	1.90	

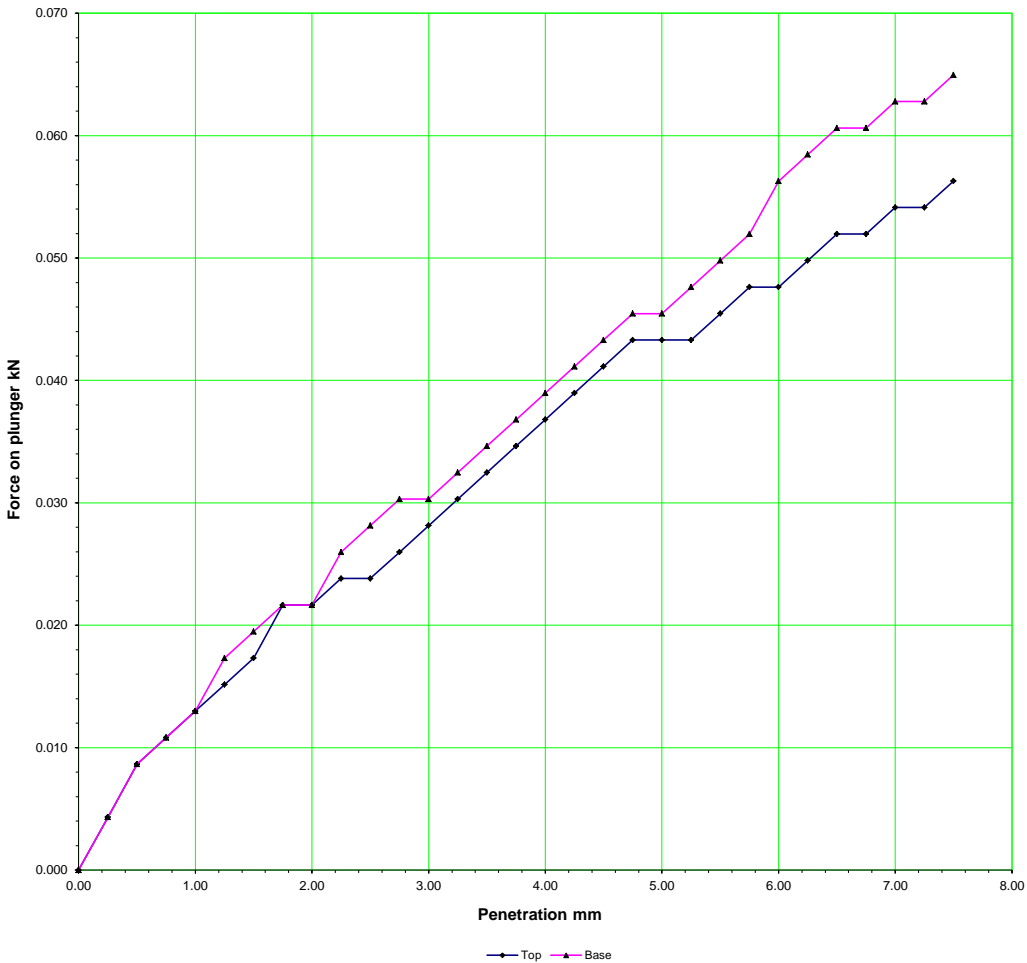


NM TL Ltd	Project: Whitehall, Swords	Date		Project No.	NMTL 3243
		Operator	Ms 6-Aug-20	Trial Pit No.	TP07
		Checked	Nc	Sample No.	B
		Approved	Bc	Depth	3.30m

GII Project ID: 9225-11-19

DETERMINATION OF THE CALIFORNIA BEARING RATIO TEST
BS 1377 : PART 4 : CLAUSE 7 : 1990


Soil Description	Brown slightly slightly gravelly SILT/CLAY				Date	4-Aug-20
Test Method	BS 1377: Part 4 : 1990 :7.4					
Force Measuring Device	S86-010304					Test 1
Preparatic Remoulded with 2.5 kg rammer at natural moisture content						
Surcharge	10 kPa		Mean Calibration		26.46	N/Div
Penetration	Force Gauge		Force on		26.46	N/Div
of plunger	reading		plunger		California Bearing Ratio Results	%
mm	divisions		kN			
	Top	Bottom	Top	Bottom	Top	Base
0.00	0.0	0.0	0.000	0.000		
0.25	8.0	10.0	0.212	0.265		
0.50	15.0	18.0	0.397	0.476		
0.75	23.0	26.0	0.609	0.688		
1.00	30.0	33.0	0.794	0.873		
1.25	38.0	40.0	1.005	1.058		
1.50	47.0	46.0	1.244	1.217		
1.75	53.0	51.0	1.402	1.349		
2.00	60.0	56.0	1.588	1.482		
2.25	66.0	60.0	1.746	1.588		
2.50	70.0	65.0	1.852	1.720	14.03	13.03
2.75	75.0	68.0	1.985	1.799		
3.00	79.0	72.0	2.090	1.905		
3.25	83.0	75.0	2.196	1.985		
3.50	88.0	78.0	2.328	2.064		
3.75	92.0	82.0	2.434	2.170		
4.00	95.0	85.0	2.514	2.249		
4.25	99.0	87.0	2.620	2.302		
4.50	102.0	90.0	2.699	2.381		
4.75	105.0	92.0	2.778	2.434		
5.00	108.0	95.0	2.858	2.514	14.29	12.57
5.25	112.0	97.0	2.964	2.567		
5.50	115.0	99.0	3.043	2.620		
5.75	118.0	101.0	3.122	2.672		
6.00	121.0	103.0	3.202	2.725		
6.25	124.0	105.0	3.281	2.778		
6.50	126.0	107.0	3.334	2.831		
6.75	129.0	109.0	3.413	2.884		
7.00	131.0	112.0	3.466	2.964		
7.25	133.0	114.0	3.519	3.016		
7.50	135.0	116.0	3.572	3.069		
Moisture content after test		Top	Middle	Base	Specimen wt g	4570
Container No.		Tray	Tray	Tray	Diameter mm	152
Mass of wet soil + container	g	1930.0	1579.0	1620.0	Length mm	127.0
Mass of dry soil + container	g	1704.0	1403.0	1437.0		
Weight of container	g	189.0	186.0	187.0		
Mass of moisture	g	226.0	176.0	183.0	Average MC %	14.67
Dry weight	g	1515.0	1217.0	1250.0	Density Mg/m3	1.98
Moisture content	%	14.92	14.46	14.64	Dry Density Mg/m3	1.73

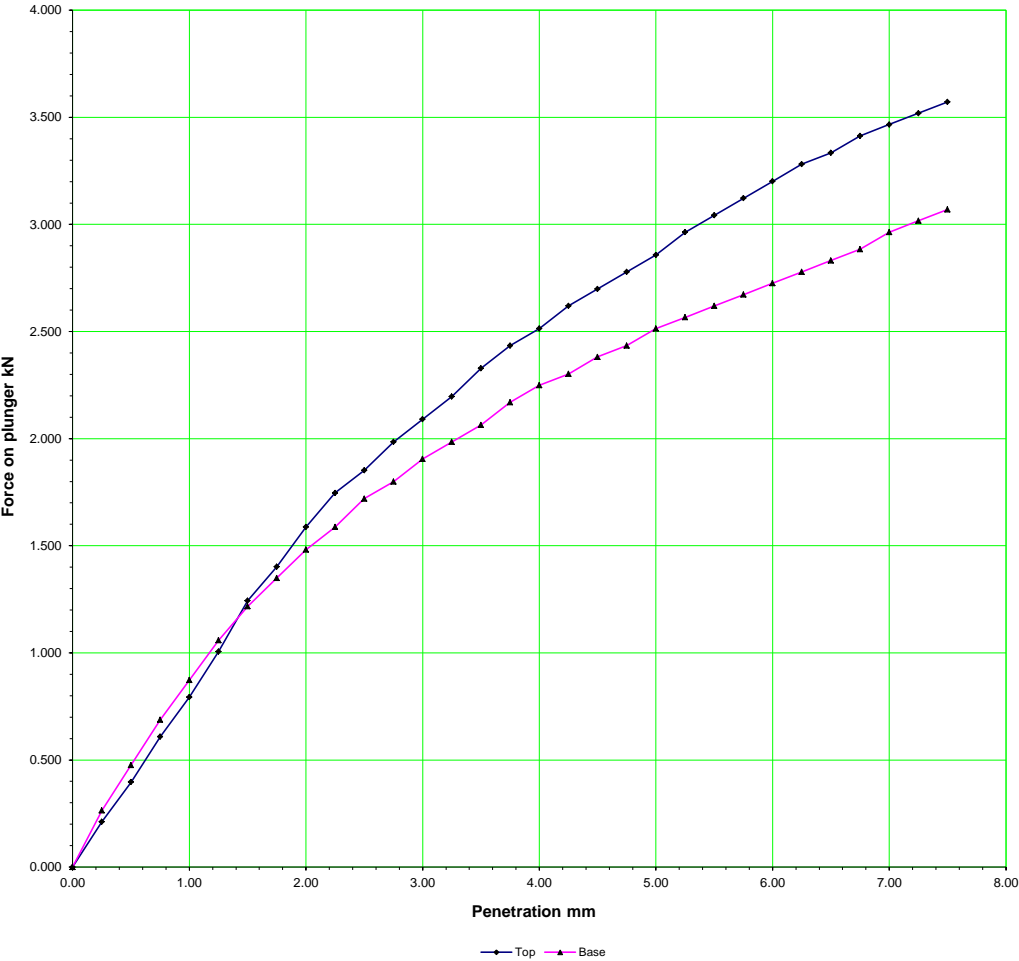

NM TL Ltd	Project: Whitehall, Swords	GII Project ID: 9225-11-19		Date	Project No.	NMTL 3243
			Operator	Ms 4-Aug-20	Trial Pit No.	TP08
			Checked	Nc	Sample No.	B
			Approved	Bc	Depth	0.70m

DETERMINATION OF THE CALIFORNIA BEARING RATIO TEST
BS 1377 : PART 4 : CLAUSE 7 : 1990

Soil Description	Brown slightly slightly gravelly SILT/CLAY				Date	4-Aug-20
Test Method	BS 1377: Part 4 : 1990 :7.4					
Force Measuring Device	VJT 08211					Test 1
Preparatic Remoulded with 2.5 kg rammer at natural moisture content						
Surcharge	10 kPa		Mean Calibration		4.33	N/Div
Penetration	Force Gauge		Force on		4.33	N/Div
of plunger	reading		plunger		California Bearing Ratio	Results
mm	divisions		kN			
	Top	Bottom	Top	Bottom	Top	Base
0.00	0.0	0.0	0.000	0.000		
0.25	6.0	7.0	0.026	0.030		
0.50	10.0	10.0	0.043	0.043		
0.75	14.0	14.0	0.061	0.061		
1.00	18.0	17.0	0.078	0.074		
1.25	22.0	21.0	0.095	0.091		
1.50	26.0	24.0	0.113	0.104		
1.75	30.0	28.0	0.130	0.121		
2.00	34.0	31.0	0.147	0.134		
2.25	39.0	35.0	0.169	0.152		
2.50	43.0	38.0	0.186	0.165	1.41	1.25
2.75	48.0	42.0	0.208	0.182		
3.00	53.0	45.0	0.229	0.195		
3.25	57.0	50.0	0.247	0.217		
3.50	62.0	54.0	0.268	0.234		
3.75	68.0	59.0	0.294	0.255		
4.00	73.0	62.0	0.316	0.268		
4.25	79.0	67.0	0.342	0.290		
4.50	84.0	70.0	0.364	0.303		
4.75	89.0	75.0	0.385	0.325		
5.00	94.0	79.0	0.407	0.342	2.04	1.71
5.25	98.0	83.0	0.424	0.359		
5.50	101.0	87.0	0.437	0.377		
5.75	107.0	90.0	0.463	0.390		
6.00	111.0	95.0	0.481	0.411		
6.25	115.0	98.0	0.498	0.424		
6.50	119.0	102.0	0.515	0.442		
6.75	124.0	105.0	0.537	0.455		
7.00	126.0	109.0	0.546	0.472		
7.25	130.0	112.0	0.563	0.485		
7.50	134.0	116.0	0.580	0.502		
Moisture content after test		Top	Middle	Base	Specimen wt g	5145
Container No.		Tray	963	Tray	Diameter mm	152
Mass of wet soil + container	g	2075.0	1963.0	1543.0	Length mm	127.0
Mass of dry soil + container	g	1862.0	1762.0	1384.0		
Weight of container	g	146.0	145.0	144.0		
Mass of moisture	g	213.0	201.0	159.0	Average MC %	12.56
Dry weight	g	1716.0	1617.0	1240.0	Density Mg/m3	2.23
Moisture content	%	12.41	12.43	12.82	Dry Density Mg/m3	1.98

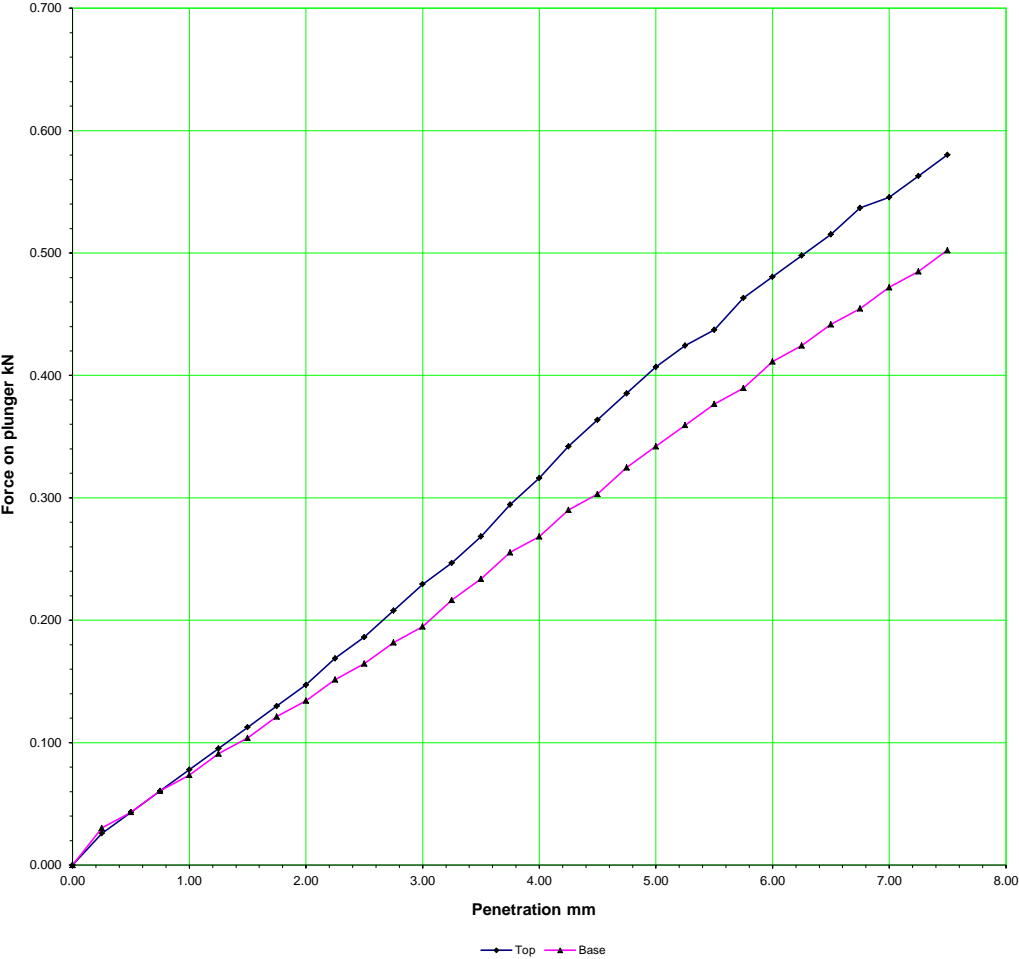

NM TL Ltd	Project: Whitehall, Swords	Date		Project No.	NMTL 3243
		Operator	Ms 4-Aug-20	Trial Pit No.	TP09
		Checked	Nc	Sample No.	B
		Approved	Bc	Depth	1.90m

GII Project ID: 9225-11-19

National Materials Testing Laboratory Ltd

Unit 18C Tullow Industrial Estate

Tel.: 059 9180822

Certificate of Test

Determination of the Undrained Shear Strength in Triaxial Compression

BS 1377 : Part 7 : 1990 Clause 8

Client Name: **Ground Investigations Ireland Ltd**
Address: **Catherinstown House**
Hazelhatch
Newcastle, Co. Dublin

Contract: **Whitehall, Swords**

Site Address: **N/A**

GII Project ID: **9225-11-19**

Sample No.: **BH04** Core Depth: **10.5-10.90m** File Reference: **NMTL 3243**

Sample Description: **Very stiff grey/brown slightly sandy slightly gravelly silty CLAY.**

Location: **Whitehall, Swords**

Date Sampled: **N/A**

Sample Type: **Core**

Sampled by: **Ground Investigations Ireland Ltd**

Client Sample Ref.: **BH04-C-10.5-10.95m**

Sampling Cert. Recd.: **No**

Source / Supplier: **GII**

Date Received: **27 July 2020**

Specification: **BS 1377: Part 7: 1990 Clause 8**

Date Tested: **11 August 2020**


Specimen

Length: **205.5** mm Diameter: **102.1** mm
Area: **8192.1** mm² Volume: **1683.5** cm³
Mass: **3873.0** g
Moisture content: **8.9** %
Bulk density: **2.30** Mg m⁻³
Dry density: **2.11** Mg m⁻³
Preparation Method: **BS 1377: Part 1: 1990 Clause 8 .3.1**

Test

Membrane type: **Latex**
Membrane thickness: **0.3** mm
Membrane correction: **1.02**
Sample state: **Undisturbed**
Number of stages: **Single**
Rate of strain: **1.0** % min⁻¹
Cell pressure: σ_3 **130** kPa

Axial Strain vs. Deviator Stress

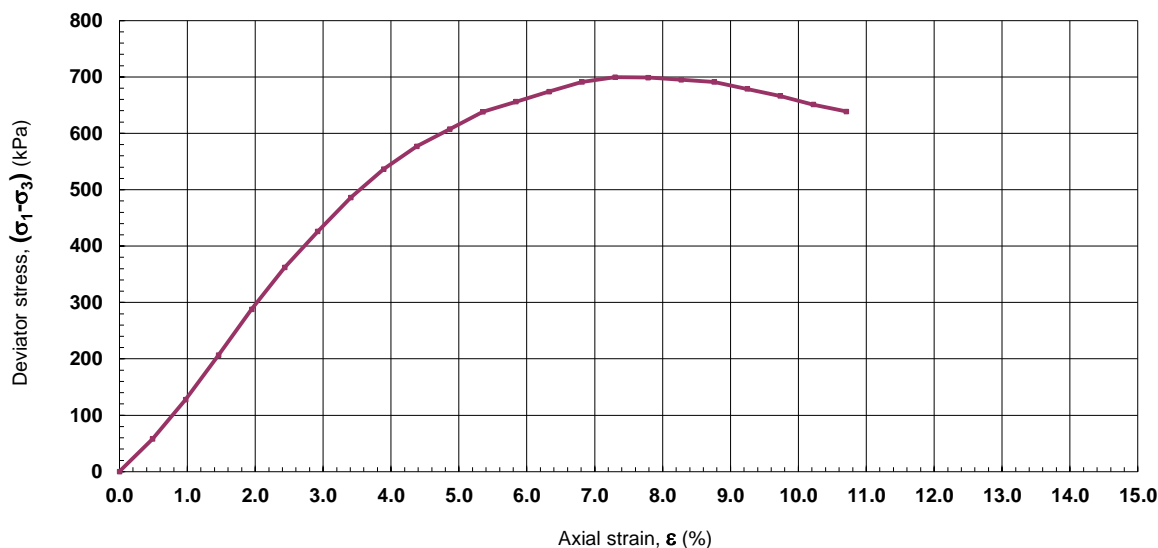

Maximum Corrected Deviator Stress at Failure:

$(\sigma_1 - \sigma_3)_f$

699.6 kPa

Strain at Failure:

ϵ

7.30 %

Maximum Cohesion / Shear Strength:

C_u

349.8 kPa

Type of Failure:

Brittle

Signed

Authorised Signatories

☐ N Chana

☐ B Chana

For NMTL Ltd

19 August 2020

Remarks: Specimen prepared with high speed diamond cutting wheel

Original to: **Client Rep.**

Copy 1 to: **File copy**

National Materials Testing Laboratory Ltd

Unit 18C Tullow Industrial Estate

Tel.: 059 9180822

Certificate of Test

Determination of the Undrained Shear Strength in Triaxial Compression

BS 1377 : Part 7 : 1990 Clause 8

Client Name: **Ground Investigations Ireland Ltd**
Address: **Catherinstown House**
Hazelhatch
Newcastle, Co. Dublin

Contract: **Whitehall, Swords**

Site Address: **N/A**

GII Project ID: **9225-11-19**

Sample No.: **BH05** Core Depth: **8.30-8.70m** File Reference: **NMTL 3243**

Sample Description: **Very stiff grey/brown slightly sandy slightly gravelly silty CLAY.**

Location: **Whitehall, Swords**

Date Sampled: **N/A**

Sample Type: **Core**

Sampled by: **Ground Investigations Ireland Ltd**

Client Sample Ref.: **BH05-C-8.30-8.70m**

Sampling Cert. Recd.: **No**

Source / Supplier: **GII**

Date Received: **27 July 2020**

Specification: **BS 1377: Part 7: 1990 Clause 8**


Date Tested: **11 August 2020**

Specimen

Length: **207.0** mm Diameter: **101.1** mm
Area: **8029.3** mm² Volume: **1662.1** cm³
Mass: **3886.0** g
Moisture content: **7.5** %
Bulk density: **2.34** Mg m⁻³
Dry density: **2.18** Mg m⁻³
Preparation Method: **BS 1377: Part 1: 1990 Clause 8.3.1**

Test

Membrane type: **Latex**
Membrane thickness: **0.3** mm
Membrane correction: **0.54**
Sample state: **Undisturbed**
Number of stages: **Single**
Rate of strain: **1.0** % min⁻¹
Cell pressure: σ_3 **100** kPa

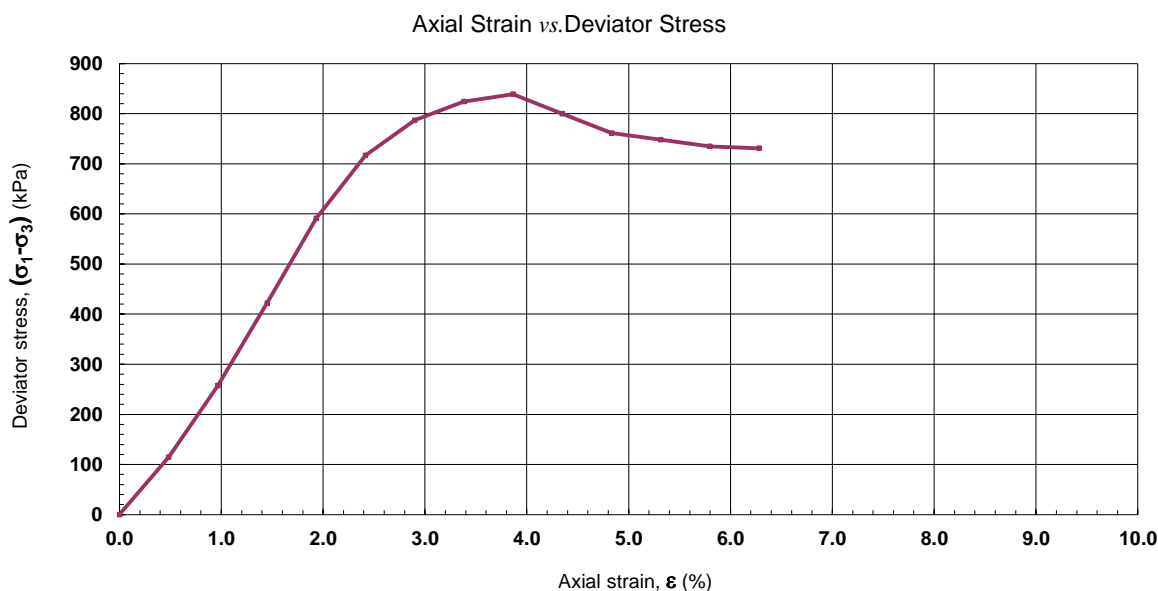

Maximum Corrected Deviator Stress at Failure:

$(\sigma_1 - \sigma_3)_f$

839.0 kPa

Strain at Failure:

ϵ

3.86 %

Maximum Cohesion / Shear Strength:

C_u

419.5 kPa

Type of Failure:

Brittle

Signed

Authorised Signatories

☐ N Chana

☐ B Chana

For NMTL Ltd

19 August 2020

Remarks: Specimen prepared with high speed diamond cutting wheel

Original to: **Client Rep.**

Copy 1 to: **File copy**

National Materials Testing Laboratory Ltd

Unit 18C Tullow Industrial Estate

Tel.: 059 9180822

Certificate of Test

Determination of the Undrained Shear Strength in Triaxial Compression

BS 1377 : Part 7 : 1990 Clause 8

Client Name: **Ground Investigations Ireland Ltd**
Address: **Catherinstown House**
Hazelhatch
Newcastle, Co. Dublin

Contract: **Whitehall, Swords**

Site Address: **N/A**

GII Project ID: **9225-11-19**

Sample No.: **BH09** Core Depth: **19.7-20.0m** File Reference: **NMTL 3243**

Sample Description: **Very stiff grey slightly sandy slightly gravelly silty CLAY.**

Location: **Whitehall, Swords**

Date Sampled: **N/A**

Sample Type: **Core**

Sampled by: **Ground Investigations Ireland Ltd**

Client Sample Ref.: **BH09-C-19.7-20.0m**

Sampling Cert. Recd.: **No**

Source / Supplier: **GII**

Date Received: **27 July 2020**

Specification: **BS 1377: Part 7: 1990 Clause 8**

Date Tested: **11 August 2020**


Specimen

Length: **202.5** mm Diameter: **100.7** mm
Area: **7962.7** mm² Volume: **1612.5** cm³
Mass: **3795.0** g
Moisture content: **10.9** %
Bulk density: **2.35** Mg m⁻³
Dry density: **2.12** Mg m⁻³
Preparation Method: **BS 1377: Part 1: 1990 Clause 8 .3.1**

Test

Membrane type: **Latex**
Membrane thickness: **0.3** mm
Membrane correction: **1.18**
Sample state: **Undisturbed**
Number of stages: **Single**
Rate of strain: **1.0** % min⁻¹
Cell pressure: σ_3 **220** kPa

Axial Strain vs. Deviator Stress

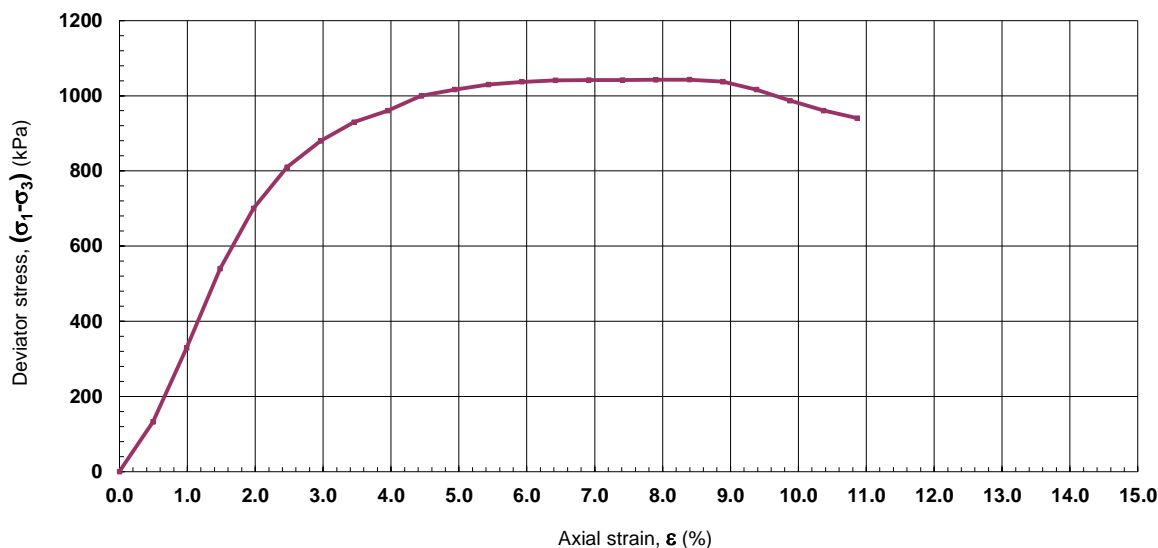

Maximum Corrected Deviator

$(\sigma_1 - \sigma_3)_f$

1042.9 kPa

Stress at Failure:

ϵ

8.40 %

Strain at Failure:

Maximum Cohesion / Shear Strength:

C_u

521.5 kPa

Type of Failure:

Brittle

Signed

Authorised Signatories

☐ N Chana

☐ B Chana

For NMTL Ltd

19 August 2020


Remarks: Specimen prepared with high speed diamond cutting wheel

Original to: **Client Rep.**

Copy 1 to: **File copy**


SUMMARY OF TEST RESULTS						
		Initial			Initial	Final
Hall Effect Gauge length	mm	n/a	Bulk Density	Mg/m3	2.32	2.35
Specimen Length	mm	202.00	Dry Density	Mg/m3	2.14	2.16
Specimen Diameter	mm	101.24	Moisture	%	8.64	9.01
Area	mm2	8049.17	Saturation	%	88.80	96.92
Volume	cc	1625.93	Sg(Assumed)	2.70		
Initial Voids ratio	e	0.2627				
Saturation Stage						
Test Stage		Cell Pressure (kPa)		Pore Pressure Parameter 'B' Base		
0		0		0		
1		50		0.12		
2		100		0.49		
3		150		0.83		
4		200		0.89		
5		300		0.93		
6		420		0.97		
Isotropic Consolidation Stage						
		Stage 1				
Cell Pressure	kPa	420				
Pore Pressure	kPa	392.4				
Back Pressure	kPa	300				
Drainage Method		One End & Radial Boundary				
t100 (min)		22.1				
Coef. Of Consolidation Cv	m2/year	9.507				
Coef. Of Compressibility Mv	m2/MN	0.100				
Permeability k	m/sec	2.935E-10				
		Stage 1				
Deviator Stress (kPa)		1035.7				
External Axial Strain (%)		16.33				
Shear Stress (kPa)		517.8				
Peak Stress Ratio		4.75				
Pore Water Pressure (kPa)		-256.6				
Radial Effective Stress (kPa)		376.6				
Axial Effective Stress (kPa)		1412.3				
Effective angle of friction (Degrees)		35.4				
Cohesion c' (kPa)	Assumed	0				
Rate of strain mm/min		0.0067				
Sample Description	Very stiff grey/brown slightly sandy gravelly silty CLAY.					
	Plastic Failure					
NM TL Ltd	Consolidated Undrained SingleTriaxial test with PWP measurement.Testesd in accordance with BS:EN ISO 17892-9-2018				Project No.	NMTL-3243
	Project: Whitehall, Swords				Borehole No.	BH09
					Sample No.	Core
					Depth.	9.65-10.0m

19/08/2020

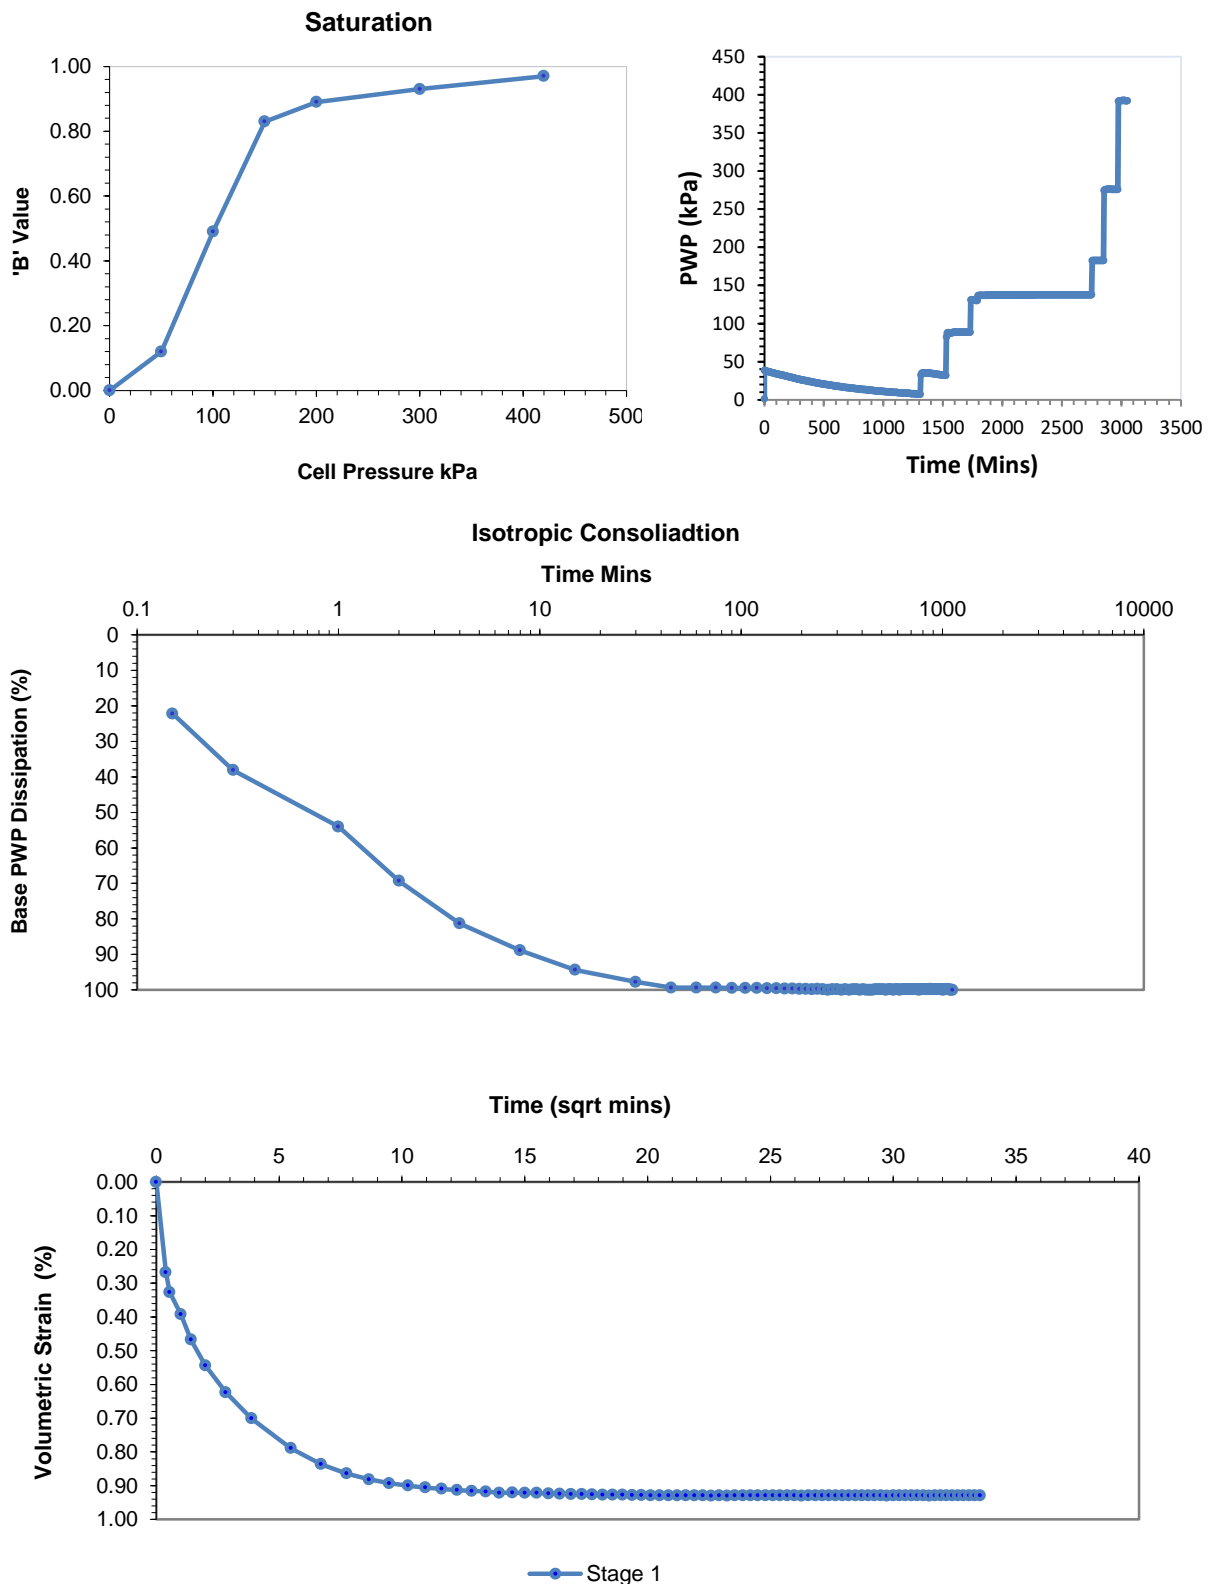

NM TL Ltd	Consolidated Undrained Single Triaxial test with PWP measurement. Tested in accordance with BS:EN ISO 17892-9:2018	Project No. NMTL-3243 Borehole No. BH09 Sample No. Core Depth. 9.65-10.0m
	Project: Whitehall, Swords	

19/08/2020

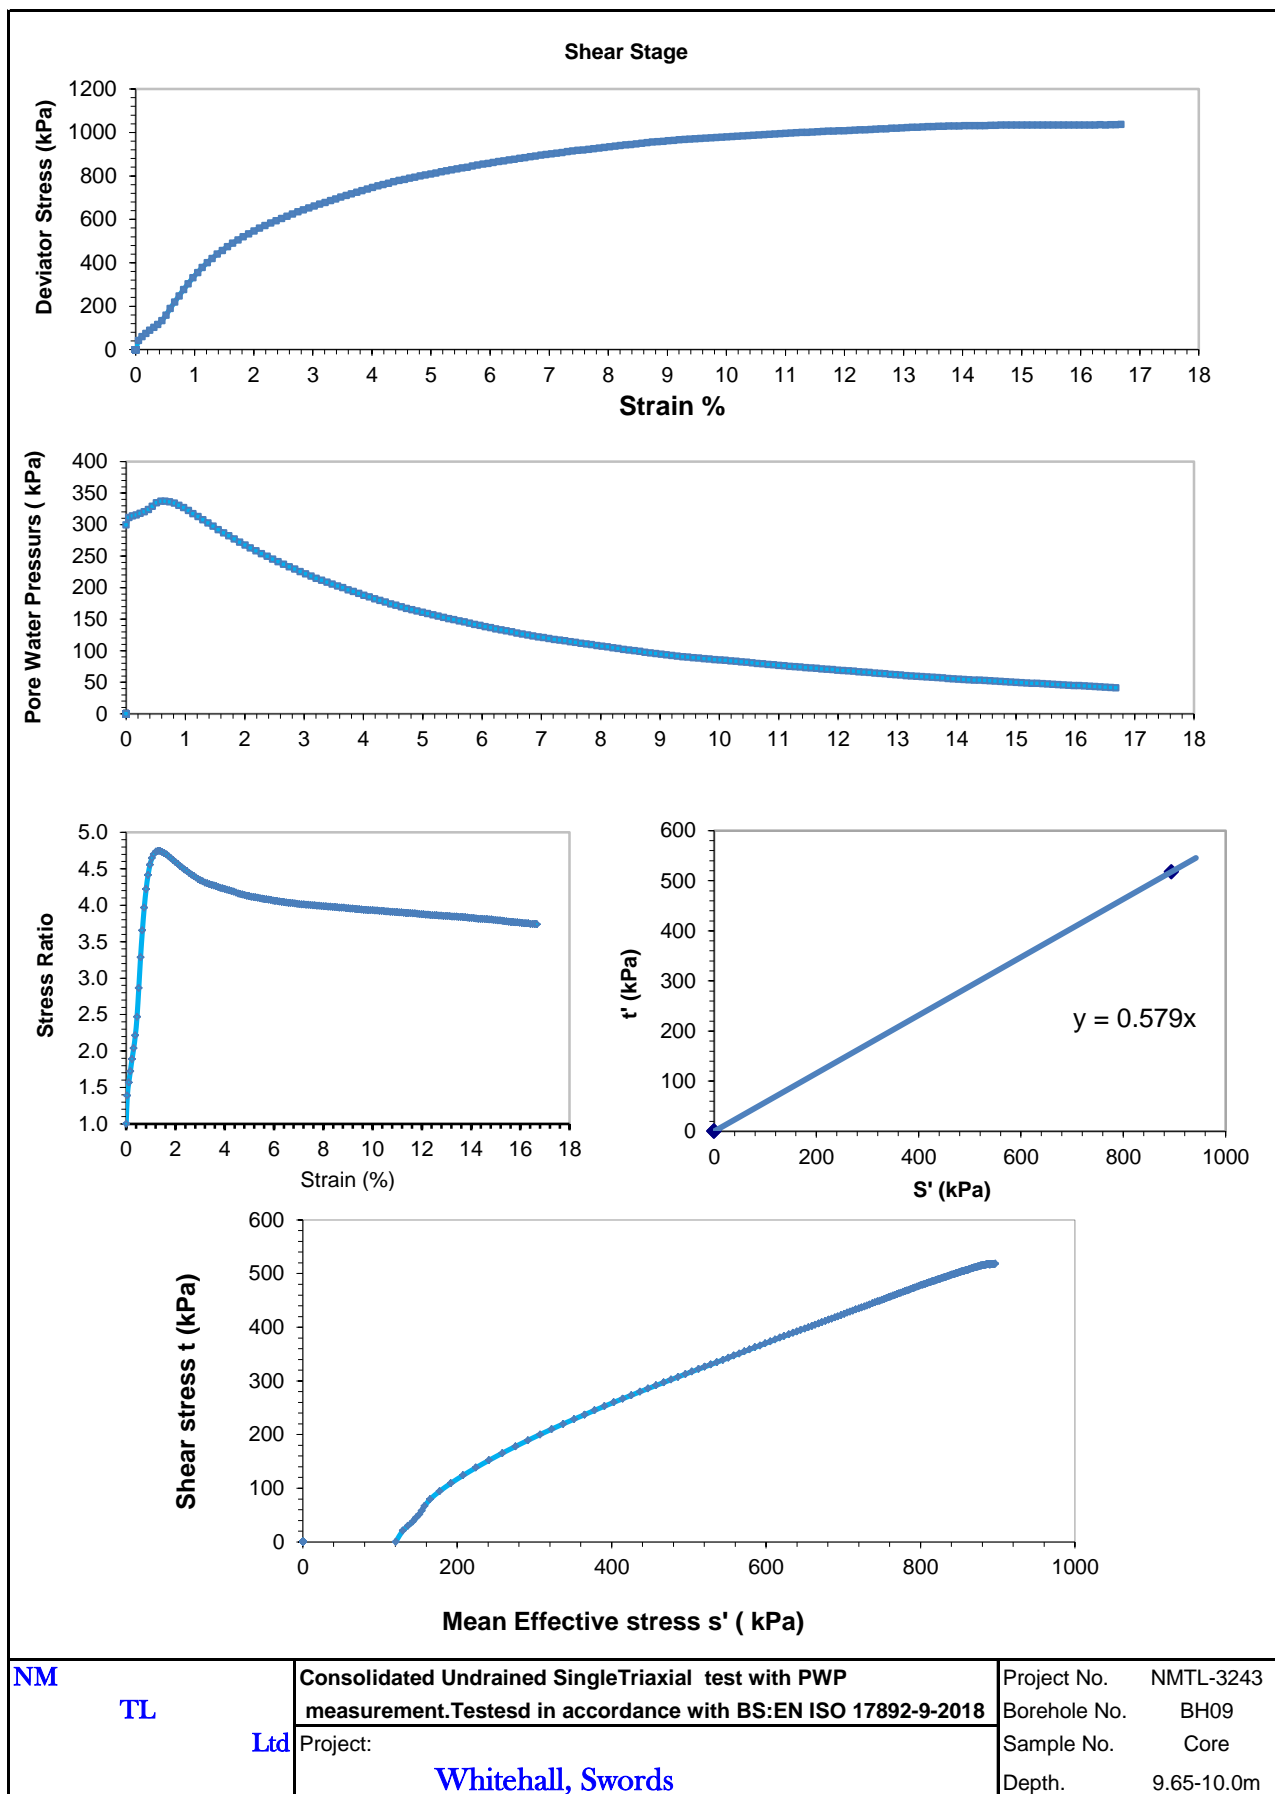

19/08/2020

SPECIMEN AFTER TEST




Soil Description Very stiff grey/brown slightly sandy gravelly silty CLAY.


NM TL Ltd	Consolidated Undrained Single Triaxial test with PWP measurement. Tested in accordance with BS:EN ISO 17892-9-2018	Project No. NMTL-3243
	Project: Whitehall, Swords	Borehole No. BH09 Sample No. Core Depth. 9.65-10.0m

19/08/2020

SUMMARY OF TEST RESULTS						
		Initial			Initial	Final
Hall Effect Gauge length	mm	n/a	Bulk Density	Mg/m3	2.30	2.34
Specimen Length	mm	201.83	Dry Density	Mg/m3	2.08	2.12
Specimen Diameter	mm	101.18	Moisture	%	10.28	10.40
Area	mm2	8040.69	Saturation	%	93.71	101.90
Volume	cc	1622.88	Sg(Assumed)	2.70		
Initial Voids ratio	e	0.2962				
Saturation Stage						
Test Stage	Cell Pressure (kPa)		Pore Pressure Parameter 'B' Base			
0	0		0			
1	50		0.37			
2	100		0.66			
3	150		0.89			
4	200		0.96			
5	300		0.96			
6	470		1.00			
Isotropic Consolidation Stage						
		Stage 1				
Cell Pressure	kPa	470				
Pore Pressure	kPa	452.9				
Back Pressure	kPa	300				
Drainage Method	One End & Radial Boundary					
t100 (min)		56.3				
Coef. Of Consolidation Cv	m2/year	3.733				
Coef. Of Compressibility Mv	m2/MN	0.104				
Permeability k	m/sec	1.207E-10				
		Stage 1				
Deviator Stress (kPa)		786.7				
External Axial Strain (%)		15.22				
Shear Stress (kPa)		393.3				
Peak Stress Ratio		4.35				
Pore Water Pressure (kPa)		-134.6				
Radial Effective Stress (kPa)		304.6				
Axial Effective Stress (kPa)		1091.3				
Effective angle of friction (Degrees)		34.3				
Cohesion c' (kPa)	Assumed	0				
Rate of strain mm/min		0.0067				
Sample Description	Very stiff grey/brown slightly gravelly slightly sandy silty CLAY.					
	Plastic Failure					
NM TL Ltd	Consolidated Undrained SingleTriaxial test with PWP measurement.Testesd in accordance with BS:EN ISO 17892-9-2018				Project No.	NMTL-3243
	Project: Whitehall, Swords				Borehole No.	BH05
					Sample No.	Core
					Depth.	14.6-15.0m

19/08/2020

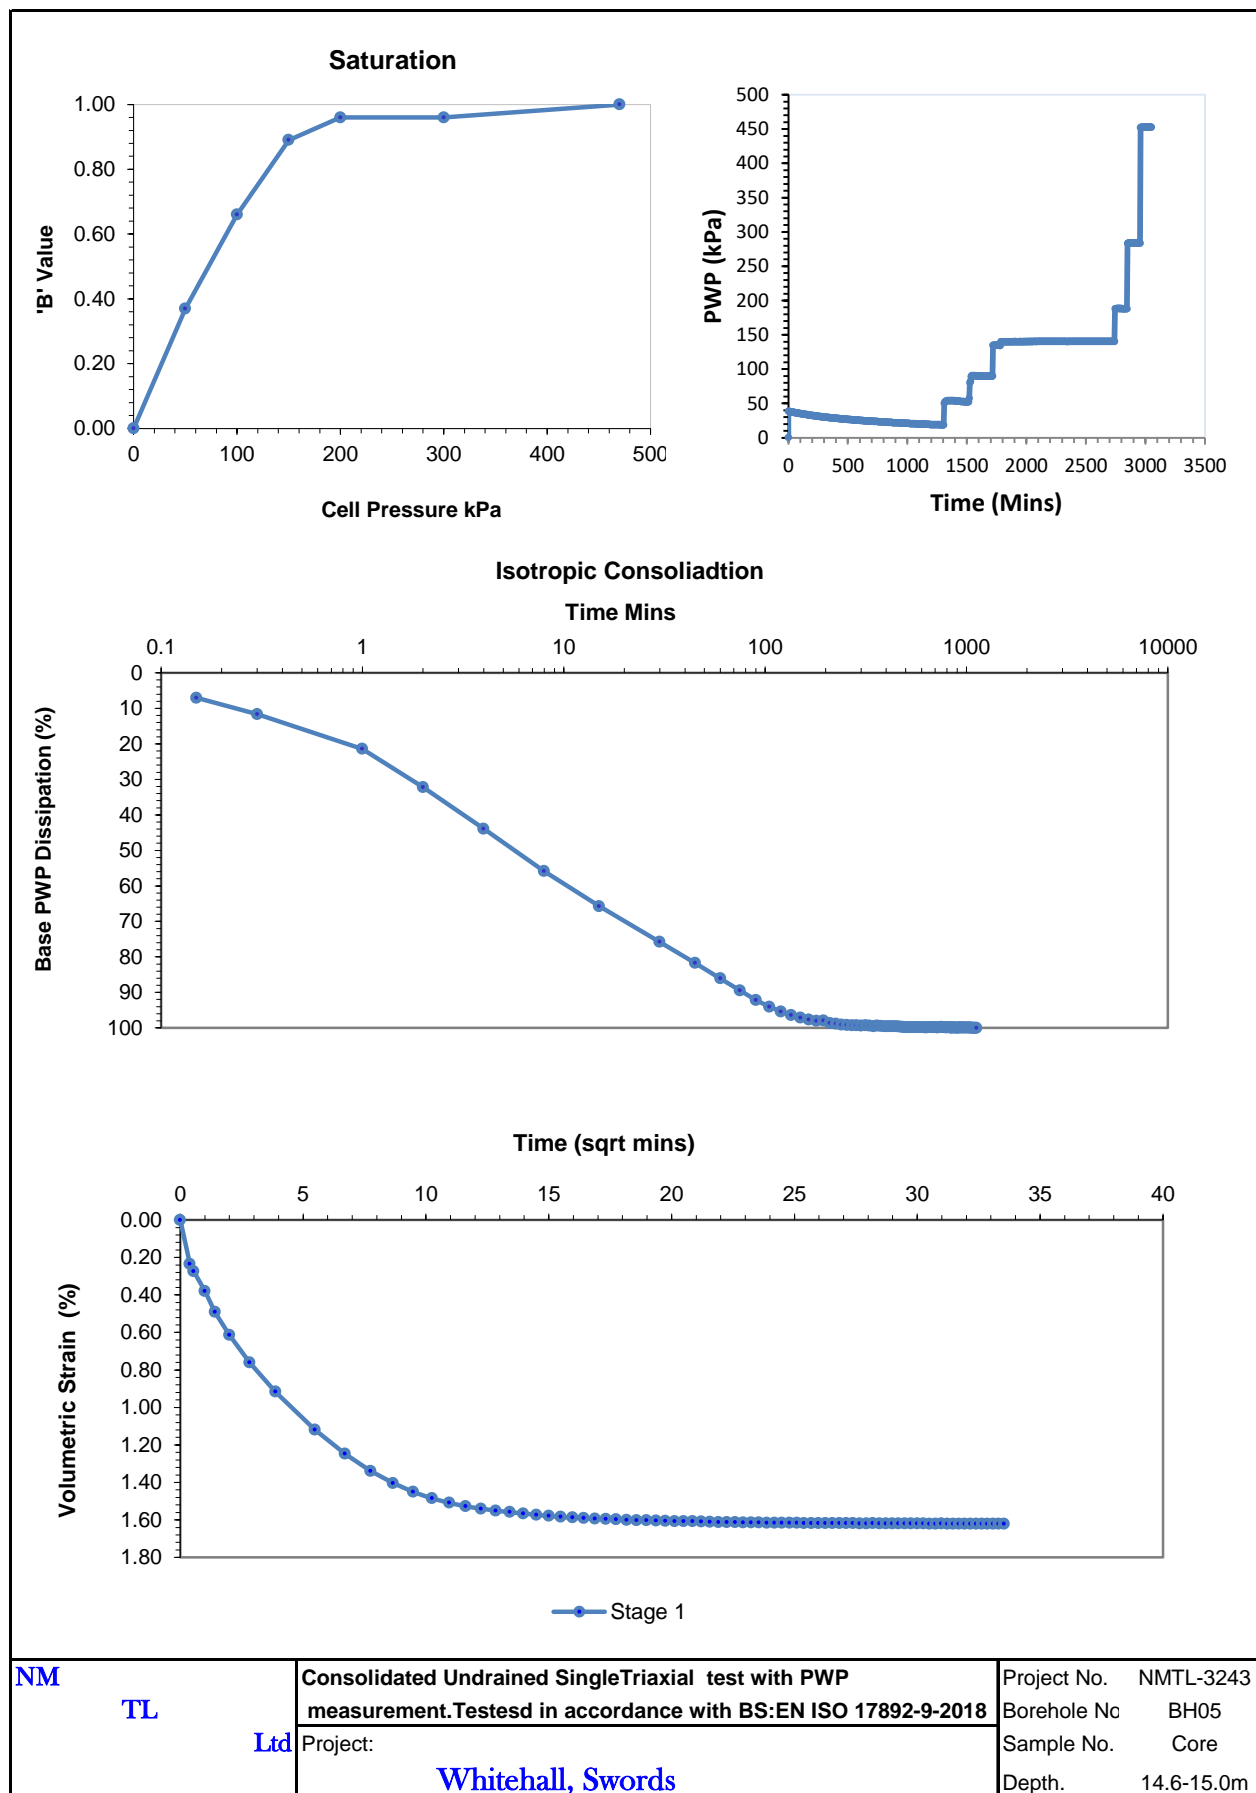

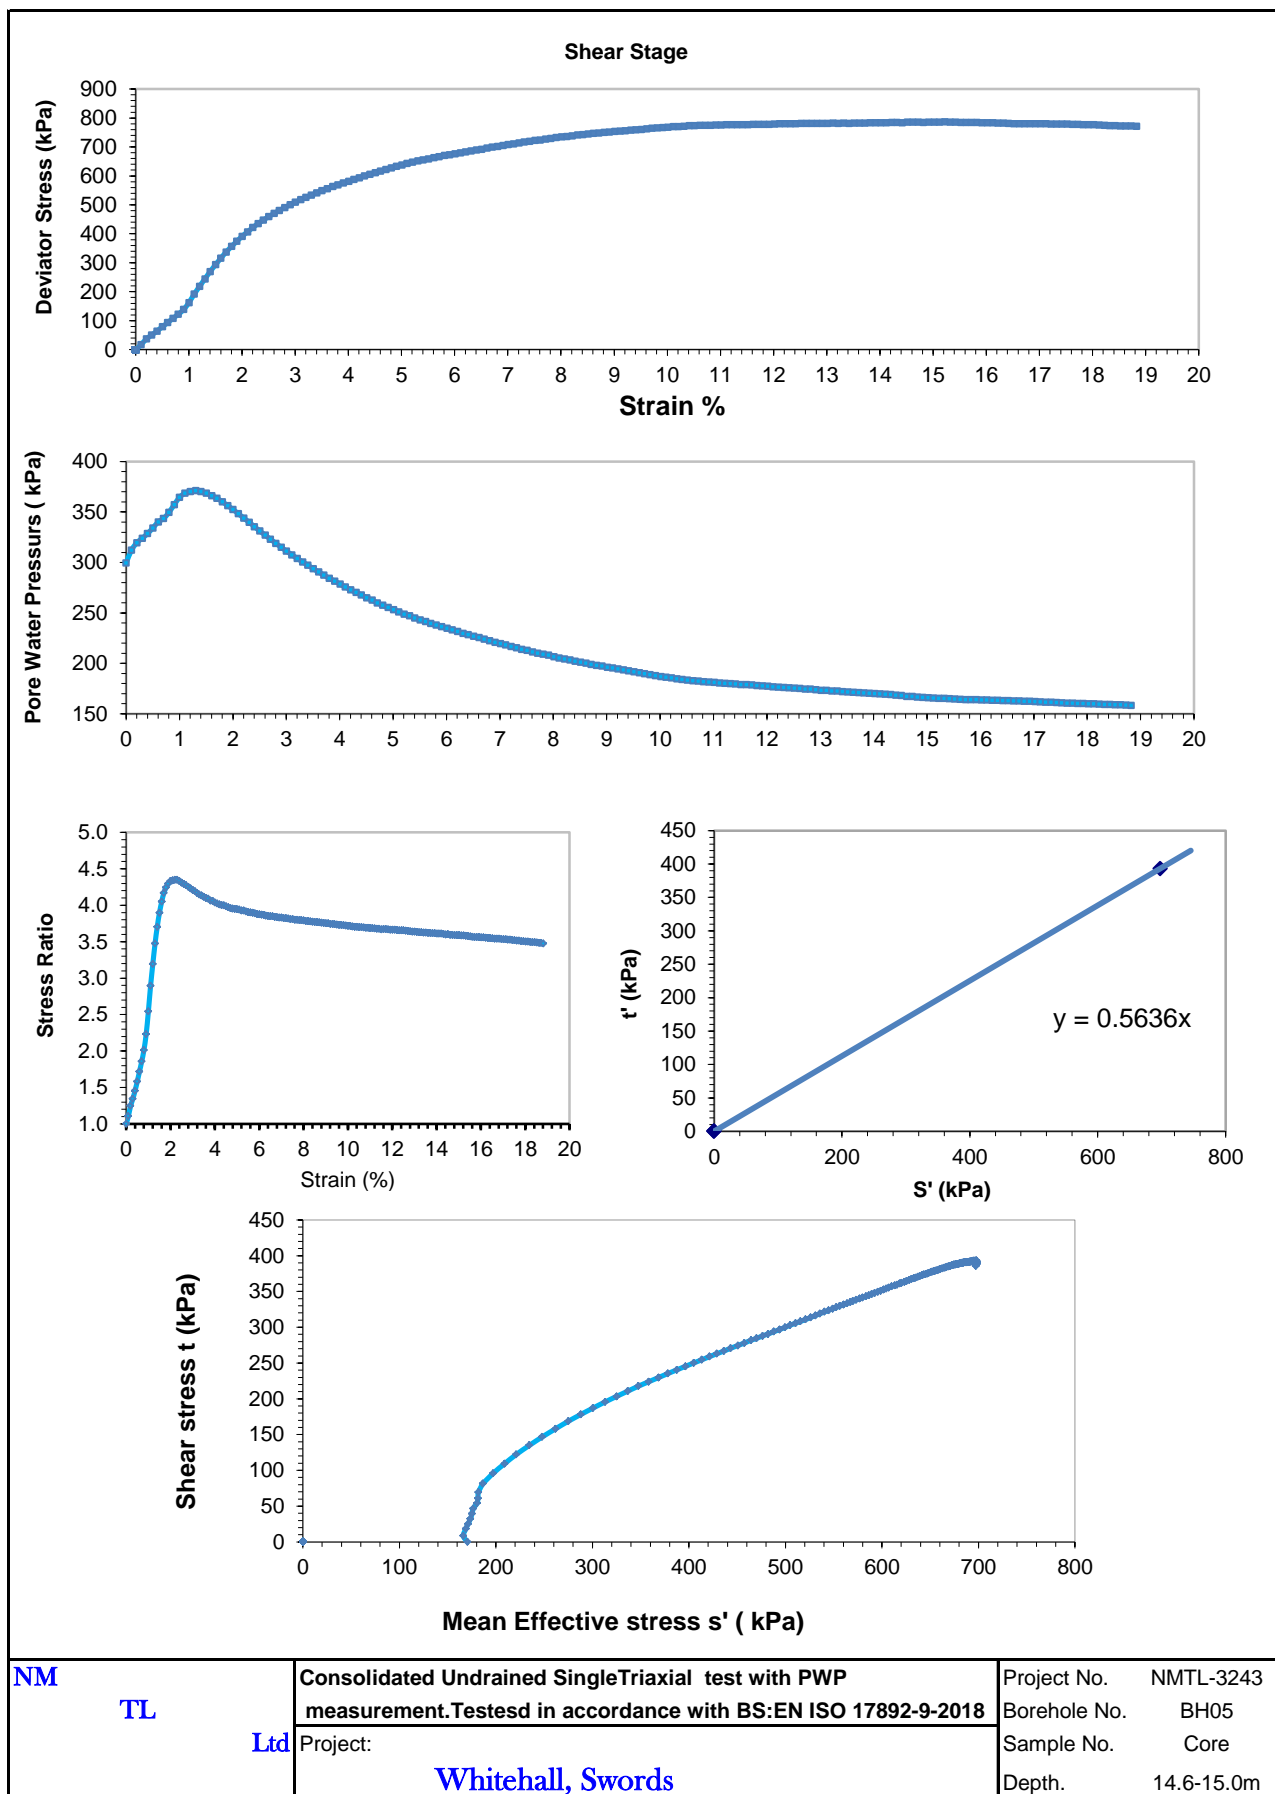

19/08/2020

SPECIMEN AFTER TEST



Soil Description Very stiff grey/brown slightly gravelly slightly sandy silty CLAY.

NM TL Ltd	Consolidated Undrained Single Triaxial test with PWP measurement. Tested in accordance with BS:EN ISO 17892-9-2018	Project No. NMTL-3243
	Project: Whitehall, Swords	Borehole No. BH05 Sample No. Core Depth. 14.6-15.0m

19/08/2020



LABORATORY REPORT



4043

Contract Number: PSL20/3995

Report Date: 13 August 2020
Client's Reference: 9429-02-20
Client Name: Ground Investigations Ireland Ltd
Catherinestown House
Hazelhatch Road
Newcastle
Co Dublin
D22 YD52

For the attention of: Chris Byrne

Contract Title: Swords Road, Whitehall
Date Received: 5/8/2020
Date Commenced: 5/8/2020
Date Completed: 13/8/2020

Notes: Opinions and Interpretations are outside the UKAS Accreditation

A copy of the Laboratory Schedule of accredited tests as issued by UKAS is attached to this report. This certificate is issued in accordance with the accreditation requirements of the United Kingdom Accreditation Service. The results reported herein relate only to the material supplied to the laboratory. This certificate shall not be reproduced other than in full, without the prior written approval of the laboratory.

Checked and Approved Signatories:

R Gunson
(Director)

A Watkins
(Director)

R Berriman
(Quality Manager)

L Knight
(Senior Technician)


S Eyre
(Senior Technician)

S Royle
(Laboratory Manager)

5 – 7 Hexthorpe Road, Hexthorpe,
Doncaster DN4 0AR
tel: +44 (0)844 815 6641
fax: +44 (0)844 815 6642
e-mail: rgunson@prosoils.co.uk
awatkins@prosoils.co.uk

Page 1 of

DETERMINATION OF UNCONFINED COMPRESSIVE STRENGTH

ISRM Suggested Methods, pp 111 –116, 1981.

[illegible]

Swords Road, Whitehall

Contract No:

PSL20/3995

Client Ref:

9429-02-20

SUMMARY OF POINT LOAD TEST RESULTS

ISRM Suggested Methods : 2007

[illegible]

***Note** All testing carried out on samples at as received water content

Par = parallel, Perp = perpendicular, U = Random

A = Axial, D = Diametral, I = Irregular



Swords Road, Whitehall

Contract No:

PSL20/3995

Client Ref:

9429-02-20

SUMMARY OF POINT LOAD TEST RESULTS

ISRM Suggested Methods : 2007

[illegible]

***Note** All testing carried out on samples at as received water content

Par = parallel, Perp = perpendicular, U = Random



Swords Road, Whitehall

Contract No:

PSL20/3995

Client Ref:

9429-02-20

Ground Investigations Ireland
Catherinestown House
Hazelhatch Road
Newcastle
Co. Dublin
Ireland



Attention : Mike Sutton
Date : 30th March, 2020
Your reference : 9429-02-20
Our reference : Test Report 20/3675 Batch 1
Location : Whitehall, Swords Road Extension
Date samples received : 9th March, 2020
Status : Final report
Issue : 1

Eight samples were received for analysis on 9th March, 2020 of which five were scheduled for analysis. Please find attached our Test Report which should be read with notes at the end of the report and should include all sections if reproduced. Interpretations and opinions are outside the scope of any accreditation, and all results relate only to samples supplied.

All analysis is carried out on as received samples and reported on a dry weight basis unless stated otherwise. Results are not surrogate corrected.

Authorised By:



Phil Sommerton BSc
Senior Project Manager

Please include all sections of this report if it is reproduced

Element Materials Technology

Client Name: Ground Investigations Ireland
Reference: 9429-02-20
Location: Whitehall, Swords Road Extension
Contact: Mike Sutton
EMT Job No: 20/3675

Report : Solid

Solids: V=60g VOC jar, J=250g glass jar, T=plastic tub

EMT Sample No.	1-3	4-6	7-9	16-18	22-24						Please see attached notes for all abbreviations and acronyms		
Sample ID	TP01	TP02	TP03	TP07	TP10								
Depth	2.4	0.5	0.5	0.7	0.5								
COC No / misc													
Containers	V J T	V J T	V J T	V J T	V J T								
Sample Date	05/03/2020	05/03/2020	05/03/2020	05/03/2020	05/03/2020								
Sample Type	Soil	Soil	Soil	Soil	Soil								
Batch Number	1	1	1	1	1								
Date of Receipt	09/03/2020	09/03/2020	09/03/2020	09/03/2020	09/03/2020						LOD/LOR	Units	Method No.
Antimony	2	2	2	3	2						<1	mg/kg	TM30/PM15
Arsenic #	8.8	9.4	13.0	19.4	10.7						<0.5	mg/kg	TM30/PM15
Barium #	85	57	152	111	59						<1	mg/kg	TM30/PM15
Cadmium #	2.4	2.3	2.9	2.2	1.5						<0.1	mg/kg	TM30/PM15
Chromium #	27.3	25.5	43.2	43.9	42.0						<0.5	mg/kg	TM30/PM15
Copper #	32	27	31	63	27						<1	mg/kg	TM30/PM15
Lead #	16	15	29	104	28						<5	mg/kg	TM30/PM15
Mercury #	<0.1	<0.1	<0.1	<0.1	<0.1						<0.1	mg/kg	TM30/PM15
Molybdenum #	4.7	3.3	4.6	4.9	4.0						<0.1	mg/kg	TM30/PM15
Nickel #	40.1	38.3	45.6	57.1	34.1						<0.7	mg/kg	TM30/PM15
Selenium #	8	<1	<1	<1	<1						<1	mg/kg	TM30/PM15
Total Sulphate as SO4 #	1085	359	528	708	354						<50	mg/kg	TM50/PM29
Zinc #	84	64	145	151	76						<5	mg/kg	TM30/PM15
PAH MS													
Naphthalene #	<0.04	<0.04	<0.04	<0.04	0.19						<0.04	mg/kg	TM4/PM8
Acenaphthylene	<0.03	<0.03	<0.03	<0.03	<0.03						<0.03	mg/kg	TM4/PM8
Acenaphthene #	<0.05	<0.05	<0.05	<0.05	0.06						<0.05	mg/kg	TM4/PM8
Fluorene #	<0.04	<0.04	<0.04	<0.04	0.06						<0.04	mg/kg	TM4/PM8
Phenanthrene #	0.09	<0.03	<0.03	0.10	0.28						<0.03	mg/kg	TM4/PM8
Anthracene #	<0.04	<0.04	<0.04	<0.04	0.09						<0.04	mg/kg	TM4/PM8
Fluoranthene #	<0.03	<0.03	<0.03	0.10	0.23						<0.03	mg/kg	TM4/PM8
Pyrene #	<0.03	<0.03	<0.03	0.09	0.16						<0.03	mg/kg	TM4/PM8
Benzo(a)anthracene #	<0.06	<0.06	<0.06	0.09	0.10						<0.06	mg/kg	TM4/PM8
Chrysene #	<0.02	<0.02	<0.02	0.09	0.08						<0.02	mg/kg	TM4/PM8
Benzo(bk)fluoranthene #	<0.07	<0.07	<0.07	0.18	0.14						<0.07	mg/kg	TM4/PM8
Benzo(a)pyrene #	<0.04	<0.04	<0.04	0.09	0.07						<0.04	mg/kg	TM4/PM8
Indeno(123cd)pyrene	<0.04	<0.04	<0.04	0.06	<0.04						<0.04	mg/kg	TM4/PM8
Dibenzo(ah)anthracene #	<0.04	<0.04	<0.04	<0.04	<0.04						<0.04	mg/kg	TM4/PM8
Benzo(ghi)perylene #	<0.04	<0.04	<0.04	0.06	<0.04						<0.04	mg/kg	TM4/PM8
Coronene	<0.04	<0.04	<0.04	<0.04	<0.04						<0.04	mg/kg	TM4/PM8
PAH 6 Total #	<0.22	<0.22	<0.22	0.49	0.44						<0.22	mg/kg	TM4/PM8
PAH 17 Total	<0.64	<0.64	<0.64	0.86	1.46						<0.64	mg/kg	TM4/PM8
Benzo(b)fluoranthene	<0.05	<0.05	<0.05	0.13	0.10						<0.05	mg/kg	TM4/PM8
Benzo(k)fluoranthene	<0.02	<0.02	<0.02	0.05	0.04						<0.02	mg/kg	TM4/PM8
Benzo(j)fluoranthene	<1	<1	<1	<1	<1						<1	mg/kg	TM4/PM8
PAH Surrogate % Recovery	82	94	98	96	99						<0	%	TM4/PM8
Methyl Tertiary Butyl Ether #	<2	<2	<2	<2	<2						<2	ug/kg	TM15/PM10
Benzene #	<3	<3	<3	<3	<3						<3	ug/kg	TM15/PM10
Toluene #	<3	<3	<3	-	<3						<3	ug/kg	TM15/PM10
Ethylbenzene #	<3	<3	<3	<3	<3						<3	ug/kg	TM15/PM10
m/p-Xylene #	<5	<5	<5	<5	<5						<5	ug/kg	TM15/PM10
o-Xylene #	<3	<3	<3	<3	<3						<3	ug/kg	TM15/PM10

Element Materials Technology

Client Name: Ground Investigations Ireland
Reference: 9429-02-20
Location: Whitehall, Swords Road Extension
Contact: Mike Sutton
EMT Job No: 20/3675

Report : Solid

Solids: V=60g VOC jar, J=250g glass jar, T=plastic tub

EMT Sample No.	1-3	4-6	7-9	16-18	22-24						Please see attached notes for all abbreviations and acronyms		
Sample ID	TP01	TP02	TP03	TP07	TP10								
Depth	2.4	0.5	0.5	0.7	0.5								
COC No / misc													
Containers	V J T	V J T	V J T	V J T	V J T								
Sample Date	05/03/2020	05/03/2020	05/03/2020	05/03/2020	05/03/2020								
Sample Type	Soil	Soil	Soil	Soil	Soil								
Batch Number	1	1	1	1	1								
Date of Receipt	09/03/2020	09/03/2020	09/03/2020	09/03/2020	09/03/2020						LOD/LOR	Units	Method No.
Surrogate Recovery Toluene D8	91	95	97	88	92						<0	%	TM15/PM10
Surrogate Recovery 4-Bromofluorobenzene	65	89	93	62	78						<0	%	TM15/PM10
Mineral Oil (C10-C40)	<30	<30	<30	32	<30						<30	mg/kg	TM5/PM8/PM16
TPH CWG													
Aliphatics													
>C5-C6 #	<0.1 ^{SV}	<0.1	<0.1	<0.1 ^{SV}	<0.1						<0.1	mg/kg	TM36/PM12
>C6-C8 #	<0.1 ^{SV}	<0.1	<0.1	<0.1 ^{SV}	<0.1						<0.1	mg/kg	TM36/PM12
>C8-C10	<0.1 ^{SV}	<0.1	<0.1	<0.1 ^{SV}	<0.1						<0.1	mg/kg	TM36/PM12
>C10-C12 #	<0.2	<0.2	<0.2	<0.2	<0.2						<0.2	mg/kg	TM5/PM8/PM16
>C12-C16 #	<4	<4	<4	<4	<4						<4	mg/kg	TM5/PM8/PM16
>C16-C21 #	<7	<7	<7	<7	<7						<7	mg/kg	TM5/PM8/PM16
>C21-C35 #	<7	<7	<7	32	<7						<7	mg/kg	TM5/PM8/PM16
>C35-C40	<7	<7	<7	<7	<7						<7	mg/kg	TM5/PM8/PM16
Total aliphatics C5-40	<26	<26	<26	32	<26						<26	mg/kg	TM5/PM8/PM16/PM12/PM10
>C6-C10	<0.1 ^{SV}	<0.1	<0.1	<0.1 ^{SV}	<0.1						<0.1	mg/kg	TM36/PM12
>C10-C25	<10	<10	<10	<10	<10						<10	mg/kg	TM5/PM8/PM16
>C25-C35	<10	<10	<10	27	<10						<10	mg/kg	TM5/PM8/PM16
Aromatics													
>C5-EC7 #	<0.1 ^{SV}	<0.1	<0.1	<0.1 ^{SV}	<0.1						<0.1	mg/kg	TM36/PM12
>EC7-EC8 #	<0.1 ^{SV}	<0.1	<0.1	<0.1 ^{SV}	<0.1						<0.1	mg/kg	TM36/PM12
>EC8-EC10 #	<0.1 ^{SV}	<0.1	<0.1	<0.1 ^{SV}	<0.1						<0.1	mg/kg	TM36/PM12
>EC10-EC12 #	<0.2	<0.2	<0.2	<0.2	<0.2						<0.2	mg/kg	TM5/PM8/PM16
>EC12-EC16 #	<4	<4	<4	<4	<4						<4	mg/kg	TM5/PM8/PM16
>EC16-EC21 #	<7	<7	<7	<7	<7						<7	mg/kg	TM5/PM8/PM16
>EC21-EC35 #	<7	<7	<7	<7	<7						<7	mg/kg	TM5/PM8/PM16
>EC35-EC40	<7	<7	<7	<7	<7						<7	mg/kg	TM5/PM8/PM16
Total aromatics C5-40	<26	<26	<26	<26	<26						<26	mg/kg	TM5/PM8/PM16/PM12/PM10
Total aliphatics and aromatics(C5-40)	<52	<52	<52	<52	<52						<52	mg/kg	TM5/PM8/PM16/PM12/PM10
>EC6-EC10 #	<0.1 ^{SV}	<0.1	<0.1	<0.1 ^{SV}	<0.1						<0.1	mg/kg	TM36/PM12
>EC10-EC25	<10	<10	<10	<10	<10						<10	mg/kg	TM5/PM8/PM16
>EC25-EC35	<10	<10	<10	<10	<10						<10	mg/kg	TM5/PM8/PM16
PCB 28 #	<5	<5	<5	<5	<5						<5	ug/kg	TM17/PM8
PCB 52 #	<5	<5	<5	<5	<5						<5	ug/kg	TM17/PM8
PCB 101 #	<5	<5	<5	<5	<5						<5	ug/kg	TM17/PM8
PCB 118 #	<5	<5	<5	<5	<5						<5	ug/kg	TM17/PM8
PCB 138 #	<5	<5	<5	<5	<5						<5	ug/kg	TM17/PM8
PCB 153 #	<5	<5	<5	<5	<5						<5	ug/kg	TM17/PM8
PCB 180 #	<5	<5	<5	<5	<5						<5	ug/kg	TM17/PM8
Total 7 PCBs #	<35	<35	<35	<35	<35						<35	ug/kg	TM17/PM8
Natural Moisture Content	9.9	16.5	25.6	26.8	14.6						<0.1	%	PM4/PM0

Element Materials Technology

Client Name:	Ground Investigations Ireland	Report :	Solid
Reference:	9429-02-20		
Location:	Whitehall, Swords Road Extension	Solids:	V=60g VOC jar, J=250g glass jar, T=plastic tub
Contact:	Mike Sutton		
EMT Job No:	20/3675		

Report : Solid

Solids: V=60g VOC jar. J=250g glass jar. T=plastic tub

[illegible]

Element Materials Technology

Client Name: Ground Investigations Ireland
Reference: 9429-02-20
Location: Whitehall, Swords Road Extension
Contact: Mike Sutton
EMT Job No: 20/3675

Report : CEN 10:1 1 Batch

Solids: V=60g VOC jar, J=250g glass jar, T=plastic tub

EMT Sample No.	1-3	4-6	7-9	16-18	22-24						Please see attached notes for all abbreviations and acronyms		
Sample ID	TP01	TP02	TP03	TP07	TP10								
Depth	2.4	0.5	0.5	0.7	0.5								
COC No / misc													
Containers	V J T	V J T	V J T	V J T	V J T								
Sample Date	05/03/2020	05/03/2020	05/03/2020	05/03/2020	05/03/2020								
Sample Type	Soil	Soil	Soil	Soil	Soil								
Batch Number	1	1	1	1	1								
Date of Receipt	09/03/2020	09/03/2020	09/03/2020	09/03/2020	09/03/2020						LOD/LOR	Units	Method No.
Dissolved Antimony #	<0.002	<0.002	<0.002	<0.002	0.003						<0.002	mg/l	TM30/PM17
Dissolved Antimony (A10) #	<0.02	<0.02	<0.02	<0.02	0.03						<0.02	mg/kg	TM30/PM17
Dissolved Arsenic #	<0.0025	<0.0025	<0.0025	<0.0025	<0.0025						<0.0025	mg/l	TM30/PM17
Dissolved Arsenic (A10) #	<0.025	<0.025	<0.025	<0.025	<0.025						<0.025	mg/kg	TM30/PM17
Dissolved Barium #	0.004	<0.003	<0.003	0.007	0.003						<0.003	mg/l	TM30/PM17
Dissolved Barium (A10) #	0.04	<0.03	<0.03	0.07	0.03						<0.03	mg/kg	TM30/PM17
Dissolved Cadmium #	<0.0005	<0.0005	<0.0005	<0.0005	<0.0005						<0.0005	mg/l	TM30/PM17
Dissolved Cadmium (A10) #	<0.005	<0.005	<0.005	<0.005	<0.005						<0.005	mg/kg	TM30/PM17
Dissolved Chromium #	<0.0015	<0.0015	<0.0015	<0.0015	<0.0015						<0.0015	mg/l	TM30/PM17
Dissolved Chromium (A10) #	<0.015	<0.015	<0.015	<0.015	<0.015						<0.015	mg/kg	TM30/PM17
Dissolved Copper #	<0.007	<0.007	<0.007	<0.007	<0.007						<0.007	mg/l	TM30/PM17
Dissolved Copper (A10) #	<0.07	<0.07	<0.07	<0.07	<0.07						<0.07	mg/kg	TM30/PM17
Dissolved Lead #	<0.005	<0.005	<0.005	<0.005	<0.005						<0.005	mg/l	TM30/PM17
Dissolved Lead (A10) #	<0.05	<0.05	<0.05	<0.05	<0.05						<0.05	mg/kg	TM30/PM17
Dissolved Molybdenum #	0.031	0.013	0.002	0.008	0.010						<0.002	mg/l	TM30/PM17
Dissolved Molybdenum (A10) #	0.31	0.13	0.02	0.08	0.10						<0.02	mg/kg	TM30/PM17
Dissolved Nickel #	<0.002	<0.002	<0.002	<0.002	<0.002						<0.002	mg/l	TM30/PM17
Dissolved Nickel (A10) #	<0.02	<0.02	<0.02	<0.02	<0.02						<0.02	mg/kg	TM30/PM17
Dissolved Selenium #	0.005	<0.003	<0.003	<0.003	<0.003						<0.003	mg/l	TM30/PM17
Dissolved Selenium (A10) #	0.05	<0.03	<0.03	<0.03	<0.03						<0.03	mg/kg	TM30/PM17
Dissolved Zinc #	<0.003	<0.003	<0.003	0.004	0.003						<0.003	mg/l	TM30/PM17
Dissolved Zinc (A10) #	<0.03	<0.03	<0.03	0.04	0.03						<0.03	mg/kg	TM30/PM17
Mercury Dissolved by CVA#	<0.00001	<0.00001	<0.00001	<0.00001	<0.00001						<0.00001	mg/l	TM61/PM0
Mercury Dissolved by CVA#	<0.0001	<0.0001	<0.0001	<0.0001	<0.0001						<0.0001	mg/kg	TM61/PM0
Phenol	<0.01	<0.01	<0.01	<0.01	<0.01						<0.01	mg/l	TM26/PM0
Phenol	<0.1	<0.1	<0.1	<0.1	<0.1						<0.1	mg/kg	TM26/PM0
Fluoride	0.5	0.5	0.3	0.5	0.4						<0.3	mg/l	TM173/PM0
Fluoride	5	5	3	5	4						<3	mg/kg	TM173/PM0
Sulphate as SO4 #	4.8	4.1	20.0	4.3	13.7						<0.5	mg/l	TM38/PM0
Sulphate as SO4 #	48	41	200	43	137						<5	mg/kg	TM38/PM0
Chloride #	<0.3	<0.3	<0.3	0.4	<0.3						<0.3	mg/l	TM38/PM0
Chloride #	<3	<3	<3	4	<3						<3	mg/kg	TM38/PM0
Dissolved Organic Carbon	<2	3	4	5	4						<2	mg/l	TM60/PM0
Dissolved Organic Carbon	<20	30	40	50	40						<20	mg/kg	TM60/PM0
pH	8.33	8.26	8.16	8.26	8.16						<0.01	pH units	TM73/PM0
Total Dissolved Solids #	79	72	114	132	103						<35	mg/l	TM20/PM0
Total Dissolved Solids #	790	720	1141	1320	1030						<350	mg/kg	TM20/PM0

Client Name:	Ground Investigations Ireland	Report :	EN12457_2
Reference:	9429-02-20		
Location:	Whitehall, Swords Road Extension	Solids:	V=60g VOC jar, J=250g glass jar, T=plastic tub
Contact:	Mike Sutton		
EMT Job No:	20/3675		

EMT Sample No.	1-3	4-6	7-9	16-18	22-24							Please see attached notes for all abbreviations and acronyms					
Sample ID	TP01	TP02	TP03	TP07	TP10												
Depth	2.4	0.5	0.5	0.7	0.5												
COC No / misc																	
Containers	V J T	V J T	V J T	V J T	V J T												
Sample Date	05/03/2020	05/03/2020	05/03/2020	05/03/2020	05/03/2020												
Sample Type	Soil	Soil	Soil	Soil	Soil												
Batch Number	1	1	1	1	1						Inert	Stable Non-reactive	Hazardous	LOD LOR	Units	Method No.	
Date of Receipt	09/03/2020	09/03/2020	09/03/2020	09/03/2020	09/03/2020												
Solid Waste Analysis																	
Total Organic Carbon #	0.70	0.51	0.82	3.73	0.68						3	5	6	<0.02	%	TM21/PM24	
Sum of BTEX	<0.017	<0.017	<0.017	<0.017	<0.017						6	-	-	<0.017	mg/kg	TM15/PM10	
Sum of 7 PCBs #	<0.035	<0.035	<0.035	<0.035	<0.035						1	-	-	<0.035	mg/kg	TM17/PM8	
Mineral Oil	<30	<30	<30	32	<30						500	-	-	<30	mg/kg	TM5/PM5/PM16	
PAH Sum of 6 #	<0.22	<0.22	<0.22	0.49	0.44						-	-	-	<0.22	mg/kg	TM4/PM8	
PAH Sum of 17	<0.64	<0.64	<0.64	0.86	1.46						100	-	-	<0.64	mg/kg	TM4/PM8	
CEN 10:1 Leachate																	
Arsenic #	<0.025	<0.025	<0.025	<0.025	<0.025						0.5	2	25	<0.025	mg/kg	TM30/PM17	
Barium #	0.04	<0.03	<0.03	0.07	0.03						20	100	300	<0.03	mg/kg	TM30/PM17	
Cadmium #	<0.005	<0.005	<0.005	<0.005	<0.005						0.04	1	5	<0.005	mg/kg	TM30/PM17	
Chromium #	<0.015	<0.015	<0.015	<0.015	<0.015						0.5	10	70	<0.015	mg/kg	TM30/PM17	
Copper #	<0.07	<0.07	<0.07	<0.07	<0.07						2	50	100	<0.07	mg/kg	TM30/PM17	
Mercury #	<0.0001	<0.0001	<0.0001	<0.0001	<0.0001						0.01	0.2	2	<0.0001	mg/kg	TM61/PM0	
Molybdenum #	0.31	0.13	0.02	0.08	0.10						0.5	10	30	<0.02	mg/kg	TM30/PM17	
Nickel #	<0.02	<0.02	<0.02	<0.02	<0.02						0.4	10	40	<0.02	mg/kg	TM30/PM17	
Lead #	<0.05	<0.05	<0.05	<0.05	<0.05						0.5	10	50	<0.05	mg/kg	TM30/PM17	
Antimony #	<0.02	<0.02	<0.02	<0.02	0.03						0.06	0.7	5	<0.02	mg/kg	TM30/PM17	
Selenium #	0.05	<0.03	<0.03	<0.03	<0.03						0.1	0.5	7	<0.03	mg/kg	TM30/PM17	
Zinc #	<0.03	<0.03	<0.03	0.04	0.03						4	50	200	<0.03	mg/kg	TM30/PM17	
Total Dissolved Solids #	790	720	1141	1320	1030						4000	60000	100000	<350	mg/kg	TM20/PM0	
Dissolved Organic Carbon	<20	30	40	50	40						500	800	1000	<20	mg/kg	TM60/PM0	
Mass of raw test portion	0.1007	0.1079	0.1121	0.115	0.1058						-	-	-		kg	NONE/PM17	
Dry Matter Content Ratio	89.3	83.7	80.0	78.3	85.5						-	-	-	<0.1	%	NONE/PM4	
Leachant Volume	0.889	0.882	0.878	0.875	0.885						-	-	-		l	NONE/PM17	
Eluate Volume	0.8	0.8	0.8	0.8	0.8						-	-	-		l	NONE/PM17	
pH #	8.66	8.55	8.24	8.25	8.55						-	-	-	<0.01	pH units	TM73/PM11	
Phenol	<0.1	<0.1	<0.1	<0.1	<0.1						1	-	-	<0.1	mg/kg	TM26/PM0	
Fluoride	5	5	3	5	4						-	-	-	<3	mg/kg	TM173/PM0	
Sulphate as SO4 #	48	41	200	43	137						1000	20000	50000	<5	mg/kg	TM38/PM0	
Chloride #	<3	<3	<3	4	<3						800	15000	25000	<3	mg/kg	TM38/PM0	

Client Name: Ground Investigations Ireland
Reference: 9429-02-20
Location: Whitehall, Swords Road Extension
Contact: Mike Sutton
EMT Job No: 20/3675

SVOC Report : Solid

EMT Sample No.	1-3	4-6	7-9	16-18	22-24						Please see attached notes for all abbreviations and acronyms		
Sample ID	TP01	TP02	TP03	TP07	TP10								
Depth	2.4	0.5	0.5	0.7	0.5								
COC No / misc													
Containers	V J T	V J T	V J T	V J T	V J T								
Sample Date	05/03/2020	05/03/2020	05/03/2020	05/03/2020	05/03/2020								
Sample Type	Soil	Soil	Soil	Soil	Soil								
Batch Number	1	1	1	1	1						LOD/LOR	Units	Method No.
Date of Receipt	09/03/2020	09/03/2020	09/03/2020	09/03/2020	09/03/2020								
SVOC MS													
Phenols													
2-Chlorophenol #	<10	<10	<10	<10	<10						<10	ug/kg	TM16/PM8
2-Methylphenol	<10	<10	<10	<10	<10						<10	ug/kg	TM16/PM8
2-Nitrophenol	<10	<10	<10	<10	<10						<10	ug/kg	TM16/PM8
2,4-Dichlorophenol #	<10	<10	<10	<10	<10						<10	ug/kg	TM16/PM8
2,4-Dimethylphenol	<10	<10	<10	<10	<10						<10	ug/kg	TM16/PM8
2,4,5-Trichlorophenol	<10	<10	<10	<10	<10						<10	ug/kg	TM16/PM8
2,4,6-Trichlorophenol	<10	<10	<10	<10	<10						<10	ug/kg	TM16/PM8
4-Chloro-3-methylphenol	<10	<10	<10	<10	<10						<10	ug/kg	TM16/PM8
4-Methylphenol	<10	<10	<10	24	<10						<10	ug/kg	TM16/PM8
4-Nitrophenol	<10	<10	<10	<10	<10						<10	ug/kg	TM16/PM8
Pentachlorophenol	<10	<10	<10	<10	<10						<10	ug/kg	TM16/PM8
Phenol #	<10	<10	<10	<10	<10						<10	ug/kg	TM16/PM8
PAHs													
2-Chloronaphthalene #	<10	<10	<10	<10	<10						<10	ug/kg	TM16/PM8
2-Methylnaphthalene #	22	<10	<10	24	<10						<10	ug/kg	TM16/PM8
Phthalates													
Bis(2-ethylhexyl) phthalate	<100	<100	<100	<100	<100						<100	ug/kg	TM16/PM8
Butylbenzyl phthalate	<100	<100	<100	<100	<100						<100	ug/kg	TM16/PM8
Di-n-butyl phthalate	<100	<100	<100	<100	<100						<100	ug/kg	TM16/PM8
Di-n-Octyl phthalate	<100	<100	<100	<100	<100						<100	ug/kg	TM16/PM8
Diethyl phthalate	<100	<100	<100	<100	<100						<100	ug/kg	TM16/PM8
Dimethyl phthalate #	<100	<100	<100	<100	<100						<100	ug/kg	TM16/PM8
Other SVOCs													
1,2-Dichlorobenzene	<10	<10	<10	<10	<10						<10	ug/kg	TM16/PM8
1,2,4-Trichlorobenzene #	<10	<10	<10	<10	<10						<10	ug/kg	TM16/PM8
1,3-Dichlorobenzene	<10	<10	<10	<10	<10						<10	ug/kg	TM16/PM8
1,4-Dichlorobenzene	<10	<10	<10	<10	<10						<10	ug/kg	TM16/PM8
2-Nitroaniline	<10	<10	<10	<10	<10						<10	ug/kg	TM16/PM8
2,4-Dinitrotoluene	<10	<10	<10	<10	<10						<10	ug/kg	TM16/PM8
2,6-Dinitrotoluene	<10	<10	<10	<10	<10						<10	ug/kg	TM16/PM8
3-Nitroaniline	<10	<10	<10	<10	<10						<10	ug/kg	TM16/PM8
4-Bromophenylphenylether #	<10	<10	<10	<10	<10						<10	ug/kg	TM16/PM8
4-Chloroaniline	<10	<10	<10	<10	<10						<10	ug/kg	TM16/PM8
4-Chlorophenylphenylether	<10	<10	<10	<10	<10						<10	ug/kg	TM16/PM8
4-Nitroaniline	<10	<10	<10	<10	<10						<10	ug/kg	TM16/PM8
Azobenzene	<10	<10	<10	<10	<10						<10	ug/kg	TM16/PM8
Bis(2-chloroethoxy)methane	<10	<10	<10	<10	<10						<10	ug/kg	TM16/PM8
Bis(2-chloroethyl)ether	<10	<10	<10	<10	<10						<10	ug/kg	TM16/PM8
Carbazole	<10	<10	<10	<10	<10						<10	ug/kg	TM16/PM8
Dibenzofuran #	<10	<10	<10	<10	<10						<10	ug/kg	TM16/PM8
Hexachlorobenzene	<10	<10	<10	<10	<10						<10	ug/kg	TM16/PM8
Hexachlorobutadiene #	<10	<10	<10	<10	<10						<10	ug/kg	TM16/PM8
Hexachlorocyclopentadiene	<10	<10	<10	<10	<10						<10	ug/kg	TM16/PM8
Hexachloroethane	<10	<10	<10	<10	<10						<10	ug/kg	TM16/PM8
Isophorone #	<10	<10	<10	<10	<10						<10	ug/kg	TM16/PM8
N-nitrosodi-n-propylamine #	<10	<10	<10	<10	<10						<10	ug/kg	TM16/PM8
Nitrobenzene #	<10	<10	<10	<10	<10						<10	ug/kg	TM16/PM8
Surrogate Recovery 2-Fluorobiphenyl	123	123	118	121	128						<0	%	TM16/PM8
Surrogate Recovery p-Terphenyl-d14	117	119	117	117	130						<0	%	TM16/PM8

Element Materials Technology

Client Name: Ground Investigations Ireland
Reference: 9429-02-20
Location: Whitehall, Swords Road Extension
Contact: Mike Sutton
EMT Job No: 20/3675

VOC Report : Solid

EMT Sample No.	1-3	4-6	7-9	16-18	22-24						Please see attached notes for all abbreviations and acronyms		
Sample ID	TP01	TP02	TP03	TP07	TP10								
Depth	2.4	0.5	0.5	0.7	0.5								
COC No / misc													
Containers	V J T	V J T	V J T	V J T	V J T								
Sample Date	05/03/2020	05/03/2020	05/03/2020	05/03/2020	05/03/2020								
Sample Type	Soil	Soil	Soil	Soil	Soil								
Batch Number	1	1	1	1	1						LOD/LOR	Units	Method No.
Date of Receipt	09/03/2020	09/03/2020	09/03/2020	09/03/2020	09/03/2020								
VOC MS													
Dichlorodifluoromethane	<2	<2	<2	<2	<2						<2	ug/kg	TM15/PM10
Methyl Tertiary Butyl Ether #	<2	<2	<2	<2	<2						<2	ug/kg	TM15/PM10
Chloromethane #	<3	<3	<3	<3	<3						<3	ug/kg	TM15/PM10
Vinyl Chloride	<2	<2	<2	<2	<2						<2	ug/kg	TM15_A/PM10
Bromomethane	<1	<1	<1	<1	<1						<1	ug/kg	TM15/PM10
Chloroethane #	<2	<2	<2	<2	<2						<2	ug/kg	TM15/PM10
Trichlorofluoromethane #	<2	<2	<2	<2	<2						<2	ug/kg	TM15/PM10
1,1-Dichloroethene (1,1 DCE) #	<6	<6	<6	<6	<6						<6	ug/kg	TM15/PM10
Dichloromethane (DCM) #	<30	<30	<30	<30	<30						<30	ug/kg	TM15/PM10
trans-1-2-Dichloroethene #	<3	<3	<3	<3	<3						<3	ug/kg	TM15/PM10
1,1-Dichloroethane #	<3	<3	<3	<3	<3						<3	ug/kg	TM15/PM10
cis-1-2-Dichloroethene #	<3	<3	<3	<3	<3						<3	ug/kg	TM15/PM10
2,2-Dichloropropane	<4	<4	<4	<4	<4						<4	ug/kg	TM15/PM10
Bromochloromethane #	<3	<3	<3	<3	<3						<3	ug/kg	TM15/PM10
Chloroform #	<3	<3	<3	<3	<3						<3	ug/kg	TM15/PM10
1,1,1-Trichloroethane #	<3	<3	<3	<3	<3						<3	ug/kg	TM15/PM10
1,1-Dichloropropene #	<3	<3	<3	<3	<3						<3	ug/kg	TM15/PM10
Carbon tetrachloride #	<4	<4	<4	<4	<4						<4	ug/kg	TM15/PM10
1,2-Dichloroethane #	<4	<4	<4	<4	<4						<4	ug/kg	TM15/PM10
Benzene #	<3	<3	<3	<3	<3						<3	ug/kg	TM15/PM10
Trichloroethene (TCE) #	<3	<3	<3	<3	<3						<3	ug/kg	TM15/PM10
1,2-Dichloropropane #	<6	<6	<6	<6	<6						<6	ug/kg	TM15/PM10
Dibromomethane #	<3	<3	<3	<3	<3						<3	ug/kg	TM15/PM10
Bromodichloromethane #	<3	<3	<3	<3	<3						<3	ug/kg	TM15/PM10
cis-1-3-Dichloropropene	<4	<4	<4	<4	<4						<4	ug/kg	TM15/PM10
Toluene #	<3	<3	<3	<3	<3						<3	ug/kg	TM15/PM10
trans-1-3-Dichloropropene	<3	<3	<3	<3	<3						<3	ug/kg	TM15/PM10
1,1,2-Trichloroethane #	<3	<3	<3	<3	<3						<3	ug/kg	TM15/PM10
Tetrachloroethene (PCE) #	<3	<3	<3	<3	<3						<3	ug/kg	TM15/PM10
1,3-Dichloropropane #	<3	<3	<3	<3	<3						<3	ug/kg	TM15/PM10
Dibromochloromethane #	<3	<3	<3	<3	<3						<3	ug/kg	TM15/PM10
1,2-Dibromoethane #	<3	<3	<3	<3	<3						<3	ug/kg	TM15/PM10
Chlorobenzene #	<3	<3	<3	<3	<3						<3	ug/kg	TM15/PM10
1,1,1,2-Tetrachloroethane #	<3	<3	<3	<3	<3						<3	ug/kg	TM15/PM10
Ethylbenzene #	<3	<3	<3	<3	<3						<3	ug/kg	TM15/PM10
m/p-Xylene #	<5	<5	<5	<5	<5						<5	ug/kg	TM15/PM10
o-Xylene #	<3	<3	<3	<3	<3						<3	ug/kg	TM15/PM10
Styrene	<3	<3	<3	<3	<3						<3	ug/kg	TM15_A/PM10
Bromoform	<3	<3	<3	<3	<3						<3	ug/kg	TM15/PM10
Isopropylbenzene #	<3	<3	<3	<3	<3						<3	ug/kg	TM15/PM10
1,1,2,2-Tetrachloroethane #	<3	<3	<3	<3	<3						<3	ug/kg	TM15/PM10
Bromobenzene	<2	<2	<2	<2	<2						<2	ug/kg	TM15/PM10
1,2,3-Trichloropropane #	<4	<4	<4	<4	<4						<4	ug/kg	TM15/PM10
Propylbenzene #	<4	<4	<4	<4	<4						<4	ug/kg	TM15/PM10
2-Chlorotoluene	<3	<3	<3	<3	<3						<3	ug/kg	TM15/PM10
1,3,5-Trimethylbenzene #	<3	<3	<3	<3	<3						<3	ug/kg	TM15/PM10
4-Chlorotoluene	<3	<3	<3	<3	<3						<3	ug/kg	TM15/PM10
tert-Butylbenzene #	<5	<5	<5	<5	<5						<5	ug/kg	TM15/PM10
1,2,4-Trimethylbenzene #	<6	<6	<6	<6	<6						<6	ug/kg	TM15/PM10
sec-Butylbenzene #	<4	<4	<4	<4	<4						<4	ug/kg	TM15/PM10
4-Isopropyltoluene #	<4	<4	<4	<4	<4						<4	ug/kg	TM15/PM10
1,3-Dichlorobenzene #	<4	<4	<4	<4	<4						<4	ug/kg	TM15/PM10
1,4-Dichlorobenzene #	<4	<4	<4	<4	<4						<4	ug/kg	TM15/PM10
n-Butylbenzene #	<4	<4	<4	<4	<4						<4	ug/kg	TM15/PM10
1,2-Dichlorobenzene #	<4	<4	<4	<4	<4						<4	ug/kg	TM15/PM10
1,2-Dibromo-3-chloropropane #	<4	<4	<4	<4	<4						<4	ug/kg	TM15/PM10
1,2,4-Trichlorobenzene #	<7	<7	<7	<7	<7						<7	ug/kg	TM15/PM10
Hexachlorobutadiene	<4	<4	<4	<4	<4						<4	ug/kg	TM15/PM10
1,2,3-Trichlorobenzene #	<7	<7	<7	<7	<7						<7	ug/kg	TM15/PM10
Surrogate Recovery Toluene D8	91	95	97	88	92						<0	%	TM15/PM10
Surrogate Recovery 4-Bromofluorobenzene	65	89	93	62	78						<0	%	TM15/PM10

Matrix : Solid

9 of 17

Client Name: Ground Investigations Ireland
Reference: 20/02/9429
Location: Whitehall, Swords Road Extension
Contact: Mike Sutton

Note:

Asbestos Screen analysis is carried out in accordance with our documented in-house methods PM042 and TM065 and HSG 248 by Stereo and Polarised Light Microscopy using Dispersion Staining Techniques and is covered by our UKAS accreditation. Detailed Gravimetric Quantification and PCOM Fibre Analysis is carried out in accordance with our documented in-house methods PM042 and TM131 and HSG 248 using Stereo and Polarised Light Microscopy and Phase Contrast Optical Microscopy (PCOM). Samples are retained for not less than 6 months from the date of analysis unless specifically requested.

Opinions, including ACM type and Asbestos level less than 0.1%, lie outside the scope of our UKAS accreditation.

Where the sample is not taken by a Element Materials Technology consultant, Element Materials Technology cannot be responsible for inaccurate or unrepresentative sampling.

EMT Job No.	Batch	Sample ID	Depth	EMT Sample No.	Date Of Analysis	Analysis	Result
20/3675	1	TP01	2.4	2	18/03/2020	General Description (Bulk Analysis)	soil.stones
					18/03/2020	Asbestos Fibres	NAD
					18/03/2020	Asbestos ACM	NAD
					18/03/2020	Asbestos Type	NAD
					18/03/2020	Asbestos Level Screen	NAD
20/3675	1	TP02	0.5	5	18/03/2020	General Description (Bulk Analysis)	soil.stones
					18/03/2020	Asbestos Fibres	NAD
					18/03/2020	Asbestos ACM	NAD
					18/03/2020	Asbestos Type	NAD
					18/03/2020	Asbestos Level Screen	NAD
20/3675	1	TP03	0.5	8	18/03/2020	General Description (Bulk Analysis)	soil.stones
					18/03/2020	Asbestos Fibres	NAD
					18/03/2020	Asbestos ACM	NAD
					18/03/2020	Asbestos Type	NAD
					18/03/2020	Asbestos Level Screen	NAD
20/3675	1	TP07	0.7	17	18/03/2020	General Description (Bulk Analysis)	Soil/Stone
					18/03/2020	Asbestos Fibres	NAD
					18/03/2020	Asbestos ACM	NAD
					18/03/2020	Asbestos Type	NAD
					18/03/2020	Asbestos Level Screen	NAD
20/3675	1	TP10	0.5	23	18/03/2020	General Description (Bulk Analysis)	soil.stones
					18/03/2020	Asbestos Fibres	NAD
					18/03/2020	Asbestos ACM	NAD
					18/03/2020	Asbestos Type	NAD
					18/03/2020	Asbestos Level Screen	NAD

Client Name: Ground Investigations Ireland **Matrix : Solid**

Reference: 9429-02-20

Location: Whitehall, Swords Road Extension

Contact: Mike Sutton

[illegible]

Please note that only samples that are deviating are mentioned in this report. If no samples are listed it is because none were deviating.

Only analyses which are accredited are recorded as deviating if set criteria are not met.

NOTES TO ACCOMPANY ALL SCHEDULES AND REPORTS

EMT Job No.: 20/3675

SOILS

Please note we are only MCERTS accredited (UK soils only) for sand, loam and clay and any other matrix is outside our scope of accreditation.

Where an MCERTS report has been requested, you will be notified within 48 hours of any samples that have been identified as being outside our MCERTS scope. As validation has been performed on clay, sand and loam, only samples that are predominantly these matrices, or combinations of them will be within our MCERTS scope. If samples are not one of a combination of the above matrices they will not be marked as MCERTS accredited.

It is assumed that you have taken representative samples on site and require analysis on a representative subsample. Stones will generally be included unless we are requested to remove them.

All samples will be discarded one month after the date of reporting, unless we are instructed to the contrary.

If you have not already done so, please send us a purchase order if this is required by your company.

Where appropriate please make sure that our detection limits are suitable for your needs, if they are not, please notify us immediately.

All analysis is reported on a dry weight basis unless stated otherwise. Limits of detection for analyses carried out on as received samples are not moisture content corrected. Results are not surrogate corrected. Samples are dried at 35°C ±5°C unless otherwise stated. Moisture content for CEN Leachate tests are dried at 105°C ±5°C.

Where Mineral Oil or Fats, Oils and Grease is quoted, this refers to Total Aliphatics C10-C40.

Where a CEN 10:1 ZERO Headspace VOC test has been carried out, a 10:1 ratio of water to wet (as received) soil has been used.

% Asbestos in Asbestos Containing Materials (ACMs) is determined by reference to HSG 264 The Survey Guide - Appendix 2 : ACMs in buildings listed in order of ease of fibre release.

Sufficient amount of sample must be received to carry out the testing specified. Where an insufficient amount of sample has been received the testing may not meet the requirements of our accredited methods, as such accreditation may be removed.

Negative Neutralization Potential (NP) values are obtained when the volume of NaOH (0.1N) titrated (pH 8.3) is greater than the volume of HCl (1N) to reduce the pH of the sample to 2.0 - 2.5. Any negative NP values are corrected to 0.

The calculation of Pyrite content assumes that all oxidisable sulphides present in the sample are pyrite. This may not be the case. The calculation may be an overestimate when other sulphides such as Barite (Barium Sulphate) are present.

WATERS

Please note we are not a UK Drinking Water Inspectorate (DWI) Approved Laboratory .

ISO17025 accreditation applies to surface water and groundwater and usually one other matrix which is analysis specific, any other liquids are outside our scope of accreditation.

As surface waters require different sample preparation to groundwaters the laboratory must be informed of the water type when submitting samples.

Where Mineral Oil or Fats, Oils and Grease is quoted, this refers to Total Aliphatics C10-C40.

DEVIATING SAMPLES

All samples should be submitted to the laboratory in suitable containers with sufficient ice packs to sustain an appropriate temperature for the requested analysis. The temperature of sample receipt is recorded on the confirmation schedules in order that the client can make an informed decision as to whether testing should still be undertaken.

SURROGATES

Surrogate compounds are added during the preparation process to monitor recovery of analytes. However low recovery in soils is often due to peat, clay or other organic rich matrices. For waters this can be due to oxidants, surfactants, organic rich sediments or remediation fluids. Acceptable limits for most organic methods are 70 - 130% and for VOCs are 50 - 150%. When surrogate recoveries are outside the performance criteria but the associated AQC passes this is assumed to be due to matrix effect. Results are not surrogate corrected.

DILUTIONS

A dilution suffix indicates a dilution has been performed and the reported result takes this into account. No further calculation is required.

BLANKS

Where analytes have been found in the blank, the sample will be treated in accordance with our laboratory procedure for dealing with contaminated blanks.

NOTE

Data is only reported if the laboratory is confident that the data is a true reflection of the samples analysed. Data is only reported as accredited when all the requirements of our Quality System have been met. In certain circumstances where all the requirements of the Quality System have not been met, for instance if the associated AQC has failed, the reason is fully investigated and documented. The sample data is then evaluated alongside the other quality control checks performed during analysis to determine its suitability. Following this evaluation, provided the sample results have not been effected, the data is reported but accreditation is removed. It is a UKAS requirement for data not reported as accredited to be considered indicative only, but this does not mean the data is not valid.

Where possible, and if requested, samples will be re-extracted and a revised report issued with accredited results. Please do not hesitate to contact the laboratory if further details are required of the circumstances which have led to the removal of accreditation.

Please include all sections of this report if it is reproduced

REPORTS FROM THE SOUTH AFRICA LABORATORY

Any method number not prefixed with SA has been undertaken in our UK laboratory unless reported as subcontracted.

Measurement Uncertainty

Measurement uncertainty defines the range of values that could reasonably be attributed to the measured quantity. This range of values has not been included within the reported results. Uncertainty expressed as a percentage can be provided upon request.

ABBREVIATIONS and ACRONYMS USED

#	ISO17025 (UKAS Ref No. 4225) accredited - UK.
SA	ISO17025 (SANAS Ref No.T0729) accredited - South Africa
B	Indicates analyte found in associated method blank.
DR	Dilution required.
M	MCERTS accredited.
NA	Not applicable
NAD	No Asbestos Detected.
ND	None Detected (usually refers to VOC and/SVOC TICs).
NDP	No Determination Possible
SS	Calibrated against a single substance
SV	Surrogate recovery outside performance criteria. This may be due to a matrix effect.
W	Results expressed on as received basis.
+	AQC failure, accreditation has been removed from this result, if appropriate, see 'Note' on previous page.
>>	Results above calibration range, the result should be considered the minimum value. The actual result could be significantly higher, this result is not accredited.
*	Analysis subcontracted to an Element Materials Technology approved laboratory.
AD	Samples are dried at 35°C ±5°C
CO	Suspected carry over
LOD/LOR	Limit of Detection (Limit of Reporting) in line with ISO 17025 and MCERTS
ME	Matrix Effect
NFD	No Fibres Detected
BS	AQC Sample
LB	Blank Sample
N	Client Sample
TB	Trip Blank Sample
OC	Outside Calibration Range

EMT Job No: 20/3675

Test Method No.	Description	Prep Method No. (if appropriate)	Description	ISO 17025 (UKAS/ANAS)	MCERTS (UK soils only)	Analysis done on As Received (AR) or Dried (AD)	Reported on dry weight basis
PM4	Gravimetric measurement of Natural Moisture Content and % Moisture Content at either 35°C or 105°C. Calculation based on ISO 11465 and BS1377.	PM0	No preparation is required.			AR	
TM4	Modified USEPA 8270 method for the solvent extraction and determination of PAHs by GC-MS.	PM8	End over end extraction of solid samples for organic analysis. The solvent mix varies depending on analysis required.			AR	Yes
TM4	Modified USEPA 8270 method for the solvent extraction and determination of PAHs by GC-MS.	PM8	End over end extraction of solid samples for organic analysis. The solvent mix varies depending on analysis required.	Yes		AR	Yes
TM5	Modified 8015B method for the determination of solvent Extractable Petroleum Hydrocarbons (EPH) within the range C8-C40 by GCFID. For waters the solvent extracts dissolved phase plus a sheen if present.	PM16	Fractionation into aliphatic and aromatic fractions using a Rapid Trace SPE.			AR	
TM5	Modified 8015B method for the determination of solvent Extractable Petroleum Hydrocarbons (EPH) within the range C8-C40 by GCFID. For waters the solvent extracts dissolved phase plus a sheen if present.	PM8/PM16	End over end extraction of solid samples for organic analysis. The solvent mix varies depending on analysis required/Fractionation into aliphatic and aromatic fractions using a Rapid Trace SPE.			AR	Yes
TM5	Modified 8015B method for the determination of solvent Extractable Petroleum Hydrocarbons (EPH) within the range C8-C40 by GCFID. For waters the solvent extracts dissolved phase plus a sheen if present.	PM8/PM16	End over end extraction of solid samples for organic analysis. The solvent mix varies depending on analysis required/Fractionation into aliphatic and aromatic fractions using a Rapid Trace SPE.	Yes		AR	Yes
TM5/TM36	please refer to TM5 and TM36 for method details	PM8/PM12/PM16	please refer to PM8/PM16 and PM12 for method details			AR	Yes
TM15	Modified USEPA 8260. Quantitative Determination of Volatile Organic Compounds (VOCs) by Headspace GC-MS.	PM10	Modified US EPA method 5021. Preparation of solid and liquid samples for GC headspace analysis.			AR	Yes
TM15	Modified USEPA 8260. Quantitative Determination of Volatile Organic Compounds (VOCs) by Headspace GC-MS.	PM10	Modified US EPA method 5021. Preparation of solid and liquid samples for GC headspace analysis.	Yes		AR	Yes
TM16	Modified USEPA 8270. Quantitative determination of Semi-Volatile Organic compounds (SVOCs) by GC-MS.	PM8	End over end extraction of solid samples for organic analysis. The solvent mix varies depending on analysis required.			AR	Yes

EMT Job No: 20/3675

Test Method No.	Description	Prep Method No. (if appropriate)	Description	ISO 17025 (UKAS/ANAS)	MCERTS (UK soils only)	Analysis done on As Received (AR) or Dried (AD)	Reported on dry weight basis
TM16	Modified USEPA 8270. Quantitative determination of Semi-Volatile Organic compounds (SVOCs) by GC-MS.	PM8	End over end extraction of solid samples for organic analysis. The solvent mix varies depending on analysis required.	Yes		AR	Yes
TM17	Modified US EPA method 8270. Determination of specific Polychlorinated Biphenyl congeners by GC-MS.	PM8	End over end extraction of solid samples for organic analysis. The solvent mix varies depending on analysis required.	Yes		AR	Yes
TM20	Modified BS 1377-3: 1990/USEPA 160.3 Gravimetric determination of Total Dissolved Solids/Total Solids	PM0	No preparation is required.	Yes		AR	Yes
TM21	Modified BS 7755-3:1995, ISO10694:1995 Determination of Total Organic Carbon or Total Carbon by combustion in an Eltra TOC furnace/analyser in the presence of oxygen. The CO ₂ generated is quantified using infra-red detection. Organic Matter (SOM) calculated as per EA MCERTS Chemical Testing of Soil, March 2012 v4.	PM24	Dried and ground solid samples are washed with hydrochloric acid, then rinsed with deionised water to remove the mineral carbon before TOC analysis.	Yes		AD	Yes
TM26	Determination of phenols by Reversed Phased High Performance Liquid Chromatography and Electro-Chemical Detection.	PM0	No preparation is required.			AR	Yes
TM30	Determination of Trace Metal elements by ICP-OES (Inductively Coupled Plasma - Optical Emission Spectrometry). Modified US EPA Method 200.7, 6010B and BS EN ISO 11885 2009	PM15	Acid digestion of dried and ground solid samples using Aqua Regia refluxed at 112.5 °C. Samples containing asbestos are not dried and ground.			AD	Yes
TM30	Determination of Trace Metal elements by ICP-OES (Inductively Coupled Plasma - Optical Emission Spectrometry). Modified US EPA Method 200.7, 6010B and BS EN ISO 11885 2009	PM15	Acid digestion of dried and ground solid samples using Aqua Regia refluxed at 112.5 °C. Samples containing asbestos are not dried and ground.	Yes		AD	Yes
TM30	Determination of Trace Metal elements by ICP-OES (Inductively Coupled Plasma - Optical Emission Spectrometry). Modified US EPA Method 200.7, 6010B and BS EN ISO 11885 2009	PM17	Modified method BS EN12457-2 As received solid samples are leached with water in a 10:1 water to soil ratio for 24 hours, the moisture content of the sample is included in the ratio.	Yes		AR	Yes
TM36	Modified US EPA method 8015B. Determination of Gasoline Range Organics (GRO) in the carbon chain range of C4-12 by headspace GC-FID. MTBE by GC/FID co-elutes with 3-methylpentane if present and therefore can give a false positive. Positive MTBE results can be confirmed using GCMS.	PM12	Modified US EPA method 5021. Preparation of solid and liquid samples for GC headspace analysis.			AR	Yes
TM36	Modified US EPA method 8015B. Determination of Gasoline Range Organics (GRO) in the carbon chain range of C4-12 by headspace GC-FID. MTBE by GC/FID co-elutes with 3-methylpentane if present and therefore can give a false positive. Positive MTBE results can be confirmed using GCMS.	PM12	Modified US EPA method 5021. Preparation of solid and liquid samples for GC headspace analysis.	Yes		AR	Yes

EMT Job No: 20/3675

Test Method No.	Description	Prep Method No. (if appropriate)	Description	ISO 17025 (UKAS/S ANAS)	MCERTS (UK soils only)	Analysis done on As Received (AR) or Dried (AD)	Reported on dry weight basis
TM38	Soluble Ion analysis using Discrete Analyser. Modified US EPA methods 325.2 (Chloride), 375.4 (Sulphate), 365.2 (o-Phosphate), 353.1 (TON), 354.1 (Nitrite), 350.1 (NH4+) comparable to BS ISO 15923-1, 7196A (Hex Cr)	PM0	No preparation is required.	Yes		AR	Yes
TM38	Soluble Ion analysis using Discrete Analyser. Modified US EPA methods 325.2 (Chloride), 375.4 (Sulphate), 365.2 (o-Phosphate), 353.1 (TON), 354.1 (Nitrite), 350.1 (NH4+) comparable to BS ISO 15923-1, 7196A (Hex Cr)	PM20	Extraction of dried and ground or as received samples with deionised water in a 2:1 water to solid ratio using a reciprocal shaker for all analytes except hexavalent chromium. Extraction of as received sample using 10:1 ratio of 0.2M sodium hydroxide to soil for hexavalent chromium using a reciprocal shaker.	Yes		AD	Yes
TM38	Soluble Ion analysis using Discrete Analyser. Modified US EPA methods 325.2 (Chloride), 375.4 (Sulphate), 365.2 (o-Phosphate), 353.1 (TON), 354.1 (Nitrite), 350.1 (NH4+) comparable to BS ISO 15923-1, 7196A (Hex Cr)	PM20	Extraction of dried and ground or as received samples with deionised water in a 2:1 water to solid ratio using a reciprocal shaker for all analytes except hexavalent chromium. Extraction of as received sample using 10:1 ratio of 0.2M sodium hydroxide to soil for hexavalent chromium using a reciprocal shaker.			AR	Yes
TM38	Soluble Ion analysis using Discrete Analyser. Modified US EPA methods 325.2 (Chloride), 375.4 (Sulphate), 365.2 (o-Phosphate), 353.1 (TON), 354.1 (Nitrite), 350.1 (NH4+) comparable to BS ISO 15923-1, 7196A (Hex Cr)	PM20	Extraction of dried and ground or as received samples with deionised water in a 2:1 water to solid ratio using a reciprocal shaker for all analytes except hexavalent chromium. Extraction of as received sample using 10:1 ratio of 0.2M sodium hydroxide to soil for hexavalent chromium using a reciprocal shaker.	Yes		AR	Yes
TM50	Acid soluble sulphate (Total Sulphate) analysed by ICP-OES	PM29	A hot hydrochloric acid digest is performed on a dried and ground sample, and the resulting liquor is analysed.	Yes		AD	Yes
TM60	TC/TOC analysis of Waters by High Temperature Combustion followed by NDIR detection. Based on the following modified standard methods: USEPA 9060, APHA Standard Methods for Examination of Water and Wastewater 5310B, ASTM D 7573, and USEPA 415.1.	PM0	No preparation is required.			AR	Yes
TM61	Modified US EPA methods 245.7 and 200.7. Determination of Mercury by Cold Vapour Atomic Fluorescence.	PM0	No preparation is required.	Yes		AR	Yes
TM65	Asbestos Bulk Identification method based on HSG 248.	PM42	Solid samples undergo a thorough visual inspection for asbestos fibres prior to asbestos identification using TM065.	Yes		AR	
TM73	Modified US EPA methods 150.1 and 9045D and BS1377:1990. Determination of pH by Metrohm automated probe analyser.	PM0	No preparation is required.			AR	Yes
TM73	Modified US EPA methods 150.1 and 9045D and BS1377:1990. Determination of pH by Metrohm automated probe analyser.	PM11	Extraction of as received solid samples using one part solid to 2.5 parts deionised water.	Yes		AR	No

EMT Job No: 20/3675

Test Method No.	Description	Prep Method No. (if appropriate)	Description	ISO 17025 (UKAS/S ANAS)	MCERTS (UK soils only)	Analysis done on As Received (AR) or Dried (AD)	Reported on dry weight basis
TM89	Modified USEPA method OIA-1667. Determination of cyanide by Flow Injection Analyser. Where WAD cyanides are required a Ligand displacement step is carried out before analysis.	PM45	As received solid samples are extracted with 1M NaOH by orbital shaker for Cyanide, Sulphide and Thiocyanate analysis.	Yes		AR	Yes
TM107	Determination of Sulphide/Thiocyanate by Skalar Continuous Flow Analyser	PM45	As received solid samples are extracted with 1M NaOH by orbital shaker for Cyanide, Sulphide and Thiocyanate analysis.			AR	Yes
TM108	Determination of Elemental Sulphur by Reversed Phase High Performance Liquid Chromatography with Ultra Violet spectroscopy.	PM114	End over end extraction of dried and crushed soil samples for organic analysis. The solvent mix varies depending on analysis required			AD	Yes
TM173	Analysis of fluoride by ISE (Ion Selective Electrode) using modified ISE method 340.2	PM0	No preparation is required.			AR	Yes
NONE	No Method Code	NONE	No Method Code			AD	Yes
NONE	No Method Code	PM17	Modified method BS EN12457-2 As received solid samples are leached with water in a 10:1 water to soil ratio for 24 hours, the moisture content of the sample is included in the ratio.				
NONE	No Method Code	PM17	Modified method BS EN12457-2 As received solid samples are leached with water in a 10:1 water to soil ratio for 24 hours, the moisture content of the sample is included in the ratio.			AR	
NONE	No Method Code	PM4	Gravimetric measurement of Natural Moisture Content and % Moisture Content at either 35°C or 105°C. Calculation based on ISO 11465 and BS1377.			AR	
TM15_A	Modified USEPA 8260. Quantitative Determination of Volatile Organic Compounds, Vinyl Chloride & Styrene by Headspace GC-MS.	PM10	Modified US EPA method 5021. Preparation of solid and liquid samples for GC headspace analysis.			AR	Yes

Ground Investigations Ireland
Catherinestown House
Hazelhatch Road
Newcastle
Co. Dublin
Ireland



Attention : Mike Sutton
Date : 22nd July, 2020
Your reference : 9429-02-20
Our reference : Test Report 20/9186 Batch 1
Location : Whitehall Swords Road
Date samples received : 14th July, 2020
Status : Final report
Issue : 1

Ten samples were received for analysis on 14th July, 2020 of which ten were scheduled for analysis. Please find attached our Test Report which should be read with notes at the end of the report and should include all sections if reproduced. Interpretations and opinions are outside the scope of any accreditation, and all results relate only to samples supplied.
All analysis is carried out on as received samples and reported on a dry weight basis unless stated otherwise. Results are not surrogate corrected.

Authorised By:



Phil Sommerton BSc
Senior Project Manager

Please include all sections of this report if it is reproduced

Element Materials Technology

Client Name: Ground Investigations Ireland
Reference: 9429-02-20
Location: Whitehall Swords Road
Contact: Mike Sutton
EMT Job No: 20/9186

Report : Solid

Solids: V=60g VOC jar, J=250g glass jar, T=plastic tub

[illegible]

Client Name: Ground Investigations Ireland

Reference: 9429-02-20

Location: Whitehall Swords Road

Contact: Mike Sutton

[illegible]

Please note that only samples that are deviating are mentioned in this report. If no samples are listed it is because none were deviating. Only analyses which are accredited are recorded as deviating if set criteria are not met.

NOTES TO ACCOMPANY ALL SCHEDULES AND REPORTS

EMT Job No.: 20/9186

SOILS

Please note we are only MCERTS accredited (UK soils only) for sand, loam and clay and any other matrix is outside our scope of accreditation.

Where an MCERTS report has been requested, you will be notified within 48 hours of any samples that have been identified as being outside our MCERTS scope. As validation has been performed on clay, sand and loam, only samples that are predominantly these matrices, or combinations of them will be within our MCERTS scope. If samples are not one of a combination of the above matrices they will not be marked as MCERTS accredited.

It is assumed that you have taken representative samples on site and require analysis on a representative subsample. Stones will generally be included unless we are requested to remove them.

All samples will be discarded one month after the date of reporting, unless we are instructed to the contrary.

If you have not already done so, please send us a purchase order if this is required by your company.

Where appropriate please make sure that our detection limits are suitable for your needs, if they are not, please notify us immediately.

All analysis is reported on a dry weight basis unless stated otherwise. Limits of detection for analyses carried out on as received samples are not moisture content corrected. Results are not surrogate corrected. Samples are dried at 35°C ±5°C unless otherwise stated. Moisture content for CEN Leachate tests are dried at 105°C ±5°C.

Where Mineral Oil or Fats, Oils and Grease is quoted, this refers to Total Aliphatics C10-C40.

Where a CEN 10:1 ZERO Headspace VOC test has been carried out, a 10:1 ratio of water to wet (as received) soil has been used.

% Asbestos in Asbestos Containing Materials (ACMs) is determined by reference to HSG 264 The Survey Guide - Appendix 2 : ACMs in buildings listed in order of ease of fibre release.

Sufficient amount of sample must be received to carry out the testing specified. Where an insufficient amount of sample has been received the testing may not meet the requirements of our accredited methods, as such accreditation may be removed.

Negative Neutralization Potential (NP) values are obtained when the volume of NaOH (0.1N) titrated (pH 8.3) is greater than the volume of HCl (1N) to reduce the pH of the sample to 2.0 - 2.5. Any negative NP values are corrected to 0.

The calculation of Pyrite content assumes that all oxidisable sulphides present in the sample are pyrite. This may not be the case. The calculation may be an overestimate when other sulphides such as Barite (Barium Sulphate) are present.

WATERS

Please note we are not a UK Drinking Water Inspectorate (DWI) Approved Laboratory .

ISO17025 accreditation applies to surface water and groundwater and usually one other matrix which is analysis specific, any other liquids are outside our scope of accreditation.

As surface waters require different sample preparation to groundwaters the laboratory must be informed of the water type when submitting samples.

Where Mineral Oil or Fats, Oils and Grease is quoted, this refers to Total Aliphatics C10-C40.

DEVIATING SAMPLES

All samples should be submitted to the laboratory in suitable containers with sufficient ice packs to sustain an appropriate temperature for the requested analysis. The temperature of sample receipt is recorded on the confirmation schedules in order that the client can make an informed decision as to whether testing should still be undertaken.

SURROGATES

Surrogate compounds are added during the preparation process to monitor recovery of analytes. However low recovery in soils is often due to peat, clay or other organic rich matrices. For waters this can be due to oxidants, surfactants, organic rich sediments or remediation fluids. Acceptable limits for most organic methods are 70 - 130% and for VOCs are 50 - 150%. When surrogate recoveries are outside the performance criteria but the associated AQC passes this is assumed to be due to matrix effect. Results are not surrogate corrected.

DILUTIONS

A dilution suffix indicates a dilution has been performed and the reported result takes this into account. No further calculation is required.

BLANKS

Where analytes have been found in the blank, the sample will be treated in accordance with our laboratory procedure for dealing with contaminated blanks.

NOTE

Data is only reported if the laboratory is confident that the data is a true reflection of the samples analysed. Data is only reported as accredited when all the requirements of our Quality System have been met. In certain circumstances where all the requirements of the Quality System have not been met, for instance if the associated AQC has failed, the reason is fully investigated and documented. The sample data is then evaluated alongside the other quality control checks performed during analysis to determine its suitability. Following this evaluation, provided the sample results have not been effected, the data is reported but accreditation is removed. It is a UKAS requirement for data not reported as accredited to be considered indicative only, but this does not mean the data is not valid.

Where possible, and if requested, samples will be re-extracted and a revised report issued with accredited results. Please do not hesitate to contact the laboratory if further details are required of the circumstances which have led to the removal of accreditation.

Please include all sections of this report if it is reproduced

REPORTS FROM THE SOUTH AFRICA LABORATORY

Any method number not prefixed with SA has been undertaken in our UK laboratory unless reported as subcontracted.

Measurement Uncertainty

Measurement uncertainty defines the range of values that could reasonably be attributed to the measured quantity. This range of values has not been included within the reported results. Uncertainty expressed as a percentage can be provided upon request.

ABBREVIATIONS and ACRONYMS USED

#	ISO17025 (UKAS Ref No. 4225) accredited - UK.
SA	ISO17025 (SANAS Ref No.T0729) accredited - South Africa
B	Indicates analyte found in associated method blank.
DR	Dilution required.
M	MCERTS accredited.
NA	Not applicable
NAD	No Asbestos Detected.
ND	None Detected (usually refers to VOC and/SVOC TICs).
NDP	No Determination Possible
SS	Calibrated against a single substance
SV	Surrogate recovery outside performance criteria. This may be due to a matrix effect.
W	Results expressed on as received basis.
+	AQC failure, accreditation has been removed from this result, if appropriate, see 'Note' on previous page.
>>	Results above calibration range, the result should be considered the minimum value. The actual result could be significantly higher, this result is not accredited.
*	Analysis subcontracted to an Element Materials Technology approved laboratory.
AD	Samples are dried at 35°C ±5°C
CO	Suspected carry over
LOD/LOR	Limit of Detection (Limit of Reporting) in line with ISO 17025 and MCERTS
ME	Matrix Effect
NFD	No Fibres Detected
BS	AQC Sample
LB	Blank Sample
N	Client Sample
TB	Trip Blank Sample
OC	Outside Calibration Range

EMT Job No: 20/9186

[illegible]

Ground Investigations Ireland
Catherinestown House
Hazelhatch Road
Newcastle
Co. Dublin
Ireland



Attention : Mike Sutton
Date : 28th July, 2020
Your reference : 9429-02-20
Our reference : Test Report 20/9618 Batch 1
Location : Whitehall Swords
Date samples received : 22nd July, 2020
Status : Final report
Issue : 1

One sample was received for analysis on 22nd July, 2020 of which one was scheduled for analysis. Please find attached our Test Report which should be read with notes at the end of the report and should include all sections if reproduced. Interpretations and opinions are outside the scope of any accreditation, and all results relate only to samples supplied. □
All analysis is carried out on as received samples and reported on a dry weight basis unless stated otherwise. Results are not surrogate corrected.

Authorised By:



Bruce Leslie
Project Manager

Please include all sections of this report if it is reproduced

Element Materials Technology

Client Name: Ground Investigations Ireland
Reference: 9429-02-20
Location: Whitehall Swords
Contact: Mike Sutton
EMT Job No: 20/9618

Report : Solid

Solids: V=60g VOC jar, J=250g glass jar, T=plastic tub

[illegible]

Client Name: Ground Investigations Ireland

Reference: 9429-02-20

Location: Whitehall Swords

Contact: Mike Sutton

[illegible]

Please note that only samples that are deviating are mentioned in this report. If no samples are listed it is because none were deviating. Only analyses which are accredited are recorded as deviating if set criteria are not met.

NOTES TO ACCOMPANY ALL SCHEDULES AND REPORTS

EMT Job No.: 20/9618

SOILS

Please note we are only MCERTS accredited (UK soils only) for sand, loam and clay and any other matrix is outside our scope of accreditation.

Where an MCERTS report has been requested, you will be notified within 48 hours of any samples that have been identified as being outside our MCERTS scope. As validation has been performed on clay, sand and loam, only samples that are predominantly these matrices, or combinations of them will be within our MCERTS scope. If samples are not one of a combination of the above matrices they will not be marked as MCERTS accredited.

It is assumed that you have taken representative samples on site and require analysis on a representative subsample. Stones will generally be included unless we are requested to remove them.

All samples will be discarded one month after the date of reporting, unless we are instructed to the contrary.

If you have not already done so, please send us a purchase order if this is required by your company.

Where appropriate please make sure that our detection limits are suitable for your needs, if they are not, please notify us immediately.

All analysis is reported on a dry weight basis unless stated otherwise. Limits of detection for analyses carried out on as received samples are not moisture content corrected. Results are not surrogate corrected. Samples are dried at 35°C ±5°C unless otherwise stated. Moisture content for CEN Leachate tests are dried at 105°C ±5°C.

Where Mineral Oil or Fats, Oils and Grease is quoted, this refers to Total Aliphatics C10-C40.

Where a CEN 10:1 ZERO Headspace VOC test has been carried out, a 10:1 ratio of water to wet (as received) soil has been used.

% Asbestos in Asbestos Containing Materials (ACMs) is determined by reference to HSG 264 The Survey Guide - Appendix 2 : ACMs in buildings listed in order of ease of fibre release.

Sufficient amount of sample must be received to carry out the testing specified. Where an insufficient amount of sample has been received the testing may not meet the requirements of our accredited methods, as such accreditation may be removed.

Negative Neutralization Potential (NP) values are obtained when the volume of NaOH (0.1N) titrated (pH 8.3) is greater than the volume of HCl (1N) to reduce the pH of the sample to 2.0 - 2.5. Any negative NP values are corrected to 0.

The calculation of Pyrite content assumes that all oxidisable sulphides present in the sample are pyrite. This may not be the case. The calculation may be an overestimate when other sulphides such as Barite (Barium Sulphate) are present.

WATERS

Please note we are not a UK Drinking Water Inspectorate (DWI) Approved Laboratory .

ISO17025 accreditation applies to surface water and groundwater and usually one other matrix which is analysis specific, any other liquids are outside our scope of accreditation.

As surface waters require different sample preparation to groundwaters the laboratory must be informed of the water type when submitting samples.

Where Mineral Oil or Fats, Oils and Grease is quoted, this refers to Total Aliphatics C10-C40.

DEVIATING SAMPLES

All samples should be submitted to the laboratory in suitable containers with sufficient ice packs to sustain an appropriate temperature for the requested analysis. The temperature of sample receipt is recorded on the confirmation schedules in order that the client can make an informed decision as to whether testing should still be undertaken.

SURROGATES

Surrogate compounds are added during the preparation process to monitor recovery of analytes. However low recovery in soils is often due to peat, clay or other organic rich matrices. For waters this can be due to oxidants, surfactants, organic rich sediments or remediation fluids. Acceptable limits for most organic methods are 70 - 130% and for VOCs are 50 - 150%. When surrogate recoveries are outside the performance criteria but the associated AQC passes this is assumed to be due to matrix effect. Results are not surrogate corrected.

DILUTIONS

A dilution suffix indicates a dilution has been performed and the reported result takes this into account. No further calculation is required.

BLANKS

Where analytes have been found in the blank, the sample will be treated in accordance with our laboratory procedure for dealing with contaminated blanks.

NOTE

Data is only reported if the laboratory is confident that the data is a true reflection of the samples analysed. Data is only reported as accredited when all the requirements of our Quality System have been met. In certain circumstances where all the requirements of the Quality System have not been met, for instance if the associated AQC has failed, the reason is fully investigated and documented. The sample data is then evaluated alongside the other quality control checks performed during analysis to determine its suitability. Following this evaluation, provided the sample results have not been effected, the data is reported but accreditation is removed. It is a UKAS requirement for data not reported as accredited to be considered indicative only, but this does not mean the data is not valid.

Where possible, and if requested, samples will be re-extracted and a revised report issued with accredited results. Please do not hesitate to contact the laboratory if further details are required of the circumstances which have led to the removal of accreditation.

Please include all sections of this report if it is reproduced

REPORTS FROM THE SOUTH AFRICA LABORATORY

Any method number not prefixed with SA has been undertaken in our UK laboratory unless reported as subcontracted.

Measurement Uncertainty

Measurement uncertainty defines the range of values that could reasonably be attributed to the measured quantity. This range of values has not been included within the reported results. Uncertainty expressed as a percentage can be provided upon request.

ABBREVIATIONS and ACRONYMS USED

#	ISO17025 (UKAS Ref No. 4225) accredited - UK.
SA	ISO17025 (SANAS Ref No.T0729) accredited - South Africa
B	Indicates analyte found in associated method blank.
DR	Dilution required.
M	MCERTS accredited.
NA	Not applicable
NAD	No Asbestos Detected.
ND	None Detected (usually refers to VOC and/SVOC TICs).
NDP	No Determination Possible
SS	Calibrated against a single substance
SV	Surrogate recovery outside performance criteria. This may be due to a matrix effect.
W	Results expressed on as received basis.
+	AQC failure, accreditation has been removed from this result, if appropriate, see 'Note' on previous page.
>>	Results above calibration range, the result should be considered the minimum value. The actual result could be significantly higher, this result is not accredited.
*	Analysis subcontracted to an Element Materials Technology approved laboratory.
AD	Samples are dried at 35°C ±5°C
CO	Suspected carry over
LOD/LOR	Limit of Detection (Limit of Reporting) in line with ISO 17025 and MCERTS
ME	Matrix Effect
NFD	No Fibres Detected
BS	AQC Sample
LB	Blank Sample
N	Client Sample
TB	Trip Blank Sample
OC	Outside Calibration Range

EMT Job No: 20/9618

[illegible]

Ground Investigations Ireland
Catherinestown House
Hazelhatch Road
Newcastle
Co. Dublin
Ireland




Attention : Mike Sutton
Date : 22nd July, 2020
Your reference : 9429-02-20
Our reference : Test Report 20/9144 Batch 1
Location : Whitehall, Swords, Road Extension
Date samples received : 14th July, 2020
Status : Final report
Issue : 1

Three samples were received for analysis on 14th July, 2020 of which three were scheduled for analysis. Please find attached our Test Report which should be read with notes at the end of the report and should include all sections if reproduced. Interpretations and opinions are outside the scope of any accreditation, and all results relate only to samples supplied.

All analysis is carried out on as received samples and reported on a dry weight basis unless stated otherwise. Results are not surrogate corrected.

Authorised By:

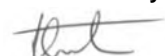

Phil Sommerton BSc
Senior Project Manager

Please include all sections of this report if it is reproduced

Element Materials Technology

Client Name: Ground Investigations Ireland
Reference: 9429-02-20
Location: Whitehall, Swords, Road Extension
Contact: Mike Sutton
EMT Job No: 20/9144

Report : Liquid

Liquids/products: V=40ml vial, G=glass bottle, P=plastic bottle
H=H₂SO₄, Z=ZnAc, N=NaOH, HN=HN₃

EMT Sample No.	1-10	11-16,18-19	21-30								Please see attached notes for all abbreviations and acronyms		
Sample ID	BH01	BH06	BH10										
Depth													
COC No / misc													
Containers	V H HN HCL Z P BOD G	V H HN HCL Z BOD G	V H HN HCL Z P BOD G										
Sample Date	13/07/2020	13/07/2020	13/07/2020										
Sample Type	Ground Water	Ground Water	Ground Water										
Batch Number	1	1	1										
Date of Receipt	14/07/2020	14/07/2020	14/07/2020								LOD/LOR	Units	Method No.
Dissolved Antimony #	<2	<2	<2								<2	ug/l	TM30/PM14
Dissolved Arsenic #	<2.5	2.7	3.4								<2.5	ug/l	TM30/PM14
Dissolved Barium #	108	76	99								<3	ug/l	TM30/PM14
Dissolved Cadmium #	<0.5	<0.5	<0.5								<0.5	ug/l	TM30/PM14
Total Dissolved Chromium #	<1.5	<1.5	<1.5								<1.5	ug/l	TM30/PM14
Dissolved Copper #	<7	<7	<7								<7	ug/l	TM30/PM14
Dissolved Lead #	<5	<5	<5								<5	ug/l	TM30/PM14
Dissolved Mercury #	<1	<1	<1								<1	ug/l	TM30/PM14
Dissolved Molybdenum #	3	14	6								<2	ug/l	TM30/PM14
Dissolved Nickel #	8	12	10								<2	ug/l	TM30/PM14
Dissolved Selenium #	<3	<3	<3								<3	ug/l	TM30/PM14
Dissolved Zinc #	6	4	10								<3	ug/l	TM30/PM14
PAH MS													
Naphthalene #	<0.1	<0.1	<0.1								<0.1	ug/l	TM4/PM30
Acenaphthylene #	<0.013	<0.013	<0.013								<0.013	ug/l	TM4/PM30
Acenaphthene #	<0.013	<0.013	<0.013								<0.013	ug/l	TM4/PM30
Fluorene #	<0.014	<0.014	<0.014								<0.014	ug/l	TM4/PM30
Phenanthrene #	<0.011	<0.011	<0.011								<0.011	ug/l	TM4/PM30
Anthracene #	<0.013	<0.013	<0.013								<0.013	ug/l	TM4/PM30
Fluoranthene #	<0.012	<0.012	<0.012								<0.012	ug/l	TM4/PM30
Pyrene #	<0.013	<0.013	<0.013								<0.013	ug/l	TM4/PM30
Benzo(a)anthracene #	<0.015	<0.015	<0.015								<0.015	ug/l	TM4/PM30
Chrysene #	<0.011	<0.011	<0.011								<0.011	ug/l	TM4/PM30
Benzo(bk)fluoranthene #	<0.018	<0.018	<0.018								<0.018	ug/l	TM4/PM30
Benzo(a)pyrene #	<0.016	<0.016	<0.016								<0.016	ug/l	TM4/PM30
Indeno(123cd)pyrene #	<0.011	<0.011	<0.011								<0.011	ug/l	TM4/PM30
Dibenzo(ah)anthracene #	<0.01	<0.01	<0.01								<0.01	ug/l	TM4/PM30
Benzo(ghi)perylene #	<0.011	<0.011	<0.011								<0.011	ug/l	TM4/PM30
PAH 16 Total #	<0.195	<0.195	<0.195								<0.195	ug/l	TM4/PM30
Benzo(b)fluoranthene	<0.01	<0.01	<0.01								<0.01	ug/l	TM4/PM30
Benzo(k)fluoranthene	<0.01	<0.01	<0.01								<0.01	ug/l	TM4/PM30
PAH Surrogate % Recovery	82	88	87								<0	%	TM4/PM30
Methyl Tertiary Butyl Ether #	<0.1	<0.1	<0.1								<0.1	ug/l	TM15/PM10
Benzene #	<0.5	<0.5	<0.5								<0.5	ug/l	TM15/PM10
Toluene #	<5	<5	<5								<5	ug/l	TM15/PM10
Ethylbenzene #	<1	<1	<1								<1	ug/l	TM15/PM10
m/p-Xylene #	<2	<2	<2								<2	ug/l	TM15/PM10
o-Xylene #	<1	<1	<1								<1	ug/l	TM15/PM10
Surrogate Recovery Toluene D8	107	106	108								<0	%	TM15/PM10
Surrogate Recovery 4-Bromofluorobenzene	108	105	108								<0	%	TM15/PM10

Element Materials Technology

Client Name: Ground Investigations Ireland
Reference: 9429-02-20
Location: Whitehall, Swords, Road Extension
Contact: Mike Sutton
EMT Job No: 20/9144

Report : Liquid

Liquids/products: V=40ml vial, G=glass bottle, P=plastic bottle
 H=H₂SO₄, Z=ZnAc, N=NaOH, HN=HNO₃

EMT Sample No.	1-10	11-16,18-19	21-30								Please see attached notes for all abbreviations and acronyms		
Sample ID	BH01	BH06	BH10										
Depth													
COC No / misc													
Containers	V H HN HCL Z P BOD G	V H HN HCL Z BOD G	V H HN HCL Z P BOD G										
Sample Date	13/07/2020	13/07/2020	13/07/2020										
Sample Type	Ground Water	Ground Water	Ground Water										
Batch Number	1	1	1										
Date of Receipt	14/07/2020	14/07/2020	14/07/2020								LOD/LOR	Units	Method No.
TPH CWG													
Aliphatics													
>C5-C6 #	<10	<10	<10								<10	ug/l	TM36/PM12
>C6-C8 #	<10	<10	<10								<10	ug/l	TM36/PM12
>C8-C10 #	<10	<10	<10								<10	ug/l	TM36/PM12
>C10-C12 #	<5	<5	<5								<5	ug/l	TM5/PM16/PM30
>C12-C16 #	<10	<10	<10								<10	ug/l	TM5/PM16/PM30
>C16-C21 #	<10	<10	<10								<10	ug/l	TM5/PM16/PM30
>C21-C35 #	<10	<10	<10								<10	ug/l	TM5/PM16/PM30
Total aliphatics C5-35 #	<10	<10	<10								<10	ug/l	TM5/PM16/PM30
Aromatics													
>C5-EC7 #	<10	<10	<10								<10	ug/l	TM36/PM12
>EC7-EC8 #	<10	<10	<10								<10	ug/l	TM36/PM12
>EC8-EC10 #	<10	<10	<10								<10	ug/l	TM36/PM12
>EC10-EC12 #	<5	<5	<5								<5	ug/l	TM5/PM16/PM30
>EC12-EC16 #	<10	<10	<10								<10	ug/l	TM5/PM16/PM30
>EC16-EC21 #	<10	<10	<10								<10	ug/l	TM5/PM16/PM30
>EC21-EC35 #	<10	<10	<10								<10	ug/l	TM5/PM16/PM30
Total aromatics C5-35 #	<10	<10	<10								<10	ug/l	TM5/PM16/PM30
Total aliphatics and aromatics(C5-35) #	<10	<10	<10								<10	ug/l	TM5/PM16/PM30
PCB 28	<0.1	<0.1	<0.1								<0.1	ug/l	TM17/PM30
PCB 52	<0.1	<0.1	<0.1								<0.1	ug/l	TM17/PM30
PCB 101	<0.1	<0.1	<0.1								<0.1	ug/l	TM17/PM30
PCB 118	<0.1	<0.1	<0.1								<0.1	ug/l	TM17/PM30
PCB 138	<0.1	<0.1	<0.1								<0.1	ug/l	TM17/PM30
PCB 153	<0.1	<0.1	<0.1								<0.1	ug/l	TM17/PM30
PCB 180	<0.1	<0.1	<0.1								<0.1	ug/l	TM17/PM30
Total 7 PCBs	<0.7	<0.7	<0.7								<0.7	ug/l	TM17/PM30
Sulphate as SO ₄ #	384.0	370.7	302.1								<0.5	mg/l	TM38/PM0
Chloride #	16.6	97.5	20.8								<0.3	mg/l	TM38/PM0
Ammoniacal Nitrogen as N #	0.23	0.24	0.14								<0.03	mg/l	TM38/PM0
Electrical Conductivity @25C #	1418	1388	1066								<2	uS/cm	TM76/PM0
pH #	7.46	7.62	7.75								<0.01	pH units	TM73/PM0

Element Materials Technology

Client Name: Ground Investigations Ireland
Reference: 9429-02-20
Location: Whitehall, Swords, Road Extension
Contact: Mike Sutton
EMT Job No: 20/9144

SVOC Report : Liquid

EMT Sample No.	1-10	11-16,18-19	21-30									
Sample ID	BH01	BH06	BH10									
Depth												
COC No / misc												
Containers	V H H N HCL Z P BOD G	V H H N HCL Z BOD G	V H H N HCL Z P BOD G									
Sample Date	13/07/2020	13/07/2020	13/07/2020									
Sample Type	Ground Water	Ground Water	Ground Water									
Batch Number	1	1	1									
Date of Receipt	14/07/2020	14/07/2020	14/07/2020									
	LOD/LOR	Units	Method No.									
SVOC MS												
Phenols												
2-Chlorophenol #	<1	<1	<1							<1	ug/l	TM16/PM30
2-Methylphenol #	<0.5	<0.5	<0.5							<0.5	ug/l	TM16/PM30
2-Nitrophenol	<0.5	<0.5	<0.5							<0.5	ug/l	TM16/PM30
2,4-Dichlorophenol #	<0.5	<0.5	<0.5							<0.5	ug/l	TM16/PM30
2,4-Dimethylphenol	<1	<1	<1							<1	ug/l	TM16/PM30
2,4,5-Trichlorophenol #	<0.5	<0.5	<0.5							<0.5	ug/l	TM16/PM30
2,4,6-Trichlorophenol	<1	<1	<1							<1	ug/l	TM16/PM30
4-Chloro-3-methylphenol #	<0.5	<0.5	<0.5							<0.5	ug/l	TM16/PM30
4-Methylphenol	<1	<1	<1							<1	ug/l	TM16/PM30
4-Nitrophenol	<10	<10	<10							<10	ug/l	TM16/PM30
Pentachlorophenol	<1	<1	<1							<1	ug/l	TM16/PM30
Phenol	<1	<1	<1							<1	ug/l	TM16/PM30
PAHs												
2-Chloronaphthalene #	<1	<1	<1							<1	ug/l	TM16/PM30
2-Methylnaphthalene #	<1	<1	<1							<1	ug/l	TM16/PM30
Phthalates												
Bis(2-ethylhexyl) phthalate	<5	<5	<5							<5	ug/l	TM16/PM30
Butylbenzyl phthalate	<1	<1	<1							<1	ug/l	TM16/PM30
Di-n-butyl phthalate #	<1.5	<1.5	<1.5							<1.5	ug/l	TM16/PM30
Di-n-Octyl phthalate	<1	<1	<1							<1	ug/l	TM16/PM30
Diethyl phthalate #	<1	<1	<1							<1	ug/l	TM16/PM30
Dimethyl phthalate	<1	<1	<1							<1	ug/l	TM16/PM30
Other SVOCs												
1,2-Dichlorobenzene #	<1	<1	<1							<1	ug/l	TM16/PM30
1,2,4-Trichlorobenzene #	<1	<1	<1							<1	ug/l	TM16/PM30
1,3-Dichlorobenzene #	<1	<1	<1							<1	ug/l	TM16/PM30
1,4-Dichlorobenzene #	<1	<1	<1							<1	ug/l	TM16/PM30
2-Nitroaniline	<1	<1	<1							<1	ug/l	TM16/PM30
2,4-Dinitrotoluene #	<0.5	<0.5	<0.5							<0.5	ug/l	TM16/PM30
2,6-Dinitrotoluene	<1	<1	<1							<1	ug/l	TM16/PM30
3-Nitroaniline	<1	<1	<1							<1	ug/l	TM16/PM30
4-Bromophenylphenylether #	<1	<1	<1							<1	ug/l	TM16/PM30
4-Chloroaniline	<1	<1	<1							<1	ug/l	TM16/PM30
4-Chlorophenylphenylether #	<1	<1	<1							<1	ug/l	TM16/PM30
4-Nitroaniline	<0.5	<0.5	<0.5							<0.5	ug/l	TM16/PM30
Azobenzene #	<0.5	<0.5	<0.5							<0.5	ug/l	TM16/PM30
Bis(2-chloroethoxy)methane #	<0.5	<0.5	<0.5							<0.5	ug/l	TM16/PM30
Bis(2-chloroethyl)ether #	<1	<1	<1							<1	ug/l	TM16/PM30
Carbazole #	<0.5	<0.5	<0.5							<0.5	ug/l	TM16/PM30
Dibenzofuran #	<0.5	<0.5	<0.5							<0.5	ug/l	TM16/PM30
Hexachlorobenzene #	<1	<1	<1							<1	ug/l	TM16/PM30
Hexachlorobutadiene #	<1	<1	<1							<1	ug/l	TM16/PM30
Hexachlorocyclopentadiene	<1	<1	<1							<1	ug/l	TM16/PM30
Hexachloroethane #	<1	<1	<1							<1	ug/l	TM16/PM30
Isophorone #	<0.5	<0.5	<0.5							<0.5	ug/l	TM16/PM30
N-nitrosodi-n-propylamine #	<0.5	<0.5	<0.5							<0.5	ug/l	TM16/PM30
Nitrobenzene #	<1	<1	<1							<1	ug/l	TM16/PM30
Surrogate Recovery 2-Fluorobiphenyl	108	113	103							<0	%	TM16/PM30
Surrogate Recovery p-Terphenyl-d14	126	112	109							<0	%	TM16/PM30

Please see attached notes for all abbreviations and acronyms

Element Materials Technology

Client Name: Ground Investigations Ireland
Reference: 9429-02-20
Location: Whitehall, Swords, Road Extension
Contact: Mike Sutton
EMT Job No: 20/9144

VOC Report : Liquid

EMT Sample No.	1-10	11-16,18-19	21-30									
Sample ID	BH01	BH06	BH10									
Depth												
COC No / misc												
Containers	V H H N H C L Z P B O D G	V H H N H C L Z B O D G	V H H N H C L Z P B O D G									
Sample Date	13/07/2020	13/07/2020	13/07/2020									
Sample Type	Ground Water	Ground Water	Ground Water									
Batch Number	1	1	1									
Date of Receipt	14/07/2020	14/07/2020	14/07/2020									
	LOD/LOR	Units	Method No.									
VOC MS												
Dichlorodifluoromethane	<2	ug/l	TM15/PM10									
Methyl Tertiary Butyl Ether #	<0.1	ug/l	TM15/PM10									
Chloromethane #	<3	ug/l	TM15/PM10									
Vinyl Chloride #	<0.1	ug/l	TM15/PM10									
Bromomethane	<1	ug/l	TM15/PM10									
Chloroethane #	<3	ug/l	TM15/PM10									
Trichlorofluoromethane #	<3	ug/l	TM15/PM10									
1,1-Dichloroethene (1,1 DCE) #	<3	ug/l	TM15/PM10									
Dichloromethane (DCM) #	<5	ug/l	TM15/PM10									
trans-1-2-Dichloroethene #	<3	ug/l	TM15/PM10									
1,1-Dichloroethane #	<3	ug/l	TM15/PM10									
cis-1-2-Dichloroethene #	<3	ug/l	TM15/PM10									
2,2-Dichloropropane	<1	ug/l	TM15/PM10									
Bromochloromethane #	<2	ug/l	TM15/PM10									
Chloroform #	<2	ug/l	TM15/PM10									
1,1,1-Trichloroethane #	<2	ug/l	TM15/PM10									
1,1-Dichloropropene #	<3	ug/l	TM15/PM10									
Carbon tetrachloride #	<2	ug/l	TM15/PM10									
1,2-Dichloroethane #	<2	ug/l	TM15/PM10									
Benzene #	<0.5	ug/l	TM15/PM10									
Trichloroethene (TCE) #	<3	ug/l	TM15/PM10									
1,2-Dichloropropane #	<2	ug/l	TM15/PM10									
Dibromomethane #	<3	ug/l	TM15/PM10									
Bromodichloromethane #	<2	ug/l	TM15/PM10									
cis-1-3-Dichloropropene	<2	ug/l	TM15/PM10									
Toluene #	<5	ug/l	TM15/PM10									
trans-1-3-Dichloropropene	<2	ug/l	TM15/PM10									
1,1,2-Trichloroethane #	<2	ug/l	TM15/PM10									
Tetrachloroethene (PCE) #	<3	ug/l	TM15/PM10									
1,3-Dichloropropane #	<2	ug/l	TM15/PM10									
Dibromochloromethane #	<2	ug/l	TM15/PM10									
1,2-Dibromoethane #	<2	ug/l	TM15/PM10									
Chlorobenzene #	<2	ug/l	TM15/PM10									
1,1,1,2-Tetrachloroethane #	<2	ug/l	TM15/PM10									
Ethylbenzene #	<1	ug/l	TM15/PM10									
m/p-Xylene #	<2	ug/l	TM15/PM10									
o-Xylene #	<1	ug/l	TM15/PM10									
Styrene	<2	ug/l	TM15/PM10									
Bromoform #	<2	ug/l	TM15/PM10									
Isopropylbenzene #	<3	ug/l	TM15/PM10									
1,1,2,2-Tetrachloroethane	<4	ug/l	TM15/PM10									
Bromobenzene #	<2	ug/l	TM15/PM10									
1,2,3-Trichloropropane #	<3	ug/l	TM15/PM10									
Propylbenzene #	<3	ug/l	TM15/PM10									
1,2-Dibromo-3-chloropropane	<2	ug/l	TM15/PM10									
1,2,4-Trichlorobenzene	<3	ug/l	TM15/PM10									
Hexachlorobutadiene	<3	ug/l	TM15/PM10									
Naphthalene	<2	ug/l	TM15/PM10									
1,2,3-Trichlorobenzene	<3	ug/l	TM15/PM10									
Surrogate Recovery Toluene D8	107	%	TM15/PM10									
Surrogate Recovery 4-Bromofluorobenzene	108	%	TM15/PM10									

Please see attached notes for all abbreviations and acronyms

Client Name: Ground Investigations Ireland
Reference: 9429-02-20
Location: Whitehall, Swords, Road Extension
Contact: Mike Sutton

Client Name: Ground Investigations Ireland
Reference: 9429-02-20
Location: Whitehall, Swords, Road Extension
Contact: Mike Sutton

Client Name: Ground Investigations Ireland
Reference: 9429-02-20
Location: Whitehall, Swords, Road Extension
Contact: Mike Sutton

Client Name: Ground Investigations Ireland
Reference: 9429-02-20
Location: Whitehall, Swords, Road Extension
Contact: Mike Sutton

[illegible]

Please note that only samples that are deviating are mentioned in this report. If no samples are listed it is because none were deviating. Only analyses which are accredited are recorded as deviating if set criteria are not met.

NOTES TO ACCOMPANY ALL SCHEDULES AND REPORTS

EMT Job No.: 20/9144

SOILS

Please note we are only MCERTS accredited (UK soils only) for sand, loam and clay and any other matrix is outside our scope of accreditation.

Where an MCERTS report has been requested, you will be notified within 48 hours of any samples that have been identified as being outside our MCERTS scope. As validation has been performed on clay, sand and loam, only samples that are predominantly these matrices, or combinations of them will be within our MCERTS scope. If samples are not one of a combination of the above matrices they will not be marked as MCERTS accredited.

It is assumed that you have taken representative samples on site and require analysis on a representative subsample. Stones will generally be included unless we are requested to remove them.

All samples will be discarded one month after the date of reporting, unless we are instructed to the contrary.

If you have not already done so, please send us a purchase order if this is required by your company.

Where appropriate please make sure that our detection limits are suitable for your needs, if they are not, please notify us immediately.

All analysis is reported on a dry weight basis unless stated otherwise. Limits of detection for analyses carried out on as received samples are not moisture content corrected. Results are not surrogate corrected. Samples are dried at 35°C ±5°C unless otherwise stated. Moisture content for CEN Leachate tests are dried at 105°C ±5°C.

Where Mineral Oil or Fats, Oils and Grease is quoted, this refers to Total Aliphatics C10-C40.

Where a CEN 10:1 ZERO Headspace VOC test has been carried out, a 10:1 ratio of water to wet (as received) soil has been used.

% Asbestos in Asbestos Containing Materials (ACMs) is determined by reference to HSG 264 The Survey Guide - Appendix 2 : ACMs in buildings listed in order of ease of fibre release.

Sufficient amount of sample must be received to carry out the testing specified. Where an insufficient amount of sample has been received the testing may not meet the requirements of our accredited methods, as such accreditation may be removed.

Negative Neutralization Potential (NP) values are obtained when the volume of NaOH (0.1N) titrated (pH 8.3) is greater than the volume of HCl (1N) to reduce the pH of the sample to 2.0 - 2.5. Any negative NP values are corrected to 0.

The calculation of Pyrite content assumes that all oxidisable sulphides present in the sample are pyrite. This may not be the case. The calculation may be an overestimate when other sulphides such as Barite (Barium Sulphate) are present.

WATERS

Please note we are not a UK Drinking Water Inspectorate (DWI) Approved Laboratory .

ISO17025 accreditation applies to surface water and groundwater and usually one other matrix which is analysis specific, any other liquids are outside our scope of accreditation.

As surface waters require different sample preparation to groundwaters the laboratory must be informed of the water type when submitting samples.

Where Mineral Oil or Fats, Oils and Grease is quoted, this refers to Total Aliphatics C10-C40.

DEVIATING SAMPLES

All samples should be submitted to the laboratory in suitable containers with sufficient ice packs to sustain an appropriate temperature for the requested analysis. The temperature of sample receipt is recorded on the confirmation schedules in order that the client can make an informed decision as to whether testing should still be undertaken.

SURROGATES

Surrogate compounds are added during the preparation process to monitor recovery of analytes. However low recovery in soils is often due to peat, clay or other organic rich matrices. For waters this can be due to oxidants, surfactants, organic rich sediments or remediation fluids. Acceptable limits for most organic methods are 70 - 130% and for VOCs are 50 - 150%. When surrogate recoveries are outside the performance criteria but the associated AQC passes this is assumed to be due to matrix effect. Results are not surrogate corrected.

DILUTIONS

A dilution suffix indicates a dilution has been performed and the reported result takes this into account. No further calculation is required.

BLANKS

Where analytes have been found in the blank, the sample will be treated in accordance with our laboratory procedure for dealing with contaminated blanks.

NOTE

Data is only reported if the laboratory is confident that the data is a true reflection of the samples analysed. Data is only reported as accredited when all the requirements of our Quality System have been met. In certain circumstances where all the requirements of the Quality System have not been met, for instance if the associated AQC has failed, the reason is fully investigated and documented. The sample data is then evaluated alongside the other quality control checks performed during analysis to determine its suitability. Following this evaluation, provided the sample results have not been effected, the data is reported but accreditation is removed. It is a UKAS requirement for data not reported as accredited to be considered indicative only, but this does not mean the data is not valid.

Where possible, and if requested, samples will be re-extracted and a revised report issued with accredited results. Please do not hesitate to contact the laboratory if further details are required of the circumstances which have led to the removal of accreditation.

Please include all sections of this report if it is reproduced

REPORTS FROM THE SOUTH AFRICA LABORATORY

Any method number not prefixed with SA has been undertaken in our UK laboratory unless reported as subcontracted.

Measurement Uncertainty

Measurement uncertainty defines the range of values that could reasonably be attributed to the measured quantity. This range of values has not been included within the reported results. Uncertainty expressed as a percentage can be provided upon request.

ABBREVIATIONS and ACRONYMS USED

#	ISO17025 (UKAS Ref No. 4225) accredited - UK.
SA	ISO17025 (SANAS Ref No.T0729) accredited - South Africa
B	Indicates analyte found in associated method blank.
DR	Dilution required.
M	MCERTS accredited.
NA	Not applicable
NAD	No Asbestos Detected.
ND	None Detected (usually refers to VOC and/SVOC TICs).
NDP	No Determination Possible
SS	Calibrated against a single substance
SV	Surrogate recovery outside performance criteria. This may be due to a matrix effect.
W	Results expressed on as received basis.
+	AQC failure, accreditation has been removed from this result, if appropriate, see 'Note' on previous page.
>>	Results above calibration range, the result should be considered the minimum value. The actual result could be significantly higher, this result is not accredited.
*	Analysis subcontracted to an Element Materials Technology approved laboratory.
AD	Samples are dried at 35°C ±5°C
CO	Suspected carry over
LOD/LOR	Limit of Detection (Limit of Reporting) in line with ISO 17025 and MCERTS
ME	Matrix Effect
NFD	No Fibres Detected
BS	AQC Sample
LB	Blank Sample
N	Client Sample
TB	Trip Blank Sample
OC	Outside Calibration Range

EMT Job No: 20/9144

Test Method No.	Description	Prep Method No. (if appropriate)	Description	ISO 17025 (UKAS/ANAS)	MCERTS (UK soils only)	Analysis done on As Received (AR) or Dried (AD)	Reported on dry weight basis
TM4	Modified USEPA 8270D v5:2014 method for the solvent extraction and determination of PAHs by GC-MS.	PM30	Water samples are extracted with solvent using a magnetic stirrer to create a vortex.				
TM4	Modified USEPA 8270D v5:2014 method for the solvent extraction and determination of PAHs by GC-MS.	PM30	Water samples are extracted with solvent using a magnetic stirrer to create a vortex.	Yes			
TM5	Modified 8015B v2:1996 method for the determination of solvent Extractable Petroleum Hydrocarbons (EPH) within the range C8-C40 by GCFID. For waters the solvent extracts dissolved phase plus a sheen if present.	PM16/PM30	Fractionation into aliphatic and aromatic fractions using a Rapid Trace SPE/Water samples are extracted with solvent using a magnetic stirrer to create a vortex.	Yes			
TM5/TM36	please refer to TM5 and TM36 for method details	PM12/PM16/PM30	please refer to PM16/PM30 and PM12 for method details	Yes			
TM15	Modified USEPA 8260B v2:1996. Quantitative Determination of Volatile Organic Compounds (VOCs) by Headspace GC-MS.	PM10	Modified US EPA method 5021A v2:2014. Preparation of solid and liquid samples for GC headspace analysis.				
TM15	Modified USEPA 8260B v2:1996. Quantitative Determination of Volatile Organic Compounds (VOCs) by Headspace GC-MS.	PM10	Modified US EPA method 5021A v2:2014. Preparation of solid and liquid samples for GC headspace analysis.	Yes			
TM16	Modified USEPA 8270D v5:2014. Quantitative determination of Semi-Volatile Organic compounds (SVOCs) by GC-MS.	PM30	Water samples are extracted with solvent using a magnetic stirrer to create a vortex.				
TM16	Modified USEPA 8270D v5:2014. Quantitative determination of Semi-Volatile Organic compounds (SVOCs) by GC-MS.	PM30	Water samples are extracted with solvent using a magnetic stirrer to create a vortex.	Yes			
TM17	Modified US EPA method 8270D v5:2014. Determination of specific Polychlorinated Biphenyl congeners by GC-MS.	PM30	Water samples are extracted with solvent using a magnetic stirrer to create a vortex.				
TM30	Determination of Trace Metals by ICP-OES (Inductively Coupled Plasma – Optical Emission Spectrometry); WATERS by Modified USEPA Method 200.7, Rev. 4.4, 1994; Modified EPA Method 6010B, Rev.2, Dec 1996; Modified BS EN ISO 11885:2009: SOILS by Modified USEP	PM14	Preparation of waters and leachates for metals by ICP OES/ICP MS. Samples are filtered for Dissolved metals, and remain unfiltered for Total metals then acidified	Yes			

EMT Job No: 20/9144

Test Method No.	Description	Prep Method No. (if appropriate)	Description	ISO 17025 (UKAS/ANAS)	MCERTS (UK soils only)	Analysis done on As Received (AR) or Dried (AD)	Reported on dry weight basis
TM36	Modified US EPA method 8015B v2:1996. Determination of Gasoline Range Organics (GRO) in the carbon chain range of C4-12 by headspace GC-FID. MTBE by GCFID co-elutes with 3-methylpentane if present and therefore can give a false positive. Positive MTBE re	PM12	Modified US EPA method 5021A v2:2014. Preparation of solid and liquid samples for GC headspace analysis.	Yes			
TM38	Soluble Ion analysis using Discrete Analyser. Modified US EPA methods: Chloride 325.2 (1978), Sulphate 375.4 (Rev.2 1993), o-Phosphate 365.2 (Rev.2 1993), TON 353.1 (Rev.2 1993), Nitrite 354.1 (1971), Hex Cr 7196A (1992), NH4+ 350.1 (Rev.2 1993 (comparabl	PM0	No preparation is required.	Yes			
TM73	Modified US EPA methods 150.1 (1982) and 9045D Rev. 4 - 2004) and BS1377-3:1990. Determination of pH by Metrohm automated probe analyser.	PM0	No preparation is required.	Yes			
TM76	Modified US EPA method 120.1 (1982). Determination of Specific Conductance by Metrohm automated probe analyser.	PM0	No preparation is required.	Yes			

APPENDIX 7 – Groundwater Monitoring



www.gii.ie



GROUND INVESTIGATIONS IRELAND
Geotechnical & Environmental

Catherinestown House,
Hazelhatch Road,
Newcastle,
Co. Dublin.
D22 YD52

Tel: 01 601 5175 / 5176
Email: info@gii.ie
Web: www.gii.ie

GROUNDWATER MONITORING

Whithall Swords Road Extension

BOREHOLE	DATE	TIME	GROUNDWATER (m BGL)	Comments
BH01	30/06/2020	17.13	1.77	
BH06	30/06/2020	17.23	5.21	
BH10	30/06/2020	17.17	1.76	



GROUND INVESTIGATIONS IRELAND
Geotechnical & Environmental

Catherinestown House,
Hazelhatch Road,
Newcastle,
Co. Dublin.
D22 YD52

Tel: 01 601 5175 / 5176
Email: info@gii.ie
Web: www.gii.ie

GROUNDWATER MONITORING

Whitehall, Swords

BOREHOLE	DATE	TIME	GROUNDWATER (m BGL)	Comments
BH01	13/07/2020	14:02	1.52	
BH06	13/07/2020	15:05	4.15	
BH10	13/07/2020	14:45	1.74	



GROUND INVESTIGATIONS IRELAND
Geotechnical & Environmental

Catherinestown House,
Hazelhatch Road,
Newcastle,
Co. Dublin.
D22 YD52

Tel: 01 601 5175 / 5176
Email: info@gii.ie
Web: www.gii.ie

GROUNDWATER MONITORING

Whithall Swords Road Extension

BOREHOLE	DATE	TIME	GROUNDWATER (m BGL)	Comments
BH01	13/08/2020	8.03	1.86	
BH06	13/08/2020	8.09	3.65	
BH10	13/08/2020	8.20	1.57	